

As-Built Plans

# DESERT SAGE HEALTH CENTER

2280 American Legion Blvd. part of Glens Ferry Health Center Mountain Home, Idaho

## KEY TO MATERIALS

- EARTH
- ASPHALT PAVING
- COMPACTED GRANULAR FILL
- CONCRETE MASONRY UNITS
- CONCRETE
- BRICK
- PLYWOOD
- STEEL CONTINUOUS
- CONTINUOUS WOOD
- WOOD BLOCKING
- INSULATION
- RIGID INSULATION
- FINISH WOOD
- ENGINEERED FILL
- UNDISTURBED EARTH
- TOP SOIL
- CRUSHED GRAVEL
- SAND

## CONSULTANTS

**ARCHITECT**  
**MEDICAL DESIGN GROUP**  
 2716 Westland Place  
 Boise, Idaho 83704  
 archmdg@aol.com E-MAIL  
 (208) 378-1405 FAX  
 (208) 378-0817 PHONE  
 David R. Davies, AIA NCARB

**CIVIL ENGINEER AND STRUCTURAL ENGINEER**  
**PINNACLE ENGINEERS, INC.**  
 12552 W. Executive Dr., Suite B  
 Boise, Idaho 83713  
 brians@pinnacle-engineers.com  
 (208) 887-7781 FAX  
 (208) 887-7760 PHONE  
 Brian Smith, PE, SE  
 Roger Smith, PE

**MECHANICAL ENGINEER**  
**ELKHORN ENGINEERS, P.A.**  
 290 E. Magic View Dr., Ste 190  
 Meridian, Idaho 83642  
 otennyson@elkhorneng.com  
 (208) 955-0999 FAX  
 (208) 955-0555 PHONE  
 Owen Tennyson, CIPE

**ELECTRICAL ENGINEER**  
**PAYNE ENGINEERING INC.**  
 107 So. 18th Ave  
 Pocatello, Idaho 83201  
 payneeng@srv.net  
 (208) 232-1435 FAX  
 (208) 232-4439 PHONE  
 Todd Payne, PE

**USDA RURAL DEVELOPMENT**  
 Caldwell Office  
 (208) 459-0761 ext 116  
 Dave Flesher, RD Specialist

**GEOTECHNICAL ENGINEER**  
 MTI  
 (208) 376-4748  
 Kevin Schroeder, PG

**DENTAL EQUIPT. SUPPLIER (DES)**  
**SULLIVAN-SCHIEIN**  
 (208) 433-1852  
 Brent Davis

**X-RAY EQUIPMENT SUPPLIER**  
**TURN-KEY MEDICAL, INC.**  
 (208) 888-1760  
 Willie Rowell

**SURVEYOR**  
**FOX LAND SURVEYS, INC.**  
 (208) 342-7957  
 Tim Fox, Surveyor

## SYMBOLS

- BUILDING SECTION
- DETAIL
- FINISH ELEVATION PLAN
- ELEVATIONS INTERIOR
- KEYNOTES
- WINDOW TYPES
- WALL TYPES
- DOOR NUMBER
- INTERIOR ELEVATIONS
- EQUIPMENT, FURNISHING NO.

## ABBREVIATIONS

- |                           |   |
|---------------------------|---|
| AC Asphalt Concrete       | HD Hand Dumper                            |
| ADJ Adjustable            | HORIZ Horizontal                          |
| AFF Above Finished Floor  | HW Hot Water                              |
| APPROX Approximately      | MANFR Manufacturer                        |
| BM Benchmark              | MAX Maximum                               |
| BS Back Splash            | MECH Mechanical                           |
| CFCI Contractor Furnished | MIN Minimum                               |
| CFM Contractor Installed  | NTS Not to Scale                          |
| CI Cast Iron              | DC On Center                              |
| CL Center Line            | DFCI Dimer Furnished Contractor Installed |
| CLG Ceiling               | DFOI Dimer Furnished Dimer Installed      |
| CMU Concrete Masonry Unit | OPP Opposite                              |
| CD Clean Out              | OSB Oriented Strand Board                 |
| CBL Column                | PL Plate                                  |
| CCMC Concrete             | R Radius                                  |
| CONT Continuous           | RA Return Air                             |
| CONST Construction        | REF Refrigerator                          |
| CONT Continuous           | REQD Required                             |
| COTG Clean Out To Grade   | RJ Rin Joist                              |
| CW Cold Water             | RO Rough Opening                          |
| D Deep                    | RPM Rotations Per Minute                  |
| DBL Penny                 | TEL Telephone                             |
| DIA Double                | TJI Truss Joist International             |
| DIA Diameter              | SA Supply Air                             |
| DIM Dimension             | SIH Similar                               |
| DWGS Drawings             | STRUCT Structural                         |
| DWY Drain Waste Vent      | T&B Top and Bottom                        |
| EA Each                   | TEL Telephone                             |
| EC Electrical Contractor  | TOP Top of                                |
| ELEC Electrical           | TV Television                             |
| EQ Equal or Equivalent    | TYP Typical                               |
| FF Finish Floor           | UNO Unless Noted Otherwise                |
| FIN Finish                | VERT Vertical                             |
| FND Foundation            | VTR Vent Through Roof                     |
| FD Face DF                | V Wide                                    |
| FTG Footing               | W/ With                                   |
| GR Grade                  | W/O With Out                              |
| GPM Gallons Per Minute    | WCD Wall Clean Out                        |
| GYP BRD Gypsum Board      |   |
| H High                    |   |

## CODE ANALYSIS

**GENERAL:**  
 OCCUPANCY GROUP  
 CONSTRUCTION TYPE

**GENERAL:**  
 OCCUPANCY GROUP  
 CONSTRUCTION TYPE

**CODES:**  
 2000 INTERNATIONAL BUILDING CODE  
 Latest Edition IFC  
 Latest Edition IMC  
 Latest Edition NEC  
 2000 INTERNATIONAL FIRE CODE  
 1995 NFPA Life Safety I01, ch. 26  
 Latest Edition IFAS and ADA/AG  
 AIA ISBN 0-913962-96-1 Guidelines

**NFPA 1B FIRE SPRINKLERS THROUGHOUT**

**BASIC ALLOWABLE AREA:** 9000 SF  
**INCREASE FOR SPRINKLERS OF 200%:**  
**INCREASE FOR FRONTAGE OF 75%:**  
**MAX. ALLOWABLE AREA:** 24,750 SF

**ACTUAL AREA:** 8370 SF

**DESIGN LOADS:**  
 See Structural Calcs, sheet 3.01 and following

## OWNER APPROVALS:

I/WE HAVE REVIEWED THESE CONTRACT DOCUMENTS AND FIND THEM TO BE A COMPLETE STATEMENT OF OUR CONSTRUCTION REQUIREMENTS. WE UNDERSTAND THAT ANY MODIFICATIONS REQUESTED BY US AFTER THIS DATE MAY RESULT IN A CHANGE ORDER AFFECTING TIME AND/OR CONSTRUCTION COST.

*Signature: [Handwritten Signature]*  
 DATE: 3/17/04

## DRAWING INDEX

- 1.00 TITLE SHEET
- C1.0 CIVIL SITE PLAN
- C1.1 DRAINAGE AND GRADING PLAN
- C1.2 DRAINAGE AND GRADING DETAILS
- C1.2a DRAINAGE AND GRADING DETAILS
- C1.3 SEWER PLAN AND PROFILE
- C1.4 UTILITY DETAILS
- C1.5 GENERAL NOTES
- 2.45 SITE DETAILS
- 2.50 LANDSCAPE PLAN AND SPECIFICATIONS
- 2.65 IRRIGATION NOTES
- 2.66 IRRIGATION DETAILS
- 3.01 STRUCTURAL SPECS
- 3.02 STRUCTURAL SPECS
- 3.03 STRUCTURAL SPECS
- 3.04 STRUCT. SPECS/SCHEDULES
- 3.05 ENERGY ANALYSIS - ENVELOPE
- 3.08 ARCHITECTURAL SPECS
- 3.07 ARCHITECTURAL SPECS
- 3.08 ARCHITECTURAL SPECS AND COLOR SCHEDULE
- 3.10 FOUNDATION PLAN
- 3.15 FOUNDATION DETAILS
- 3.30 FLOOR PLAN
- 3.31 DIMENSION/FINISH PLAN
- 3.35 WALL ASSEMBLIES
- 3.40 ROOF PLAN
- 3.45 TYPICAL ROOF DETAILS
- 3.46 TYPICAL ROOF DETAILS
- 3.47 ROOF/WALL PANEL DETAILS
- 3.50 ROOF FRAMING PLAN
- 3.80 REFLECTED CEILING PLAN
- 4.00 EXTERIOR ELEVATIONS
- 4.10 EXTERIOR ELEVATIONS
- 5.00 BUILDING SECTIONS
- 5.10 TYPICAL WALL SECTION
- 5.11 WALL SECTION
- 5.12 WALL SECTIONS
- 5.20 DETAILS
- 5.21 DETAILS
- 6.00 DOOR/FRAME TYPES
- 6.01 WINDOW TYPES
- 6.10 DOOR/WINDOW DETAILS
- 6.11 DOOR SCHEDULES
- 7.00 TYP. INTERIOR ELEVATION DETAILS
- 7.01 INTERIOR DETAILS
- 7.10 INTERIOR ELEVATIONS
- 7.11 INTERIOR ELEVATIONS
- 7.12 INTERIOR ELEVATIONS
- 7.13 INTERIOR ELEVATIONS
- 7.14 INTERIOR ELEVATIONS
- 13.01 X-RAY SPECS/DETAILS
- 13.02 X-RAY SPECS/DETAILS
- 13.03 XRAY SPECS/DETAILS
- 13.04 XRAY SPECS/DETAILS
- 13.05 XRAY SPECS/DETAILS
- 13.06 XRAY SPECS/DETAILS
- P 0.0 PLUMBING LEGENDS & ABBREY.
- P 0.1 PLUMBING SPECIFICATIONS
- P 0.2 PLUMBING SPECIFICATIONS
- P 0.3 PLUMBING SPECIFICATIONS
- P 0.4 PLUMBING SCHEDULES
- P 1.1 PLUMBING FLOOR PLAN
- P 1.2 PLUMBING FLOOR PLAN
- P 1.3 PLUMBING FLOOR PLAN
- P 1.4 PLUMBING FLOOR PLAN
- P 2.1 PLUMBING ROOF PLAN
- P 3.1 PLUMBING DETAILS
- P 3.2 PLUMBING DETAILS
- P 3.3 PLUMBING DETAILS
- P 3.4 PLUMBING DETAILS
- EN 1.0 ENERGY ANALYSIS - MECH
- M 0.0 HVAC LEGENDS & ABBREY.
- M 0.1 HVAC SPECIFICATIONS
- M 0.2 HVAC SPECIFICATIONS
- M 0.3 HVAC SPECIFICATIONS
- M 0.4 HVAC SCHEDULES
- M 1.1 HVAC FLOOR PLAN
- M 1.2 RELIEF AIR FLOOR PLAN
- M 2.1 HVAC ROOF PLAN
- M 3.1 HVAC DETAILS
- M 4.1 MECH BUILDING SECTIONS
- 16.00 NOTES & SCHEDULES
- 16.01 ELECTRICAL SITE PLAN
- 16.10 FLOOR PLAN - LIGHTING
- 16.20 FLOOR PLAN - POWER
- 16.21 POWER Riser & SCHEDULES
- 16.22 ELECT. PANEL SCHEDULES
- 16.23 ROOF/CRAWL SPACE PLANS
- 16.24 DENTAL EQUIPMENT PLAN
- 16.30 ELECTRICAL DETAILS
- 16.40 ELECTRICAL SPECIFICATIONS
- 16.41 ELECT. COM-CHECK REPORT
- D1.0 DENTAL DETAILS
- D1.1 DENTAL DETAILS
- D1.2 DENTAL DETAILS
- D1.3 DENTAL DETAILS

20

SET NO.

Excuse Do Not Remove from Office

**Medical Design Group**  
 Architecture for Health Care

2716 WESTLAND PLACE  
 BOISE, IDAHO 83704-5863

BOISEARCHITECT@AOL.COM  
 Fax (208) 378-1405  
 Phone (208) 378-0817

© COPYRIGHT: MEDICAL DESIGN GROUP

**REGISTERED ARCHITECT**  
 No. AR-1740  
 22 March 2004

**COVER SHEET**

Desert Sage Health Center SHEET  
 2280 American Legion Blvd. Mountain Home, Idaho 1.00

Mar 2004

c:\Program Files\AutoCAD Architectural 2\TEMPLATE\acad-b.dwt August 2001 MDC



C:\CIVIL\0036218\0036218\_BS.dwg, CIVIL, 3/23/2004 8:23:34 AM, L:\CIVIL\0036218\0036218\_BS.dwg, ALL RIGHTS RESERVED

# CIVIL SITE PLAN FOR DESERT SAGE HEALTH CENTER

A PORTION OF GOVERNMENT LOT 2, NW 1/4 SECTION 30,  
TOWNSHIP 3 SOUTH, RANGE 7 EAST, BOISE MERIDIAN  
MOUNTAIN HOME, ELMORE COUNTY, IDAHO  
2003

## GENERAL LEGEND

- BOUNDARY LINE
- EXISTING FENCE
- S(12")- EXISTING SEWER LINE (PIPE SIZE)
- W- EXISTING WATER LINE
- SD(12")- EXISTING STORM DRAIN LINE (PIPE SIZE)
- G- EXISTING GAS LINE
- OHP- EXISTING OVERHEAD POWER LINE
- UGP- EXISTING UNDERGROUND POWER LINE
- SD(6")- NEW STORM DRAIN LINE (PIPE SIZE)
- FD(4")- NEW FOUNDATION DRAIN LINE (PIPE SIZE)
- W(8")- NEW WATER LINE (PIPE SIZE)
- S(8")- NEW SEWER LINE (PIPE SIZE)
- CONSTRUCTION LIMIT
- NEW CATCH BASIN
- NEW LANDSCAPE DRAIN
- ⊙ EXISTING TELEPHONE MANHOLE
- ⊙ EXISTING TELEPHONE BOX
- ⊙ EXISTING SANITARY SEWER MANHOLE
- ⊙ EXISTING STORM SEWER MANHOLE
- ⊙ EXISTING POWER POLE GUY WIRE
- ⊙ EXISTING POWER POLE
- ⊙ EXISTING WATER MANHOLE
- ⊙ EXISTING POWER MARKER
- ⊙ EXISTING WATER VALVE
- ⊙ EXISTING MAILBOX
- ⊙ EXISTING LIGHT POLE
- ⊙ NEW FLAGPOLE
- ⊙ EXISTING FIRE HYDRANT
- ⊙ FUTURE FIRE HYDRANT
- ⊙ NEW SAND AND GREASE TRAP
- ⊙ NEW SEWER CLEAN OUT
- ⊙ EXISTING CONIFEROUS TREE
- ⊙ EXISTING DECIDUOUS TREE
- FOUND 5/8" REBAR
- FOUND 1/2" REBAR
- 30.50 NEW CURB AND GUTTER
- 30.50 TOC SPOT ELEVATION
- TOA ELEVATION AT TOP OF CONCRETE
- TOA/C TOP OF ASPHALT AND CONCRETE
- BSW BACK OF SIDEWALK
- EP EDGE OF PAVEMENT
- TOC TOP OF GRATE
- TOC TOP OF CONCRETE
- INV INVERT ELEVATION
- (EX) EXISTING
- (N.E.) MATCH EXISTING
- EXISTING CURB, GUTTER, AND SIDEWALK
- /// ADD ALTERNATE #8-CONCRETE PARKING LOT

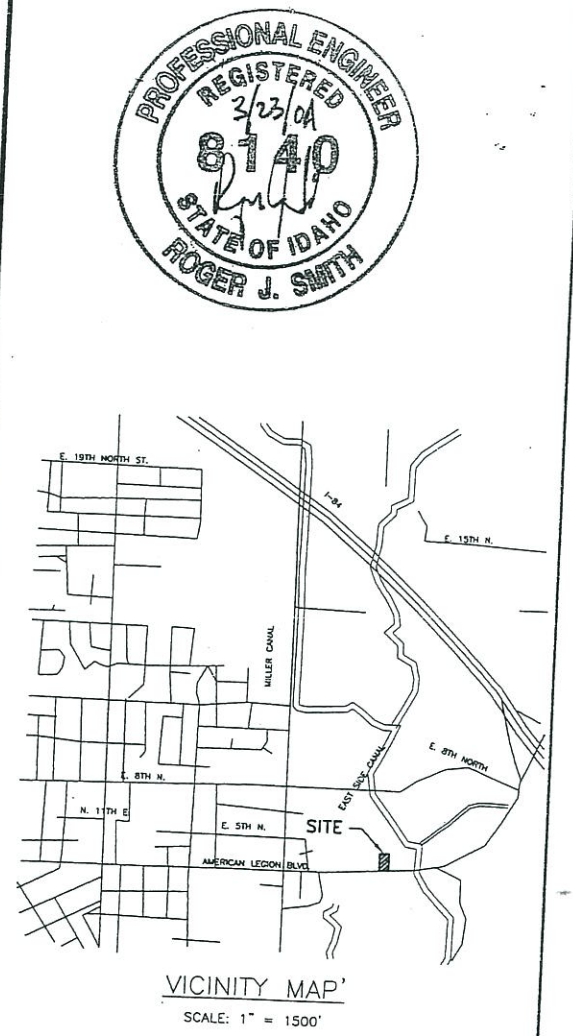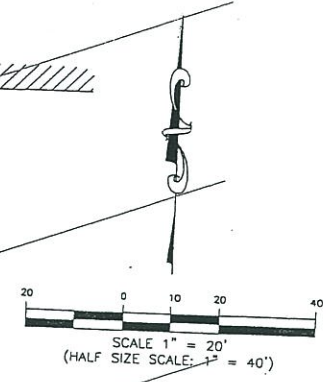

**PINNACLE**  
Engineers, Inc.  
12552 W. Executive Dr., Suite B, Boise, Idaho 83713  
(208) 887-7760


**Medical Design Group**  
Architecture for Health Care  
2716 WESTLAND PLACE  
BOISE, IDAHO 83704-5863  
BOISEARCHITECT@AOL.COM  
Fax (208) 378-1405  
Phone (208) 378-0817

© COPYRIGHT: MEDICAL DESIGN GROUP

## CIVIL SITE

Desert Sage He  
2280 Ameri  
Mountain

NOTES:  
1) THE LOCATION OF EXISTING UNDERGROUND UTILITIES ARE SHOWN APPROXIMATELY ONLY PRIOR TO CONSTRUCTION. IT SHALL BE THE RESPONSIBILITY OF THE CONTRACTOR TO INFORM ALL UTILITY COMPANIES OF THE CONSTRUCTION SCHEDULE. THE CONTRACTOR SHALL DETERMINE THE EXACT LOCATION OF ALL EXISTING UTILITIES BEFORE COMMENCING WORK. THE CONTRACTOR IS RESPONSIBLE FOR ANY AND ALL DAMAGE WHICH MAY OCCUR BY FAILURE TO EXACTLY LOCATE AND PROTECT ALL UTILITIES. CALL DIGLINE, INC. BEFORE COMMENCING UNDERGROUND WORK. 342-1585.  
2) CONTRACTOR SHALL COMPLETE BASE FLOOD ELEVATION CERTIFICATION PRIOR TO AND AFTER CONSTRUCTION IS COMPLETE TO CERTIFY BUILDING FINISHED FLOOR ELEVATION IS SUFFICIENTLY ABOVE THE BASE FLOOD ELEVATION AS REQUIRED BY THE (FEMA) CERTIFICATION PROCESS.

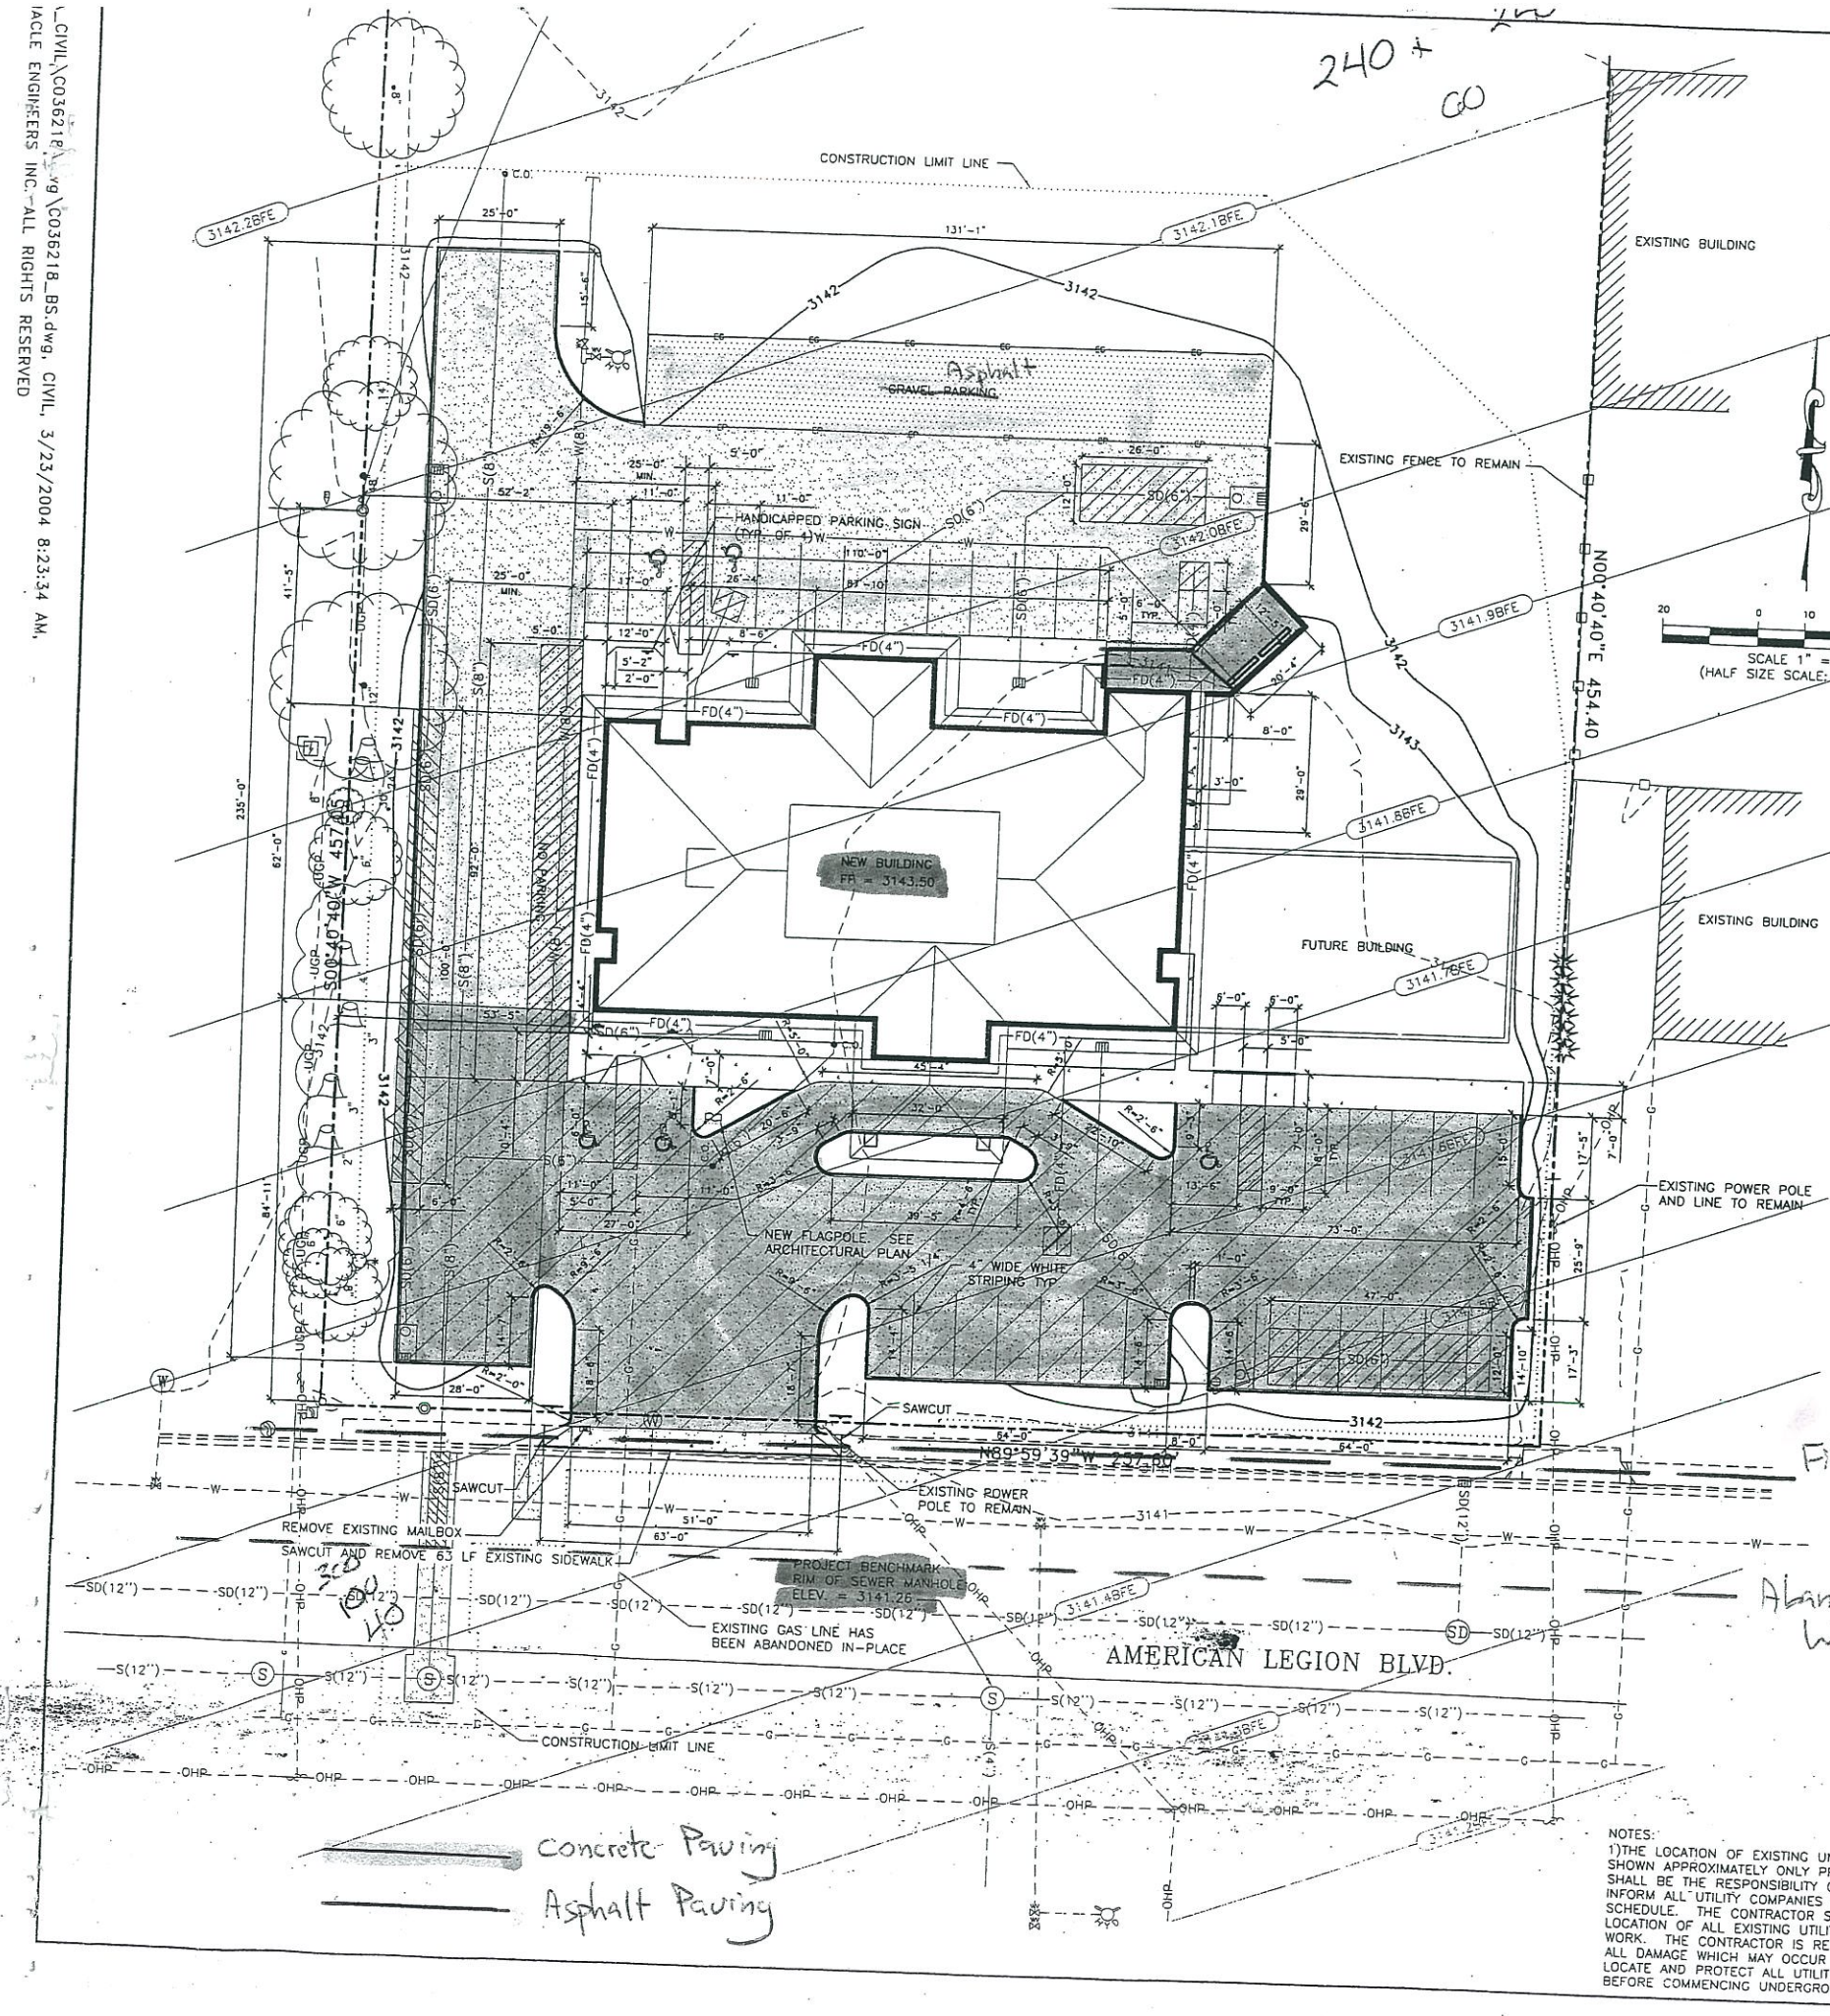

A:\CIVIL\0303219\dwg\0303219\_BS.dwg, D&G, 3/23/2004 8:28:42 AM, PINNACLE ENGINEERS INC. ALL RIGHTS RESERVED

# DRAINAGE AND GRADING PLAN FOR DESERT SAGE HEALTH CENTER

A PORTION OF GOVERNMENT LOT 2, NW 1/4 SECTION 30, TOWNSHIP 3 SOUTH, RANGE 7 EAST, BOISE MERIDIAN MOUNTAIN HOME, ELMORE COUNTY, IDAHO 2003

## DRAINAGE NOTES:

- ALL WORK SHALL CONFORM TO THE LATEST EDITION OF THE IDAHO STANDARDS FOR PUBLIC WORKS CONSTRUCTION.
- THE SIZE OF THE DRAINAGE TRENCH SHALL BE ENLARGED IF GROUND WATER IS ENCOUNTERED ABOVE NOMINAL SEEPAGE TRENCH DEPTH. IF THIS SITUATION OCCURS, CONTACT ENGINEER FOR NEW SEEPAGE BED SIZING.
- THE CONTRACTOR IS TO CALL CITY OF MOUNTAIN HOME ENGINEER FOR THE INSPECTION OF ALL CATCH BASINS AND DRAINAGE TRENCH CONSTRUCTION. 24 HOUR NOTICE IS REQUIRED. DRAINAGE FACILITIES WILL NOT BE APPROVED BY MOUNTAIN HOME UNLESS INSPECTION IS PERFORMED.
- THE BOTTOM OF DISPOSAL BEDS ARE TO PENETRATE A MINIMUM OF 12 INCHES INTO FREE DRAINING SAND AND GRAVEL MATERIALS.
- POTABLE WATER LINES SHALL MAINTAIN A 25' SEPARATION FROM DISPOSAL BEDS AND A 10' SEPARATION FROM SAND AND GREASE TRAPS.
- REFER TO ARCHITECTURAL DRAWINGS FOR LANDSCAPING. FINISH GRADE LANDSCAPING TO RETAIN ALL RUNOFF ON SITE.
- THE CONTRACTOR IS RESPONSIBLE FOR ANY AND ALL DAMAGE WHICH MAY OCCUR BY FAILURE TO EXACTLY LOCATE AND PROTECT ALL UTILITIES. THE CONTRACTOR SHALL COMPLY WITH IDAHO CODE, CHAPTER 22, TITLE 55 REGARDING UNDERGROUND FACILITIES DAMAGE PREVENTION. CALL DIGLINE, INC. BEFORE COMMENCING WORK, 342-1585.
- ALL CONSTRUCTION IN THE PUBLIC RIGHT-OF-WAY SHALL CONFORM TO THE LATEST EDITION OF THE ISPWC. NO EXCEPTION TO THE ISPWC WILL BE ALLOWED UNLESS SPECIFICALLY AND PREVIOUSLY APPROVED IN WRITING BY ITD AND CITY OF MOUNTAIN HOME.
- IF ANY UTILITY OR IRRIGATION FACILITY INTERFERES WITH REQUIRED STREET IMPROVEMENTS, ALL SUCH UTILITIES OR IRRIGATION FACILITIES SHALL BE RELOCATED AT THE OWNER'S EXPENSE SO AS NOT TO INTERFERE WITH REQUIRED STREET IMPROVEMENTS.
- ALL WATER VALVES, BLOW-OFFS, AND MANHOLES SHALL BE GRADED AND PLACED SO AS NOT TO CONFLICT WITH ANY CONCRETE CURB AND GUTTER, VALLEY GUTTER, OR SIDEWALK IMPROVEMENTS.
- NORTHWEST TECHNOLOGIES (322-0757) REMOVED AN EXISTING 1000 SF. HOUSE WITH A PARTIAL BASEMENT FROM THE SITE IN SEPTEMBER 2003. WORK OF THIS CURRENT CONTRACT INCLUDES THE REMOVAL AND RE-COMPACTION OF THE EXISTING EARTH AT THE ORIGINAL HOUSE LOCATION. EXCAVATE SOILS IN THIS AREA AND RE-COMPACT TO 95% MINIMUM.



**PINNACLE**  
Engineers, Inc.  
12552 W. Executive Dr., Suite B, Boise, Idaho 83713  
(208) 887-7760


**Medical Design Group**  
Architecture for Health Care  
2716 WESTLAND PLACE  
BOISE, IDAHO 83704-5863  
BOISEARCHITECT@AOL.COM  
Fax (208) 378-1405  
Phone (208) 378-0817

© COPYRIGHT: MEDICAL DESIGN GROUP

## DRAINAGE AND GRADING PLAN

Desert Sage Health Center  
2280 American Legion Blvd  
Mountain Home, ID

Dec 2003

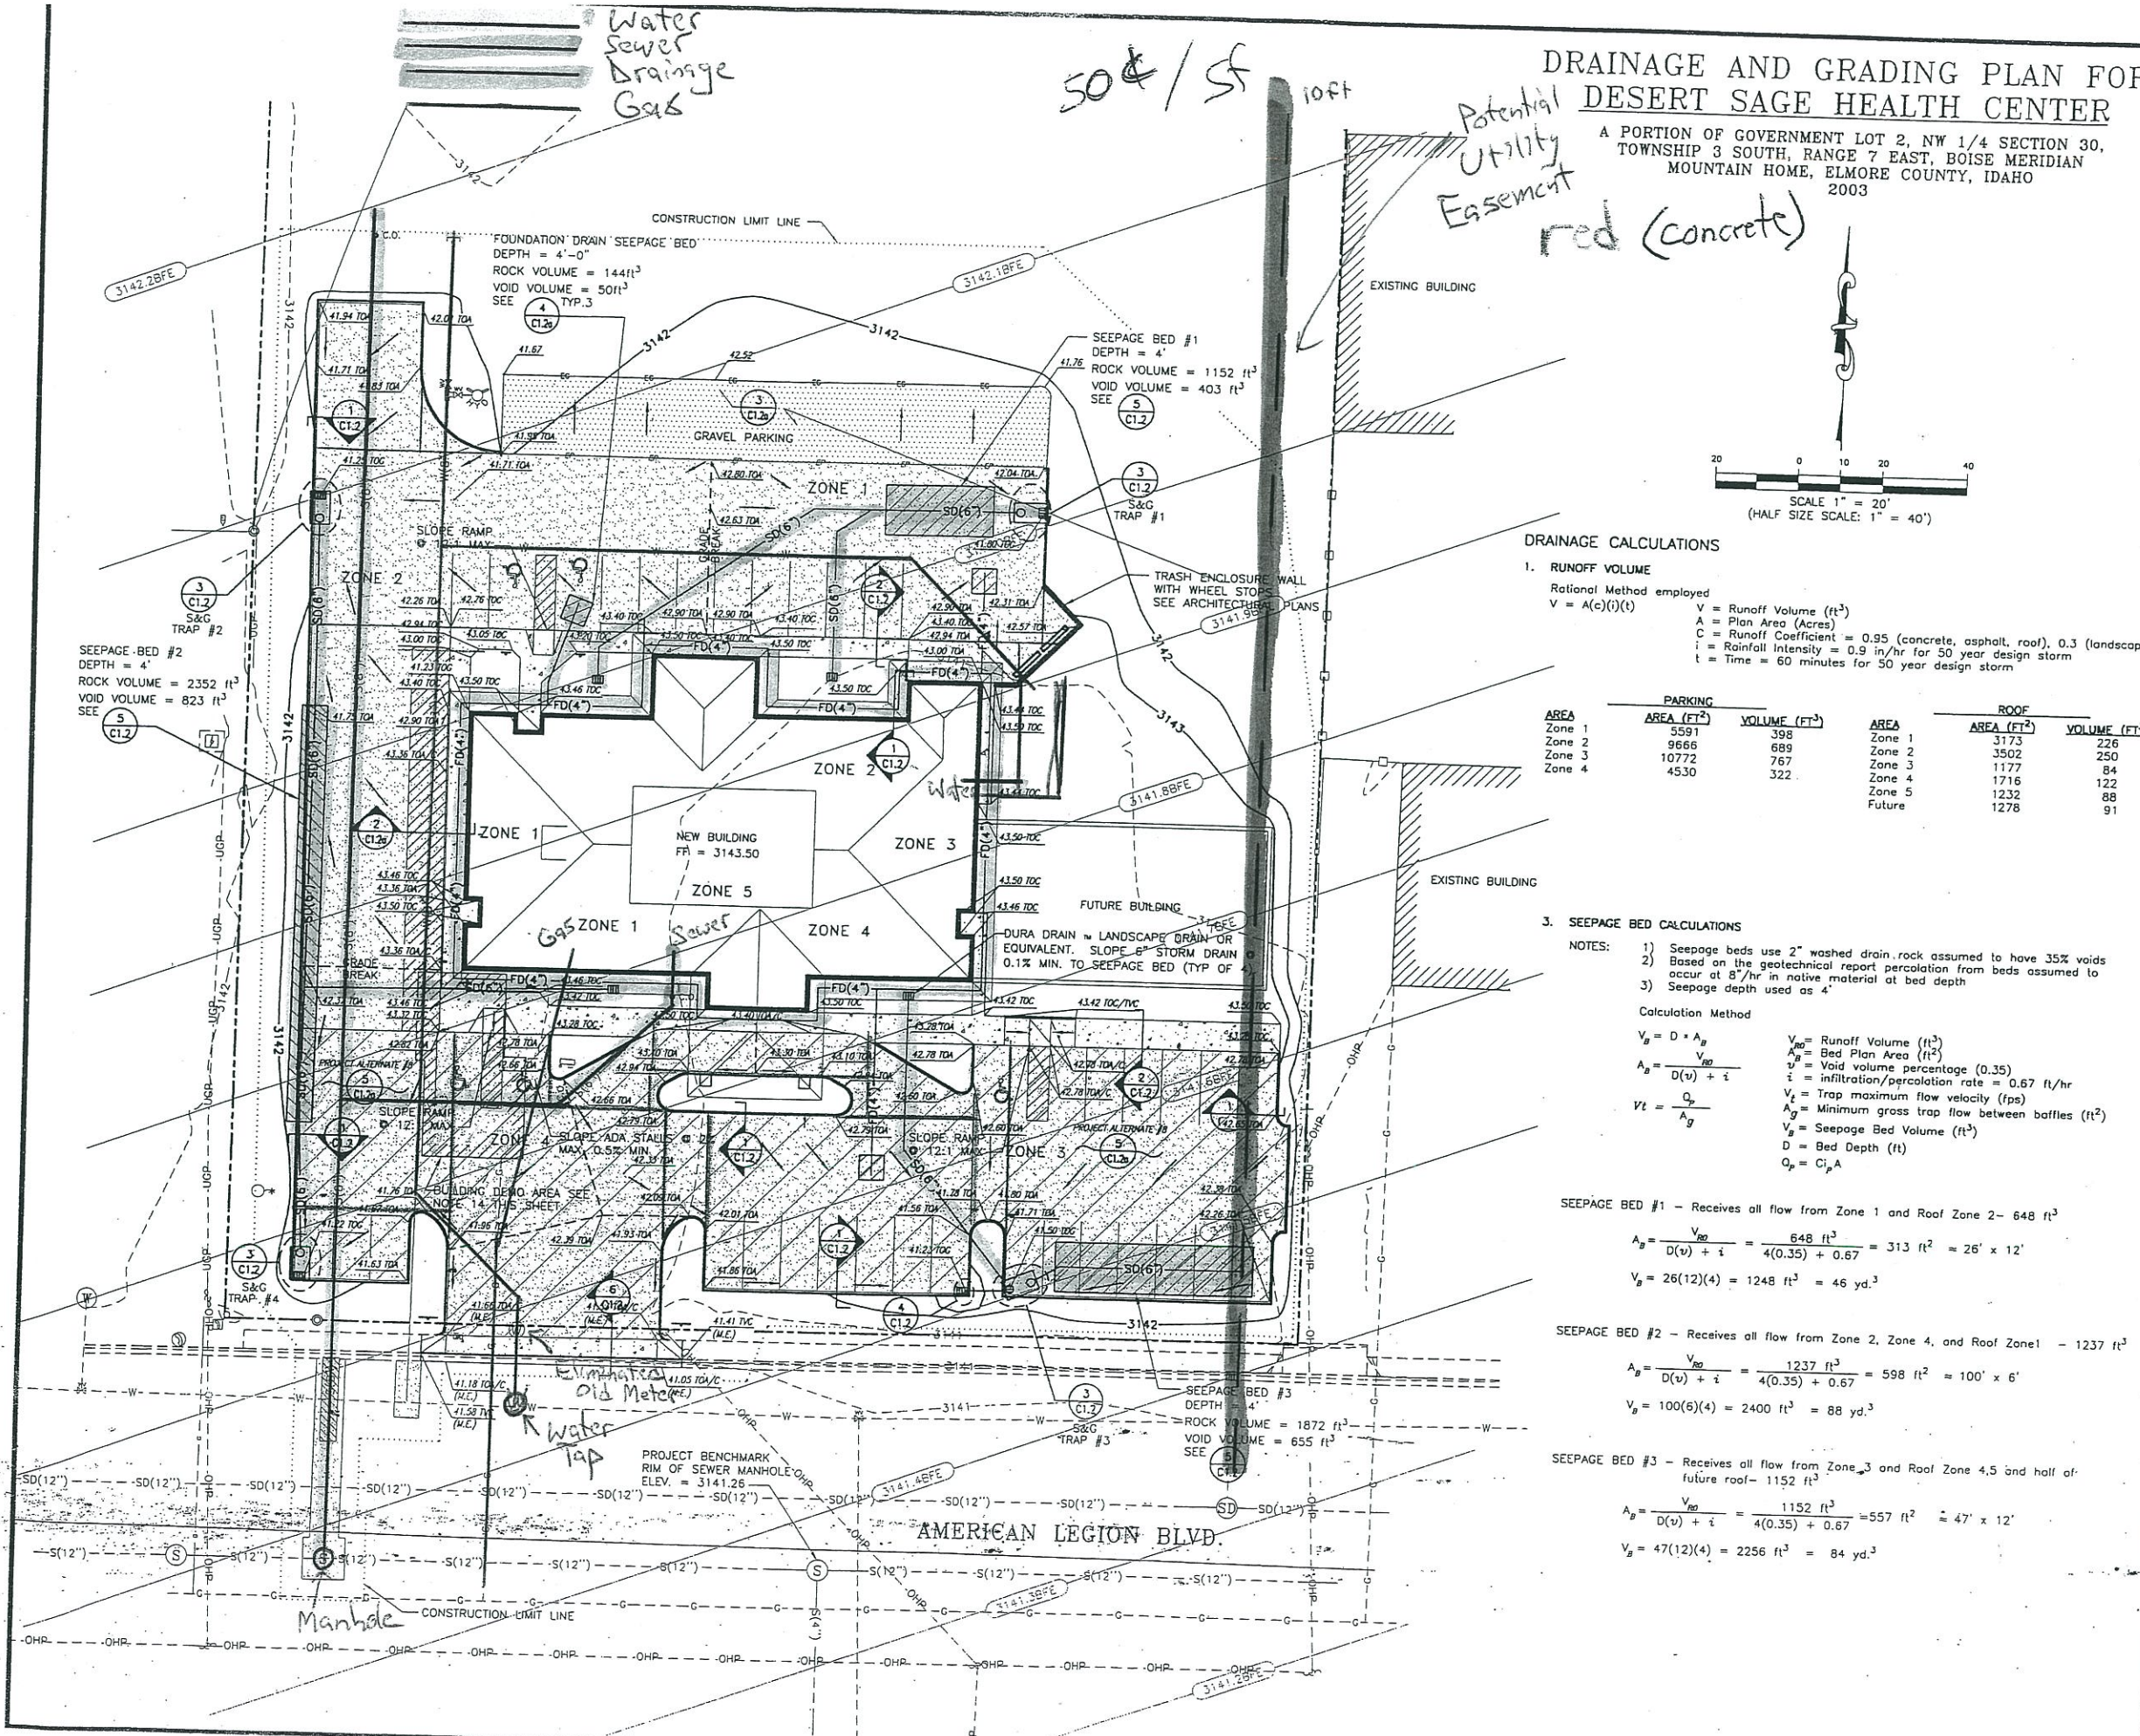

### DRAINAGE CALCULATIONS

#### 1. RUNOFF VOLUME

Rational Method employed  
 $V = A(c)(i)(t)$   
 $V$  = Runoff Volume (ft<sup>3</sup>)  
 $A$  = Plan Area (Acres)  
 $C$  = Runoff Coefficient = 0.95 (concrete, asphalt, roof), 0.3 (landscape)  
 $i$  = Rainfall Intensity = 0.9 in/hr for 50 year design storm  
 $t$  = Time = 60 minutes for 50 year design storm

AREA	PARKING		ROOF	
	AREA (FT <sup>2</sup> )	VOLUME (FT <sup>3</sup> )	AREA (FT <sup>2</sup> )	VOLUME (FT <sup>3</sup> )
Zone 1	5591	398	3173	226
Zone 2	9668	689	3502	250
Zone 3	10772	767	1177	84
Zone 4	4530	322	1716	122
			1232	88
			1278	91

#### 3. SEEPAGE BED CALCULATIONS

- NOTES:
- Seepage beds use 2" washed drain rock assumed to have 35% voids
  - Based on the geotechnical report percolation from beds assumed to occur at 8"/hr in native material at bed depth
  - Seepage depth used as 4'

Calculation Method  
 $V_b = D \cdot A_b$   
 $A_b = \frac{V_{no}}{D(v) + i}$   
 $V_t = \frac{Q_p}{A_g}$   
 $D = \text{Bed Depth (ft)}$   
 $Q_p = C_i \cdot A$   
 $V_{no}$  = Runoff Volume (ft<sup>3</sup>)  
 $A_b$  = Bed Plan Area (ft<sup>2</sup>)  
 $v$  = Void volume percentage (0.35)  
 $i$  = infiltration/percolation rate = 0.67 ft/hr  
 $V_t$  = Trap maximum flow velocity (fps)  
 $A_g$  = Minimum gross trap flow between baffles (ft<sup>2</sup>)  
 $V_b$  = Seepage Bed Volume (ft<sup>3</sup>)  
 $D$  = Bed Depth (ft)  
 $Q_p$  = C<sub>i</sub> · A

SEEPAGE BED #1 - Receives all flow from Zone 1 and Roof Zone 2 - 648 ft<sup>3</sup>

$$A_b = \frac{V_{no}}{D(v) + i} = \frac{648 \text{ ft}^3}{4(0.35) + 0.67} = 313 \text{ ft}^2 = 26' \times 12'$$

$$V_b = 26(12)(4) = 1248 \text{ ft}^3 = 46 \text{ yd}^3$$

SEEPAGE BED #2 - Receives all flow from Zone 2, Zone 4, and Roof Zone 1 - 1237 ft<sup>3</sup>


$$A_b = \frac{V_{no}}{D(v) + i} = \frac{1237 \text{ ft}^3}{4(0.35) + 0.67} = 598 \text{ ft}^2 = 100' \times 6'$$

$$V_b = 100(6)(4) = 2400 \text{ ft}^3 = 88 \text{ yd}^3$$

SEEPAGE BED #3 - Receives all flow from Zone 3 and Roof Zone 4,5 and half of future roof - 1152 ft<sup>3</sup>


$$A_b = \frac{V_{no}}{D(v) + i} = \frac{1152 \text{ ft}^3}{4(0.35) + 0.67} = 557 \text{ ft}^2 = 47' \times 12'$$

$$V_b = 47(12)(4) = 2256 \text{ ft}^3 = 84 \text{ yd}^3$$

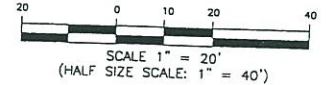


C:\CIVIL\003621B.dwg\003621B.dwg D&G DETAILS, 3/23/2004 8:28:52 AM  
 FACILE ENGINEERS INC. - ALL RIGHTS RESERVED

- NOTES:
- IF GROUND WATER IS ENCOUNTERED WITHIN THREE FEET OF THE BOTTOM OF THE DRAIN ROCK LAYER CONTACT THE ENGINEER TO REVISE THE SEEPAGE BED DIMENSIONS.
  - SEASONAL HIGH GROUND WATER AND FREE DRAINING MATERIAL ELEVATIONS ARE BASED UPON AVAILABLE GEOTECHNICAL INFORMATION AND MAY VARY FROM REPORTED VALUES.

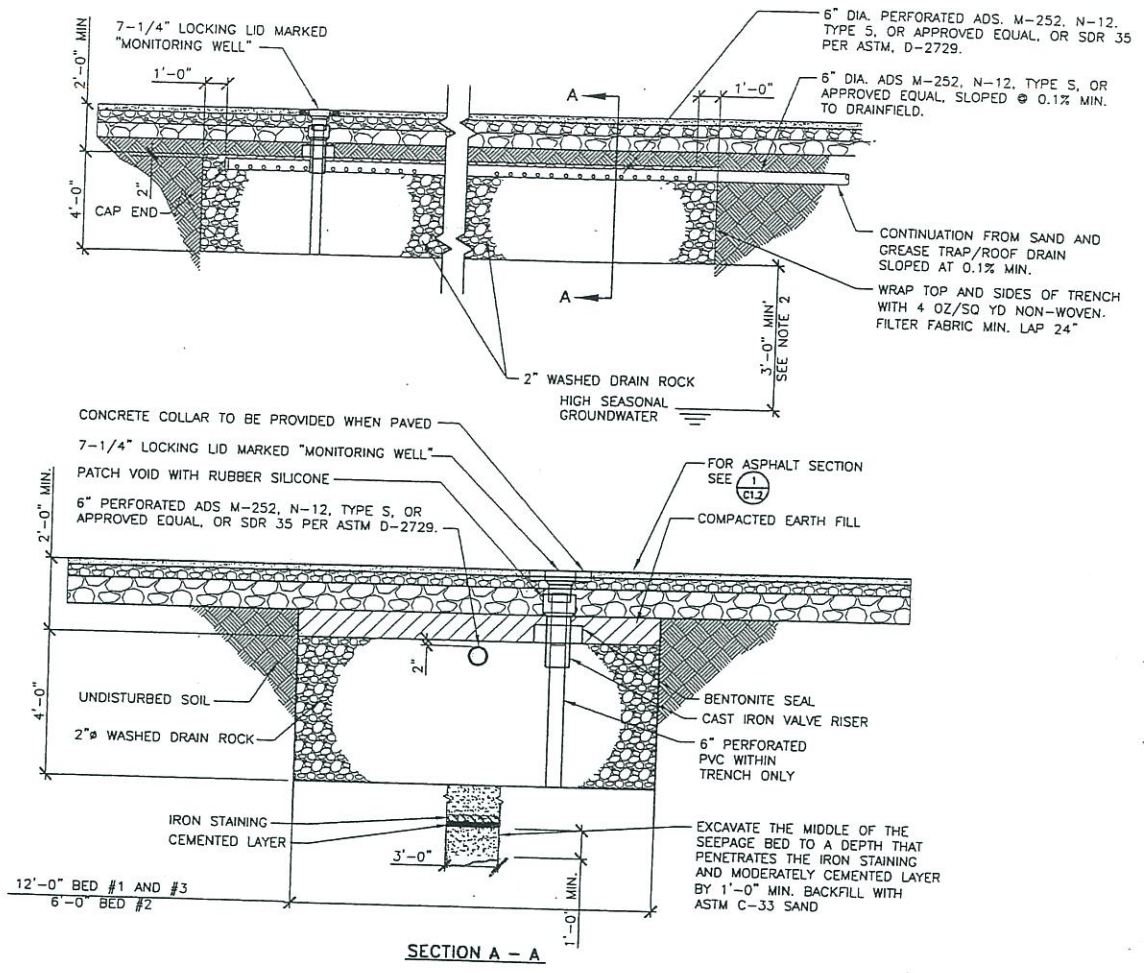

14 ft on all


5 SEEPAGE BED

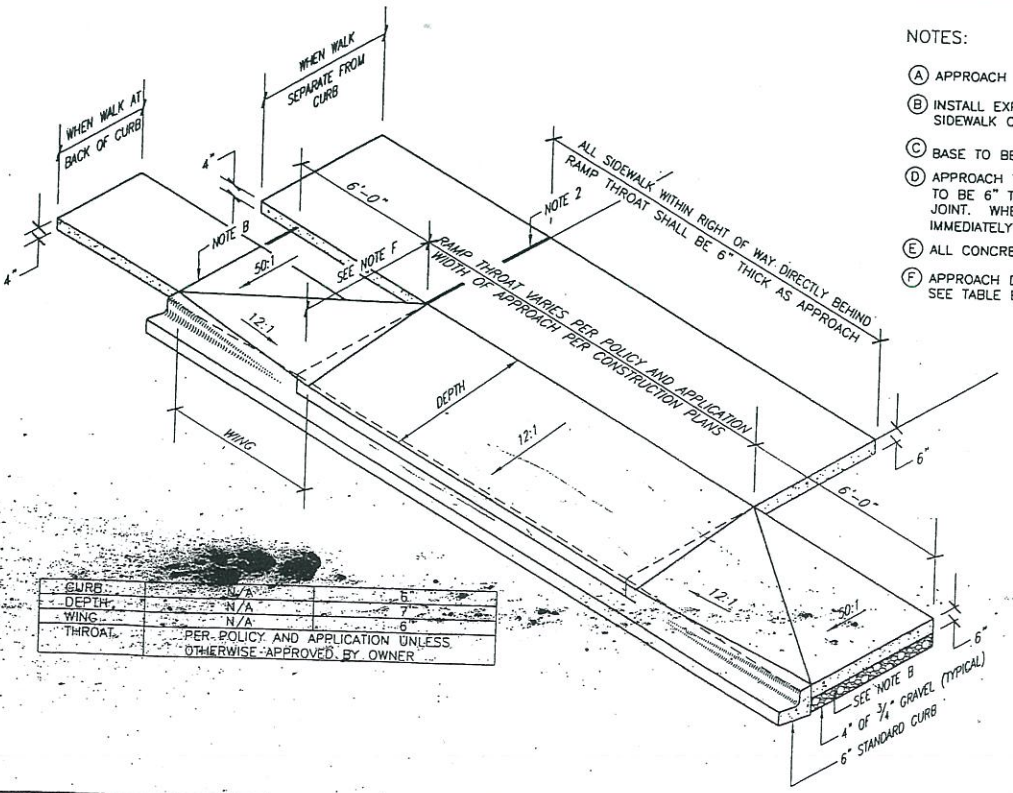





- NOTES:
- APPROACH TO CONFORM TO THE LATEST ADA STANDARDS.
  - INSTALL EXPANSION JOINT AT TIP OF APPROACH WINGS AND WHERE SIDEWALK CHANGES THICKNESS.
  - BASE TO BE A 4" THICKNESS OF 3/4" CRUSHED AGGREGATE PER SECTION-802.
  - APPROACH THROAT WIDTHS SET BY POLICY AND APPLICATION. ALL CONCRETE TO BE 6" THICK FROM TIP OF WING TO TIP OF WING UP TO THE EXPANSION JOINT. WHEN SIDEWALK IS SEPARATE FROM CURB THE SIDEWALK IMMEDIATELY BEHIND THE APPROACH THROAT SHALL BE 6" THICK ALSO.
  - ALL CONCRETE SHALL BE CLASS 3000 PER SECTION-703.
  - APPROACH DIMENSIONS ARE BASED ON THE HEIGHT OF THE CURB. SEE TABLE BELOW.

CURB	N/A	6
DEPTH	N/A	7
WING	N/A	6
THROAT	PER POLICY AND APPLICATION UNLESS OTHERWISE APPROVED BY OWNER	6

4 INLET CATCH BASIN

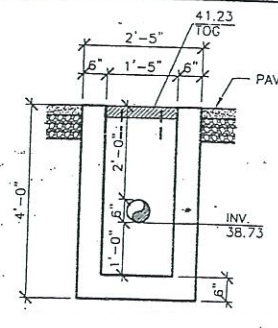

3 1000 GALLON SAND & GREASE TRAP

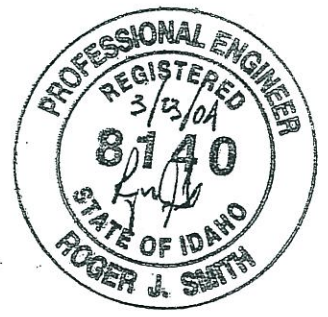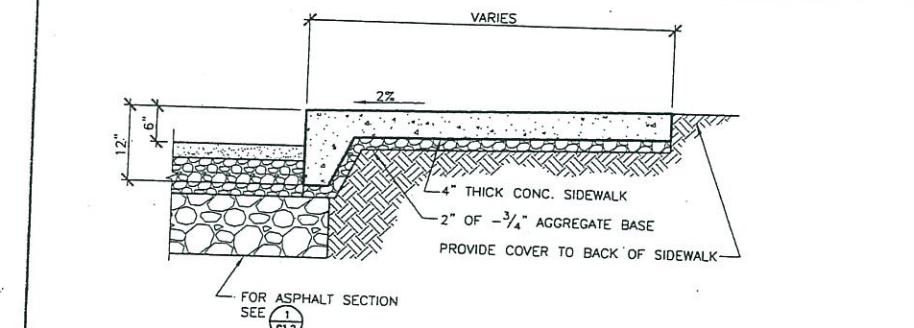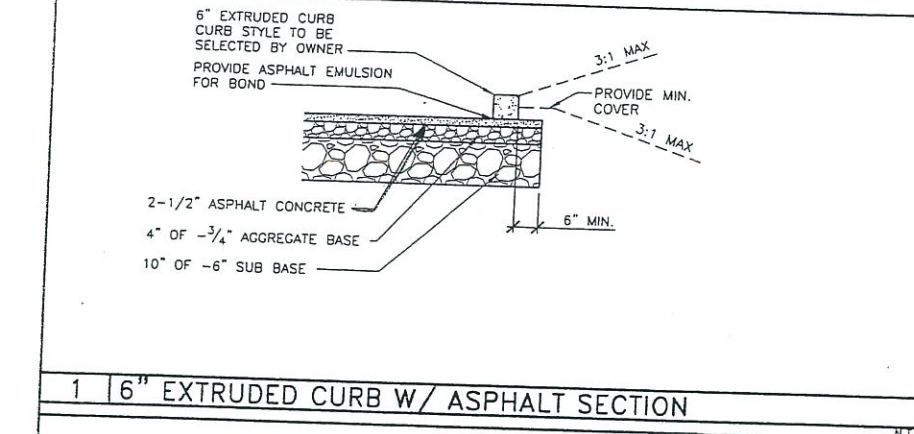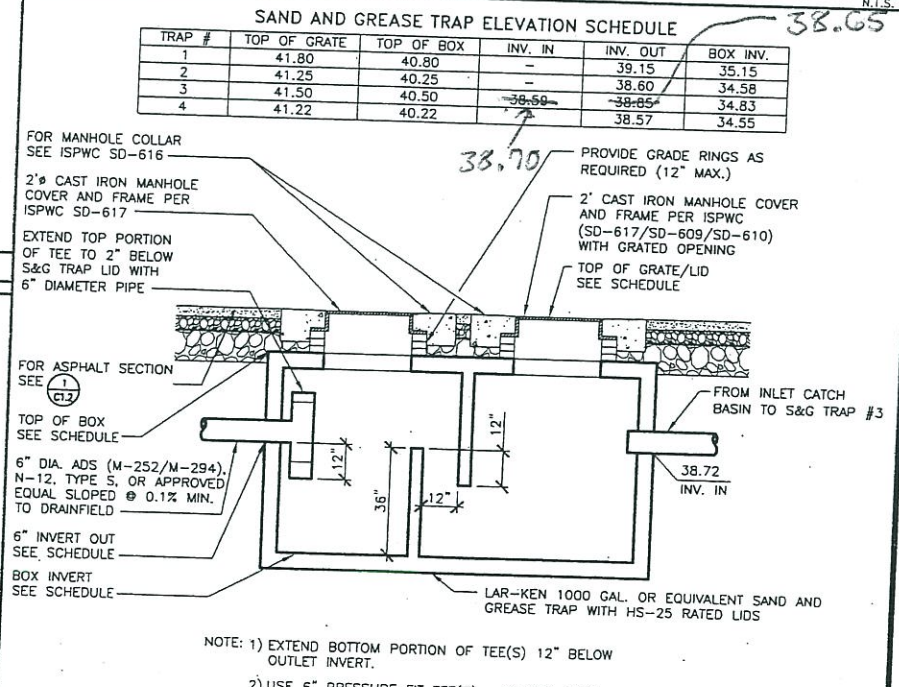

**PINNACLE**  
 Engineers, Inc.  
 12552 W. Executive Dr., Suite B, Boise, Idaho 83713  
 (208) 887-7760

**Medical Design Group**  
 Architecture for Health Care  
 2716 WESTLAND PLACE  
 BOISE, IDAHO 83704-5863  
 BOISEARCHITECT@AOL.COM  
 Fax (208) 378-1405  
 Phone (208) 378-0817

DRAINAGE AND GRADING DETAILS



Desert Sage Health Center  
 2280 American Legion Blvd.  
 Mountain Home, Idaho

SHEET  
 C1.2


Dec' 2003 PLOTDATE 12/00/03

C:\C036218.dwg, C:\C036218\_BS.dwg, D&G DETAILS (2), 3/23/2004 8:29:02 AM, CIVIL ENGINEERS INC. ALL RIGHTS RESERVED

1. IF GROUND WATER IS ENCOUNTERED WITHIN THREE FEET OF THE BOTTOM OF THE DRAIN ROCK LAYER CONTACT THE ENGINEER TO REVISE THE SEEPAGE BED DIMENSIONS.
2. SEASONAL HIGH GROUND WATER AND FREE DRAINING MATERIAL ELEVATIONS ARE BASED UPON AVAILABLE GEOTECHNICAL INFORMATION AND MAY VARY FROM REPORTED VALUES.

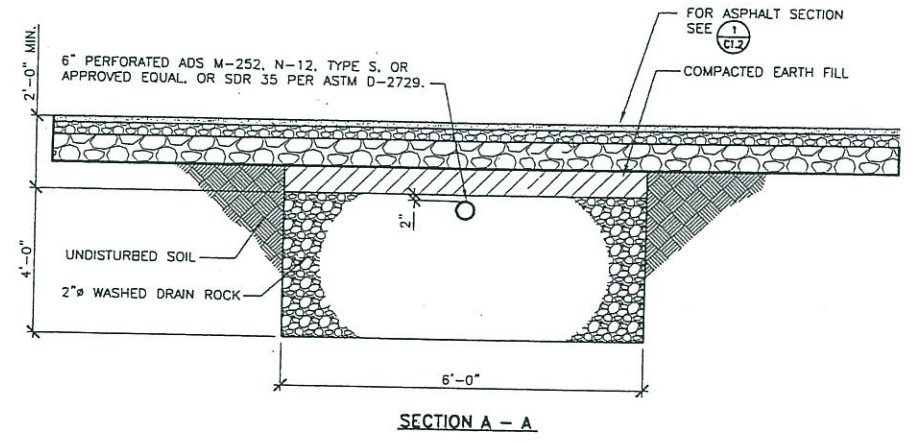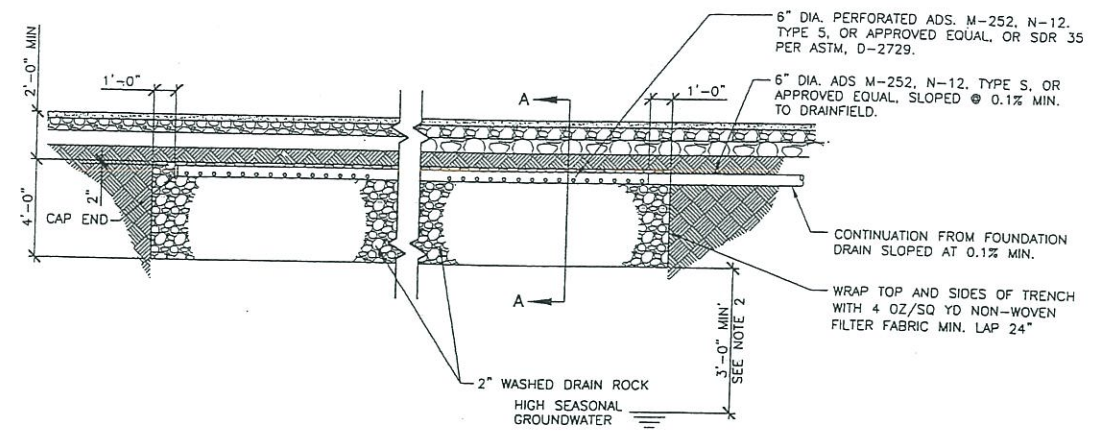


4 FOUNDATION DRAIN SEEPAGE BED

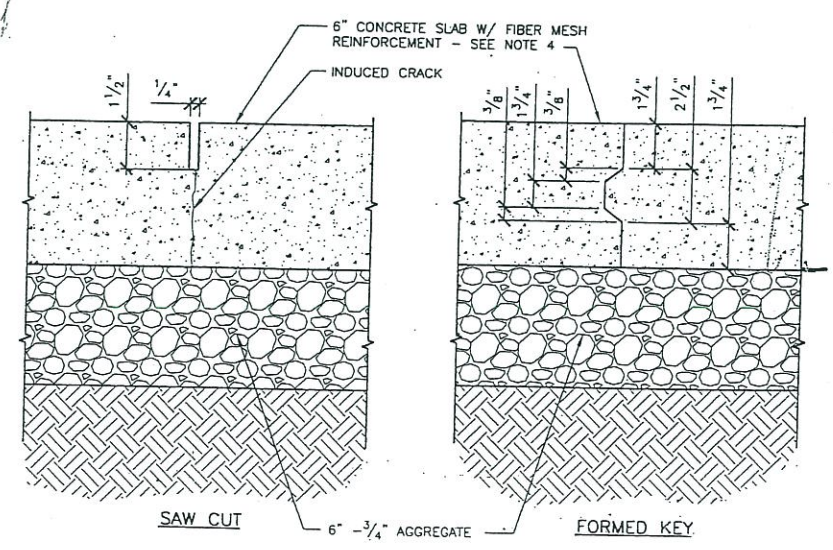

- NOTES:
- 1) CONTROL JOINT SPACING IS 30'-0" O.C. EACH WAY.
  - 2) CONTRACTORS OPTION TO USE EITHER SAWED OR FORMED JOINT.
  - 3) SAW CUT TO BE MADE WITHIN 24 HRS.
  - 4) FIBERMESH FIBERS ARE COLLATED FIBRILLATED POLYPROPYLENE OLEFIN FIBERS OR EQUAL 3/4 INCH IN LENGTH. ADD FIBERMESH FIBERS AT A MINIMUM RATE OF 1.5 lbs/cu. yd.
  - 5) REFER TO THE GEOTECHNICAL REPORT REGARDING EXISTING CLAY SOIL REMOVAL AND SITE PREPARATION.


5 6" CONCRETE @ PARKING SECTION WITH CONTROL JOINT - ADD ALTERNATE #8

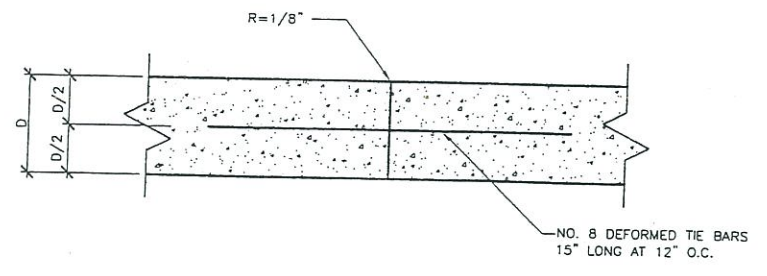


TIED TRANSVERSE CONSTRUCTION JOINT ALTERNATIVE - TYPE D

NOTE: MATCH NEW TO EXISTING CONCRETE AND GRAVEL BASE DIMENSIONS


1 CONCRETE PAVEMENT JOINTING (SD-714A)

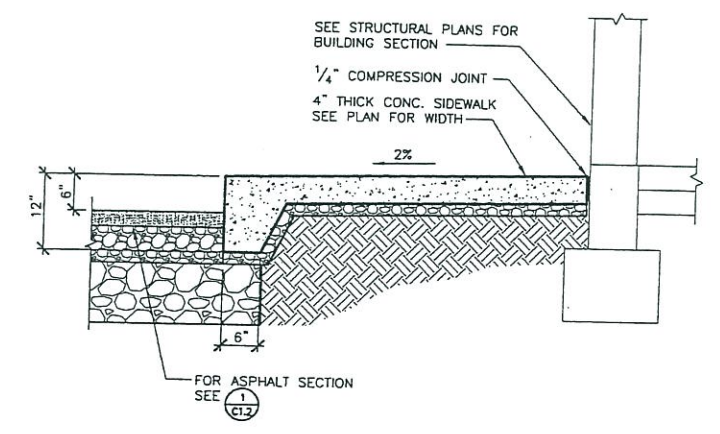


2 TURNED-DOWN SIDEWALK AT BUILDING FOUNDATION

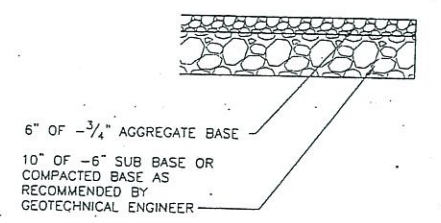

3 GRAVEL SECTION

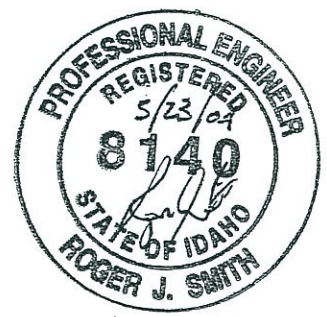

**PINNACLE**  
Engineers, Inc.  
12552 W. Executive Dr., Suite B, Boise, Idaho 83713  
(208) 887-7760

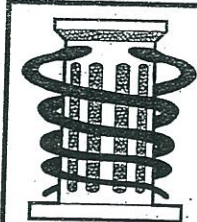

**Medical Design Group**  
Architecture for Health Care  
2716 WESTLAND PLACE  
BOISE, IDAHO 83704-5863  
BOISEARCHITECT@AOL.COM  
Fax (208) 378-1405  
Phone (208) 378-0817

© COPYRIGHT: MEDICAL DESIGN GROUP

DRAINAGE AND GRADING DETAILS


Desert Sage Health Center  
2280 American Legion Blvd.  
Mountain Home, Idaho

SHEET  
C1.2a


Dec 2003 PLOTDATE 12/00/03

A:\CIVIL\03036218\dwg\03036218\_BS.dwg, SEWER PROFILE, 3/23/2004 8:29:10 AM, PINNACLE ENGINEERS INC. ALL RIGHTS RESERVED

Handicap Signs  
 Stop/Fasten Seat Belt Signs

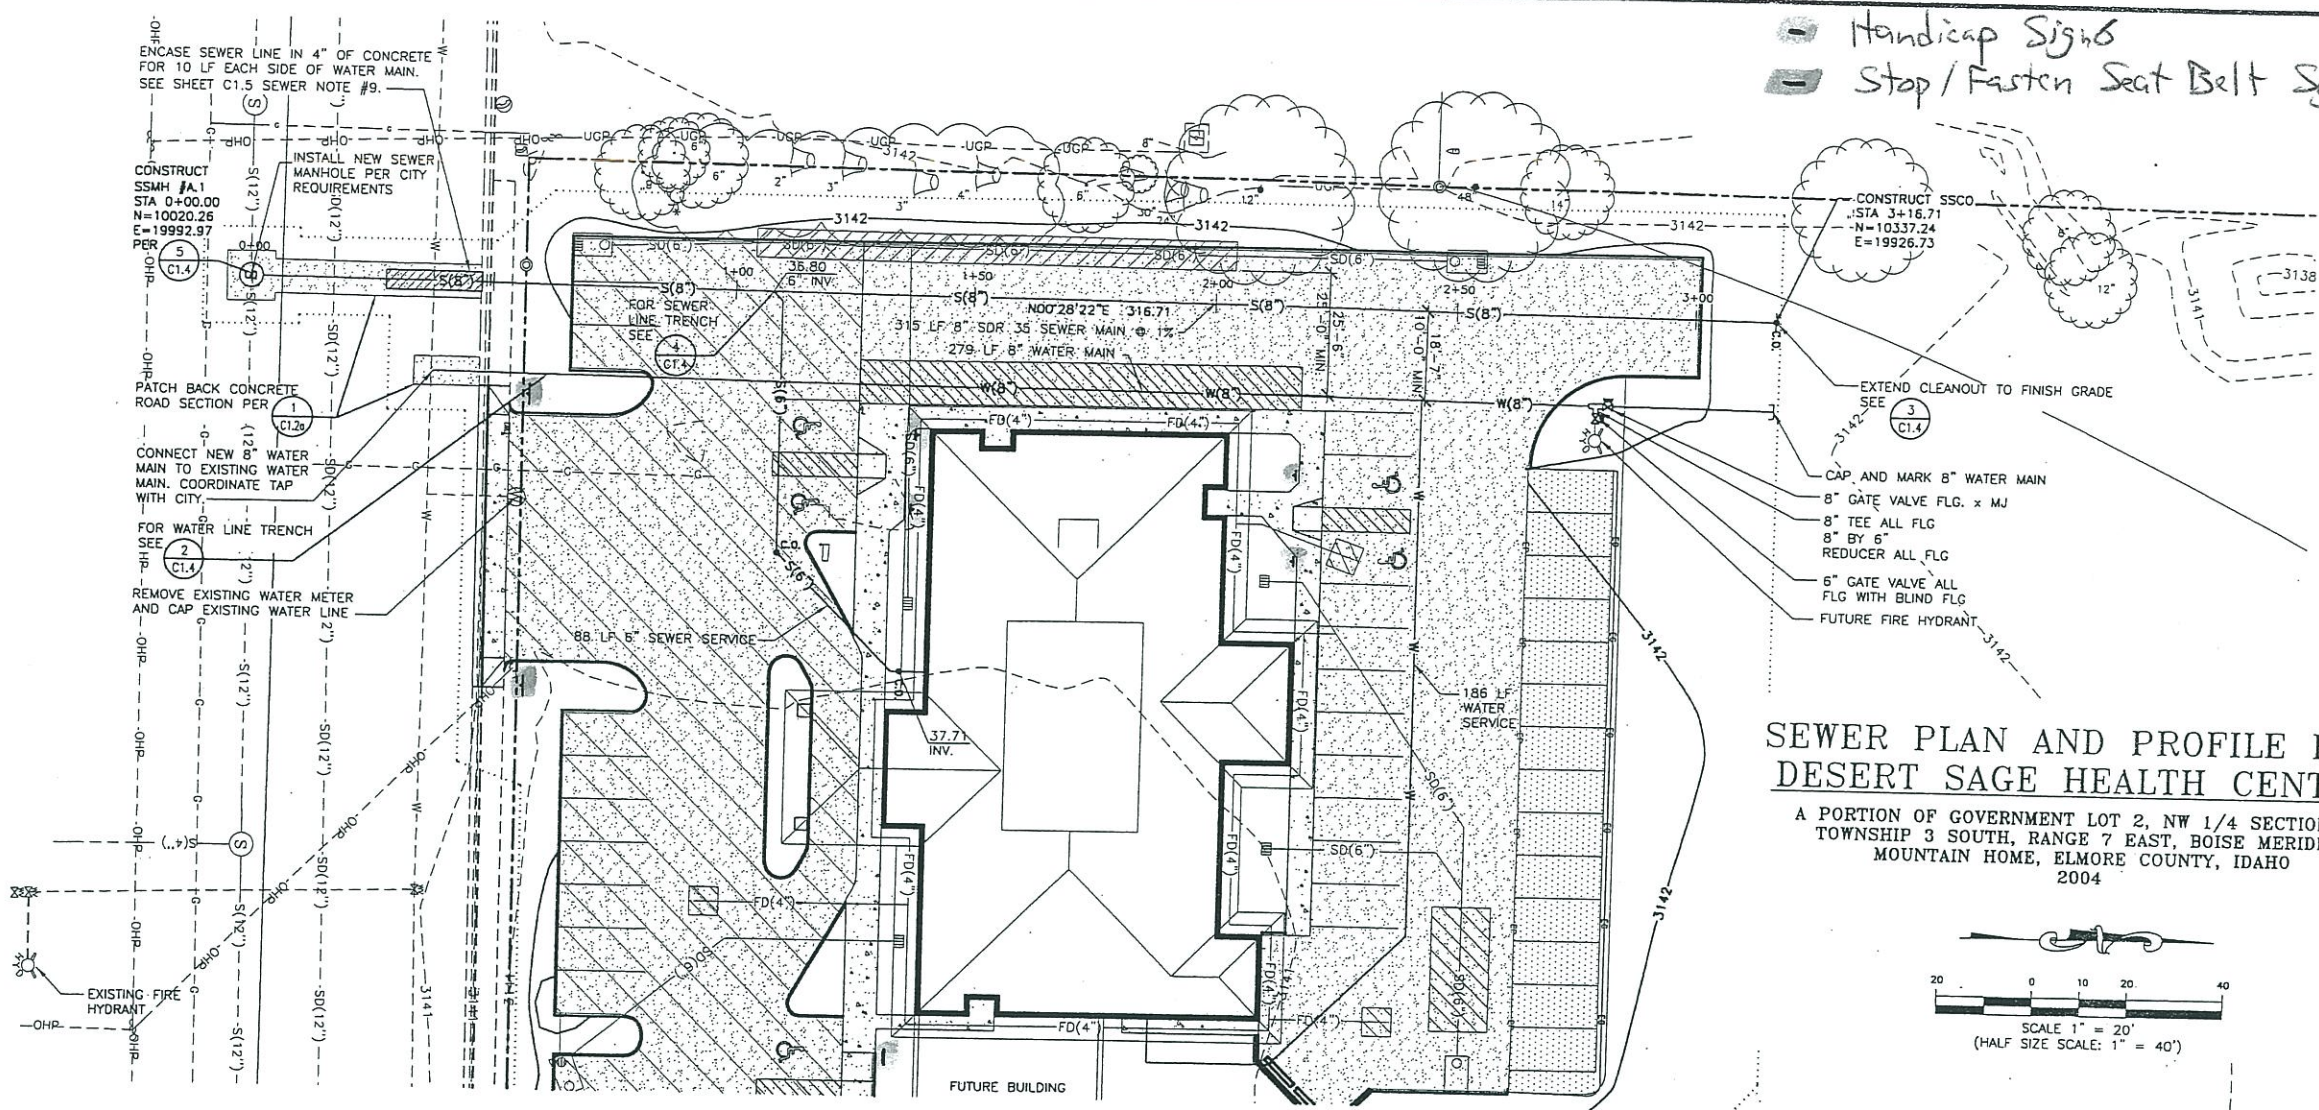


**SEWER PLAN AND PROFILE FOR  
 DESERT SAGE HEALTH CENTER**  
 A PORTION OF GOVERNMENT LOT 2, NW 1/4 SECTION 30,  
 TOWNSHIP 3 SOUTH, RANGE 7 EAST, BOISE MERIDIAN  
 MOUNTAIN HOME, ELMORE COUNTY, IDAHO  
 2004

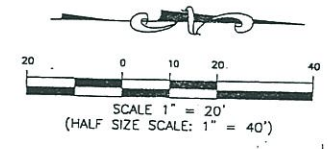

**UTILITY NOTES:**

- Any fire service shall be sized and installed by the fire service contractor.
- The contractor shall install a reduced pressure backflow assembly (RPBA) for each water or fire service entering the building.
- Refer to the mechanical plans for the water and/or fire service connection(s) at the building and for backflow protection. Coordinate with the water company for taps and metering.
- For thrust blocking see detail 1 sheet C1.5
- Verify the sewer connection at the building with the mechanical plans.
- The gas service shall be sized and installed by the plumbing contractor and/or gas company.
- The power transformer and service lines (primary and secondary) shall be sized and installed by the electrical engineer, electrical contractor, and/or power company. Refer to the electrical plans for further details.
- See sheet C1.5 for utility details.
- If any utility or irrigation facility interferes with required street improvements, all such utilities or irrigation facilities shall be relocated at the owner's expense so as not to interfere with required street improvements.
- All water valves, blow-offs, and manholes shall be graded and placed so as not to conflict with any concrete curb and gutter, valley gutter, or sidewalk improvements.
- All construction within the public right-of-way shall conform to the latest edition of the I.S.P.W.C. specifications. No exceptions to district policy, standards, or the I.S.P.W.C. will be allowed unless specifically and previously approved in writing by the district.
- See Architectural and mechanical plans for Pressure Irrigation.
- New water meter to be remote read per City of Mountain Home. See Mechanical plans for placement of meter.

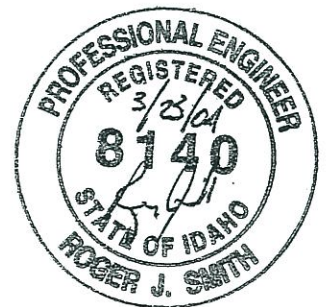


**PINNACLE**  
 Engineers, Inc.  
 12552 W. Executive Dr., Suite B, Boise, Idaho 83713  
 (208) 887-7760



**Medical Design Group**  
 Architecture for Health Care  
 2716 WESTLAND PLACE  
 BOISE, IDAHO 83704-5863  
 BOISEARCHITECT@AOL.COM  
 Fax (208) 378-1405  
 Phone (208) 378-0817

© COPYRIGHT: MEDICAL DESIGN GROUP

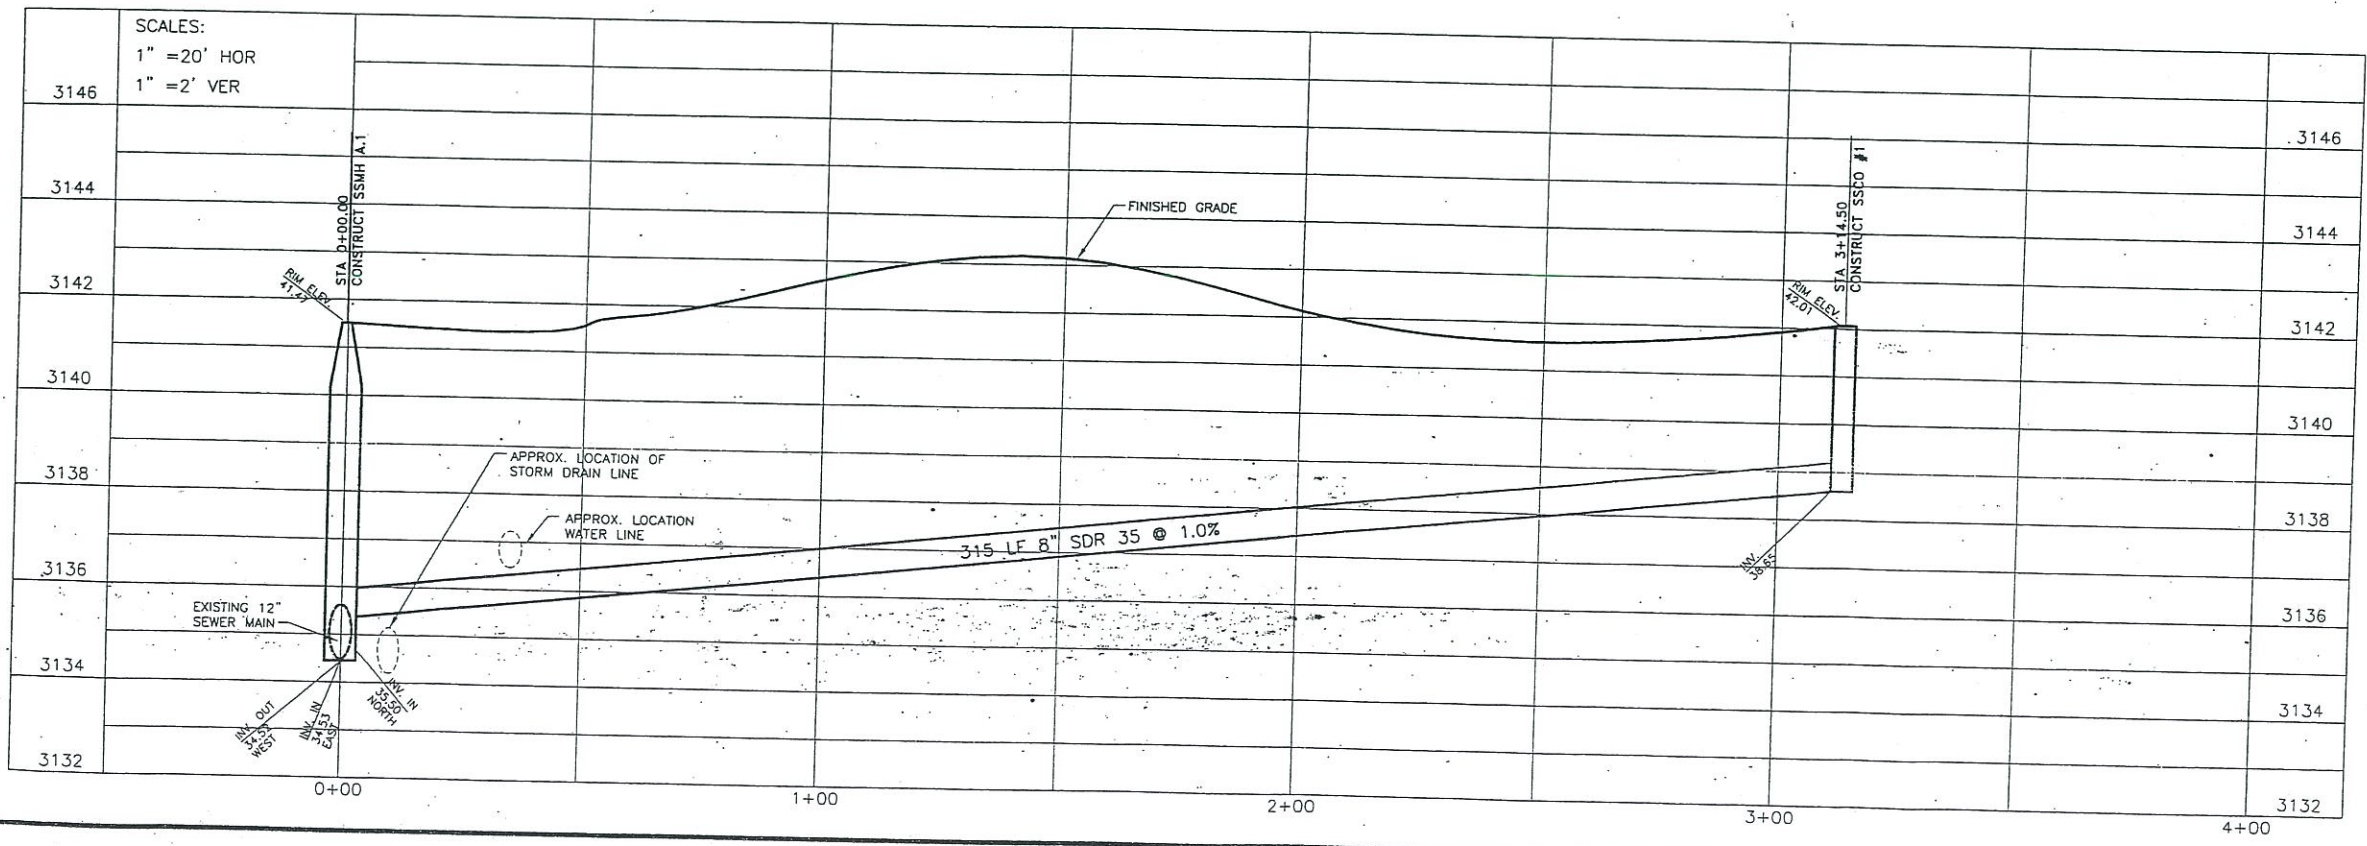


**SEWER PLAN AND PROFILE**

Desert Sage Health Center  
 2280 American Legion Blvd.  
 Mountain Home, Idaho

SHEET  
**C1.3**


A:\CIVIL\CO36218.dwg \CO36218\_BS.dwg, UTILITY DETAILS, 3/23/2004 8:29:21 AM, Pinnacle Engineers Inc. All Rights Reserved

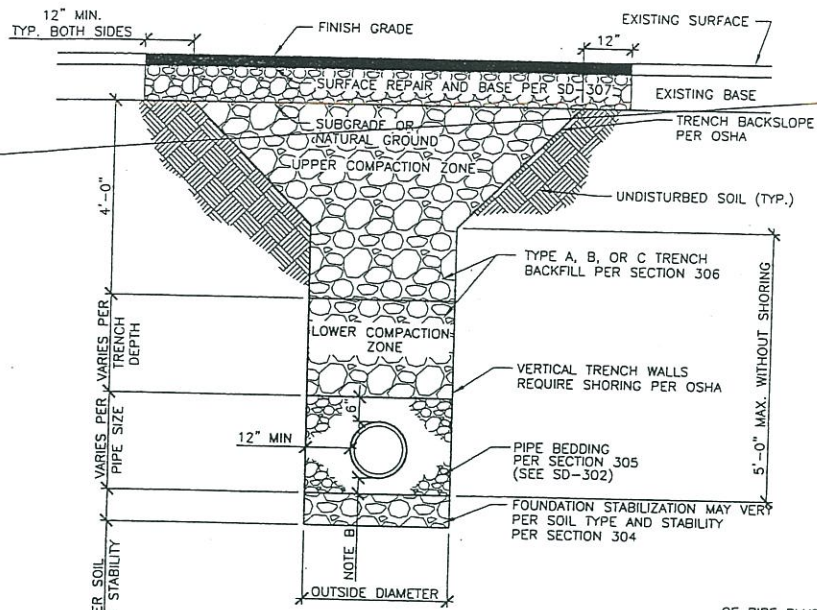

OF PIPE PLUS 2'-0"

- (A) TRENCH EXCAVATION PER SECTION-301
- (B) PIPE BEDDING PER SECTION-305
- (C) BACKFILL AND COMPACTION PER SECTION-306

4 TYPICAL TRENCH

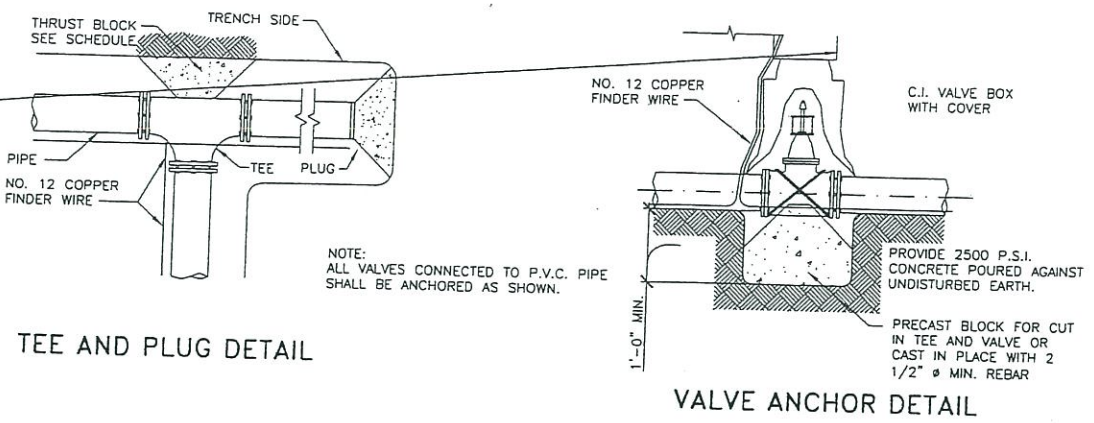

TEE AND PLUG DETAIL


VALVE ANCHOR DETAIL

MINIMUM THRUST BLOCK BEARING AREAS (FT. <sup>2</sup> )					
PIPE SIZE	TEE	90° BEND	45° BEND	22 1/2° BEND	11 1/4° BEND
8"	5.0	--	--	--	--


1 THRUST BLOCK DETAIL PER ISPWC SD-403

- LEGEND
- ① 4-1" DIA. HOLES ON 3 1/2" RADIUS.
  - ② MECHANICAL PLUG
  - ③ 12" DIA. x 1'-0" PVC, DIP OR CP.
  - ④ FIBER JOINT PACKING.
  - ⑤ PVC ASTM 3034.
  - ⑥ 45° BENDS.
  - ⑦ Y FITTINGS.
  - ⑧ EXISTING OR NEW PIPE.
  - ⑨ TYPE 1 BEDDING MATERIAL.
  - ⑩ MISSION COUPLER OR APPROVED SUBSTITUTION.
  - ⑪ UNDISTURBED MATERIAL.
  - ⑫ SEWER CAP

- NOTES: (PIPE INSTALLATION)
1. EXCAVATE BELL HOLES ON TRENCH BOTTOM AT PIPE JOINTS. BACKFILL W/ SELECTED EARTH AS DIRECTED.
  2. BEDDING TO EXTEND AS REQUIRED BELOW PIPE BELL OR BOTTOM OF PIPE, WHICHEVER IS LOWER IN ELEVATION.
  3. BEDDING TO BE PLACED 4" WIDER THAN PIPE SPRING LINE
  4. ALL WATER PIPE SHALL BE AWWA C900 PIPE WITH C.I. FITTINGS CONFORMING TO AWWA C153.

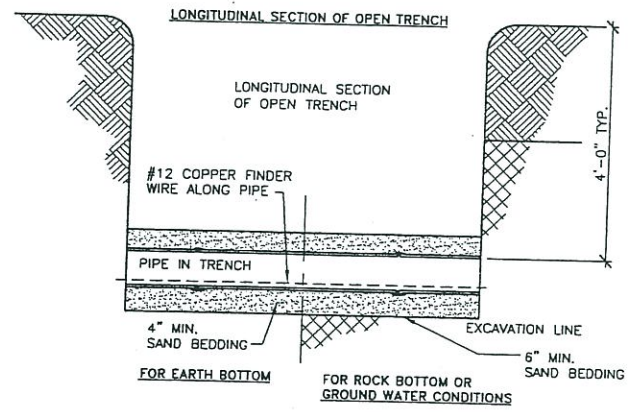


2 WATER TRENCH SECTION

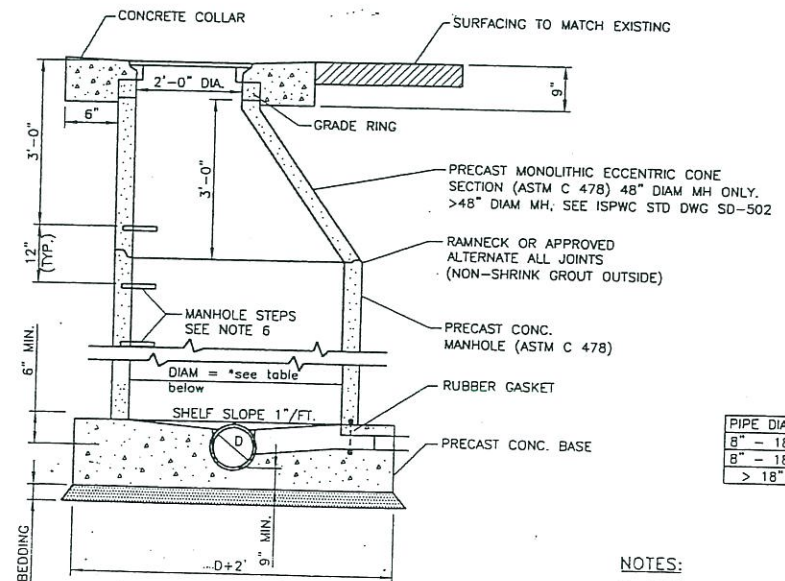


PIPE DIAM	DEPTH	REQUIRED MANHOLE DIAM
8" - 18"	<=18'	48"
8" - 18"	>18'	60"
> 18"	ANY DEPTH	60"

- NOTES:
1. VERTICAL WALL SHALL BE PLACED ON UPSTREAM SIDE OF MANHOLE, ROTATED 45°.
  2. MANHOLE FRAME AND COVER:
    - A. FRAME AND COVER SHALL BE FLUSH WITH SLOPE AND PAVEMENT.
  3. GRADE RINGS SHALL NOT EXCEED 1'-0" IN HEIGHT.
  4. WHERE PVC IS UTILIZED, A RUBBER RING IS TO BE INSTALLED WHERE THE PIPE IS IN CONTACT WITH MANHOLE BASE AND/OR MANHOLE CHANNEL, IN ORDER TO ENSURE A WATERTIGHT SEAL.
  5. A CONCENTRIC CONE SHALL BE USED ON MANHOLES 4'-0" DEEP AND LESS.
  6. MANHOLES MORE THAN 4'-0" DEEP SHALL BE EQUIPPED WITH STEPS CONFORMING TO MOUNTAIN HOME STANDARD SPECIFICATIONS.

5 STANDARD MANHOLE DETAIL

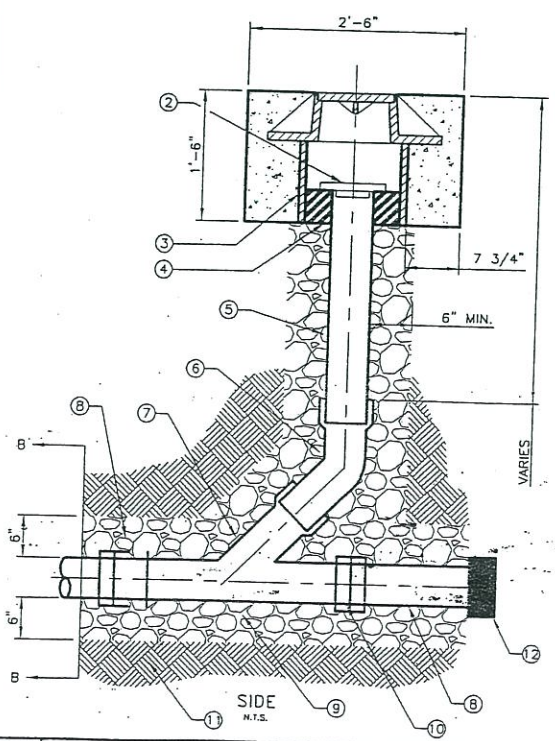


3 CLEAN OUT

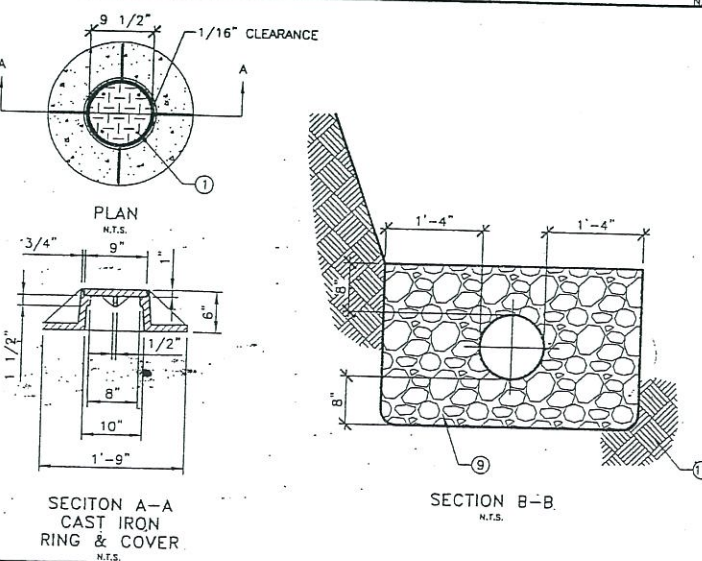

SECTION A-A CAST IRON RING & COVER N.T.S.

SECTION B-B N.T.S.

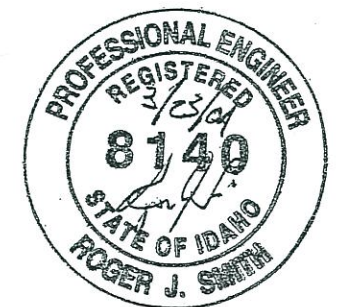

**PINNACLE**  
Engineers, Inc.  
12552 W. Executive Dr., Suite B, Boise, Idaho 83713  
(208) 887-7760



**Medical Design Group**  
Architecture for Health Care  
2716 WESTLAND PLACE  
BOISE, IDAHO 83704-5863  
BOISEARCHITECT@AOL.COM  
Fax (208) 378-1405  
Phone (208) 378-0817

© COPYRIGHT MEDICAL DESIGN GROUP

UTILITY DETAILS

Desert Sage Health Center  
2280 American Legion Blvd.  
Mountain Home, Idaho

SHEET  
C1.4

Dec 2003 PLOTDATE 12/00/03

1-C:\CIVIL\0036218\dwg\0036218\_BS.dwg, NOTES, 3/23/2004 8:29:28 AM, Pinnacle Engineers Inc. All Rights Reserved

GENERAL:

1. THE LOCATION OF EXISTING UNDERGROUND UTILITIES ARE SHOWN APPROXIMATELY ONLY PRIOR TO CONSTRUCTION. IT SHALL BE THE RESPONSIBILITY OF THE CONTRACTOR TO INFORM ALL UTILITY COMPANIES OF THE CONSTRUCTION SCHEDULE. THE CONTRACTOR SHALL DETERMINE THE EXACT LOCATION OF ALL EXISTING UTILITIES BEFORE COMMENCING WORK. THE CONTRACTOR IS RESPONSIBLE FOR ANY AND ALL DAMAGE WHICH MAY OCCUR BY FAILURE TO CALL DIGLINE INC. BEFORE COMMENCING UNDERGROUND WORK, 342-1585.
2. ALL WORK SHALL CONFORM TO THE LATEST EDITION OF THE "IDAHO STANDARDS FOR PUBLIC WORKS CONSTRUCTION (I.S.P.W.C.), AND /OR THE REQUIREMENTS OF THE IDAHO DEPARTMENT OF TRANSPORTATION.
3. THE CONTRACTOR(S) SHALL REMOVE ALL OBSTRUCTIONS ABOVE AND BELOW GROUND REQUIRED FOR THE CONSTRUCTION OF THE PROPOSED IMPROVEMENTS. THIS WORK INCLUDES CLEARING AND GRUBBING, WHICH INCLUDES CLEARING THE GROUND SURFACE OF ALL TREES, STUMPS, BRUSH, UNDERGROWTH, HEDGES, HEAVY GROWTH OF GRASS AND /OR WEEDS, FENCES, STRUCTURES, DEBRIS, RUBBISH, AND OTHER MATERIAL NOT SUITABLE FOR THE FOUNDATION OF PAVEMENTS AND OTHER STRUCTURES. ALL MATERIAL NOT SUITABLE FOR FUTURE USE ON-SITE SHALL BE DISPOSED OF OFF-SITE AT AN APPROVED LOCATION.
4. THE CONTRACTOR SHALL MAINTAIN EXISTING DRAINAGE FACILITIES WITHIN THE CONSTRUCTION AREA UNTIL THE DRAINAGE IMPROVEMENTS ARE IN PLACE AND APPROVED.
5. ALL CONTRACTORS WORKING WITHIN THE PROJECT BOUNDARIES ARE RESPONSIBLE FOR COMPLIANCE WITH ALL APPLICABLE SAFETY LAWS OF ANY JURISDICTIONAL BODY. THE CONTRACTOR SHALL BE RESPONSIBLE FOR ALL SAFETY DEVICES AND TRAFFIC CONTROL AROUND AND WITHIN THE CONSTRUCTION AREA.
6. ALL MATERIALS FURNISHED ON OR FOR THE PROJECT MUST MEET THE MINIMUM REQUIREMENTS OF THE APPROVING AGENCY OR AS SET FORTH WITHIN, WHICHEVER IS MOST RESTRICTIVE. PROOF THAT ALL MATERIALS USED ON THIS PROJECT MEET THE REQUIREMENTS ABOVE MUST BE PROVIDED AT THE REQUEST OF THE AGENCY AND/OR THE ENGINEER.
7. ALL UNDER GROUND UTILITIES AND SERVICE LINES SHALL BE INSTALLED PRIOR TO STREET CONSTRUCTION.
8. ALL COSTS OF RETESTING FOR PREVIOUSLY FAILED TESTS, IF REQUIRED, SHALL BE BACK CHARGED TO THE RESPONSIBLE CONTRACTOR BY THE OWNER.
9. ALL COSTS INCURRED BY THE CONTRACTOR FOR CORRECTING DEFICIENT WORK SHALL BE THE RESPONSIBILITY OF THE CONTRACTOR WHO PERFORMED THE WORK. FAILURE TO CORRECT DEFICIENT WORK WILL BE CAUSE FOR ISSUANCE OF A STOP WORK ORDER AND POSSIBLE TERMINATION.
10. ALL WORK SUBJECT TO APPROVAL BY ANY POLITICAL AGENCY OR GOVERNING AGENCY MUST BE APPROVED PRIOR TO (I) PLACING OF CONCRETE, (II) PLACING OF AGGREGATE BASE, (III) PLACING OF ASPHALT PAVING, (IV) BACKFILLING TRENCHES. WORK PERFORMED WITHOUT SUCH APPROVAL SHALL NOT RELIEVE THE CONTRACTOR FROM THE RESPONSIBILITY OF PERFORMING THE WORK TO THE REQUIRED STANDARDS.
11. STANDARD DRAWING NUMBERS, REFERENCED IN THESE NOTES, WHICH BEGIN WITH "SD" ARE FROM THE I.S.P.W.C. STANDARD DRAWINGS (2003 ED.).
12. THE CONTRACTOR IS TO ENSURE THAT THE LATEST REVISIONS OF CONSTRUCTION DRAWINGS ARE USED. CONTACT ENGINEER FOR VERIFICATION PRIOR TO COMMENCING CONSTRUCTION.

GENERAL NOTES

SEWER NOTES

1. ALL WORK SHALL BE DONE IN ACCORDANCE WITH THE 2003 SEWER SPECIFICATIONS AND STANDARD DRAWINGS OF IDAHO STANDARDS FOR PUBLIC WORKS CONSTRUCTION (I.S.P.W.C.).
2. FINAL APPROVAL AND ACCEPTANCE OF ALL SEWER CONSTRUCTION WILL BE BY THE MOUNTAIN HOME PUBLIC WORKS DEPARTMENT.
3. SEWER PIPE WITH COVER OF GREATER THAN 3 FEET, SHALL BE BELL AND SPIGOT, POLYVINYL CHLORIDE (PVC), SDR 35, ASTM D-3034 AS SET FORTH BY THE MOUNTAIN HOME PUBLIC WORKS DEPARTMENT.
4. SEWER INSPECTIONS WILL BE BY THE MOUNTAIN HOME PUBLIC WORKS DEPARTMENT AND THEIR DECISIONS SHOULD BE CONSIDERED AS FINAL. SUCH APPROVAL SHALL NOT RELIEVE THE CONTRACTOR FROM THE RESPONSIBILITY OF PERFORMING THE WORK IN AN ACCEPTABLE MANNER. THE CONTRACTOR WILL NOTIFY THE CITY PUBLIC WORKS DEPARTMENT 48 HOURS PRIOR TO CONSTRUCTION. THE CITY OF MOUNTAIN HOME WILL PROVIDE PERIODIC INSPECTIONS FOR AN EIGHT-HOUR DAY, FROM 8:00 A.M. TO 5:00 P.M., FOR A FORTY HOUR WEEK. THE CONTRACTOR SHALL REIMBURSE THE CITY AT RATES ESTABLISHED BY THE CITY FOR INSPECTION IN EXCESS OF THE NORMAL WORK WEEK, INCLUDING LEGAL HOLIDAYS, OVERTIME INSPECTION RATES AND A LIST OF LEGAL HOLIDAYS CAN BE OBTAINED FROM THE MOUNTAIN HOME PUBLIC WORKS DEPARTMENT.
5. SERVICE LINES SHALL BE MARKED IN ACCORDANCE WITH THE SPECIFICATIONS AND STANDARD DRAWING SD 512. SERVICE LINE MARKERS SHALL REMAIN IN PLACE DURING CONSTRUCTION AND BE PRESENT FOR FINAL INSPECTION.
6. PRIOR TO FINAL ACCEPTANCE, AFTER ALL UTILITIES ARE IN AND PRIOR TO PAVING, AN AIR TEST SHALL BE CONDUCTED. THE CONTRACTOR SHALL CONTACT THE CITY OF MOUNTAIN HOME A MINIMUM OF 24 HOURS PRIOR TO TESTING.
7. THE SEWER CONTRACTOR SHALL SUPPLY ALL LID ASSEMBLIES AND THE REQUIRED NUMBER OF RISER AND GRADE RINGS. THE SEWER CONTRACTOR SHALL FIELD VERIFY THE ELEVATION OF THE TOP OF THE MANHOLE CONE TO ASSURE THAT RING ELEVATIONS MATCH FINAL STREET GRADES. THE MAXIMUM HEIGHT OF THE GRADE RINGS SHALL BE SUCH THAT THE FINISH GRADE ELEVATION OF THE MANHOLE FRAME AND COVER SHALL NOT BE MORE THAN TWENTY-ONE (21") INCHES ABOVE THE TOP OF THE MANHOLE CONE.
8. THE PAVING CONTRACTOR SHALL SET THE GRADE RINGS AND POUR THE CONCRETE COLLARS PER IDAHO DEPARTMENT OF TRANSPORTATION STANDARDS. THE PAVING CONTRACTOR SHALL CONTACT IDAHO DEPARTMENT OF TRANSPORTATION 48 HOURS PRIOR TO POURING CONCRETE COLLARS.
9. THE HORIZONTAL SEPARATION OF THE WATER AND SEWER MAINS SHALL BE A MINIMUM OF TEN (10) FEET. WHERE IT IS NECESSARY FOR SEWER AND WATER TO CROSS EACH OTHER AND THE SEWER LINE IS LESS THAN 18 INCHES BELOW OR ABOVE THE WATER MAIN, THE SEWER LINE CROSSING SHALL BE P.V.C. PRESSURE PIPE CONFORMING TO AWWA C-900 OR ASTM D2241. FOR A DISTANCE OF 10' ON BOTH SIDES OF WATER LINE, ONE FULL LENGTH OF BOTH WATER MAIN AND SEWER LINE SHALL BE CENTERED OVER THE CROSSING POINT SO THAT ALL JOINTS WILL BE AS FAR FROM THE CROSSING AS POSSIBLE. IN LIEU OF CONSTRUCTING OR RECONSTRUCTING THE SEWER TO CONFORM TO WATER MAIN STANDARDS, THE WATER LINE OR SEWER LINE OR BOTH MAY BE ENCASED IN FOUR (4) INCHES OF CONCRETE, MEASURED AT THE BELL FOR A DISTANCE OF 10' ON BOTH SIDES OF THE WATER LINE.
10. GROUNDWATER LEVELS SHALL BE MAINTAINED BELOW THE BOTTOM OF THE TRENCH DURING THE PIPE LAYING AND PIPE JOINING OPERATIONS.
11. THE TRENCH BACKFILL ABOVE THE PIPE ZONE WILL BE INSPECTED BY THE IDAHO DEPARTMENT OF TRANSPORTATION OR BY THE OWNER'S ENGINEER IN ACCORDANCE WITH THE LATEST EDITION OF THE "CONSTRUCTION QUALITY ASSURANCE MANUAL" COMPACTION TESTS ARE REQUIRED IN THE BACKFILL ABOVE THE PIPE ZONE, WITHIN PUBLIC RIGHT-OF-WAY, ACCORDING TO IDAHO DEPARTMENT OF TRANSPORTATION REQUIREMENTS AND THE RESULTS SHALL BE SUBMITTED TO MOUNTAIN HOME PUBLIC WORKS DEPARTMENT AND IDAHO DEPARTMENT OF TRANSPORTATION PRIOR TO FINAL ACCEPTANCE.
12. ALL STATIONING RELATES TO THE GRAVITY SEWER CENTERLINE.
13. THE SEWER MAIN SHALL BE TESTED FOR DEFLECTION IN ACCORDANCE WITH THE I.S.P.W.C..
14. THE MOUNTAIN HOME PUBLIC WORKS DEPARTMENT MAY TEST THE COMPACTION OF THE SEWER PIPELINE BEDDING. TESTING WILL BE DONE BY AN INDEPENDENT TESTING LABORATORY. THE COST OF THE FIRST TEST WILL BE PAID BY THE MOUNTAIN HOME PUBLIC WORKS DEPARTMENT. IF THE FIRST TEST FAILS TO MEET REQUIRED COMPACTION, ALL RE-TESTING SHALL BE PAID BY THE SEWER CONTRACTOR. THE CONTRACTOR SHALL CONTACT THE MOUNTAIN HOME PUBLIC WORKS DEPARTMENT AND/OR TESTING LABORATORY TO SCHEDULE THE TESTS PRIOR TO ANY PIPE LAYING AND BACKFILLING.
15. SEWER CONSTRUCTION WILL MEET SPECIFIC DETAILS AND REQUIREMENTS OF THE FOLLOWING IDAHO STANDARDS FOR PUBLIC WORKS CONSTRUCTION AND THE IDAHO DEPARTMENT OF TRANSPORTATION STANDARDS:
  1. STANDARD MANHOLE - TYPE A, DRAWING NO. SD-501.
  2. DROP MANHOLE, DRAWING NO. SD-504.
  3. MANHOLE COLLAR DETAIL, DRAWING NO. HD-508.
  4. MANHOLE COVER & FRAME, DRAWING NO. SD-507.
  5. SEWER SERVICE MARKER, DRAWING NO. SD-512.
16. THE CONTRACTOR SHALL LEAVE THE EXCAVATION FOR THE UPSTREAM END OF ALL SERVICE LINES OPEN FOR FIELD VERIFICATION OF THE INVERT ELEVATION BY THE CITY'S INSPECTOR. THE CONTRACTOR SHALL NOT BACKFILL THE ENDS OF SERVICE LINES UNTIL HE HAS OBTAINED APPROVAL FROM MOUNTAIN HOME'S INSPECTOR OR MADE OTHER ARRANGEMENTS FOR THE VERIFICATION OF SERVICE LINE INVERT ELEVATIONS.
17. THE CONTRACTOR SHALL PROVIDE MOUNTAIN HOME INSPECTOR WITH "CUT SHEETS" FOR THE STAKING PROVIDED FOR CONSTRUCTION OF THE SANITARY SEWER. "CUT SHEETS" SHALL BE PROVIDED TO THE CITY PRIOR TO CONSTRUCTION. ADDITIONALLY, TEMPORARY BENCHMARKS MUST BE PROVIDED TO THE MOUNTAIN HOME'S DEPARTMENT OF PUBLIC WORKS, INSPECTION DEPARTMENT, BY THE OWNER, PRIOR TO THE COMMENCEMENT OF CONSTRUCTION.
18. THE CONTRACTOR SHALL INSTALL A REMOVABLE PLUG UPSTREAM OF SSMH A-1. THIS PLUG SHALL REMAIN IN PLACE DURING CONSTRUCTION UNTIL FINAL ACCEPTANCE OF THIS SEWER PROJECT. THE CONTRACTOR SHALL CONSTRUCT THE SANITARY SEWER IN ACCORDANCE WITH THE STAMPED PLANS APPROVED BY THE MOUNTAIN HOME PUBLIC WORKS DEPARTMENT. THESE PLANS WILL BE PROVIDED TO THE CONTRACTOR BY THE PROJECT INSPECTOR PRIOR TO CONSTRUCTION. WORK SHALL NOT BE DONE WITHOUT THE CURRENT SET OF APPROVED PLANS.

SEWER NOTES


WATER

1. THE WATER SYSTEM SHALL BE CONSTRUCTED TO CONFORM WITH THE STANDARDS SET FORTH IN THE "IDAHO RULES FOR PUBLIC DRINKING WATER SYSTEMS", AND CITY OF MOUNTAIN HOME WATER STANDARD SPECIFICATIONS AND DRAWINGS.
2. WATER DISTRIBUTION MAINS SHALL BE CONSTRUCTED WITH ASTM D2241, CLASS 200 OR AWWA C-900 CLASS 150 PIPE. THE PIPE SHALL BE INSTALLED IN WORKMANLIKE MANNER BY PERSONS PROPERLY QUALIFIED TO PERFORM SAID WORK AND SHALL BE IN CONFORMANCE WITH THE MANUFACTURER'S RECOMMENDATIONS AS APPROVED BY THE DISTRICT ENGINEER. ALL WORK AND MATERIALS MUST CONFORM TO CURRENT REQUIREMENTS OF THE I.S.P.W.C.
3. ALL WATER MAINS SHALL HAVE A MINIMUM COVER OF 48 INCHES. AFTER INSTALLATION OF THE WATER MAINS, THE TRENCHES SHALL BE COMPACTED TO 95% OF MAXIMUM DENSITY TO PREVENT FURTHER SETTLEMENT. ALL MAINS SHALL BE LEAK-TESTED, FLUSHED AND SANITIZED BEFORE CONNECTING WITH THE MUNICIPAL SYSTEM.
4. WHERE IT IS NECESSARY FOR SEWER AND WATER TO CROSS EACH OTHER, REFER TO NOTE NO. 9 UNDER SEWER NOTES.
5. ALL GATE VALVES SHALL BE FLANGED AND/OR M.J. AND SHALL CONFORM TO AWWA C-153 SPECIFICATIONS AND SHALL HAVE A 200 P.S.I. WORKING PRESSURE RATING. ALL VALVES SHALL BE ANCHORED IN CONFORMANCE WITH THE DETAIL SHOWN IN THE I.S.P.W.C. AND THE CONSTRUCTION DRAWING DETAILS.
6. ALL TEES, PLUGS, CAPS AND BENDS, AND AT OTHER LOCATIONS WHERE UNBALANCED FORCES EXIST, SHALL BE SECURED AND ANCHORED BY SUITABLE THRUST BLOCKING AS SHOWN IN THE DETAILS.
7. NO. 12 DIRECT BURIAL WIRE SHALL BE PLACED ALONG THE NORTH AND EAST SIDE OF WATER MAINS AND SERVICE LINES. WIRE SHALL BE TAPED TO GATE VALVE SO IT IS ACCESSIBLE FROM ABOVE BUT DOES NOT INTERFERE WITH VALVE OPERATION.
8. ALL WATER LINES SHALL BE DISINFECTED ACCORDING TO THE AWWA C651-92 SPECIFICATIONS, LATEST EDITION.
 


(A) THE DISTRIBUTION SYSTEM SHALL BE PRESSURE TESTED TO 150 P.S.I. TO THE SATISFACTION OF THE WATER DISTRICT. LEAKAGE SHALL NOT EXCEED .0331 GAL. PER INCH DIAMETER PER HR PER JOINT.

(B) PRIOR TO USE OF THE PIPE LINE, IT SHALL BE DISINFECTED ACCORDING TO SPECIFICATIONS TO AWWA C651-92 AND THEN FLUSHED. THE DISINFECTION AND FINAL FLUSHING PROCEDURE SHALL BE TESTED TO DETERMINE IF THE APPROPRIATE MINIMUM CHLORINE (CL2) RESIDUALS HAVE BEEN EXCEEDED. DISINFECTION REPORTS FROM A CERTIFIED LABORATORY ARE REQUIRED.
9. CONTRACTOR SHALL NOTIFY THE OWNER THREE (3) WORKING DAYS BEFORE INITIAL CONSTRUCTION BEGINS AND SHALL ALSO REQUEST ENGINEER'S INSPECTION OF WATER LINES AND APPURTENANCES TWENTY-FOUR (24) HOURS IN ADVANCE OF BACKFILLING.
10. CONTRACTOR TO FIELD VERIFY ALL VALVE BOX LID ELEVATIONS TO ASSURE THAT SAID LID ELEVATIONS MATCH FINAL STREET GRADE.
11. WATER MAIN CONSTRUCTION SPECIFICATION SHALL BE AS DIRECTED BY THE CITY OF MOUNTAIN HOME.
12. VALVES FLANGED OR M.J. SHALL BE LOCATED IN THE STREET. ALL GATE VALVES SHALL BE SET AS CLOSE (FLANGE CONNECTED) AS POSSIBLE TO MAIN LINE FITTINGS.
13. UPON THE COMPLETION OF WORK, THE CONTRACTOR SHALL SUBMIT A SET OF AS-BUILT PLANS TO THE OWNER FOR SUBMITTAL TO THE CITY OF MOUNTAIN HOME.
14. THE CONTRACTOR MAY PRESSURE TEST ALL WATER LINES AFTER DISINFECTION AND FLUSHING, BUT PRIOR TO INSTALLATION OF OTHER UTILITIES. AFTER ALL UTILITIES ARE INSTALLED AND PRIOR TO PAVING THE CONTRACTOR SHALL PERFORM A FINAL PRESSURE TEST WITH THE CITY OF MOUNTAIN HOME WATER ENGINEER OR THEIR REPRESENTATIVE IN ATTENDANCE. THE CONTRACTOR SHALL FURNISH ALL PERSONNEL AND EQUIPMENT NECESSARY TO CONDUCT THE TEST.
15. ALL WATER VALVES AND BLOW-OFFS SHALL BE PLACED SO AS NOT TO CONFLICT WITH CURB, GUTTER, SIDEWALK, OR OTHER REQUIRED STREET IMPROVEMENTS.

WATER NOTES

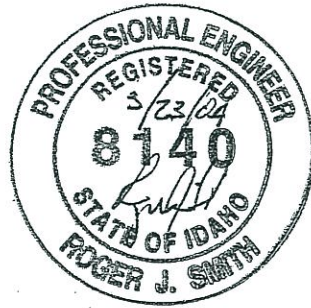

**PINNACLE**  
Engineers, Inc.  
12552 W. Executive Dr., Suite B, Boise, Idaho 83713  
(208) 887-7760

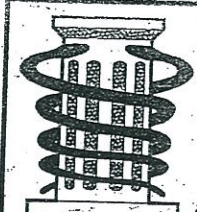

**Medical Design Group**  
Architecture for Health Care  
2716 WESTLAND PLACE  
BOISE, IDAHO 83704-5863  
BOISEARCHITECT@AOL.COM  
Fax (208) 378-1405  
Phone (208) 378-0817

© COPYRIGHT: MEDICAL DESIGN GROUP

GENERAL NOTES

Desert Sage Health Center  
2280 American Legion Blvd.  
Mountain Home, Idaho

SHEET  
C1.5


Dec 2003 PLOTDATE 12/00/03





### Ground Sleeve Installation

a.k.a. Ground Mount, Foundation Mount or Groundset

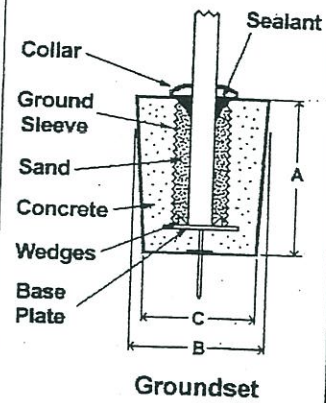

#### Ground mounted installations

**Ground Mount**  
The embedded, or Groundset, mount is the method of choice for mounting aluminum flagpoles at grade. Flagpole shafts so mounted have a higher wind speed rating than the same shafts base-plate mounted.

**Specifications:**  
2.3 A FOUNDATION TUBE: Fabricated from 16 ga. galvanized steel, with a steel base plate whose square dimension is at least the internal diameter of the sleeve plus 4". A setting plate 6" square shall be securely welded to the ground spike at least 6" below the base plate. The ground spike shall be 3/4" diameter, not less than 18" long.

1. Provide spun aluminum collar, Type FC-11, finished to match flagpole shaft. Diameter shall be at least 1" greater than diameter of sleeve.

#### Ground Sleeve Specifications

##### Shaft Foundation Dimensions

HEIGHT	BUTT DIAMETER	SLEEVE DIAMETER	DEPTH A	DEPTH B	DEPTH C
20'	4"	6"	3' 6"	30"	24"
20'	5"	8"	3' 6"	30"	24"
25'	5"	8"	3' 6"	30"	24"
25'	5.5" - 6"	10"	3' 6"	30"	24"
30'	5"	8"	3' 6"	30"	24"
30'	6"	10"	3' 6"	30"	24"
35'	5"	8"	4' 0"	36"	30"



### Sentry Flagpole Specifications


Exposed Height (feet)	Shaft Diameter (inch)		Maximum Wall Thickness (inch)	Maximum Unflagged Windspeed (mph)	Recommended Flag Size (feet)	Flagged Windspeed (mph)	Concord Continental Catalog Part Number
	Base	Top					
20	5	3	.125	255	5x8	120+	S20050125
20	5	2	.188	316	5x8	120+	S20050188
25	5	3	.125	154	5x8	105	S25050125
25	5	3	.156	201	5x8	120	S25050156
25	6	3.5	.156	195	5x8	120+	S25060156
25	6	3.5	.188	222	5x8	120+	S25060188
30	5	3	.125	110	6x10	85	S30050125
30	5	3	.156	126	6x10	95	S30050156
30	6	3.5	.156	195	6x10	120	S30060156
30	6	3.5	.188	222	6x10	120+	S30060188
35	5	3	.156	100	6x10	80	S35050156
35	6	3.5	.156	129	6x10	95	S35060156
35	7	3.5	.156	184	6x10	120	S35070156
35	7	3.5	.188	209	6x10	120	S35070188
40	7	3.5	.156	138	8x12	95	S40070156




[www.flagpoles.com](http://www.flagpoles.com)

Welcome | How to order | Catalog | What's new? | Contact us

Copyright © 1997 Concord Industries

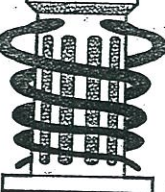

REGISTERED ARCHITECT  
No. AR-1740  
19 March 2004



DAVID R. DAVIES  
STATE OF IDAHO

**Medical Design Group**  
Architecture for Health Care

2716 WESTLAND PLACE  
BOISE, IDAHO 83704-5863

BOISEARCHITECT@AOL.COM  
Fax (208) 378-1405  
Phone (208) 378-0817

© COPYRIGHT: MEDICAL DESIGN GROUP

---

**SITE DETAILS**

Desert Sage Health Center  
2280 American Legion Blvd.  
Mountain Home, Idaho

SHEET  
**2.45**

---

Mar 2004

See O&M Manual  
for Irrigation As-Build

DRYLAND GRASS SEED

**LANDSCAPE SCHEDULE**


BHS	BLACK HILLS SPRUCE	5-7 FEET TALL
ABRM	AUTUM BLAZE RED MAPLE	2" MIN. CALIPER
RM	RED MAPLE	2" MIN. CALIPER
BFP	BRADFORD FLOWERING PEAR	2" MIN. CALIPER
KD	KOUSA DOGWOOD	2" MIN. CALIPER
DR	DAWN REDWOOD	5-7 FEET TALL
FF	FRASER FIR	5-7 FEET TALL
WC	WEeping CHERRY	2" MIN. CALIPER
SB	SNOWBALL BUSH	5 GAL
HB	HOLLY BUSH	5 GAL
BW	BOXWOOD - WINTERGREEN	5 GAL
FS	FROBELI SPIREA	5 GAL
RB	ROSEBUSH	5 GAL
MP	MUGO PINE	5 GAL
WBB	WHITE BUTTERFLY BUSH	5 GAL
PBB	PURPLE BUTTERFLY BUSH	5 GAL
CTP	POTENTILLA - CORANATION TRIUMP	5 GAL
RC	CHOKEBERRY - RED	5 GAL
TP	POTENTILLA TANGERINE	5 GAL
TCP	THUNDERCLOUD PLUM	2" MIN. CALIPER
RW	RED WEIGELA	5 GAL
CRD	DOGWOOD - CORAL RED	5 GAL
OG	OREGON GRAPE VINES	2 GAL

CONTRACTOR TO PROVIDE FULL LANDSCAPE DESIGN SUBMITTAL INCLUDING SHOP DRAWINGS AND PLANTING DETAILS

TOP SOIL DEPTH AT SHRUB BEDS: 12" MIN  
SOIL-AID/MULCH DEPTH AT TREE BASE AND IN SHRUB AREAS: 3" MIN.  
TOP SOIL AT SOD AREAS: 4" MIN.  
PROPERLY STAKE AND TIE ALL TREES UTILIZING (3) RUBBER CINCH TIES  
LAWN EDGING: BLACK DIAMOND; 36" DIA WHERE TREES OCCUR IN LAWN AREA  
ALL PLANTING/TREES/SHRUBS TO BE WARRANTED FOR ONE FULL GROWING SEASON.  
REPLACE ANY DEAD OR DYING PLANT MATERIALS DURING WARRANTY PERIOD.  
BARE ROOT TREES ARE NOT ACCEPTABLE.  
TOPSOIL: ASTM D 5268, pH RANGE 5.5 TO 7.4, FREE OF STONES 1" OR LARGER.  
BERMS SHOWN ON THIS PLAN ARE THE SOLE RESPONSIBILITY OF THE LANDSCAPE CONTRACTOR  
SUBSTITUTIONS FOR PLANT MATERIALS MUST BE REQUESTED 10 DAYS PRIOR TO BID.

Irrigation Sleeve

1 Landscape Plan  
1" = 15' (half size: 1" = 30')

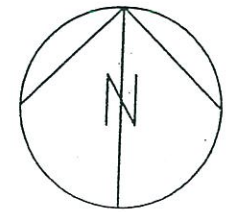


**Medical Design Group**  
Architecture for Health Care  
2716 WESTLAND PLACE  
BOISE, IDAHO 83704-5863  
BOISEARCHITECT@AOL.COM  
Fax (208) 378-1405  
Phone (208) 378-0817  
© COPYRIGHT: MEDICAL DESIGN GROUP

REGISTERED ARCHITECT  
No. AR-1740  
19 March 2004

**LANDSCAPE PLAN**

Desert Sage Health Center SHEET  
2280 American Legion Blvd. 2.50  
Mountain Home, Idaho

Mar 2004 ds250.dwg 03/19/04 15:19

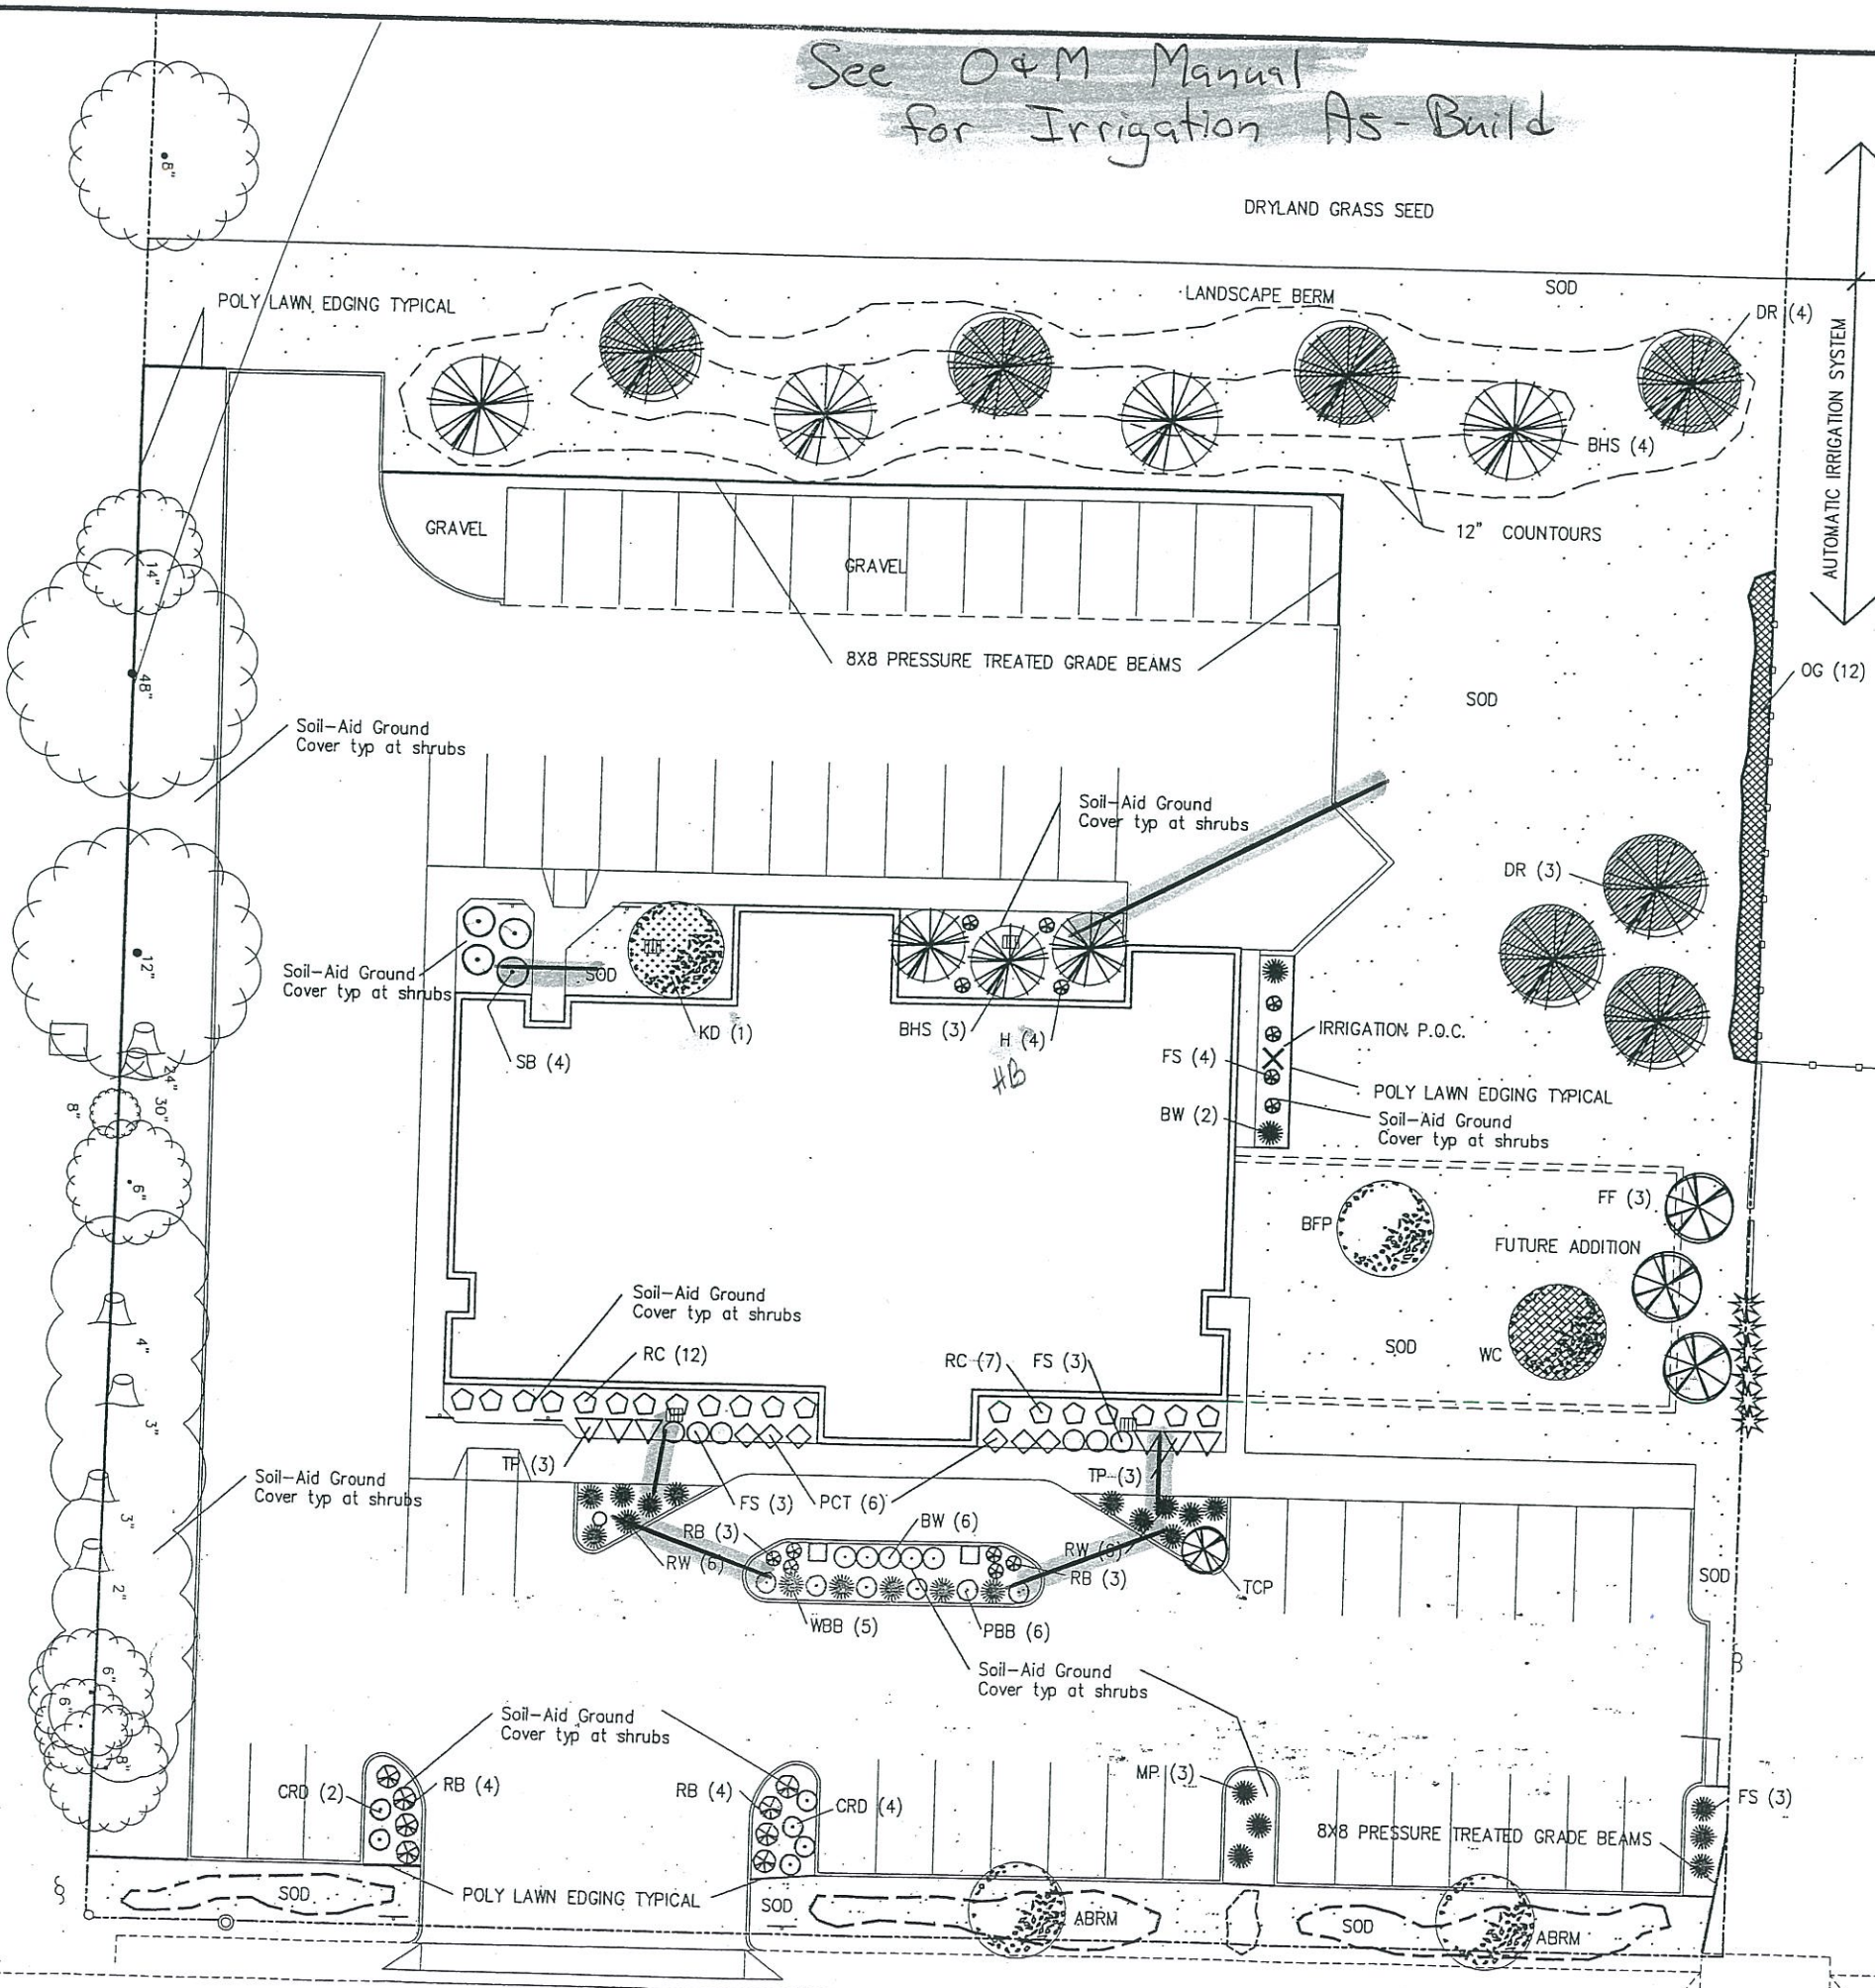

C:\p\proj\0111\_rines\m\0111\Architectural\2\TEMPLATE\mdg.dwt March 2003

## IRRIGATION PERFORMANCE SPECIFICATION

### 1. GENERAL DOCUMENTS

- a. SUMMARY
- Drawings and Contract Documents apply to this section.
  - This section includes:
    - Valves
    - Piping
    - Sprinklers
    - Specialties
    - Accessories
    - Controls
    - Wiring
  - Furnish and install an underground sprinkler irrigation system to provide irrigation of the lawn and planing areas. The work shall consist of providing and installing all material necessary for a complete system including pipe, valves, fittings, heads, automatic control equipment and all labor necessary for the installation of a satisfactorily operating system.
- b. DEFINITIONS:
- Supply Piping: Piping from water source to connections to irrigation system pressure piping. Piping is under same pressure as water supply. Supply piping is not included in the work of this section.
  - Pressure Piping: Piping downstream from supply piping to and including control valves. Piping is under irrigation system pressure. Pressure piping includes backflow preventers.
  - Circuit Piping: Piping downstream from control valves for control water flow to irrigation system zone.
  - Control Valve: Automatic (electrically operated) valve for control water flow to irrigation system zone.
  - Drain Valve: Manual drain valve for draining of main pressure line.
- c. SYSTEM PERFORMANCE: 100 percent coverage.
- d. SUBMITTALS
- Product data
  - Wiring Diagrams
  - Maintenance data
  - Complete shop drawings showing location of all main and lateral lines and sizes, POC, sprinkler heads and type, valves with associated GPM, automatic controller and type, sleeve locations and wiring.
  - Complete as-built drawings and operation and maintenance manuals.
- e. QUALITY ASSURANCE
- Comply with requirements of utility supplying water for backflow prevention.
  - Minimum water coverage in turf and planter areas: 100 percent.
- f. PROJECT CONDITIONS

Page 1 of 6

- unit on inlet and outlet. 2" and smaller may be ball valves.
- e. VALVES
- i. General: Valves are for general-duty and underground applications.
- f. CONTROL VALVES
- Key operated manual Isolation and Control Valves: MSS SP-80, Class 125, globe valves, fitted for key operation.
  - Automatic Control Valves: Diaphragm-type normally closed, with manual flow adjustment and operated by 24 volt ac solenoid.
  - Quick Couplers: Factory fabricated 2-piece assembly. Include coupler water seal valve, removable upper body with spring loaded or weighted, rubber-covered cap, hose swivel with ASME B1.20.7, 3/4"-11.5NH threads for garden hose on outlet and operating key.
  - Control Valve Box and Cover: Thermo-plastic valve boxes with lockable, snap-top lids. Max: 2 valves per box.
    - Drainage backfill: Cleaned gravel or crushed stone, graded from 3 inch max. to 3/4" min.
  - Service Boxes for Key-Operated Control Valves: Include valve key, 48 inches long with tee handle and key end to fit valve.
- g. SPRINKLERS
- Manufacturer's standard sprinklers designed to provide uniform coverage over entire area of spray shown on Drawings at available water pressure, as follows:
    - Housing: Plastic
    - Pop-up Spray: Fixed pattern with screw-type flow adjustment and stainless-steel reaction spring.
    - Pop-Up, Rotary Spray, Gear Drive, full-circle and adjustable part circle-type.
- h. AUTOMATIC CONTROL SYSTEM
- Low-voltage controller system made for control of irrigation system automatic control valves. Controller operates on 120 volts ac building power system, provides 24 volts ac power to control valves and includes stations for at least required number of control valves.
  - Exterior Control Enclosures: Weatherproof enclosure with locking cover and (2) matching keys. Comply with NFPA 70 and NEMA 250, Type 4 and include provision for grounding.
  - Material: Stainless Steel
  - Mounting: Controller mounted in a stainless steel pedestal on concrete pad.
  - Transformer: Internal-type and suitable for converting 120 volts ac building power to 24 volts ac power.
  - Controller Stations: Each station is variable from approximately 1 to 60 minutes. Include switch for manual or automatic operation of each station.
  - Timing Device: Adjustable 24 hour, 14 day clock to operate any time of day. Include provision for the following settings:

Page 3 of 6

- c. PAVING WORK
- Install piping in sleeves where crossing sidewalks, roadways and parking lots.
  - Install piping sleeves by boring under existing paving where possible.
- d. PIPING APPLICATIONS
- Main Lines:
    - 3 inch and smaller: Class 200 PVC plastic pipe, Schedule 80 PVC plastic, socket-type pipe fittings and solvent free cemented joints.
    - 4 inch and larger: Class 160 PVC plastic pipe, Schedule 80 PVC plastic, socket-type pipe fittings and solvent free cemented joints.
  - Circuit Piping and Sleeves:
    - All sizes: Class 200 PVC plastic pipe, Schedule 40 PVC plastic socket-type fittings and solvent-cement joints.
- e. PIPING SYSTEMS
- Install components having pressure rating equal to or greater than system operation pressure.
  - Install piping free of sage and bends.
  - Locate groups of pipes to permit valve servicing.
  - Pipe Connections:
    - Install unions adjacent to each valve and at final connection to each piece of equipment.
- f. PIPING INSTALLATION
- Install underground PVC piping according to ASTM D 2774
  - Lay piping on solid subbase without dips or depressions.
  - Install PVC piping in dry weather 40 degrees F or above for a period of at least 24 hours after pipe installation.
  - Install piping under sidewalks and paving in sleeves.
  - Minimum cover:
    - Pressure piping: 18 inches
    - Circuit piping: 12 inches
    - Sleeves: 18 inches.
  - Lateral Line Pipe Sizing:
    - 3/4" pipe not to exceed 10 GPM
    - 1" pipe not to exceed 16 GPM
    - 1 1/4" pipe not to exceed 26 GPM
    - 1 1/2" pipe not to exceed 35 GPM
    - 2" pipe not to exceed 55 GPM
    - 2 1/2" pipe not to exceed 80 GPM
    - 3" pipe not to exceed 120 GPM
- g. VALVES AND BACKFLOW PREVENTION
- Install valves in valve control boxes - max (2) valves per box.
  - Install backflow preventers of type, size and capacity required. Include valves, and test cocks. Install according to plumbing code and authorities having jurisdiction (AHJ).
  - Do not install a bypass around the backflow preventer.

Page 5 of 6

- Perform site survey, research public utility records, and verify existing utility locations.
  - The project shall be designed for 50 PSI static water pressure and 35 GPM. Contractor to very exact pressures and adjust the system pipe sizes and zoning accordingly.
- g. SEQUENCING AND SCHEDULING
- Maintain uninterrupted water service to building during normal working hours. Arrange for temporary water shut off with owner.
- h. EXTRA MATERIALS
- Deliver the following to the owner:
    - (1) quick coupler
    - (2) 10% of sprinklers
    - (3) (2) valve keys
    - (4) (2) quick coupler hose swivels
    - (5) (2) quick coupler operating keys
- i. WARRANTY
- Irrigation contractor shall correct without delay, at the contractor's expense, any trouble that develops with the system due to faulty workmanship or materials during one (1) year after final acceptance of the work by the owner.
  - Irrigation contractor shall be responsible for the first year winterization.
2. PRODUCTS
- a. PIPES AND TUBES
- PVC Plastic pipe: ASTM D2241, PVC 1120, 200 PSIG min pressure rating. Class 200, solvent weld sockets.
- b. PIPE AND TUBE FITTINGS
- PVC ASTM D 2464, Schedule 80 threaded and ASTM D 2467 Schedule 80 socket type.
  - Dielectric Fittings: Assembly or fitting with insulations material isolating joined dissimilar metals to prevent galvanic action and stop corrosion.
  - Dielectric Unions: Factory fabricated union assembly 250 psig minimum working pressure.
- c. JOINING MATERIALS
- Solvent Cement: ASTM F 856 primer and ASTM D 2564 solvent cement.
- d. BACKFLOW PREVENTERS
- Description: ASSE Standard backflow preventers.
- Working Pressure: 150 PSIG
  - 2 inch and smaller: bronze body with threaded ends
  - 2 1/2 inch and larger: Bronze, cast-iron, steel or stainless steel body w/ flange ends.
- Double-Check Backflow Prevention Assemblies: ASSE 1015, w/ shut-off valves on inlet and outlet and strainer on inlet. Include test cocks.
    - Pressure Loss: 12 psig
    - Gate valves supplied with and compatible for size and testing of

Page 2 of 6


- Setting to skip operation any day in timer period
  - Setting for operation every other day
  - Settings for operation (2) or more times daily
  - Include manual or semi-automatic operation without disturbing preset automatic operation
  - Provide NI-CAD battery and trickle charger to automatically power the timing device during power outages.
- viii. Wiring: UL 493, solid copper conductor, insulated cable, suitable for direct burial.
- Feeder Circuit Cables: Type UF, No. 12 AWG minimum between building and controllers.
  - Low-Voltage, Branch Circuit Cables: Type UF, No. 14 AWG Min. Between controllers and automatic control valves in differing jacket colors. Install to the side to the main line. Where control wires leave the main or lateral lines, install wire in Class 160 PVC conduit.
  - Splicing Materials: Pressure-sensitive, waterproof, thermoplastic wire connectors and other materials required to make specified connections. Locate all splices within valve boxes.
  - Add two extra control wires from panel to valves for use if a wire fails or for future addition and mark it in the control box as extra wire.
- i. DRIP IRRIGATION
- All planter beds are to be irrigated with a NETAFIM drip irrigation system.
  - All trees are to be irrigated with a NETAFIM drip irrigation system.
  - Utilize the following criteria:
    - NETAFIM Techline drip tubing with 18" emitter spacing and .61 GPH emitter flow spaced at 18".
    - A Techfilter with a triflex ring is to be installed on each zone in conjunction with a rain bird or eq. DVF series remote valve. Filter size and type: 3/4" 120 mesh disc filter (DF075-120).
    - All zones are to be installed with a TLFV-1 line flushing valve installed with collar.
    - All zones are to have a TLARV ir/vacuum relief valve installed at the highest points within the zones.
    - All tubing is to be staked down with TLS6 6" soil staples.
    - Install extra emitters if necessary to ensure the health of the plant(s).
3. EXECUTION
- a. EXAMINATION
- Investigate and determine available water supply water pressure and flow characteristics.
- b. PREPARATION
- Set stakes to identify proposed sprinkler location. Obtain approval prior to excavation from general contractor.

Page 4 of 6

- h. SPRINKLER INSTALLATION
- Flush circuit piping with full head of water and install sprinklers after hydrostatic test is complete.
  - Locate part-circle sprinklers to maintain a min. distance of 12 inches from building exterior walls.
- i. AUTOMATIC CONTROL SYSTEM INSTALLATION
- Install per manufacturer's instructions. Install wiring in same trench as piping. Where no piping occurs, install wires in conduit.
- j. CONNECTIONS
- Connect piping to sprinklers, devices, valves, control valves, specialties and accessories.
  - Connect water supplies to irrigation systems. Include backflow preventers on potable water supplies.
  - Connect to power source, controllers and automatic control valves.
- k. FIELD QUALITY CONTROL
- Perform test of piping and valves before backfilling trenches. Repair leaks as required.
- l. CLEANING AND ADJUSTING
- Flush dirt and debris from piping before installing sprinklers and other devices.
  - Adjust automatic control valves to provide flow rate of rated operating pressure required for each sprinkler circuit.
  - Adjust settings of controllers and automatic control valves.
- m. COMMISSIONING
- Verify that specialty valves and accessories have been installed correctly and operate correctly.
  - VERIFY THAT NO SPRINKLERS HIT THE BUILDING WITH IRRIGATION WATER.
  - Verify that specified tests of piping are complete.
  - Check that sprinklers and devices are correct type.
  - Check that damaged sprinklers and devices have been replaced with new materials.
  - Check that potable water supplies have correct type backflow preventers.
  - Energize circuits to electrical equipment and devices.
  - Adjust operating controls.
  - Perform operational testing after hydrostatic testing is complete, backfill is in place and sprinklers are adjusted to final position.
- n. DEMONSTRATION
- Demonstrate the Complete system operation to the Owner.
  - Review operating and maintenance information with the Owner.

End of section

Page 6 of 6

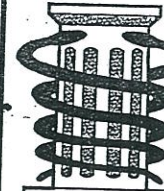

**Medical Design Group**  
Architecture for Health Care

2716 WESTLAND PLACE  
BOISE, IDAHO 83704-5863

BOISEARCHITECT@AOL.COM  
Fax (208) 378-1405  
Phone (208) 378-0817

© COPYRIGHT: MEDICAL DESIGN GROUP

REGISTERED ARCHITECT  
No. AR-1740  
19 March 2004












DAVID R. DAVIES  
STATE OF IDAHO

**IRRIGATION NOTES**

Desert Sage Health Center  
2280 American Legion Blvd.  
Mountain Home, Idaho

SHEET  
2.65

Mar 2004 | ds265.dwg 03/15/04 15:09

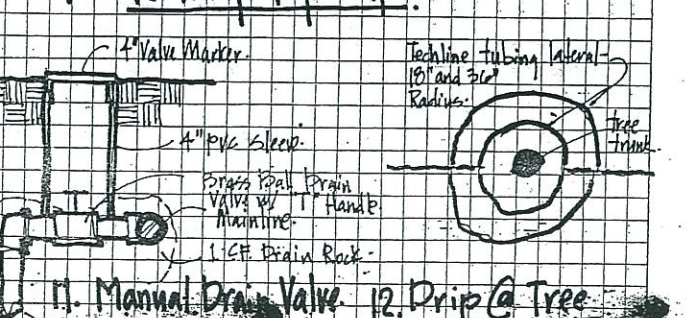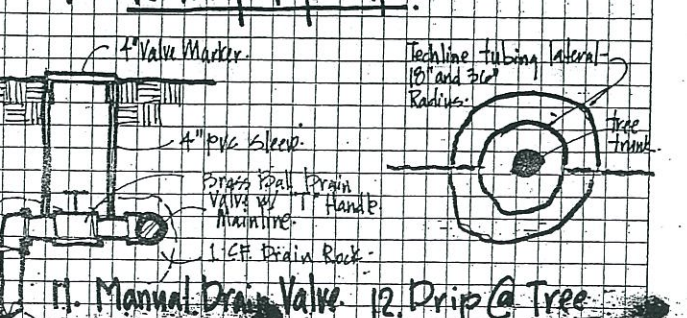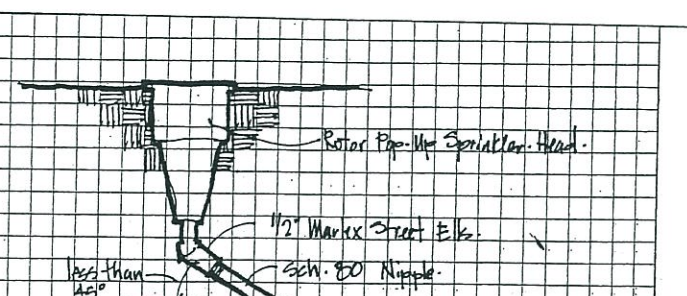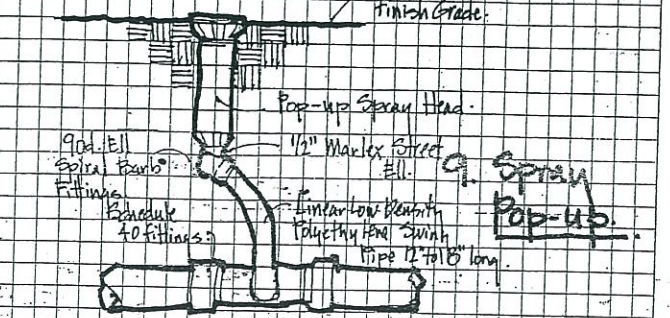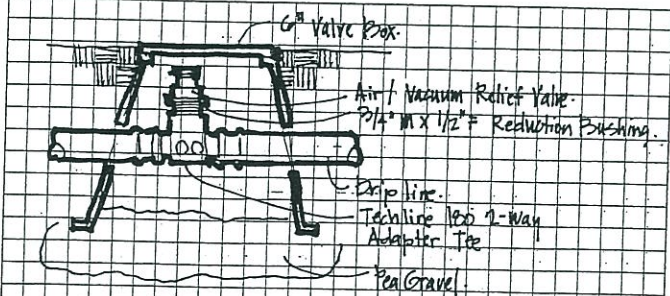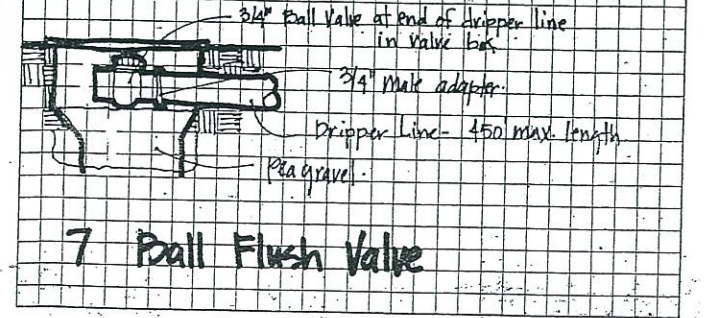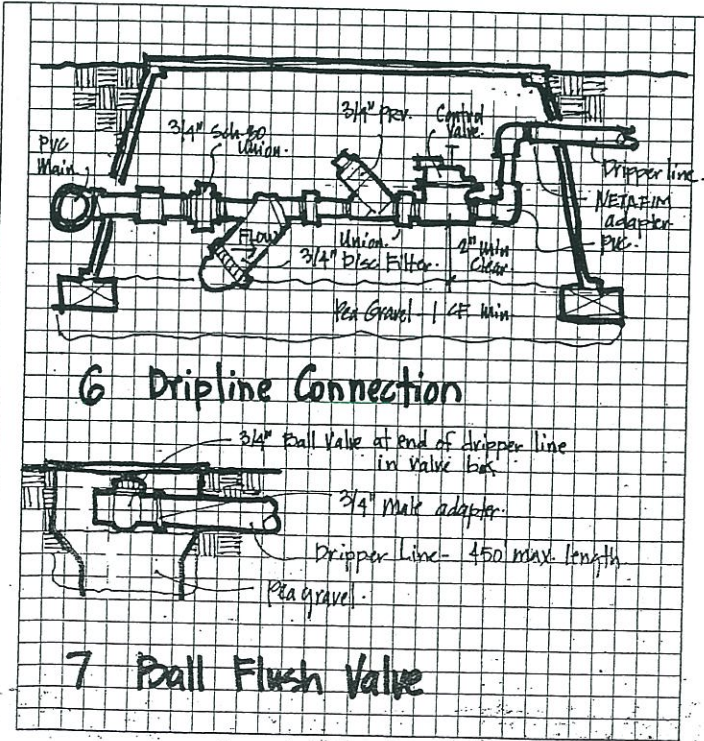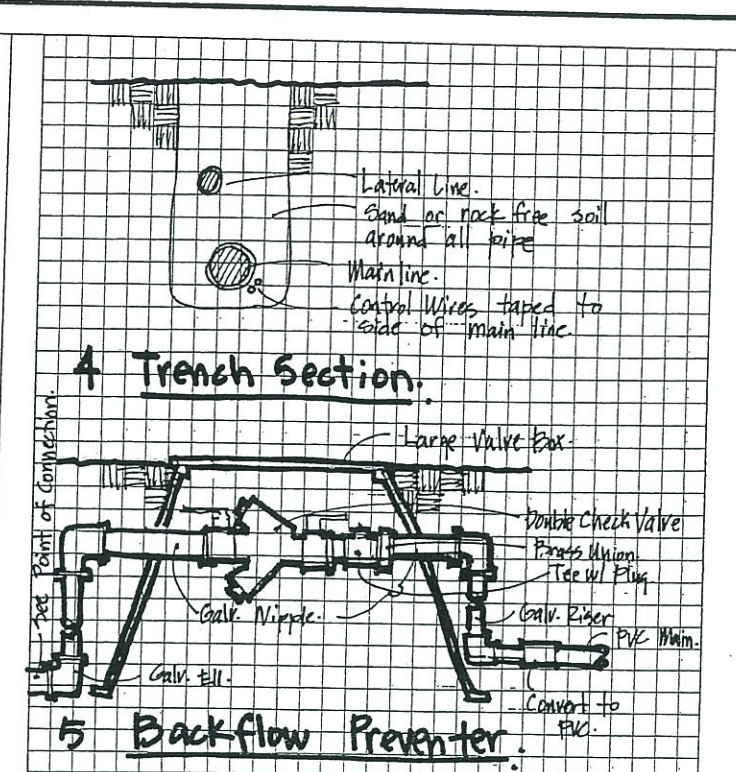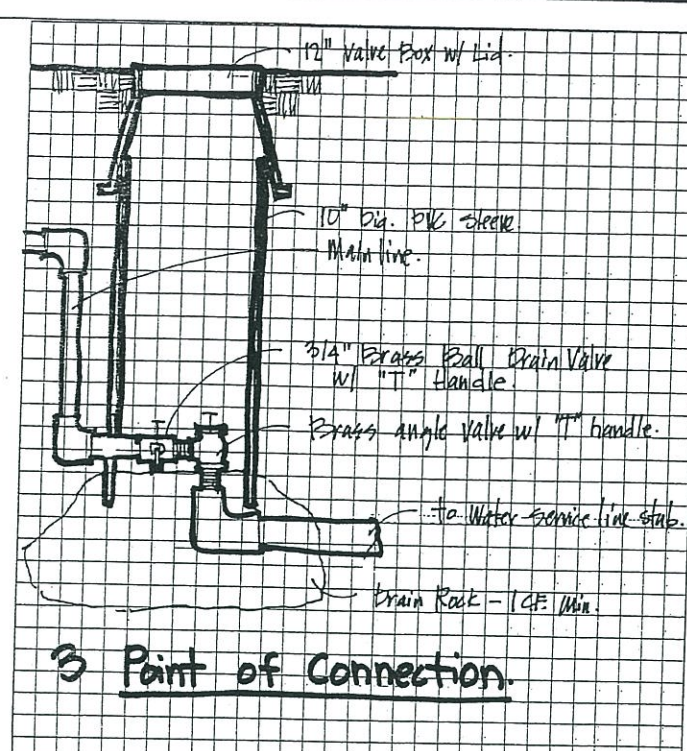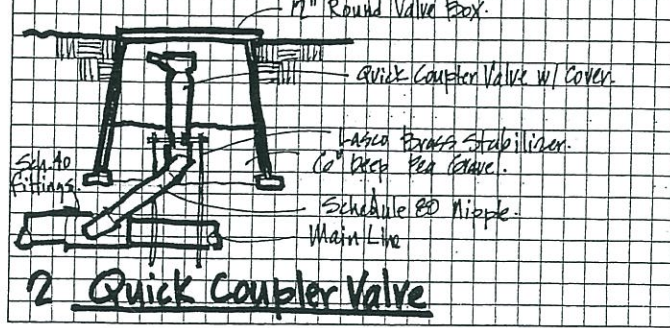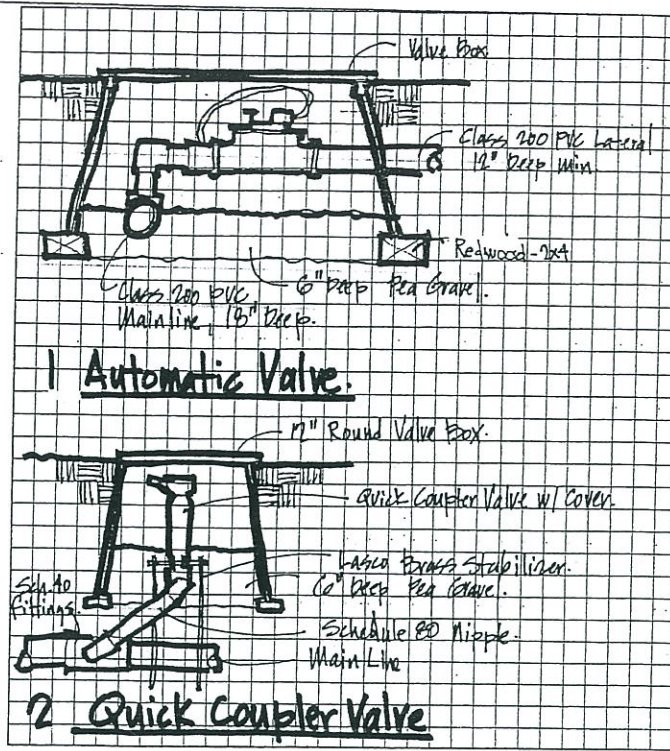

**Medical Design Group**  
 Architecture for Health Care  
 2716 WESTLAND PLACE  
 BOISE, IDAHO 83704-5863  
 BOISEARCHITECT@AOL.COM  
 Fax (208) 378-1405  
 Phone (208) 378-0817

REGISTERED ARCHITECT  
 No. AR-1740  
 19 March 2004

DAVID R. DAVIES  
 STATE OF IDAHO

© COPYRIGHT: MEDICAL DESIGN GROUP

**IRRIGATION DETAILS**

Desert Sage Health Center 2280 American Legion Blvd. Mountain Home, Idaho	SHEET 2.66
---	---------------

Mar 2004 ds266.dwg 03/15/04 15:09

...:\... ARCHITECTURAL 2\TEMPLATE\mdg.dwg March 2003

JOB NAME: Desert Sage Health Clinic  
 JOB NUMBER: S032273  
 CLIENT: Medical Design Group

**GENERAL:**

- Unless noted otherwise, all work shall conform to the requirements of the 2000 International Building Code. It is the Contractor's responsibility to verify all existing conditions at the job site, and to fully coordinate all dimensions and conditions of details with other disciplines. Any field conditions requiring construction that is different from that shown on the plans shall be brought to the attention of the Architect. Any conflicting details shown in the drawings shall be brought to the attention of the Architect prior to the construction of said detail. Do not scale drawings.
- All support of construction loads shall be the responsibility of the Contractor. All shoring and bracing required for the protection of the life and property during the construction process shall be the responsibility of the Contractor. All procedures of soil excavation, backfill, and support of adjacent property during earthwork shall be the responsibility of the General Contractor.
- All dimensions indicated on plans shall be to face of studs, face of concrete block, face of rough concrete, centerline of columns, bottom of metal deck, and top of slab, unless noted otherwise. Refer to Architectural drawings for all dimensions not indicated on structural drawings.
- Work these drawings with architectural, mechanical, and electrical drawings.
- The following design criteria shall be enforced:
 

A. Roof Live Load:	20 PSF
B. Roof Snow Load:	
A) Ground Snow Load	Pg = 20 PSF
B) Exposure Factor	Ce = 1
C) Thermal Factor	Ct = 1
D) Slope Factor	Cs = 1
E) Importance Factor	I = 1
F) Flat Roof Load	Pf = 25 PSF
G) Sloped Roof Load	Ps = 25 PSF
C. Floor Live Load:	60 PSF Labs, 50 PSF Office, 40 PSF Wards/Rooms
D. Corridor/Stair Live Load:	100 PSF
E. Roof Dead Load:	30 PSF
F. Floor Dead Load:	12 PSF
- Wind Forces:
 

Wind Building Category	I
Wind Speed, 3 Second Gust	V3S 90 MPH
Wind Exposure Category	B
Wind Importance Factor	1.0
Roof Net Uplift Due to Wind:	15.8 PSF

 Components and Cladding in accordance with IBC Section 1609.6.5

- |                           |           |           |
|---------------------------|-----------|-----------|
| Enclosed Portions Zone 1: | 10 PSF    | -12.1 PSF |
| Enclosed Portions zone 2: | 10 PSF    | -19.5 PSF |
| Enclosed Portions Zone 3: | 10 PSF    | -19.5 PSF |
| Wall Zone 4:              | 12.4 PSF  | -13.6 PSF |
| Wall Zone 5:              | 12.4 PSF  | -15.1 PSF |
| Roof Overhang Zone 2:     | -27.2 PSF |           |
| Roof Overhang Zone 3:     | -28.4 PSF |           |
- Seismic Forces:
 

Seismic Use Group:	I
Spectral Response Coefficient:	SDS = .333
Spectral Response Coefficient:	SD1 = .155
Site Class:	D
Seismic Design Category:	C

 Seismic force Resisting System: Light framed walls with wood shearwalls  
 Design Base Shear: 12217.16  
 Analysis Procedure: Simplified
  - Load combinations for Allowable Stress Design:
 

D + L + (LR or S or R)
D + L + (wW)
D + L + wW + S/2
D + L + S + wW/2
D + L + S + E/1.4
0.9 D + E/1.4

 Where wind loads are calculated in accordance with IBC Section 1609.6 or ASCE 7, the coefficient w in the above formulas shall be taken as 1.3. For other wind loads w may be taken as 1.0. Flat roof snow loads of 30 psf or less need not be combined with seismic loads. Where flat loads exceed 30 psf, 20 percent shall be combined with seismic loads.
  - Load combinations and Factors for strength design.
 

1.4D
1.2D + 1.6L + 0.5 (LR or S or R)
1.2D + 1.6 (LR or S or R) + F1, L or 0.8W
1.2D + 1.6W + F1, L + 0.5 (LR or S or R)
1.2D + 1.0E + f1, L + F2S
0.9D + (1.0E or 1.6W)

 f1 = 1.0 for floors in places of public assembly, for live loads in excess of 100 psf and for parking garage live loads.  
 f1 = 0.5 for other live loads.  
 f2 = 0.7 for roof configurations that do not shed snow off the structure.  
 f2 = 0.2 for other roof configurations. See also IBC Section 1605.2.1 Exceptions.
  - Components and cladding; Use the most stringent wind load obtained from code and the project specification. Cladding manufacturer shall consider increase pressure coefficients at building corners, eaves, and rakes.


**FOUNDATION:**

- Followed recommendations from soils investigation report prepared by Materials Testing & Inspection, Inc. #B30023g dated January 28, 2003.
- Minimum frost depth to bottom of footing from ground surface = 24 inches.
- Maximum foundation soil bearing pressure used = 3000#/SF.
- Backfill shall be compacted to 95% of Modified Proctor Density in accordance with ASTM D-1557.
- Prior to construction, remove all construction debris, surficial fill, and topsoil at all pavement, sidewalk and building areas, and replace with structural fill, see soils report for specific requirements.
- All footings shall be poured in neat excavated trenches. Trench shall be approved by inspector prior to placement of concrete at locations where structural fill is required, fill shall be placed in 6" lifts and compacted at optimum moisture content. Refer to soils investigation for depth and extent of structural fill. *Not Given*
- The Contractor shall familiarize himself with the survey and the subsurface investigation report before starting construction. All foundation work shall be in accordance with the recommendations of the soils report except where noted otherwise on drawings or specifications.
- The Contractor shall note all subsurface interferences noted in the geotechnical report and Construction Documents by other consultants including but not limited to rock, fills, utility lines, etc.
- A soils testing laboratory may be retained by the owner to provide construction review to ensure conformance with the Construction Documents during the excavation, backfill, and foundation phases of the project.
- The soils testing laboratory shall discuss with the Engineer the design intent of the Construction Documents and the testing procedures used to ensure conformance with the Construction Documents before construction begins. Inform the Engineer of any variance in these procedures.
- It shall be the responsibility of the soils testing laboratory to: determine topsoil and excavation stripping depth; inspect all subsoil exposed during stripping. Site grading, and excavation operations; approve fill materials; perform density tests of fills to ensure placement per specification requirements; inspect foundation-bearing surfaces.
- Step footing, where required shall be placed, at a ratio of one (1) vertical to two (2) horizontal with a maximum vertical step of 2'-0" unless noted otherwise.
- Inundation and long term exposure of bearing surfaces, which will result in deterioration of bearing formations, shall be prevented. Footing shall be placed immediately following footing excavations and bearing surface inspection.
- All fill materials shall be free of organic contamination and other deleterious matter.
- For back fill against grade beams, etc., Place in 8" thick layers, with each lift compacted at near optimum moisture content, until a minimum in place density of 95% of the maximum density as determined by ASTM test procedure D-1557 is achieved.
- Notify structural and geotechnical Engineer of any unusual soil conditions that are in variance with the soils report.
- See Geotechnical report building pad preparation.

*ok  
Quantity*

**CONCRETE (CAST IN PLACE AND TILT-UP):**

- All concrete materials shall comply with the standards specified in the latest edition



**Medical Design Group**  
 Architecture for Health Care

2716 WESTLAND PLACE  
 BOISE, IDAHO 83704-5863

BOISEARCHITECT@AOL.COM  
 Fax (208) 378-1405  
 Phone (208) 378-0817

© COPYRIGHT: MEDICAL DESIGN GROUP

---

REGISTERED ARCHITECT  
 No. AR-1740  
 15 March 2004

DAVID R. DAVIES  
 STATE OF IDAHO

---

**STRUCTURAL SPECS.**

Desert Sage Health Center SHEET  
 2280 American Legion Blvd.  
 Mountain Home, Idaho 3.01

Feb 2004

of the ACI 318 and IBC building code. Each mix design shall be established in accordance to chapter 5 of ACI 318 and IBC and submitted to the Engineer at least 2 weeks prior to the placement of concrete.

- Concrete testing shall be performed by an approved independent testing laboratory. The testing agency shall test (4) cylinders from each class of concrete used each day. A minimum of (1) sample must be taken from each 50 cubic yards of concrete.

3. All concrete shall develop a minimum compressive in 28 days as follows:

Location	Special Inspect.	Slump (max)	Aggregate (max size)	Compressive Strength (PSI)
Footings	NO	5	1" Ø	3500
Stem Walls	NO	5	1" Ø	3500
Columns	Yes	4	¾" Ø	4000
Retaining Wall	Yes	5	¾" Ø	4000
Tilt-up	Yes	5	¾" Ø	4000
Beams	Yes	5	¾" Ø	4000
Interior Slabs	NO	5	¾" Ø	3500
Exterior Slabs	NO	5	¾" Ø	4000
Composite Deck	YES	5	¾" Ø	4000

Slump based upon NO additives. Contractor shall be responsible for maintaining required strength.

4. All concrete shall have the following maximum water cement ratios:

Compressive Strength	Non-air Entrained	Air Entrained
3,500 PSI	0.60	0.50
4,000 PSI	0.57	0.48
5,000 PSI	0.50	0.40
6,000 PSI	0.45	0.40

- Minimum Cement content = 500 #/ YD.
- When special inspection is required by design, such special inspection shall be in conformance with special inspections section. When special inspection is not required, higher concrete strengths have been specified for quality control.
- Any concrete that fails to meet specifications shall be removed and replaced at the expense of the Contractor.
- The Contractor shall be responsible for the construction, design, placement and removal of all formwork. All shoring during placement of concrete is the sole responsibility of the Contractor.
- Provide 5% (+ 1%) air entrainment in all concrete exposed to the weather.
- All concrete work shall conform to the latest edition of ACI 117 "Standard Specifications for Tolerances for Concrete Construction Materials."
- Veneer anchors = "Dur-O-Wall" Duro-O-Eye or equal in first and second joints above and below openings and at 16" on center elsewhere.

#### CONCRETE REINFORCING:

- All reinforcing bars shall conform to ASTM A-615 or ASTM A-706 #4 bars and larger grade 60, stirrups grade 60, Fy=60,000 PSI min., #3 bars and ties grade 40, Fy=40,000 PSI min., unless noted otherwise. Bars shall be tied secure prior to placement

of concrete to maintain proper placement after concrete is in place. Lap all bars per Chapter 12 of ACI 318 unless noted otherwise. Splice bars only where shown on plans or in accordance with Item #3 below.

2. Maintain the following concrete coverage for concrete reinforcing:

Unformed surfaces in contact with earth.....	3"
Formed surfaces in contact with earth.....	2"
Formed surfaces exposed to outside weather.....	2"
Slabs and walls not exposed to weather.....	1 ½"
Clear distance between bars.....	2" U.N.O.

3. All detailing, fabrication and placing of reinforcing bars, unless otherwise noted, shall conform to the latest edition of the ACI 318, "Building Code Requirements for Reinforce Concrete", the latest ACI "Manual of Standard Practice for Detail Reinforced Concrete Structures" and IBC International Building Code.

- No tack welding for reinforcing in the field will be permitted.
- Shop drawings of all bars and locations shall be submitted to the Structural Engineer for review prior to fabrication.
- Normal weight concrete shall have a unit weight of 145 to 155 pounds per cubic foot. Use of calcium chloride is not permitted in any concrete mixes. All other additives and admixtures must have the written approval of the Engineer.
- Welded wire mesh reinforcing shall conform to ASTM A-185 and be furnished in flat sheets, unfinished. Lap mesh 8 inches minimum.
- Fibermesh fibers are collated fibrillated polypropylene olefin fibers or equal ¼ inch in length. Fibermesh Fibers shall be added to the concrete mix at a minimum rate of 1.5 pounds (0.1 percent by volume) per cubic yard of concrete. The dosage shall not exceed 15 pounds per cubic yard.

#### STRUCTURAL AND MISCELLANEOUS STEEL:

- All steel work shall conform with AISC specifications.
- Plates, angles and channels, ASTM A36.
- W shapes ASTM A992, Grade 50.
- Tubes, ASTM A500, Grade B.
- Pipes, ASTM A53, Grade B.
- Use E70 electrodes for all welds. Metal deck welding can be E60 or E70 electrodes for welding.
- Camber beams only as specified in plans for 1½ times the supported dead load, do not camber continuous beams.
- Bolts ASTM A307 for connections to concrete, ASTM A307 for steel connections.
- All welding shall be performed by welders qualified by an independent testing agency. Qualifications shall be based on the requirements of IBC Section 2208.1.

#### COLD-FORMED STEEL FRAMING:

- Erect partition walls and shear walls after roof system has been installed with complete dead and mechanical loads.
- Attach gypsum board with #10 screws at 12" o.c. at all studs, tracks, etc..
- Calculate structural characteristics of cold-formed metal framing according to AISI's "Cold-Formed Steel Design Manual".
- Cold rolled metal framing shall be manufactured according to AISI specifications and

shall meet the following minimum properties and criteria:

- Yield Strength: 50,000 psi for 16 gauge and heavier materials. 33,000 for 18 gauge and lighter materials.

b. Studs: (S is effective properties, I is gross properties).

1.	3½" x 20 ga., Sx = .244,	Ix = .444,	Iy = .059
2.	3½" x 18 ga., Sx = .316,	Ix = .562,	Iy = .074
3.	3½" x 16 ga., Sx = .381,	Ix = .693,	Iy = .090
4.	3½" x 14 ga., Sx = .487,	Ix = .854,	Iy = .108
5.	4" x 20 ga., Sx = .292	Ix = .606	Iy = .062
6.	4" x 18 ga., Sx = .378	Ix = .769	Iy = .077
7.	4" x 16 ga., Sx = .456	Ix = .950	Iy = .093
8.	4" x 14 ga., Sx = .585	Ix = 1.171	Iy = .113
9.	6" x 20 ga., Sx = .512	Ix = 1.590	Iy = .069
10.	6" x 18 ga., Sx = .665	Ix = 2.026	Iy = .086
11.	6" x 16 ga., Sx = .807	Ix = 2.510	Iy = .105
12.	6" x 14 ga., Sx = 1.035	Ix = 3.109	Iy = .126


c. Joists: (S is effective properties, I is gross properties).

1.	6" x 18 ga., Sx = .777	Ix = 2.600	Iy = .243
2.	6" x 16 ga., Sx = 1.003	Ix = 3.312	Iy = .327
3.	6" x 14 ga., Sx = 1.322	Ix = 4.115	Iy = .402
4.	6" x 12 ga., Sx = 1.852	Ix = 5.556	Iy = .522
5.	8" x 18 ga., Sx = 1.128	Ix = 5.140	Iy = .264
6.	8" x 16 ga., Sx = 1.481	Ix = 6.559	Iy = .356
7.	8" x 14 ga., Sx = 1.971	Ix = 8.166	Iy = .437
8.	8" x 12 ga., Sx = 2.776	Ix = 11.104	Iy = .568
9.	10" x 16 ga., Sx = 1.812	Ix = 11.256	Iy = .376
10.	10" x 14 ga., Sx = 2.753	Ix = 14.035	Iy = .462
11.	10" x 12 ga., Sx = 3.836	Ix = 19.182	Iy = .601
12.	12" x 16 ga., Sx = 2.152	Ix = 17.631	Iy = .392
13.	12" x 14 ga., Sx = 3.268	Ix = 22.006	Iy = .481
14.	12" x 12 ga., Sx = 5.033	Ix = 30.195	Iy = .626

d. Track: (S is effective properties, I is gross properties).

1.	3½" x 20 ga., Sx = .170	Ix = .458	Iy = .049
2.	3½" x 18 ga., Sx = .246	Ix = .607	Iy = .064
3.	3½" x 16 ga., Sx = .312	Ix = .764	Iy = .079
4.	3½" x 14 ga., Sx = .425	Ix = .967	Iy = .099
5.	4" x 20 ga., Sx = .207	Ix = .619	Iy = .051
6.	4" x 18 ga., Sx = .297	Ix = .818	Iy = .066
7.	4" x 16 ga., Sx = .376	Ix = 1.029	Iy = .082
8.	4" x 14 ga., Sx = .510	Ix = 1.300	Iy = .102
9.	6" x 20 ga., Sx = .330	Ix = 1.585	Iy = .057
10.	6" x 18 ga., Sx = .539	Ix = 2.082	Iy = .073
11.	6" x 16 ga., Sx = .680	Ix = 2.616	Iy = .091
12.	6" x 14 ga., Sx = .909	Ix = 3.300	Iy = .113

- Install cold formed steel framing and accessories in accordance with the manufacturer's recommendations.
- Fastening of cold formed steel framing shall be with self-drilling screws or welding as

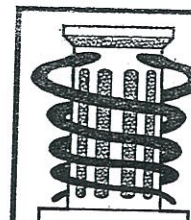


Medical Design Group  
Architecture for Health Care

2716 WESTLAND PLACE  
BOISE, IDAHO 83704-5863

BOISEARCHITECT@AOL.COM  
Fax (208) 378-1405  
Phone (208) 378-0817

© COPYRIGHT: MEDICAL DESIGN GROUP

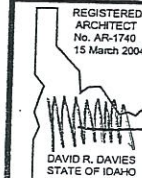

STRUCTURAL SPECS

Desert Sage Health Center  
2280 American Legion Blvd.  
Mountain Home, Idaho

SHEET  
3.02

Feb 2004

- noted in the Construction Documents, unless noted otherwise.
- Provide horizontal bridging at all bearing walls at 4'-0" o.c. vertically maximum.
  - Provide temporary bracing for all bearing walls during construction prior to sheathing.
  - Veneer to be anchored to stud walls with "Dur-O-Wall" D/4 431 seismic strap anchors at 16" on center each way with #10 screws.

**LUMBER:**

- Sawn lumber for joists, etc. (2x6 or larger) = No. 2 Doug Fir Larch.
- Sawn lumber for joists, etc. (2x4 or larger) = No. 2 Doug Fir Larch.
- Sawn lumber for wall plates = No. 2 Doug Fir Larch.
- 2xStuds = Stud Doug Fir Larch.
- Posts, stringers and beams = No. 1 Doug Fir Larch.
- Roof ply/OSB = 15/32" CDX, 32/16 APA Rated unblocked, provide one H Clip per span minimum, unless noted otherwise in plans. If roof is blocked, install blocking and do not install H Clips.
- Floor ply/OSB = 23/32" CDX, 48/24 APA Rated unblocked.
- Roof nailing = 8d at 6" o.c. all supported edges, 12" o.c. in field, see also diaphragm schedule.
- Floor nailing = 10d at 6" o.c. all supported edges, 12" o.c. in field.
- Wall ply/OSB = 7/16" CDX, APA Rated.
- Wall nailing = 8d at 6" o.c. edges and 12" o.c. in field with blocked ply/OSB edges as noted in plans. See also Shearwall Schedule.
- All ply/OSB nailing shall be 3/8" minimum from panel edges. Provide 1/8" spacing between panel edges by means of nails or Simpson PSCL sheathing clips.
- All nailing shall, at a minimum, meet the requirements of IBC Chapter 23 Table 2304.9.1 Fastening Schedule.
- All nails are to be common nails unless noted otherwise. All staples are 7/16" crown x 1-3/4" long unless noted otherwise. All nails and staples shall conform with IBC Chapter 23, Section 2303.6.
- Follow manufacturer's recommendations for all Simpson, or equal, connections. All connectors shall conform to IBC Chapter 23, Section 2303.5.
- Glu-Lam beams:
  - Simple span members combination 24F-V4 DF/DF.
  - Continuous span members combinations 24F-V8 DF/DF.
  - Provide minimum camber radius of 2,000 ft. for 1-1/2 times the supported dead load if camber is specified in the Construction Documents.
- Trus-Joist products:
  - Roof joists shown as TJI etc. shall be designed for the loads specified and shall conform to Trus-Joist specification.
  - Joists exceeding 24' in length shall be cambered to a standard radius of R = 2250.
  - Any alternate joist system(s) shall be the same depth and load carrying capacity as the Trus-Joist system shown on the drawings.
  - Camber shall not exceed Trus-Joist maximum camber for commercial Parallams. Camber is specified in Construction Documents.
  - Micro Lam Products shall conform to the following values:

Microllam LVL; Parallam PSL (18" deep end under); Parallam PSL (Over 18" deep);

E = 1.9E6 psi	E = 2.0E6 psi	E = 2.0E6 psi
Fb = 2600 psi	Fb = 2900 psi	Fb = 2900 psi
Fc per = 750 psi	Fc per = 650 psi	Fc per = 750 psi
Fc par = 2310 psi	Fc par = 2900 psi	Fc par = 2900 psi
Fv = 285 psi	Fv = 290 psi	Fv = 290 psi

**Timber Strand LSL (Headers); Timber Strand LSL (Wall studs)**

E = 1.5E6 psi	E = 1.5E6 psi
Fb = 2250 psi	Fb = 2250 psi
Fc per = 750 psi	Fc per = 350 psi
Fc par = 1950 psi	Fc par = 1950 psi
Fv = 285 psi	Fv = 400 psi

**18. Premanufactured Trusses**

- Truss Loading:
 

Top Chord	D.L. = 25 PSF.
Bottom Chord	D.L. = 5 PSF.
Top Chord	L.L. = 20 PSF, S.L. = 25 PSF.
- Member Properties:
 

Chords shall be #2 Douglas Fir or better.  
Webs shall have minimum Modulus of Elasticity of 1,500,000 psi.
- All truss blocking shall be provided by the truss manufacturer and constructed with approved plates.
- Truss manufacturer shall verify all truss dimensions, accounting for tolerances, connections, and splice requirements.
- All truss connections design shall be the responsibility of the truss manufacturer. Truss manufacturer shall design all truss connections for loads shown in Structural Notes, Construction Documents and as required by governing codes.
- Truss profiles shown are representations of possible configurations of web locations and member sizes. Truss manufacturer shall submit shop drawings for approval in accordance with IBC Chapter 23, Section 2303.4.1. All trusses shall be designed by a registered Professional Engineer and all shop drawings shall be stamped and signed by a registered Professional Engineer in the State of Idaho. Shop drawings shall be submitted for approval prior to construction.
- Truss manufacturer shall provide proof of approved third party inspection as required by IBC Chapter 23, Section 2303.4.
- Each truss shall be marked with the following information:
  - Manufacturer's identity.
  - Design load.
  - Truss spacing.
- Brick veneer to be anchored to stud walls with 22 ga. x 1" nominal anchors at 1'-4" o.c., both vertical and horizontal.
- Log work shall conform to the Log Building Standards, latest edition.
- Log properties shall conform to the Timber Products Inspection Design Values.
- All logs shall be Lodgepole Pine No. 1. The diameter shall be as noted in the plans.

**DEFERRED SUBMITTALS**

The following list of deferred submittals shall be submitted to Architect/Engineer for

review in accordance with IBC Section 106.3.4.2.  
Pre-Engineered Trusses

**SPECIAL INSPECTION**

Special Inspection, as specified in Chapter 17, Section 1704 of the IBC, is required as noted for the following items. The Contractor shall provide a minimum of 48 hours notice to Special Inspector prior to inspection.

**I. Steel Construction:**

**A. Fabrication:**

- Not required per IBC Section 1704.3, Exception 1.
- 1. Material verification of high-strength bolts;
  - Not required.
- 2. Inspection of high strength bolting;
  - Not required.
- 3. Inspection of Welding:
  - Structural Steel.
    - Not required.
  - Reinforcing Steel:
    - Not required.


**II. Concrete Construction:**

- Footings & Foundations:
  - Not required per IBC Section 1704.4, Exception 1, 2, 3, 4 or 5.
- Inspection of reinforcing steel:
  - Not required.
- Inspection of bolts in concrete:
  - Not required.
- Verification of required mix design:
  - Not required.
- Sampling and testing concrete:
  - Not required.
- Inspection of concrete and shotcrete placement:
  - Not required.
- Inspection of specified curing temperature and techniques:
  - Not required.
- Inspection of prestressed concrete:
  - Not required.
- Erection of precast concrete members.
  - Not required.
- Verification of in-situ concrete, prior to stressing of tendons in post tensioned concrete and prior to removal of shoring and forms from beams and structural slabs.
  - Not required.

**III. Wood Construction:**

- Per soils report.

**IV. Soils:**

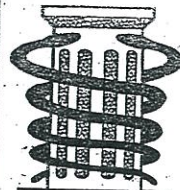

**Medical Design Group**  
Architecture for Health Care

2716 WESTLAND PLACE  
BOISE, IDAHO 83704-5863

BOISEARCHITECT@AOL.COM  
Fax (208) 378-1405  
Phone (208) 378-0817

© COPYRIGHT: MEDICAL DESIGN GROUP

---

REGISTERED ARCHITECT  
No. AR-1740  
15 March 2004

**STRUCTURAL SPECS**

Desert Sage Health Center SHEET  
2280 American Legion Blvd.  
Mountain Home, Idaho 3.03

DAVID R. DAVIES  
STATE OF IDAHO

Mar 2004

- Not required per IBC Section 1704.7 Exception.
  - Required per IBC Section 1704.7.1.
  - Required per IBC Section 1704.7.2.
  - Required per IBC Section 1704.7.3.
- XI. Adhesive and/or epoxy anchors:
- Provide special inspection.

DETAIL FILENAME:  
D:\ERIC\PROJECTS\DESERT SAGE\ShearWall1

CREATION DATE:  
26/SEPT/03

**PINNACLE**  
Engineers, Inc.  
870 N. Under Suite B, Meridian, Idaho 83642  
(208) 887-7760

DRAWN BY:  
EW

CHECKED BY:  
EW

SHEAR WALL SCHEDULE				
MARK #	SHEATHING	NAILING	END MEMBERS	SILL ANCHORS
△	APA 7/16" PLY/OSB, ONE SIDE, BLOCKED	8d @ 6" O.C. EDGES, 8d @ 12" O.C. FIELD	(1) 2 x	1/2" x 7" EMBED. @ 3'-0" O.C.
△	APA 7/16" PLY/OSB, ONE SIDE, BLOCKED	8d @ 4" O.C. EDGES, 8d @ 12" O.C. FIELD	(1) 2 x	1/2" x 7" EMBED. @ 2'-0" O.C.

NOTE: SILL ANCHOR SPACING IS UNDER SHEAR WALLS, SPACE ALL OTHER EXTERIOR SILL ANCHORS @ 4'-0" O.C.

TABLE OF EQUIVALENT FOR STAPLES <small>(VALID FOR LATERAL LOAD ONLY)</small>					
COMMON NAIL SPACING	EQUIVALENT SPACING OF APPR'D FASTENER				
	GAUGE	16	15	14	13
6d AT DIA. = .113 PEN. = 1 1/4"	PENE-TRATION	1"	1"	1"	1"
	2" O.C.	NA	2" O.C.	2" O.C.	3" O.C.
	3" O.C.	2" O.C.	3" O.C.	3" O.C.	5" O.C.
	4" O.C.	3" O.C.	4" O.C.	5" O.C.	6" O.C.
	6" O.C.	5" O.C.	6" O.C.	7" O.C.	8" O.C.
8d AT DIA. = .131 PEN. = 1 1/2"	2" O.C.	NA	NA	NA	2" O.C.
	3" O.C.	NA	2"	2"	3" O.C.
	4" O.C.	2" O.C.	3" O.C.	3" O.C.	5" O.C.
	6" O.C.	4" O.C.	5" O.C.	6" O.C.	6" O.C.
	12" O.C.	6" O.C.	8" O.C.	12" O.C.	12" O.C.
10d AT DIA. = .148 PEN. = 1 5/8"	2" O.C.	NA	NA	NA	NA
	3" O.C.	NA	NA	NA	2" O.C.
	4" O.C.	NA	2" O.C.	2" O.C.	3" O.C.
	6" O.C.	2" O.C.	3" O.C.	4" O.C.	5" O.C.
	12" O.C.	4" O.C.	5" O.C.	6" O.C.	8" O.C.

NOTES:  
1) PENETRATION IS THE DEPTH OF THE EMBEDMENT OF THE STAPLE OR NAIL INTO THE MAIN MEMBER REQ'D TO ATTAIN ITS FULL CAPACITY SHEAR VALUE FOR LATERAL LOADING.  
2) NAILS ARE COMMON NAILS. STAPLES ARE 7/16" CROWN x 1 3/4" LONG.


HOLDOWN SCHEDULE			
MARK #	TYPE	WOOD MEMBER	COMMENTS
■	SIMPSON STD14/STD14RJ	(2) 2x OR (1) 4x	SEE SHEARWALL SCHEDULE RJ - RIM JOIST APPLICATION

19/32"

DIAPHRAGM SCHEDULE			
MARK #	MATERIAL	BLOCKED	NAILING
△	3/8" PLY, 32/16, APA RATED (MIN.)	NO	8d @ 6" O.C. EDGES, 12" O.C. FIELD
△	3/8" PLY, 48/24, APA RATED (MIN.)	NO	10d @ 6" O.C. EDGES, 12" O.C. FIELD

1 1/8" Sturdy-floor glue & nail.

**SHEARWALL, HOLDOWN & DIAPHRAGM SCHEDULE**



**Medical Design Group**  
Architecture for Health Care  
2716 WESTLAND PLACE  
BOISE, IDAHO 83704-5863  
BOISEARCHITECT@AOL.COM  
Fax: (208) 378-1405  
Phone: (208) 378-0817

REGISTERED ARCHITECT  
No. AR-1740  
15 March 2004

DAVID R. DAVIES  
STATE OF IDAHO

© COPYRIGHT MEDICAL DESIGN GROUP

STRUC/ARCH SPECS

Desert Sage Health Center  
2280 American Legion Blvd.  
Mountain Home, Idaho

SHEET  
3.04

Mar 2004



**Envelope Compliance Certificate  
2001 IECC**

COMcheck-EZ Software Version 2.5 Release 1  
Data filename: Untitled

**Section 1: Project Information**

Project Name: Desert Sage Health center  
Designer/Contractor: Medical Design Group, Architect  
Document Author: David R. Davies

**Section 2: General Information**

Building Location (for weather data): Mountain Home, Idaho  
Climate Zone: 13b  
Heating Degree Days (base 65 degrees F): 6176  
Cooling Degree Days (base 65 degrees F): 741  
Project Type: New Construction

Building Type	Floor Area
Medical and Clinical Care	8557

**Section 3: Requirements Checklist**

- Bldg. |  
Dept. |  
Use |
- Air Leakage, Component Certification, and Vapor Retarder Requirements**
- [ ] | 1. All joints and penetrations are caulked, gasketed, weather-stripped, or otherwise sealed.
  - [ ] | 2. Windows, doors, and skylights certified as meeting leakage requirements.
  - [ ] | 3. Component R-values & U-factors labeled as certified.
  - [ ] | 4. Vapor retarder installed.

Permit Number

Checked By/Date

**Climate-Specific Requirements**

Component Name/Description	Gross Area	Cavity R-Value	Cont. R-Value	Proposed U-Factor	Budget U-Factor
Roof 1: All-Wood Joist/Rafter/Truss	7323	38.0	0.0	0.028	0.054
Roof 2: All-Wood Joist/Rafter/Truss	1188	30.0	0.0	0.035	0.054
Skylight 1: Metal Frame, Double Pane with Low-E Tinted, SHGC 0.59	64	--	--	0.600	0.054
Exterior Wall 1: Wood Frame, Any Spacing	2431	21.0	6.0	0.045	0.086
Window 1: Metal Frame with Thermal Break, Double Pane with Low-E Tinted, SHGC 0.58, PF 0.75	702	--	--	0.540	0.579
Window 2: Metal Frame with Thermal Break, Double Pane with Low-E Tinted, SHGC 0.58, PF 0.56	32	--	--	0.540	0.579
Door 1: Glass, Tinted, SHGC 0.47, PF 0.50	96	--	--	0.920	0.579
Exterior Wall 2: Wood Frame, Any Spacing	1309	21.0	0.0	0.062	0.086
Interior Wall 1: Wood Frame, Any Spacing	160	19.0	0.0	0.066	0.136
Interior Wall 2: Metal Frame, 16" o.c.	240	19.0	0.0	0.110	0.136

(a) Budget U-factors are used for software baseline calculations ONLY, and are not code requirements.

**Envelope PASSES:** Design 29% better than code


**Section 4: Compliance Statement**

The proposed envelope design represented in this document is consistent with the building plans, specifications and other calculations submitted with this permit application. The proposed envelope system has been designed to meet the 2001 IECC, Chapter 8, requirements in COMcheck-EZ Version 2.5 Release 1 and to comply with the mandatory requirements in the Requirements Checklist.

*David Davies*  
Principal Envelope Designer-Name

*[Signature]*  
Signature

*2/26/04*  
Date



**Medical Design Group**  
Architecture for Health Care

2716 WESTLAND PLACE  
BOISE, IDAHO 83704-5863

BOISEARCHITECT@AOL.COM  
Fax (208) 378-1405  
Phone (208) 378-0817

© COPYRIGHT: MEDICAL DESIGN GROUP

---

REGISTERED ARCHITECT  
No. AR-1740  
15 March 2004

DAVID R. DAVIES  
STATE OF IDAHO

**ENERGY ANALYSIS**

Desert Sage Health Center  
2280 American Legion Blvd.  
Mountain Home, Idaho

SHEET  
**3.05**

Mar 2004 ds305.dwg 01/29/04 08:53


DIVISION 01 - General

- 01.03 Any requested substitutions to be accompanied with the CSI substitution request form and delivered to the office of the Architect at least 10 days prior to bid date.
- 01.04 Payment Application to be on form AIA G702 on or before 25th of the month. Payment by Owner within 30 days after certification by Architect, approval by the owner and acceptance by the funding agency.
- 01.06 All submittals required to be submitted to the architect within 30 days of notice to proceed. Architect to review and return within 14 calendar days.
- 01.08 General contractor required to provide the following for this project:
  - Full time on-site superintendent
  - Temporary electricity, lighting, heat, ventilation, water, sanitary facilities
  - On-site telephone and fax machine
  - Required construction barriers and/or fencing
  - Progress cleaning and final cleaning prior to Owner occupancy.
  - 4' x 8' professionally painted job site sign approved by the Architect erected within 10 days of Notice to Proceed.
  - Full Labor, Performance and Payment bonds.
- 01.09 All work to be in full conformance with applicable codes and laws.
- 01.10 All materials included in the work to be new.
- 01.11 Construction Close Out:
  - General contractor to submit written certification to Architect that work is in full conformance with the contract documents. Owner training has been accomplished to the satisfaction of the Owner.
  - Equipment systems are adjusted, tested and fully operational
  - Close out submittals (2 copies) have been approved by the Architect.
  - Close out submittals to include: Certificate of Occupancy, Project record documents, O&M data, Warranties and Bonds, Spare parts and Maintenance Materials, Keys, Evidence of

- 04.07 Faux Stone: Cultured Stone by Owens Corning with the following components: Weather barrier (see div. 06), 2.5 lb. Metal Lath or 18 ga. Galv. Woven wire mesh, galv. Nail fasteners, Type N mortar (1 part Type N cement, 1 part lime, 4.5 to 6 parts sand), Mortar color (selection by Architect), and Cultured Stone including field pieces, corner pieces and wainscot cap pieces as applicable, and Silane base masonry sealer.
- 04.08 Faux Stone: Install per manufacturer's published instructions under NER report 358 to achieve a 50 year limited warranty.
- 04.09 Faux Stone: Color to be per architectural color schedule.
- 04.10 Reinforced Unit Masonry System: ACI 530 - Building Code Requirements for Masonry Systems, IMIAC - Recommended Practices and Guide Specifications for Cold and Hot Weather Construction. Utilize Type I, moisture controlled masonry units, ASTM C-90, 2800 psi compressive strength. Composite Masonry Strength: fm = 1500 psi. Reinforcing Steel: ASTM A615, 60 ksi.

DIVISION 06 - Woods and Plastics

- 06.03 Sill Plate Seal: 1/4" polyurethane foam
- 06.04 Building Paper: DuPont Tyvek or DuPont Tyvek Stucco Wrap, install horizontally over exterior wall sheathing. Lap edges 6" min. to shed water and secure.
- 06.15 Finish carpentry: provide and install finish carpentry items other than custom casework, max tolerance from true position: 1/16".
- 06.16 Trim Wood to be oak (light stain) and <sup>oak</sup> (dark stain). Finish to be stained two colors to match wood doors.
- 06.17 Install finish carpentry in accordance with AWI custom quality standard.
- 06.18 Custom Casework: Provide and install: cabinet units, counter tops, cabinet hardware, prefinished surfaces in compliance with AWI's "AWI/AWMAC Quality Standards Illustrated"; Custom Grade. Furnish shop drawings. PROVIDE AWI QUALITY CERTIFICATION PROGRAM CERTIFICATE INDICATING THAT WOODWORK COMPLIES WITH REQUIREMENTS OF

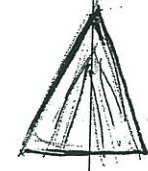

07.10

- 07.03 Foil/Scrim/Kraft with flame spread less than 25 and a smoke density of less than 450. Anchor to substrate at 3" o.c. Design intent: provide a continuous vapor barrier throughout the building envelope. Vapor barrier is to be air tight and free from holes, tears and punctures.
- 07.04 Batt and Blanket insulation: Provide and install acoustical batt insulation, thermal, unfaced batt insulation; R-19 min at exterior walls, R-38 min at attic. Match framing spacing.
- 07.04 Concrete Roof Tile: Bartile, Shake Style. Install in strict accordance with manufacturer's written instructions. Color per Architectural Color Selection Instructions.
- 07.05 Asphalt shingles: Provide and install granular surfaced fiberglass reinforced asphalt shingle roofing, 30# underlayment, plus 60 mil ice dam protection min. 2" upslope beyond interior face of exterior wall and 2" each side of valleys, and all roof penetration and edge flashings weather lapped and sealed watertight. Contractor performing roofing work is solely responsible for complete weather tightness for the entire roof system. Min. air temperature while performing work: 50 degrees.
- 07.06 Asphalt shingle: Elk Prestique with manufacturer's pro-rated warranty for 50 years.
- 07.07 Sheet metal flashing and trim: provide and install roof flashings, reglets and misc. exposed metal trim and flashings, concealed brick, masonry and foundation flashings and window and door head flashings, gutter and downspout. Exposed flashings: shop pre-coated with Kynar 500. Provide 20 year warranty for degradation of metal finish. Color of flashing to be per Architectural Color Selection Instructions. Caulk all metal joints.
- 07.08 Joint Sealers: Sikaflex 2c NS/SL FS TT-S-00227 at exterior locations except as specifically noted in this paragraph; Sikaflex 1a FS TT-S-00230 at interior door/window frames, metal flashing lap joints and masonry reglets and Sikaflex 15 LM FS TT-S-01543 at interior high moisture and mildew areas. Translucent Skylights - Kallwall Translucent Daylighting Panels, Self-flashing Single Slope Crystal-Crystal, 2.5 R Factor, 65% Light Transmission, thermally broken perimeter framing. Live Load per code analysis on cover sheet of drawings. Submit shop drawings. 2 3/4" panel thickness. Grid pattern - In-line

- 08.02a species to be Red Oak Finish to be stained. See door schedule and Architectural Color Selection Instructions.
- 08.05 Raise Panel wood doors (bid alternate): Marshfield Stile and Rail Doors, 1 3/4" thick, Red Oak Veneer, Lifetime Warranty. Aluminum entrances and storefronts: Provide and install aluminum doors, frames and glazed lights, glass, anchors, brackets and attachments and hardware. Provide 5 year manufacturer's warranty. Product: EFCO Thermal D502 entrance and framing at exterior locations D500 entrances and framing at interior locations or prior approved equal (during bidding). Hardware: Weather stripping at exterior locations, off set pivot hinges, threshold door bottom, closer: LCN 4041, Adams Rite 4510 Latch Lock cylinder, push-pull: ultralite, solid metal kickplate. Hardware finish to be US26D. Door and Window Kynar 500 prefinished color to be selected by architect from standard or premium color finish. Provide shop drawing submittal.
- 08.06 Aluminum windows: Provide and install aluminum windows, operating hardware, perimeter sealant, glazing (shop glazed) to be EFCO window 890 series thermal Equal Sightline, 3 1/2" frame or prior approved equal.. Kynar 500 frame color to be per Architectural Color Selection Instructions
- 08.08 Door hardware: Finish to be US10B, Antique Bronze. Hinges: McKinney T4B3786. Locksets and latches: Best 94K7-\*\*-14L-S3. See door schedule for lockset functions. (entry = AB, Classroom = R, Passage = ON, Storage = D and Privacy = OL). Lever Latch Lock: Adams Rite 4510 Closer: LCN 4041 series, DA, ADA. Push/Pulls: 2350P Quality and 402 Quality Stops and holders: Floor: 119 Quality, HD Floor: 1209 Trimco, Panic Device: Von Duprin Series 35 rim surface vertical rod type with lever/key cylinder. Wall: 302 Quality, Overhead stop: GJ100LPS Glynn-Johnson, Door Holder: 1149-A Quality. Kickplates: 48 Quality, Weatherstrip and seals: S88D Pemko, Threshold: 2005BS light seal. Low Energy Power Assisted Opener: Horton series 7000 easy Access Low-Energy Electric Swing Door Operator. <http://www.hortondors.com> Keyless Interior Latchset: Best Keypad Electronic Lock, trim to match latchset as noted above. Typical at all doors: frame silencers.
- 08.09 Glazing: Provide and install 1/4" thick clear float (ASTM

- 01.12 Payment and Release of Liens, Consent of Surety to Final Payment, Certified completed list of final punch list items. Items paid by Owner: Permanent Electrical, Sewer and Water connection fees, Plan Check and Building Permit fees, Fire department review fees, Traffic Impact fees and Materials Testing and Inspection costs. All other fees, permits, licenses and charges for services and connections to outside services by Contractor.
- 01.13 On Change Orders: Maximum Overhead and Profit mark-up by subcontractor on raw labor and material costs shall be 10% plus any bonding costs.
- 01.14 On Change Orders: Maximum Overhead and Profit markup by general contractor to subcontractors costs, and raw labor and materials costs incurred by the general contractor shall be 15% plus any bonding costs.
- 01.15 On Change Orders: On credits back to the owner, the Minimum credit for Overhead and Profit shall be 10% on labor, materials and subcontractor items plus any bonding costs.
- 01.17 Sub-Contractor Minimum Insurance Requirements: Same as General Contractor except \$500,000 each for General Liability and Automobile Liability.
- 01.18 Materials Testing: In coordination with the architect, test sub-base and base materials for compaction prior to placement of concrete or asphalt materials, and also at the site of the demolished house and basement as noted on the site plan. Also, test concrete for slump, air and strength, test asphalt for compaction. Contact MTH of Boise for testing services. (376-4748)

DIVISION 02 - Site

- 02.10 Foundation vent wall - Lay-right Foundation vent wall FV168E or equivalent. Bowman & Kemp Steel and Supply; Inc. (801) 733-7886
- 02.11 Pole Mounted Exterior Site Signs: Advances Sign, Boise, Idaho 2" square punched tube. Sign Schedule: (2) stop/buckle seat belts combination signs and (5) ADA parking signs.

DIVISION 04 - Masonry

- 06.19 GRADES SPECIFIED. AWI Quality Cert. Proj No.: 04.017 Casework wood materials: Softwood lumber: 8% max moisture. Hardwood lumber oak veneer at all door and drawer fronts and face frames. Stain to match Hardwood Interior Doors (light stain). See the Architectural Color Selection Instructions. Utilize Birch wood where a Dark Stain is noted.
- 06.20 Casework sheet materials: Permalam thermoset decorative panels, 45 pound wood particle board at all interior semi-exposed surfaces. Location: Drawer construction, Gables and backs, Shelving. Color by architect from manufacturer's standard colors.
- 06.21 Casework Plastic laminate: Counter tops NEMA 0.050 inch general purpose.
- 06.22 Casework edge trim: Solid hardwood on all exposed edges where Hardwood lumber is specified.
- 06.23 Casework Hardware: Shelf Standards: Blum 34.0040; Drawer and Door Pulls: 4" wire pulls, finish to match Div. 08 door hardware; Cabinet locks: Dead Bolt 5 pin tumbler locks equal to Olympus 100DR and 200DW; Drawer glides: Blum ~~420~~ <sup>239</sup> series or ~~Access Model 1200~~; Extra heavy drawer guides: Blum 426A series; Hinges: European style, Blum or eq., 125 degree self-closing concealed clip hinges, (2) per doors under 36" high, (3) per doors between 37" and 60" and (4) on doors taller than 60"; Cable grommets: two part 60mm with spring closure by Hafele or eq.
- 06.24 Shelf width: 30" wide or smaller: 3/4", 30" to 42": 1" wide, shelves above 42 inches are not allowed without intermediate support.
- 06.25 Crawl Space Access Door Hardware: Stanley 1215 Trap Door Pull Ring
- 06.26 Reception Window: Knape&Vogt P99Z 2C w/ 1/4" min. tempered glass

DIVISION 07 - Thermal and Moisture Protection

- 07.01 Bituminous Dampproofing: Sonneborn Hydrocide 600 installed on exterior side of foundation walls.
- 07.02 Vapor and Air Retarders: Under Slab and at ground level at crawl space: 10 mil clear polyethylene; At exterior walls and ceiling on warm side of insulation directly beneath gypsum board: 6 mil clear polyethylene; At exterior walls and ceiling on warm side of insulation not directly beneath gypsum board:

- 07.11 Shoji. Alum finish: Class II Clear, 204-R1, 0.4 mil thickness. Install flashings, fasteners, hardware, sealants and glazing materials required for a complete weatherproof installation. Provide manufacturer's ten year weather tightness warranty against any leaks. Warranty to fully cover costs of materials and labor.
- 07.11 Architectural Wall Panels: Preformed flat seam wall panel system with manufacturer's fasteners, flashing and trim. Warranty: Manufacturer's 20 year finish and material warranty and Installer's 2 year warranty. Warranty: Garland Co., Cleveland, Ohio, R-MER FSP, 24 gauge steel, fluorocarbon finish, mfr. Standard color.
- 07.12a Modified Bituminous Membrane Roofing with insulation- Torch Applied. Over properly prepared substrate which is to include: 2 layers of 2" polyisocyanurate, 1/4" Dens-Prime, and .5/12 tapered polyisocyanurate crickets mechanically fastened to deck according to roofing system manufacturer's guidelines. install the following roofing system. 195 mil Modified Stressply IV Mineral surfaced roofing membrane with dual fiberglass scrim over two layers of HPR SBS torch base sheet. Include all flashings, counter-flashings, curbs and penetrations according to Garland guidelines. Submittals Required. Manufacturer: Garland Co., Cleveland, OH. Warranty: Manufacturer 30 year water tightness. Installer: 2 year. Annual inspections for the life of the warranty.
- 07.14 Roofing Sealant: Concealed: PT1-707 Exposed: GE Silglaze II 2800

DIVISION 08 - Doors and Windows

- 08.01 Exterior Standard steel doors and frames: Provide and install SDI-100 Grade III 16 gauge model 2 and 2A doors and 16 gauge fully welded steel frames equivalent to Steelcraft. Insulate exterior doors. Provide factory zinc chromate prime coat. Fire rated doors/frames conform to NFPA 252, provide door labeling per UBC. Max. tolerance 1/16"
- 08.02 Flush wood doors: Provide and install fire rated and non-fire rated 5 ply AWI PC-5 premium grade hardwood veneer doors equal to Weyerhaeuser/Marshfield and door light kits. Veneer

Matt Hedlund  
(208) 850-1021  
Manufacturers Rep  
Cultured Stone

	<b>Medical Design Group</b> Architecture for Health Care	
	2716 WESTLAND PLACE BOISE, IDAHO 83704-5863 BOISEARCHITECT@AOL.COM Fax (208) 378-1405 Phone (208) 378-0817	
© COPYRIGHT: MEDICAL DESIGN GROUP		
<b>ARCHITECTURAL SPECS</b>		SHEET <b>3.06</b>
Desert Sage Health Center 2280 American Legion Blvd. Mountain Home, Idaho		Mar 2004 ds306.dwg 03/19/04 15:40

C1036), 1/4" thick clear safety (ASTM C1048), 1/4" thick mirror glass, 1" overall thickness insulated glass units (ASTM E774) - 1/4" thick each glass pane with 3/8" air space. Provide ten year pro-rated warranty on insulating glass units. Utilize safety glass where required by code. Utilize insulated glass units at all exterior locations. All exterior glass: medium grey tint. The work of this contract includes the glazing for one door at the old Desert Sage Clinic location in Mountain Home. The existing clinic has an etched glass panel approx 24" x 72". Remove that existing panel, carefully measure the panel and fit it into the new door no. 126 at the new building. Replace the glazing at the old location with a clear piece of 1/4" tempered glazing.

DIVISION 09 - Finishes

- 09.01 Light Gauge Metal Studs: Provide and install non-load bearing formed steel interior wall framing, accessories for steel stud walls and backing for all wall mounted equipment, door wall stops and accessories. Max. allowable deflection - L/240. Design system to provide for movement of components without damage, failure of joint seals, undue stress on fasteners or failure due to temperature variations. Utilize Angeles Metal System or equal. Studs, and furring channels: 25 gauge except 16 gauge at areas where wall mounted cabinets occur where blocking is required. Tracks and headers: 20 gauge. Backing: utilize 3/4" cdx plywood or solid 2x lumber. Tolerance: 1/8" in 10'.
- 09.04 Exterior Coatings (Lath and Plaster Stucco): Provide and install exterior stucco system consisting of EPS Insulation board, 20 Ga. metal lath, Stucco base coat, elastomeric/acrylic finish coat and accessories such as continuous screened galvanized soffit vent, sealants and control joints. Manufacturer: Western Stucco Products Co., Inc. Product: Western One-Kote, ICBO report ER-3899 or prior approved equal.
- 09.05 Gypsum Board Systems: Provide and install 5/8" type X gypsum board, taped and sanded joint treatment, Light orange peel sprayed texture finish and installation of acoustical sealant at sound rated wall perimeters and accessories including edge trim, control joints at walls greater than 30 in

- 09.10a and Kote by Sonneborn, Two coats Sonothane MVP by Sonneborn. Color selected by Architect from manufacturer's standard colors. Architect may select up to 10 paint colors.
- 9.11 Fabric Wall Covering: Tri-Kes, Halcyon 63
- 9.12 Acrylic Impregnated Hardwood Flooring: Gamapar, Beach, maple, Natural Finish, translations 31777
- Sheet Vinyl Flooring: Armstrong Possibilities, Heat welded seams mint

DIVISION 10 - Specialities

- 10.01 Fixed foundation wall louver. Provide and install 8" x 16" Witten Automatic Vent which open and close automatically based on the air temperature. Manufactured by Witten Automatic Vent Co. [www.doityourself.com](http://www.doityourself.com)
- 10.02 Corner Guards: Provide and install 4'-0" long IPC 4212 Series corner guards. Utilize smaller width in "back to back" installation situations. Color: clear. Fastener: Self tapping screws into wall studs or solid backing.
- 10.03 Vinyl letters: Provide and install vinyl adhesive type building numbers adhered to the glass at the front door which satisfy building code requirements.
- 10.05 Plastic Signs: Provide and install panel signs which comply with ANSI 117.1 provisions for character proportions, height, raised and brailled characters and pictorial symbol. Center of sign to be 60" above finished floor adjacent to latch side of interior door on wall surface. Color by architect from manufacturer's standard. Manufacturer: Innerface Architectural Signage, Wood series, wall mounted; <http://www.innerface-signage.com>. Schedule: (4) Unisex Bathroom approx 8" x 8", (7) Exam Room signs approx 4" x 15", (2) 2-line "Exam Room/Procedure Room" signs approx 7" x 15", (1) X-Ray sign approx 4" x 15", (1) "Laboratory" Sign Approx 4" x 15", (1) "No Smoking" sign approx 4" x 15", (1) "Conference Room" sign approx 4" x 15". Note: Each exam room is to be given a unique letter/number suffix (ie. "Exam Room A1" or "Exam Room B3/Procedure Room") Unique suffixes will be A1, A2, A3, B1, B2, B3 (combination procedure room), C1 and C2.
- 10.06 Fire Extinguisher, Cabinet and Accessories: Provide and install 60 BC tank with pressure gauge, 10 lb. capacity in a white semi-recessed cabinet equal to Larsen's Manufacturing

10.13

Window Coverings: Hunter-Douglas, Duette, 3/4" pleat, Double Honeycomb Construction, color by architect from entire range of colors and Elite fabrics, semi-opaque except at office areas which are to be semi-shear with Expressions fabrics, Bottom-up with Ultra Glide and ~~along~~ along with a lifetime warranty. Dedication Plaque: Best Sign Systems #228577, 300 Letters

DIVISION 13 - Special Construction

- 13.01 Radiation Protection
  - Includes Lead Backed Gypsum Board, Lead Sheet Accessories, Gypsum Panel Fasteners, Lead Lined flush wood doors, Lead Lined Steel telescopic window frames, Radiation resistant glass, Glazing accessories.
  - References: NCRP Report No. 49, Structural Shielding Design and Evaluation for Medical Use of X-rays and Gamma Rays of Energies up to 10 MeV.
  - System Description:
    - Installed radiation protection materials shall comply with National Council on Radiation Protection, NCRP Report No. 49 for diagnostic rooms.
    - Electrical installer shall install electrical boxes centered between studs and connect conduit at the top of electrical boxes, where possible at walls with lead lining.
  - Submittals: Product Data, Shop Drawings, Certificates, Door Hardware, Site Inspection Report prepared by a Radiation shielding inspector within 10 days after site inspection or exposed radiation resistant assemblies.
  - Distributors: Wave Barriers, Shielded Building Materials, 20811 NW Cornell Rd. Ste 500, Hillsboro, OR 97124-9804 Bill Zander 1-800-498-1460
  - Components:
    - Lead Backed Gypsum Board Panels: ASTM C36, Beveled, Type X with lead backing sheet backing meeting FS QQ-L-201, Grade C.
    - Lead Sheet Accessories: FS QQ-L-201, Grade C. Batten Strips: Same thickness or greater as lead sheet on back face of adj. Wall panels, 2" wide, 7 feet long.
    - Wall Penetration Covers: Same thickness or greater than thickness of lead sheet on back face of adjacent wall panels. Size as required for not less than 1 inch wide lap with lead sheet on back face of adjacent wall panels.

- vertical gypsum panel joints.
  - B. Install lead backed gypsum board in compliance with GA-216 and ASTM C840. Install with long edges vertical. Install to within 1/4" of floor. Screw lead backed gypsum board to steel framing members at 8 inches o.c. at panel edges and 12 inches o.c. in the field. Utilize fastener tabs at wood studs.
  - C. Install Steel Door Frames using adhesive to apply lead lining in door jambs. Otherwise, install in accordance with section 08.
  - D. Install Wood Doors and Door Hardware to comply with AWI Quality Standards, Section 1700.
  - E. Install Lead Lined Steel Telescopic View Window Frames setting unlead frame plumb and square in wall opening on control room side of wall with shims. Set leaded frame inside unlead frame on X-ray side of wall and compress adjustable frame against face of wall. Secure both frames with equal spaced screws through each jamb. Install setting blocks, shims and glazing tape in glazing channel to prevent glass from touching the steel frame. Install radiation resistant glazing in telescoping frame. Place steel stops.
  - F. Install wall penetration covers by cutting the covers from lead sheet making allowance for required laps. Install penetrating wall boxes and raceways centered between studs using steel telescoping mounting brackets. Adhesive apply lead sheet penetration covers on penetrating boxes and raceways and return penetration covers to backside of lead backed wall panels with 1 inch minimum laps.
  - G. Install pipe penetrations in Walls and Ceilings by wrapping pipe with wall penetration covers lapping lead joints 1 inch minimum. To prevent radiation passage through pipe openings, offset pipe direction as close behind wall lead lining as possible so that the pipe can be backed with lead sheet sufficient to prevent radiation passage at an angle.
10. Completion:
- A. Prior to applying gypsum panels to back face of radiation resistant interior walls, employ a qualified radiation shielding inspector for field inspection of installed radiation resistant materials. Contractor to include cost for this inspection in price for construction. Written report to be issued to Architect and Owner within ten days of inspection. Repair and replace work found defective by radiation shielding inspector or testing by a

- length, joint materials and fasteners. Conform to applicable codes for fire rated assemblies. Manufacturer: USGypsum Co. or equal. Max. variation from flatness: 1/8" in 10'. Install water resistant gypsum board on the back and side walls within 5' of plumbing fixtures. Suspended Gypsum Board Systems: USG Drywall Suspension System.
- 09.07 Suspended Acoustical Ceilings: Provide and install Non-fire rated Suspended metal grid ceiling system and perimeter trim, Acoustical tile. Fully comply with seismic bracing requirements of the building code. Furnish 100 sf. of extra tile to Owner for each tile type. Manufacturer: Suspension system: Donn Corp. 9/16" Centricitee Acoustical tile: USG Eclipse 24 x 24 Climaplus style FL and USG Sand Drift 24 x 24
- 09.08 Resilient Flooring: Provide and install Sheet Linoleum flooring, 4" and 6" high Resilient Base, 1/4" Multi-ply sub-floor underlayment; Sub-floor fillers; primers and adhesives, Johnsonite Rubber floor thresholds, Heat Welded Seams. Provide 20 sf of extra stock for each type of flooring material. Manufacturer: Sheet Linoleum: Forbo Marmoleum Resilient Rubber Base: Johnsonite Carpet to Resilient transition threshold: Johnsonite CTA-XX-H 1/4" carpet to 1/8" resilient. Installation by certified Master Mechanic.
- 09.09a Carpet Base: Provide and install carpet base as specified in "Resilient Floor Base" above unless hardwood floor base is shown on the drawings in which case install a 4" x 3/4" stained hardwood floor base to match doors.
- 09.09b Carpet: Manufacturer: Collins and Aikman Product: Bahaus Boarder Carpet: Per finish plan. Include 20 year Manufacturer's non prorated warranty.
- 09.10 Painting: Provide and install Surface preparation and Surface finish. Provide two gallons of extra stock of each type and color of paint. Manufacturer: Benjamin Moore Co.. Min. temperature for application: 50 degrees. Beginning of installation means acceptance of substrate. Schedule: Pavement markings: One coat chlorinated rubber paint, white; Steel shop primed and galvanized: One coat zinc chromate primer, Two coats alkyd enamel, gloss. Gypsum Board: On coat acrylic latex primer sealer, Two coats acrylic latex enamel, semi-gloss. Gypsum Board to receive wall covering: One coat acrylic latex primer sealer. Concrete Floors: One coat Prime

- 10.07 2409-6R, vertical duo, color: white. Dimensions: 27 x 12 x 8. Verify proper fit into wall cavity prior to order. Silk screen "FIRE EXTINGUISHER" on cabinet door.
- 10.08 Lock Boxes: Provide and install one recessed mounted Knox Box at building exterior near the front entrance. Obtain purchase order from local fire chief.
- Toilet and Bath Accessories: Provide and install toilet and bath accessories as manufactured by McKinney Manufacturing Co. as follows: Toilet paper dispenser - Surface MK 1530, Grab Bars MK 9604, Janitor Closet: 224 Utility shelf, 4'-0" long with mob hooks, Feminine Napkin Disposal: 626. Paper Towel Dispenser: 609 (250 C-Fold Capacity). Recessed Paper Towel Disposal: 829. Revolving Specimen Pass-through Cabinet 895. Robe Hood 1028B. Soap dispenser by suppliers of paper towel/soap products to be installed by owner. Electronic Paper Towel Dispenser: In-Sight Elect-R-Matic HRT Dispenser, 09703, 10.5" x 15.75" x 8.6", Smoke Grey. OFCI Paper Towel Dispensers to be relocated in exam rooms: total (5). OFCI Changing Table to be located in Patient Toilet 1. Remove these OFCI accessories from the existing Desert Sage Clinic in Mountain Home and relocate to the new facility. New Accessories required include: Grab Bars (per plan), Toilet Tissue dispenser - one per water closet, Feminine Napkin Dispenser - one per water closet, One Utility shelf to be located in the Utility 1 room above the janitor sink, (10) new Paper Towel Dispensers (C-Fold type) to be located next to each hand wash sink except at bathroom sinks, (4) new Electronic Paper Towel Dispensers to be located next to each of the Bathroom Hand Wash Sinks. (4) recessed Paper Towel Disposal units (15.5"W x 28.5" H x 4" deep. Top of unit 44" AFF max. (1) Revolving Specimen Pass-through Cabinet (rough opening: 13.75" W x 14.5" H). Robe Hooks: (1) at back of door 129. All Mirrors to be OFCI. Mirrors to be wood framed and are to be securely mounted to walls in locations determined by architect.
- Fixed Wall Mounted Louver: Greenheck, Mill Finish Aluminum, Stationary Extruded Louver, Model ESK. [www.greenheck.com](http://www.greenheck.com)
- Cast Exterior Letters: Metallic Arts [www.metallicarts.com](http://www.metallicarts.com) Baked Enamel Painted Finish on Aluminum; ~~height~~ height: 12" high, 1" depth, 2.25 - 2.75" stroke, ave. width: 10.25 in both UPPER and lower case. Projected Spacer Mounting.

- D. Fastener Tabs: Same or greater thickness than thickness of lead sheet on back face of adjacent wall panels. Size not less than 1 inch wide by 2 inches long. Note: these tabs are used for screw application of gypsum panels to steel studs without batten strips and for all wood studs. See details.
  - E. Door Jamb Lining: Same or greater thickness than thickness of lead sheet on back face of adjacent wall panels. Size 7 foot long by width required by door frame.
  - F. Lockset Rose and Knob Lining: Same or greater thickness than thickness of lead sheet within adjacent door. Size as required to fill lockset rose and knob.
  - G. Frame Lining: Same or greater thickness than thickness of lead sheet on back face of adjacent wall panels. Continuous length at head and jamb, 3 pieces with 1 inch laps at frame corners.
  - G. Gypsum Panels Fasteners: Screws: ASTM 1002, 1 inch long, bugle head. Adhesive: ASTM C557.
  - H. Radiation Shielding Glass: Glass type: Polished radiation shielding glass containing not less than 50 percent lead oxide. Glass Quality: Surface: Mirror polished, 1/4" thick min. Lead Equivalency of Glass: 1.58 mm min.
  - I. Glazing Accessories: Setting Blocks: Solid Neoprene, 80 to 90 Shore A hardness. Glazing Tape: Foam neoprene.
7. Lead Lined Flush Wood Doors: AWI Custom PC-5, Lead Lined, Face Veneer and Stain Color to match other wood doors in facility as specified in section 08. Thickness: 1 3/4". Finish: comply with requirements of section 09. Door fitting requirements: 1/8" space max at perimeter except 3/8" max space at door bottom.
8. Lead Lined steel Telescopic View Window Frames: Frame: ASTM A568 and ASTM 366 with Lead Sheet Lining FS QQ-L-201, Grade C, single un-pierced strip, 1/16" thick. Frame Profile: 2 inches wide with 7/16 inch high integral fixed stop and 16 gauge applied cold rolled steel stop. Frame Construction: Two telescoping steel frames with continuous welded corner seams and lead sheet applied with adhesive to inside face of the outside frame, shop primed.
9. Execution:
- A. Installation of Radiation Resistant Wall Assemblies: Screw lead battens to steel studs at 12 inches o.c. from floor to ceiling. If wood studs are used, secure lead battens to wood studs with adhesive or brad nails from floor to ceiling behind

10.11  
10.12

Garmond  
Bald  
Italk

**Medical Design Group**  
Architecture for Health Care

2716 WESTLAND PLACE  
BOISE, IDAHO 83704-5863

BOISEARCHITECT@AOL.COM  
Fax (208) 378-1405  
Phone (208) 378-0817

© COPYRIGHT: MEDICAL DESIGN GROUP

REGISTERED ARCHITECT  
No. AR-1740  
22 March 2004

ARCHITECTURAL SPECS

Desert Sage Health Center SHEET  
2280 American Legion Blvd.  
Mountain Home, Idaho 3.07

Mar 2004 ds307.dwg 03/22/04 19:34

qualified health physicist. Cost for re-inspection if necessary shall be borne by the contractor.  
 B. Tape temporary paper signs on radiation resistant walls with the following text: "DO NOT MOUNT EQUIPMENT ON THIS WALL WITHOUT COVERING PENETRATING FASTENERS WITH LEAD SHEET OF THICKNESS REQUIRED BY ORIGINAL CONTRACT DOCUMENTS"

# ARCHITECTURAL COLOR SELECTION INSTRUCTIONS

## VERSION 02

Date: 6 August 2004  
 Project: Desert Sage Health Center, Mountain Home

### Exterior Materials


Stone: Cultured Stone Blend: 80% Souther LedgeStone (CSV 2056) and 20% Bucks Country Dressed Fieldstone (CSV 2030)  
 Stucco Light: Dryvit #812 Moonlight  
 Stucco Dark: Dryvit #131 Gull Gray > see attached sketch.  
 Aluminum Window Frames: EFCO Charcoal  
 Aluminum Storefront; South Entry: EFCO Dove Grey  
 Aluminum Storefront; Other: EFCO Charcoal  
 Glass: Medium Grey Tint  
 Metal Flashings and gutter system: Uni-clad Charcoal Gray (Kynar 500)  
 Concrete Roof Tile: Bartile: 20% Vermont Grey, 40% Laredo, 40% Lexington  
 Exterior Light Fixtures: SPI PT09 Medium Gray

### Interior Materials:

Carpet: C&A Bahaus, 56016 Itten  
 Boarder Carpet A: C&A PAII 60042 Steel  
 Boarder Carpet B: C&A SD 81363 Clarion  
 Boarder Carpet C: C&A SD 81353 Bluegrass  
 Boarder Carpet D: C&A SD 60035 Mediterranean  
 Boarder Carpet E: C&A 60056 Indigo  
 Carpet Rubber Base: Johnsonite 38 Pewter  
 Walk-off Carpet: C&A Triad, 60 Bordeaux  
 Linoleum A: Forbo Real 3053 Dove Blue w/ Johnsonite 38 Pewter  
 Linoleum B: Forbo Fresco 3866 Eternity w/ John. 21 Platinum Base  
 Sheet Vinyl: Armstrong Translations #31779 Mint  
 Wood Flooring: Gamapar, Beech, Natural  
 Stain Light: Marshfield Oak, Honey 26-85  
 Stain Dark: Marshfield Birch, Raisin 50-87  
 Interior Wood Doors: see "Stain Light" above  
 Interior Wood Trim: Varies: See drawings.  
 Solid Surface: Corian Venaro Gray, Malachite, Everest and Colbalt  
 Laminate One through Five: WA 4797-60 Burnished Spruce, WA D321-60 Brittney Blue, WA D369-60 Burgandy, WA 4829-07 Satin Silver, WA 4795-60 Windswept Pewter  
 Paint One through Ten: -to be determined-  
 Fabric Wall Covering: -to be determined-

Window Coverings:

Stucco  
 Window  
 Roof  
 Carpet  
 Painters  
 Millwork

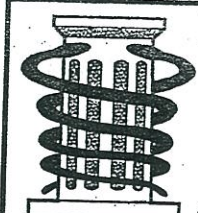

**Medical Design Group**  
 Architecture for Health Care  
 2716 WESTLAND PLACE  
 BOISE, IDAHO 83704-5863  
 BOISEARCHITECT@AOL.COM  
 Fax (208) 378-1405  
 Phone (208) 378-0817  
 © COPYRIGHT: MEDICAL DESIGN GROUP

REGISTERED ARCHITECT  
 No. AR-1740  
 22 March 2004


DAVID R. DAVIES  
 STATE OF IDAHO

ARCHITECTURAL SPECS

Desert Sage Health Center SHEET  
 2280 American Legion Blvd. 3.08  
 Mountain Home, Idaho

Mar 2004 ds308.dwg 03/22/04 19:35

C:\Program Files\Autodesk\Architectural 2\TEMPLATE\midg.dwg March 2003

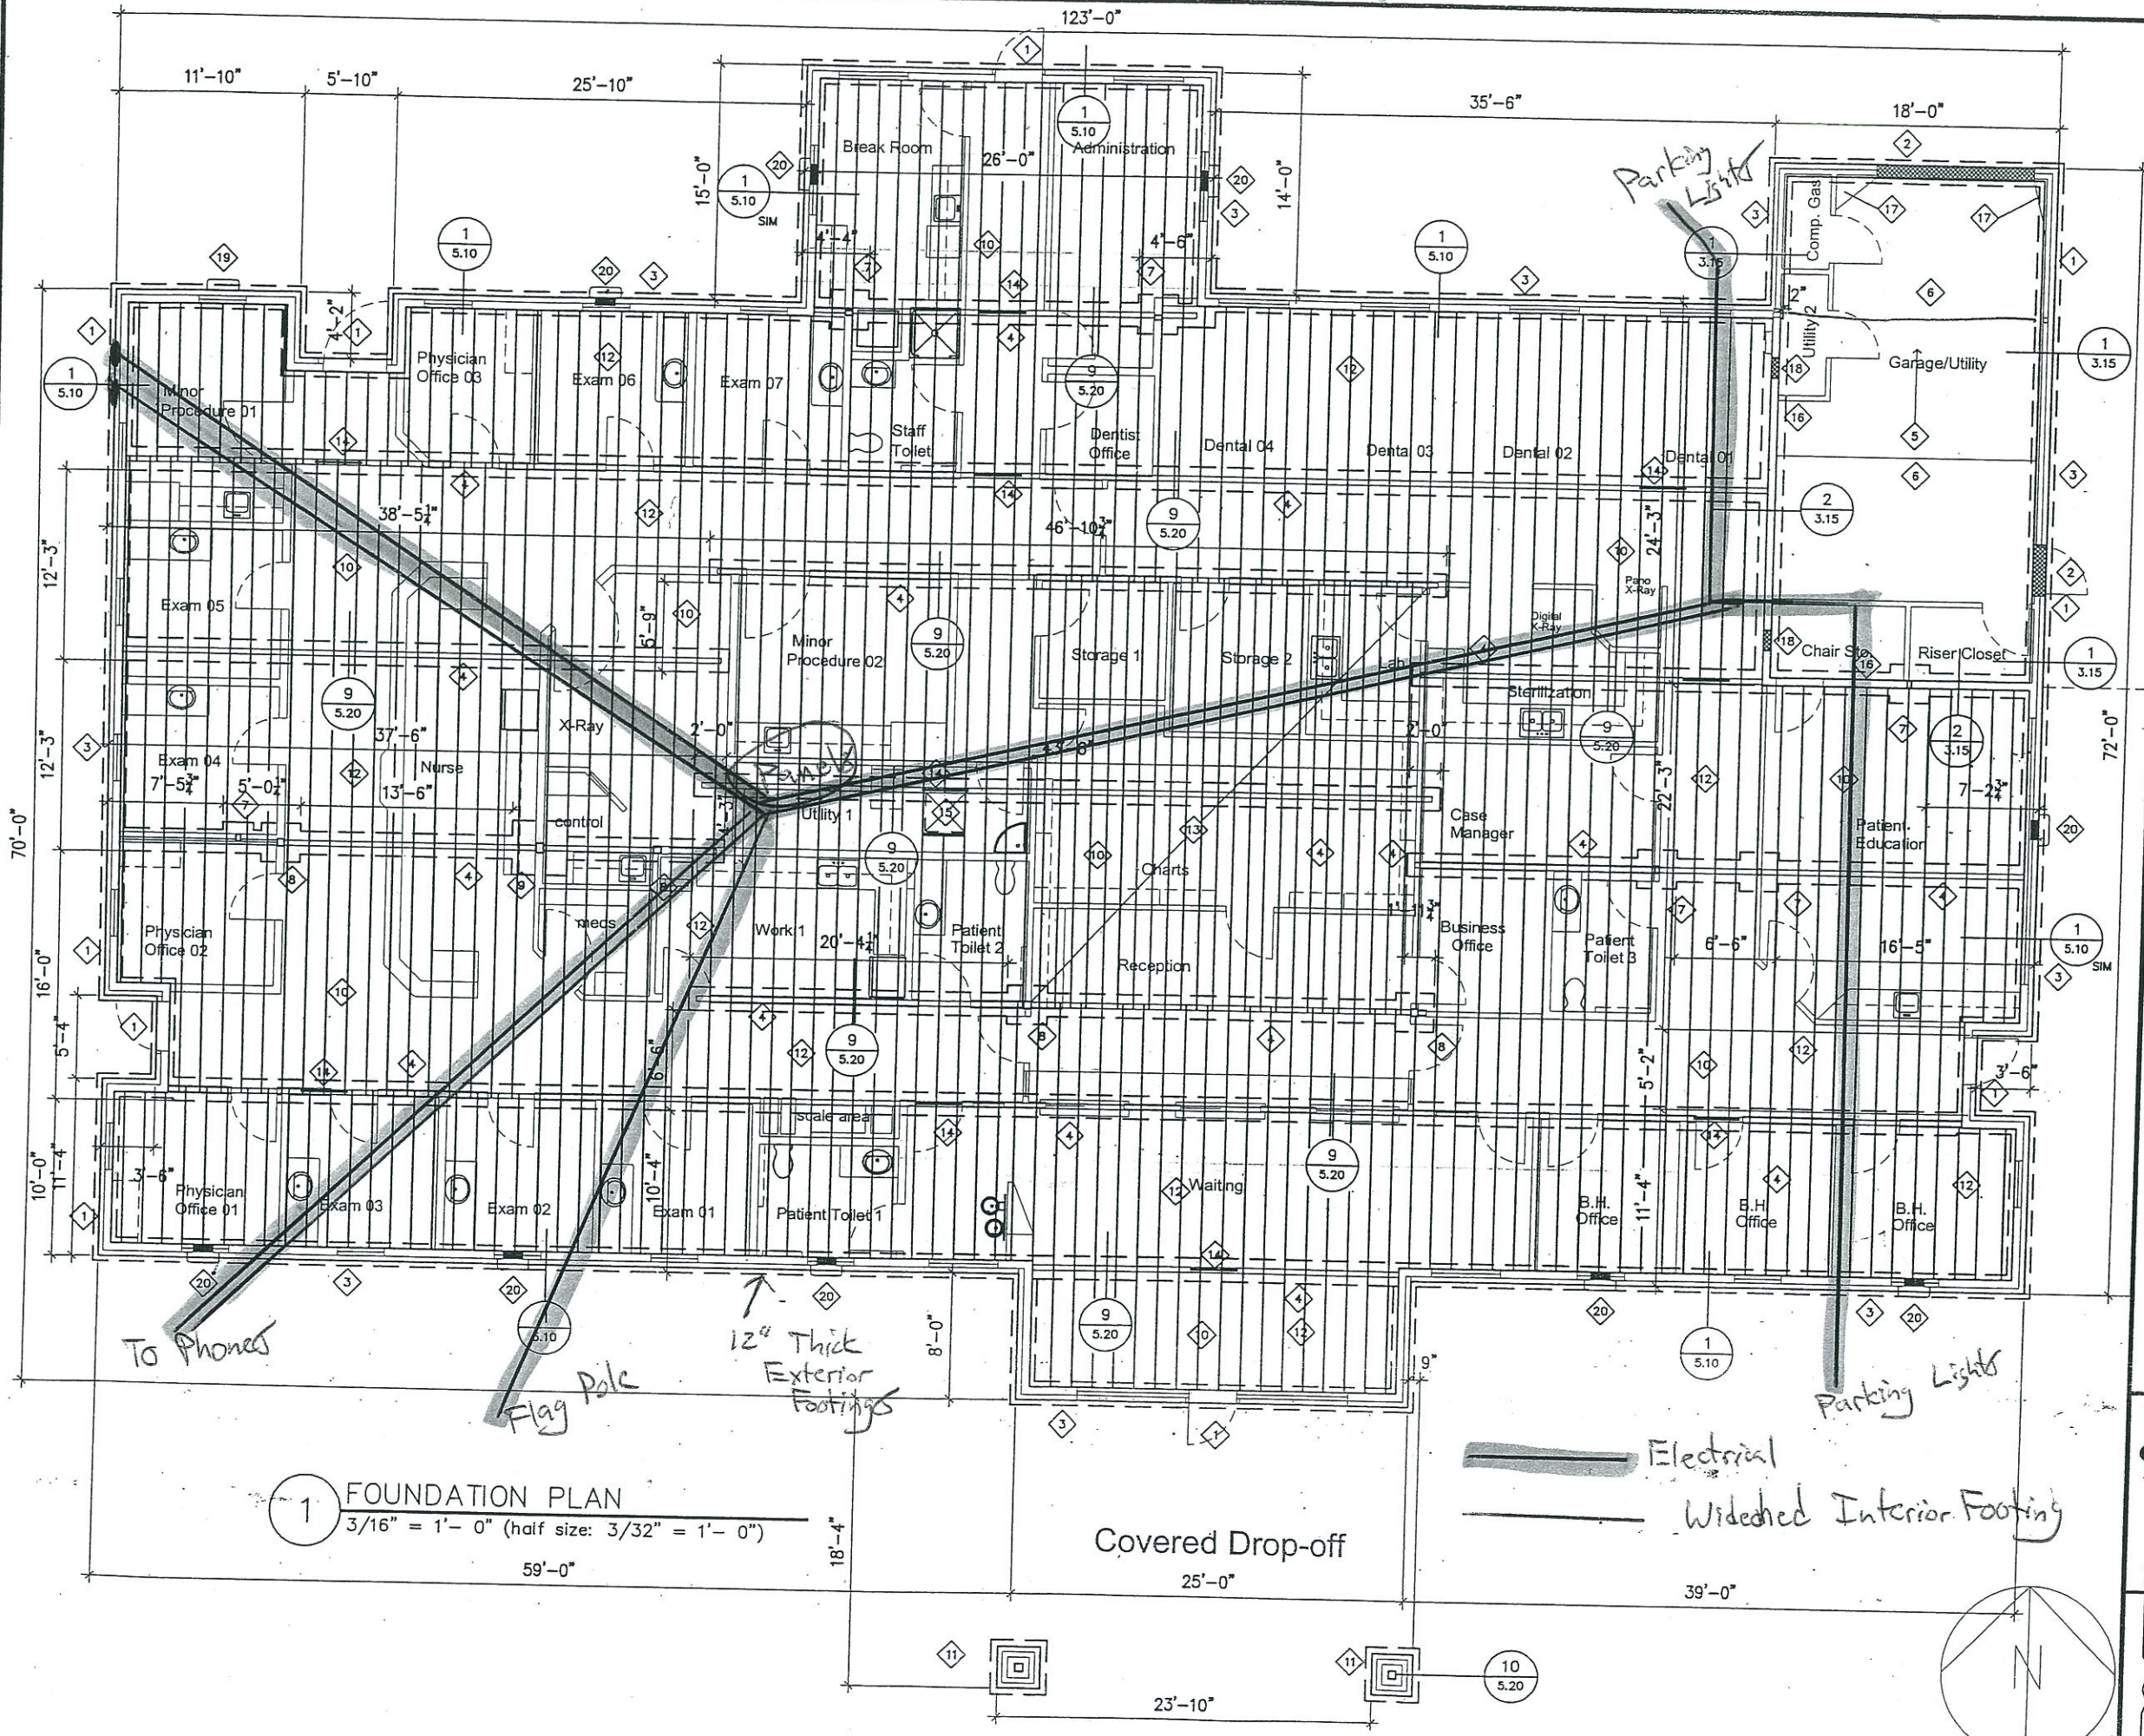

**NUMBERED NOTES**

01. Tie Site Concrete to foundation wall w/ #4 @ 6" O.c. w/ 6" min. embed
02. Depress top of conc. v.foundation wall 4" to pour slab over at cross hatch
03. Typical Exterior Foundation:  
1'-6" x 8" Footing w/ (2) #4 Cont. w/ 10" stem wall w/ #4 vert. alt. hooks at 2'-8" o.c. w/ #4 Horiz @ 1'-0" o.c.
04. Typical Pony Wall Footing:  
1'-4" x 8" W/ (2) #4 Continuous.  
Pony Wall Framing: 2x6 @ 1'-4" o.c.
05. Slope Concrete Slab to Overhead Door
06. 4" thick Conc. Slab over 4" gravel over 95% compacted sub-base
07. 2'-0" Sq. x 8" Pad w/ (3) #4 E.W.
08. 2'-6" Sq. x 8" Pad w/ (3) #4 E.W.
09. 3'-6" Sq. x 12" Pad w/ (4) #4 E.W.
10. Floor Sheathing: 1 1/8" T&G Sturdi-Floor Glue and Nail
11. 2'-8" Sq. Pier w/ (4) #4 Vert Hooks w/ #3 Ties @ 8" o.c. w/ 3'-6" Sq. x 8" Pad w/ (4) #4 E.W.
12. Floor Framing Members: 11 7/8" TJI Pro 250. Typical Spacing: 1'-4" except where noted at Chart Room Area.
13. Floor Joist Members 1'-0" o.c. this area
14. (2) 2x6 header at 36" wide opening through pony wall at crawl space
15. 22" x 30" min. crawl space access with recessed ring handel. Trim with Floor Finish for this room and rubber transition strip at access panel.
16. Interior Garage Foundation:  
1'-4" x 8" Footing w/ (2) #4 Cont. w/ 6" stem wall w/ #4 vert. alt. hooks at 2'-8" o.c. w/ #4 Horiz @ 1'-0" o.c.
17. Cricket Conc. Slab slightly to promote drainage to the exterior.
18. 4" deep x 16" long x width of fnd. wall block out for HVAC/Mech
19. Ventwell for EF5 - see mechanical. w/ washed rock base down for fnd. drain
20. Ventwell and 8"x16" Witten Automatic Foundation Vent. Pack Foundation Wall full of rigid insulation.

**General Note:**  
Dim. to Face of fnd wall or Face of footing or Face of pony wall studs


**1 FOUNDATION PLAN**  
3/16" = 1'-0" (half size: 3/32" = 1'-0")

**Electrical**  
**Widened Interior Footing**



**Medical Design Group**  
Architecture for Health Care  
2716 WESTLAND PLACE  
BOISE, IDAHO 83704-5863  
BOISEARCHITECT@AOL.COM  
Fax (208) 378-1405  
Phone (208) 378-0817


© COPYRIGHT: MEDICAL DESIGN GROUP

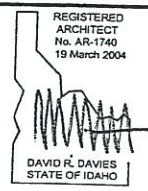

**FOUNDATION PLAN**  
Desert Sage Health Center  
2280 American Legion Blvd.  
Mountain Home, Idaho  
**SHEET 3.10**  
Mar 2004

Z:\TEMPLATE\mdg.dwg March 2003

**HOLE CHARTS - ROUND, SQUARE AND RECTANGULAR HOLES**

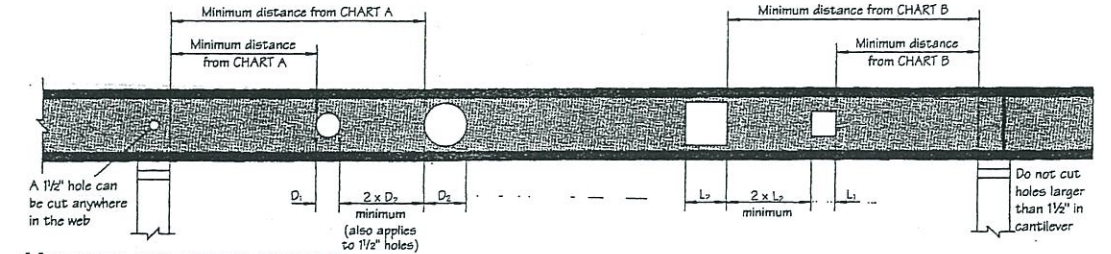

**HOW TO USE THESE CHARTS**

1. Determine the hole shape (round, square or rectangular) and select the appropriate CHART - A or B.
2. Under HOLE SIZE, locate the column which meets or exceeds the size of hole you require.
3. Use the first two columns to identify the TJI® joist series and depth being used in your floor or roof system.
4. Scan right across the row until you intersect the column which contains the hole size you selected. The value shown is the required minimum distance from edge of the hole to the inside face of the nearest support.

**CHART A - ROUND HOLES**  
MINIMUM DISTANCE FROM INSIDE FACE OF ANY SUPPORT TO NEAREST EDGE OF HOLE

JOIST DEPTH	TJI® JOIST SERIES	ROUND HOLE SIZE												
		2'-0"	2'-6"	3'-0"	3'-6"	4'-0"	4'-6"	5'-0"	5'-6"	6'-0"	6'-6"	7'-0"	7'-6"	
2x4	2075	2'-0"	2'-6"	3'-0"	3'-6"	4'-0"	4'-6"	5'-0"	5'-6"	6'-0"	6'-6"	7'-0"	7'-6"	
	1575	1'-6"	2'-0"	2'-6"	3'-0"	3'-6"	4'-0"	4'-6"	5'-0"	5'-6"	6'-0"	6'-6"	7'-0"	
2x6	2075	1'-0"	1'-6"	2'-0"	2'-6"	3'-0"	3'-6"	4'-0"	4'-6"	5'-0"	5'-6"	6'-0"	6'-6"	7'-0"
	1575	1'-0"	1'-6"	1'-6"	2'-0"	2'-6"	3'-0"	3'-6"	4'-0"	4'-6"	5'-0"	5'-6"	6'-0"	6'-6"
	250	1'-0"	1'-6"	2'-0"	2'-6"	3'-0"	3'-6"	4'-0"	4'-6"	5'-0"	5'-6"	6'-0"	6'-6"	7'-0"
	250	1'-0"	1'-6"	2'-0"	2'-6"	3'-0"	3'-6"	4'-0"	4'-6"	5'-0"	5'-6"	6'-0"	6'-6"	7'-0"
	350	1'-6"	2'-0"	2'-6"	3'-0"	3'-6"	4'-0"	4'-6"	5'-0"	5'-6"	6'-0"	6'-6"	7'-0"	7'-6"
2x8	2075	1'-0"	1'-6"	1'-6"	2'-0"	2'-6"	3'-0"	3'-6"	4'-0"	4'-6"	5'-0"	5'-6"	6'-0"	6'-6"
	1575	1'-0"	1'-6"	1'-6"	2'-0"	2'-6"	3'-0"	3'-6"	4'-0"	4'-6"	5'-0"	5'-6"	6'-0"	6'-6"
	250	1'-0"	1'-6"	1'-6"	2'-0"	2'-6"	3'-0"	3'-6"	4'-0"	4'-6"	5'-0"	5'-6"	6'-0"	6'-6"
	250	1'-0"	1'-6"	1'-6"	2'-0"	2'-6"	3'-0"	3'-6"	4'-0"	4'-6"	5'-0"	5'-6"	6'-0"	6'-6"
	350	1'-6"	2'-0"	2'-6"	3'-0"	3'-6"	4'-0"	4'-6"	5'-0"	5'-6"	6'-0"	6'-6"	7'-0"	7'-6"
2x10	2075	1'-0"	1'-6"	1'-6"	2'-0"	2'-6"	3'-0"	3'-6"	4'-0"	4'-6"	5'-0"	5'-6"	6'-0"	6'-6"
	1575	1'-0"	1'-6"	1'-6"	2'-0"	2'-6"	3'-0"	3'-6"	4'-0"	4'-6"	5'-0"	5'-6"	6'-0"	6'-6"
	250	1'-0"	1'-6"	1'-6"	2'-0"	2'-6"	3'-0"	3'-6"	4'-0"	4'-6"	5'-0"	5'-6"	6'-0"	6'-6"
	250	1'-0"	1'-6"	1'-6"	2'-0"	2'-6"	3'-0"	3'-6"	4'-0"	4'-6"	5'-0"	5'-6"	6'-0"	6'-6"
	350	1'-6"	2'-0"	2'-6"	3'-0"	3'-6"	4'-0"	4'-6"	5'-0"	5'-6"	6'-0"	6'-6"	7'-0"	7'-6"

**CHART B - SQUARE OR RECTANGULAR HOLES**  
MINIMUM DISTANCE FROM INSIDE FACE OF ANY SUPPORT TO NEAREST EDGE OF HOLE

JOIST DEPTH	TJI® JOIST SERIES	SQUARE OR RECTANGULAR HOLE SIZE												
		2'-0"	3'-0"	4'-0"	4'-6"	5'-0"	5'-6"	6'-0"	6'-6"	7'-0"	7'-6"	8'-0"	8'-6"	
2x4	2075	2'-0"	3'-0"	4'-0"	4'-6"	5'-0"	5'-6"	6'-0"	6'-6"	7'-0"	7'-6"			
	1575	1'-6"	3'-0"	4'-0"	4'-6"	5'-0"	5'-6"	6'-0"	6'-6"	7'-0"	7'-6"			
2x6	2075	1'-6"	2'-6"	3'-6"	4'-6"	5'-6"	6'-6"	7'-6"	8'-0"	8'-6"	9'-0"			
	1575	1'-0"	2'-0"	3'-0"	4'-6"	5'-6"	6'-6"	7'-6"	8'-0"	8'-6"	9'-0"			
	250	1'-6"	2'-6"	3'-6"	4'-6"	5'-6"	6'-6"	7'-6"	8'-0"	8'-6"	9'-0"	9'-6"		
	250	1'-6"	2'-6"	3'-6"	4'-6"	5'-6"	6'-6"	7'-6"	8'-0"	8'-6"	9'-0"	9'-6"		
	350	3'-6"	4'-6"	6'-0"	7'-6"	9'-0"	9'-6"	9'-6"	10'-0"	10'-6"	10'-6"			
2x8	2075	1'-0"	2'-0"	3'-0"	4'-0"	5'-6"	5'-6"	7'-6"	9'-0"	9'-6"	10'-0"	10'-6"	11'-6"	
	1575	1'-0"	1'-0"	2'-0"	4'-0"	6'-0"	6'-6"	8'-0"	10'-0"	10'-6"	10'-6"	11'-0"	12'-0"	
	250	1'-0"	1'-0"	3'-0"	5'-0"	6'-6"	7'-0"	9'-0"	10'-6"	10'-6"	11'-0"	11'-6"	12'-0"	
	250	2'-6"	4'-0"	5'-6"	7'-0"	8'-6"	9'-0"	10'-0"	11'-6"	11'-6"	12'-0"	12'-6"	13'-0"	
	350	1'-0"	1'-0"	1'-0"	1'-0"	2'-0"	3'-0"	4'-6"	6'-6"	8'-6"	8'-6"	9'-6"	10'-0"	11'-6"
2x10	2075	1'-0"	1'-0"	1'-0"	1'-6"	4'-0"	4'-6"	6'-0"	8'-0"	10'-0"	10'-0"	11'-0"	11'-6"	13'-0"
	250	1'-0"	1'-0"	2'-6"	4'-6"	6'-0"	8'-0"	8'-6"	9'-6"	11'-6"	13'-0"	13'-0"	14'-0"	15'-6"


Rectangular holes based on measurement of longest side.


**GENERAL NOTES**

- If more than one hole is cut into the web, the distance between the edges of the holes must be at least 2x the length of the largest hole.
- Holes may be located vertically anywhere within the web. Leave 1/8" of web minimum at top and bottom of hole.
- TJI® joists are manufactured with 1/2" perforated knockouts in the web at approximately 12" on-center along the length of the joist.
- Distances in the charts above are based on uniformly loaded joists using the maximum loads shown for any of the tables listed within this brochure. For other load conditions or hole configurations not included in these charts, refer to our TJI-Beam™ software or contact your Trus Joist MacMillan representative.
- For simple span (5 foot minimum) uniformly loaded joists meeting the requirements of this brochure, one maximum size round hole may be located at the center of the joist span provided no other holes occur in the joist. **DO NOT** cut into joist flanges when cutting the web.



FULL WEB-DEPTH RECTANGULAR HOLES ARE ALSO POSSIBLE. CONTACT YOUR TRUS JOIST-MACMILLAN REPRESENTATIVE FOR ASSISTANCE.

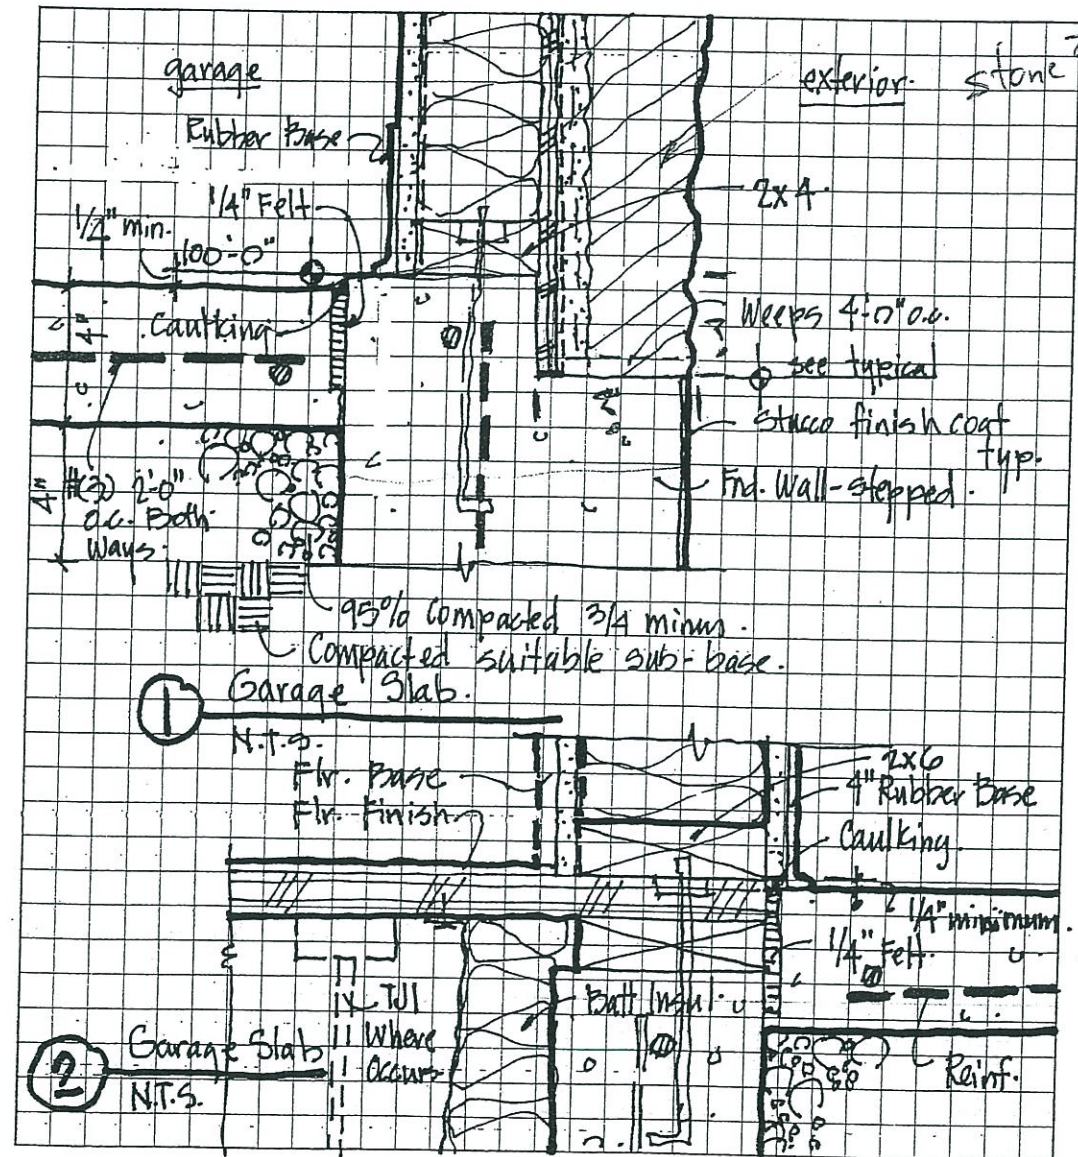




**Medical Design Group**  
Architecture for Health Care  
2716 WESTLAND PLACE  
BOISE, IDAHO 83704-5863  
BOISEARCHITECT@AOL.COM  
Fax (208) 378-1405  
Phone (208) 378-0817

© COPYRIGHT: MEDICAL DESIGN GROUP

REGISTERED ARCHITECT  
No. AR-1740  
19 March 2004

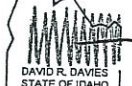


DAVID R. DAVIES  
STATE OF IDAHO

**FOUNDATION DETAILS**

Desert Sage Health Center  
2280 American Legion Blvd.  
Mountain Home, Idaho

SHEET  
**3.15**

Mar 2004 ds315.dwg 03/19/04 16:04

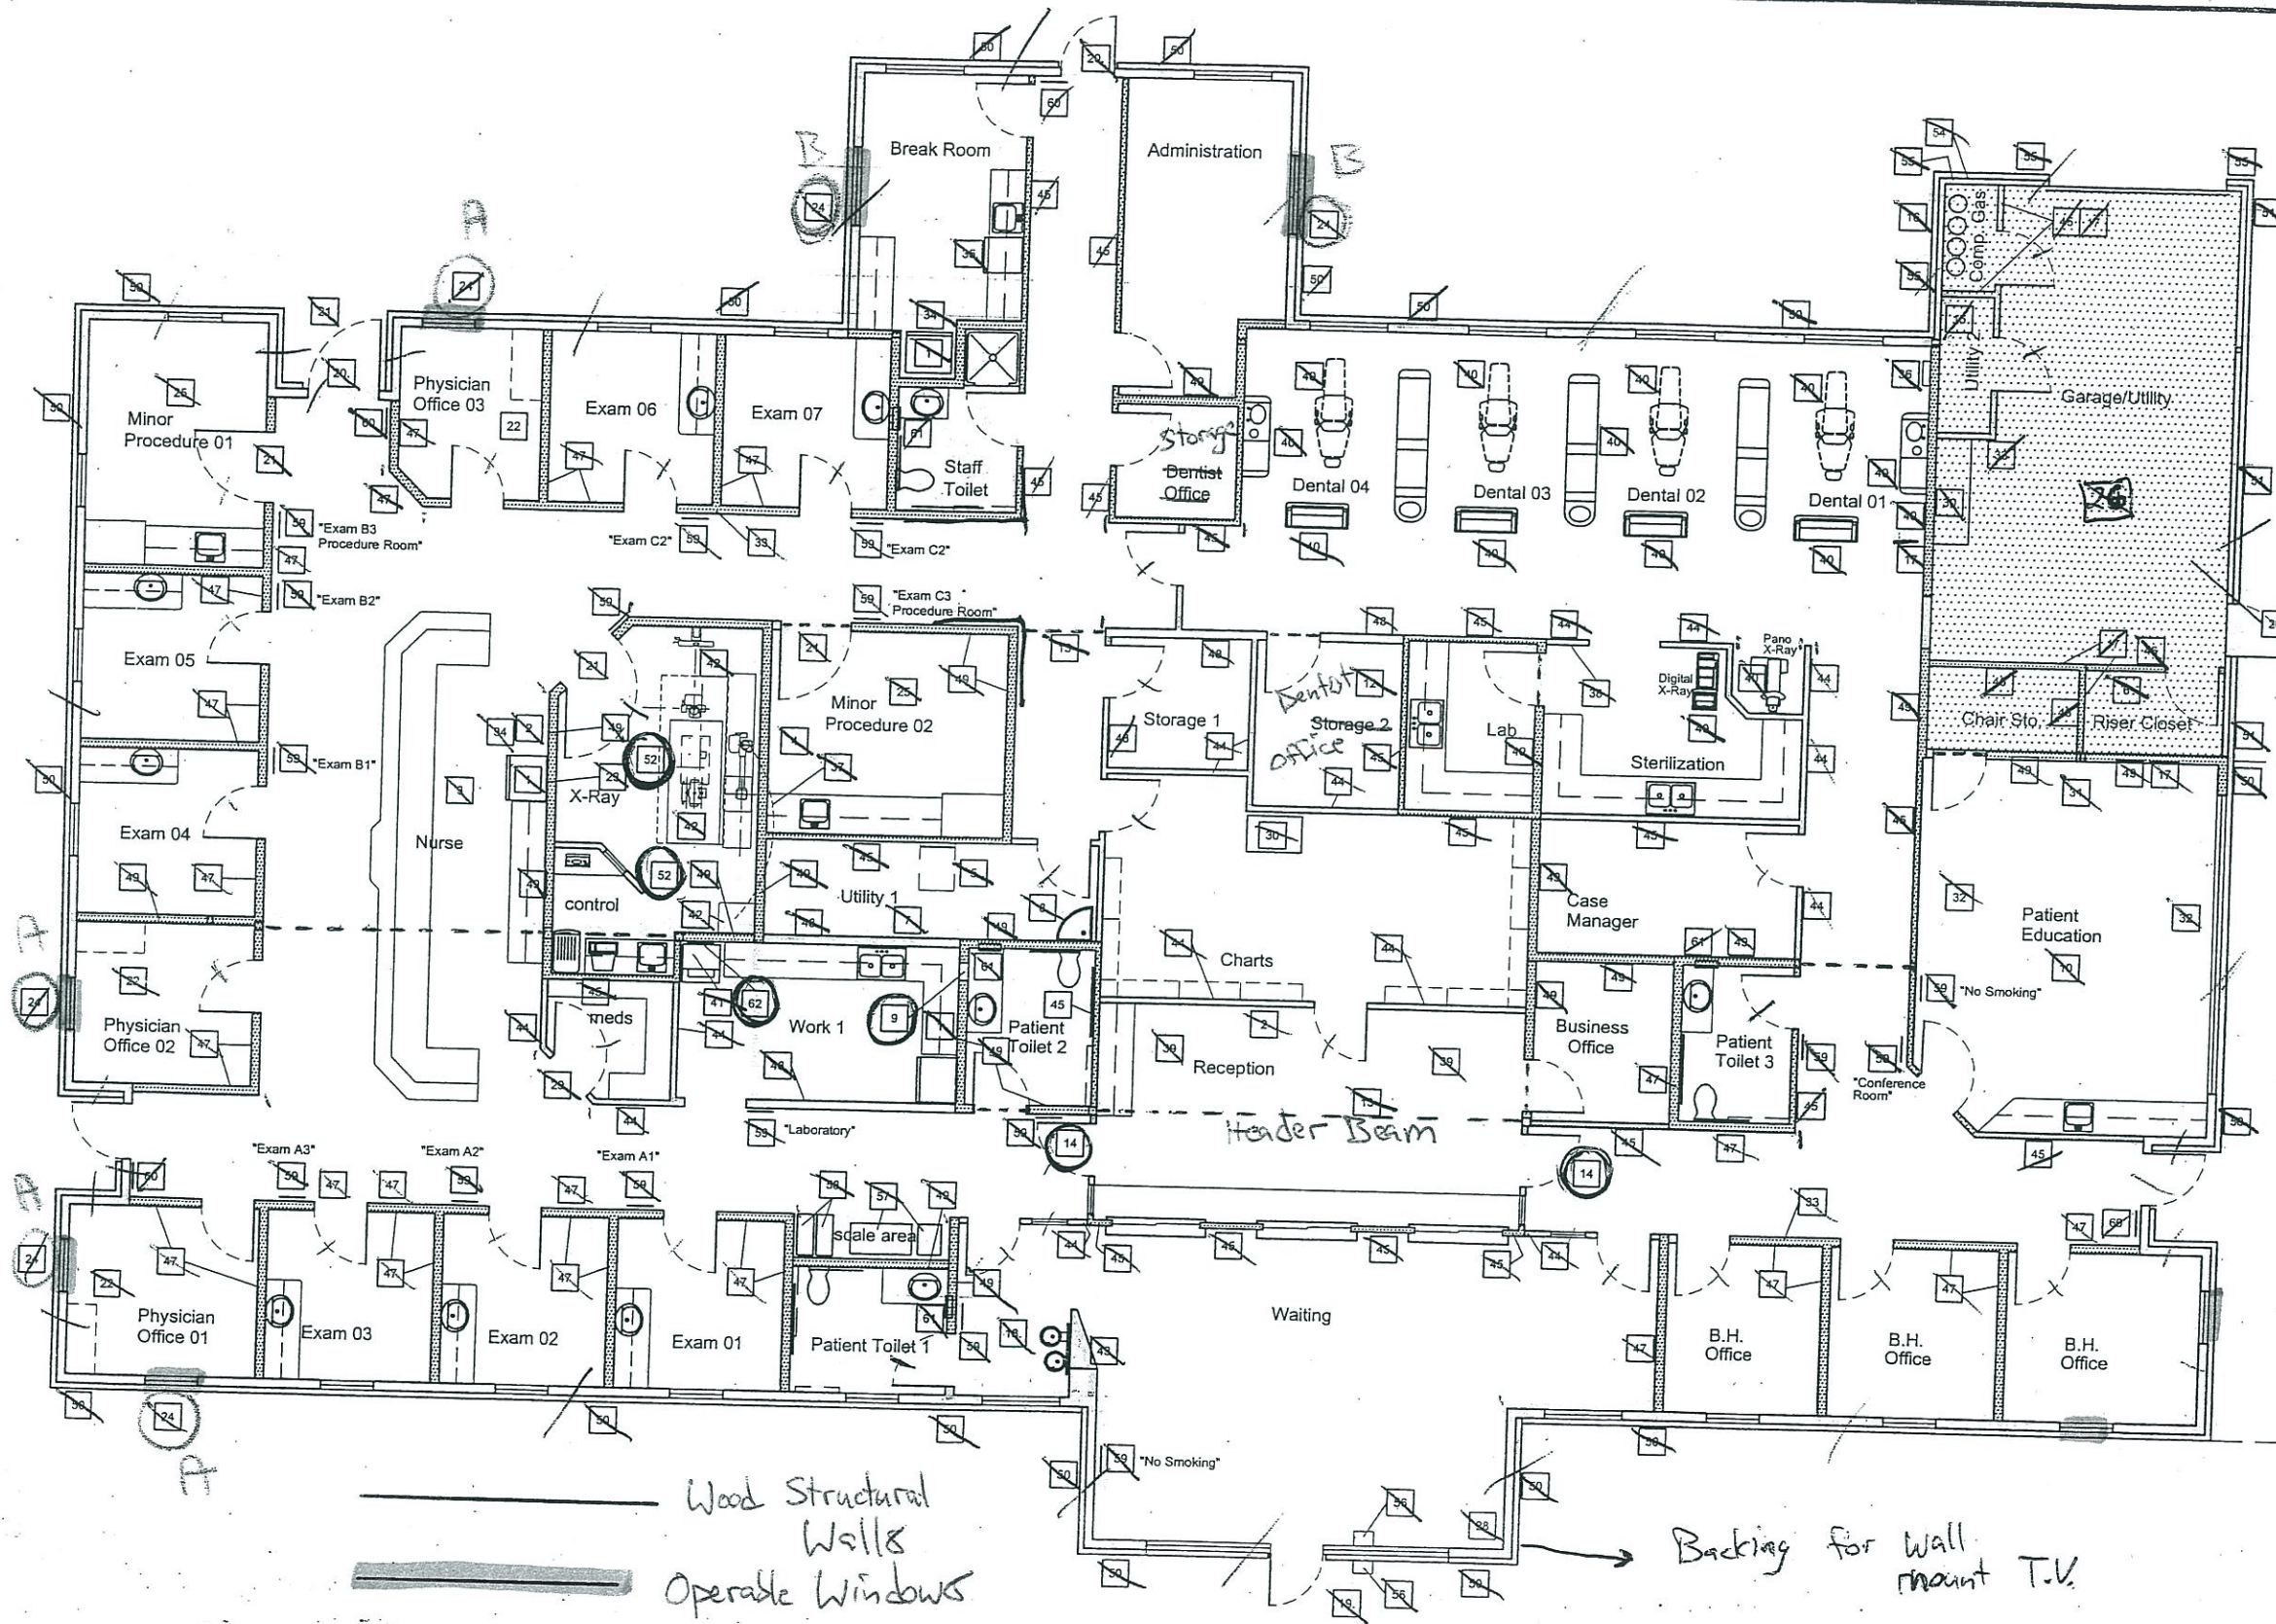

- NUMBERED NOTES**
- 01. Owner Furnished Owner Installed (OFOI) Refrigerator
  - 02. Space for OFOI Photo Copy Machine
  - 03. Skylight shown dashed above
  - 04. Extend Medical Vacuum to this room
  - 05. Ladder and Roof Hatch
  - 06. Area for Fire Riser
  - 07. Area for electrical and Phone Panels
  - 08. Floor Mop Sink
  - 09. Specimen Pass Through → GC
  - 10. Ceiling Mounted Projector - OFOI
  - 11. Bite Wing and Panoramic x-ray
  - 12. Future Dental Operator
  - 13. Roof Well Above shown dashed
  - 14. Bottom Half of Dutch Door with Shelf
  - 15. Vacuum and Air Compressor
  - 16. Nitrous and Oxygen Tanks - OFOI
  - 17. One Hour Fire Rated Wall
  - 18. Dual Drinking Fountain
  - 19. Push Button Assisted Entry
  - 20. Card Reader Entrance System
  - 21. 3'-6" Wide Doorway
  - 22. Future Exam Room
  - 23. Natural Gas Connection to Refrigerator
  - 24. Operable Windows
  - 25. OFOI Overhead Ceiling Mounted Exam Light elect.
  - 26. Hatched area is to be 4" Slab on Grade.
  - 27. - not used -
  - 28. TV Area for Kids
  - 29. Keyless lock
  - 30. OFOI casework
  - 31. Electric roll down projection screen not used
  - 32. Perimeter drop soffit with dimmable lights
  - 33. Acoustical Insulation
  - 34. Ice Maker with Refrigerator connection see mechanical
  - 35. Dishwasher w/ Microwave Oven above OFOI
  - 36. Nitrous/Oxygen Shut-off
  - 37. Route cable to x-ray head through ceiling
  - 38. Vacuum/Compressor Switches
  - 39. Skylight - Bid Alternate
  - 40. Dental Equipment
  - 41. OFOI Stacking Washer/Dryer
  - 42. OFOI X-Ray Machine
  - 43. Wall Type S03.5A
  - 44. Wall Type S03.5B
  - 45. Wall Type S03.5C
  - 46. Wall Type S03.5G
  - 47. Wall Type S03.5K
  - 48. Wall Type S05.5A
  - 49. Wall Type S05.5C
  - 50. Wall Type W05.5A
  - 51. Wall Type W3.5A
  - 52. See Sheet 13.01 - 13.06 for lead shielding req's not used
  - 53. (2) vents - see mech.
  - 54. See wall type W03.5B
  - 55. Automatic Door Push Button
  - 56. OFOI scales
  - 57. Wheelchair storage area
  - 58. Interior Sign, Wall Mounted
  - 59. Fire Extinguisher and FE Cabinet, Semi-recessed
  - 60. Recessed Trash Receptacle
  - 61. 14" x 14" painted 3/4" Plywood Access Panel coord. with 3/M3.1

Future Expansion


**1 FLOOR PLAN**  
 3/16" = 1'-0" (half size: 3/32" = 1'-0")

Wood Structural Walls  
 Operable Windows

Backing for Wall mount T.V.

Structural Wall  
 Non Structural Wall

Covered Drop-off

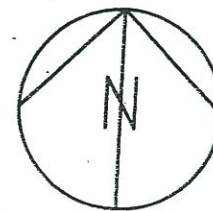

**Medical Design Group**  
 Architecture for Health Care

2716 WESTLAND PLACE  
 BOISE, IDAHO 83704-5863

BOISEARCHITECT@AOL.COM  
 Fax (208) 378-1405  
 Phone (208) 378-0817

© COPYRIGHT: MEDICAL DESIGN GROUP

REGISTERED ARCHITECT  
 No. AR-1740  
 19 March 2004


**FLOOR PLAN**

Desert Sage Health Center  
 2280 American Legion Blvd.  
 Mountain Home, Idaho

SHEET 3.30

Mar 2004 ds330.dwg 03/19/04 16:59

C:\ARCHITECT\Z\TEMPLATE\mdg.dwg March 2003

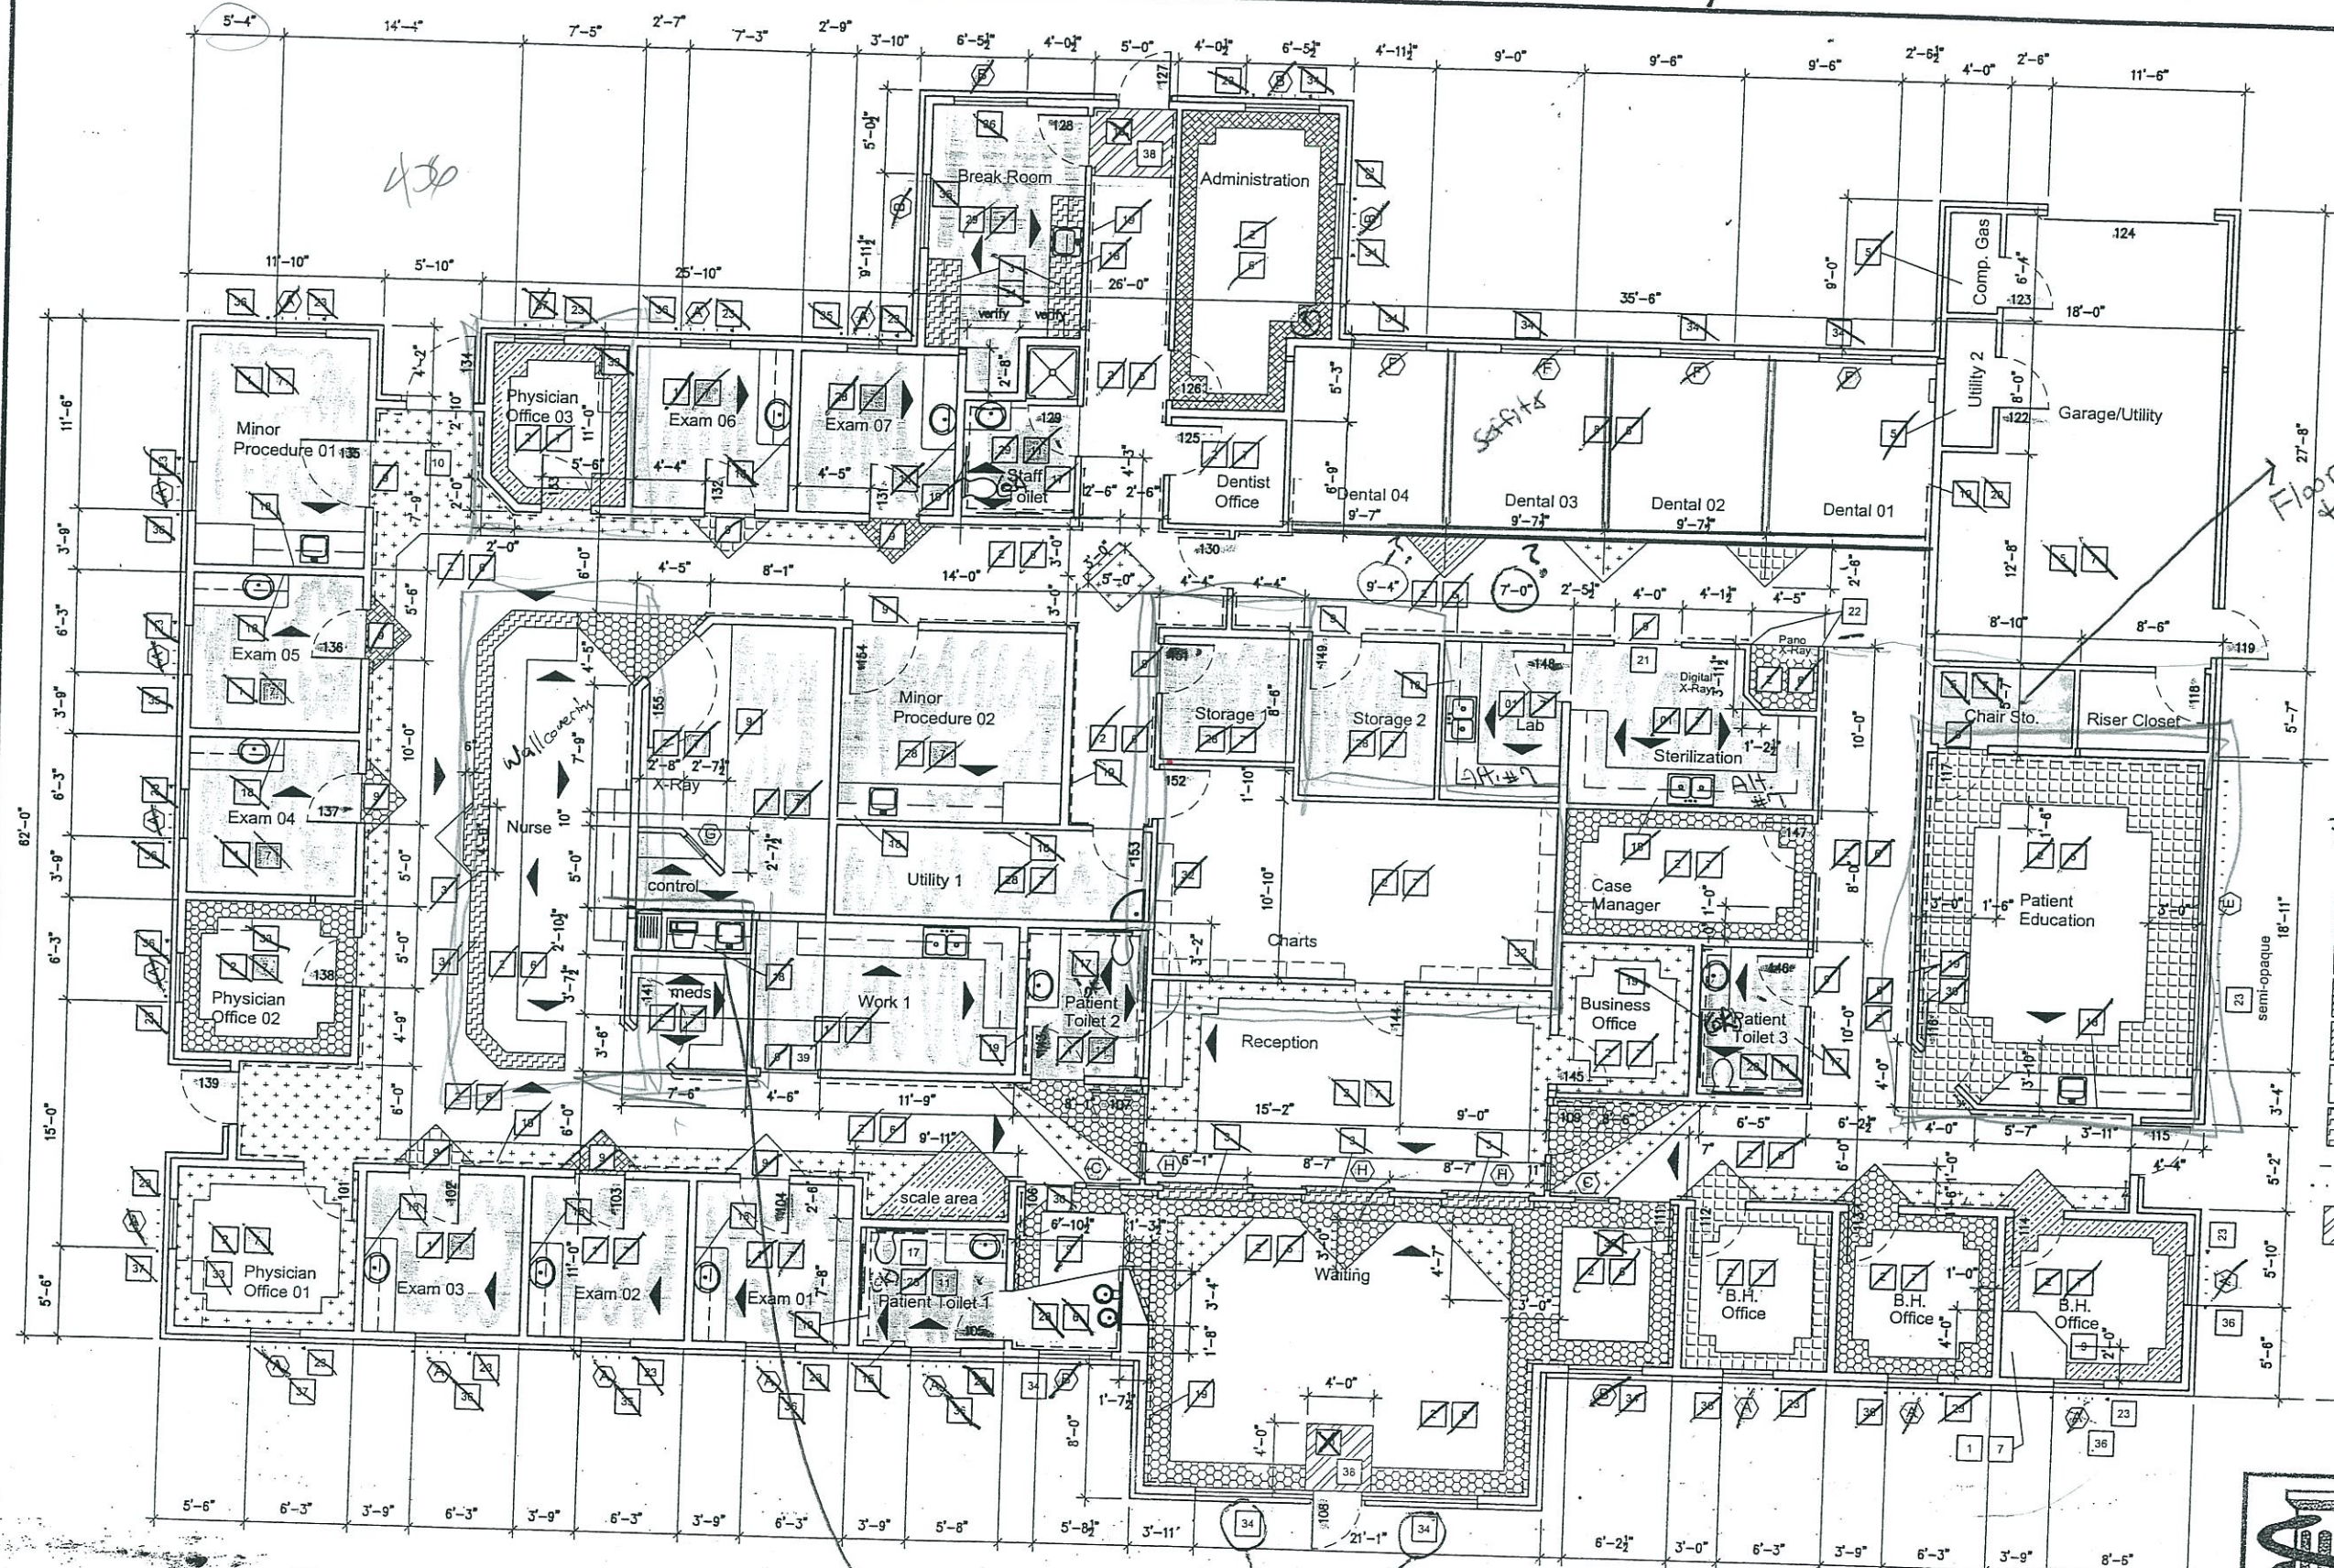

- NUMBERED NOTES**
- 01. Sheet Linoleum Type "A"
  - 02. Carpet color "A"
  - 03. Solid Surface Counter top → Venaro Gray
  - 04. Carpet Boarder color "C"
  - 05. Sealed concrete with 4" Rubber Base
  - 06. 5 1/2" High Light Stained Hardwood Base (BM 1518)
  - 07. 4" High Rubber Floor Base
  - 08. Hardwood Flooring
  - 09. Rubber Transition Strip
  - 10. Walk-off Carpet
  - 11. 6" High Rubber Floor Base
  - 12. Future Dental Operator
  - 13. Roof Well Above shown dashed
  - 14. Bottom Half of Dutch Door with Shelf
  - 15. OFOI Changing Table
  - 16. Steel Ladder to Roof Hatch
  - 17. Toilet Accessories:  
(2) Grab Bars (36" and 42"), Toilet Paper Dispenser, Paper Towel Dispenser, Mirror
  - 18. Chair Rail - See Detail 6/5.21 (BM 1520)
  - 19. Terminate Chair Rail at Dental Casework
  - 20. Cased Opening - utilize Frame Type A/B
  - 21. Cased Opening sim to Frame Type A/B
  - 22. Bottom up window covering
  - 23. Carpet Boarder "A"
  - 24. Carpet Boarder "B"
  - 25. Carpet Boarder "C"
  - 26. Carpet Boarder "D"
  - 27. Carpet Boarder "E"
  - 28. Linoleum Type "B"
  - 29. Sheet Vinyl Type "A"
  - 30. Wall Stop Detail 7/5.21
  - 31. Solid Surface Backsplash
  - 32. OFOI Chart Files
  - 33. Future casework/plumbing
  - 34. Solid Surface - Venaro Gray
  - 35. Solid Surface - Malachite
  - 36. Solid Surface - Everest
  - 37. Solid Surface - Cobalt
  - 38. Walk-off Carpet - Bordeaux 60
  - 39. Cased Opening - utilize Frame Type A/B, 42" wide
18. Paper Towel Disp.



- Carpet Type "A", keynote 24
- Carpet Type "B", keynote 25
- Carpet Type "C", keynote 04
- Carpet Type "D", keynote 26
- Carpet Type "E", keynote 27
- Solid Surface Counter Top, keynote 3
- Chair Rail, keynote 19
- Interior Window Covering - see keynote 23
- Walk-off Carpet, keynote 38

**General Notes:**  
 Paint all Walls and Hard Ceilings  
 All Dimensions to Face of Masonry or Face of Studs

1 FLOOR PLAN  
 3/16" = 1'-0" (half size: 3/32" = 1'-0")

27' 8 1/2" → Hard Lid SOFFIT

3 Covered Drop-off

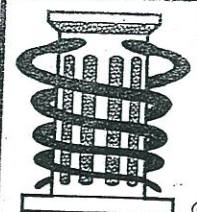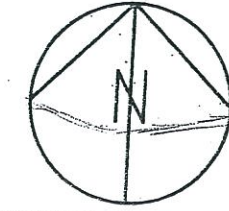

**Medical Design Group**  
 Architecture for Health Care  
 2716 WESTLAND PLACE  
 BOISE, IDAHO 83704-5863  
 BOISEARCHITECT@AOL.COM  
 Fax (208) 378-1405  
 Phone (208) 378-0817

© COPYRIGHT: MEDICAL DESIGN GROUP


REGISTERED ARCHITECT  
 No. AR-1740  
 22 March 2004  
 DAVID R. DAVIES  
 STATE OF IDAHO

**DIMENSION/FINISH PLAN**

Desert Sage Health Center SHEET  
 2280 American Legion Blvd. Mountain Home, Idaho 3.31

4: V:\LAWYER\VINAG.AWT March 2003




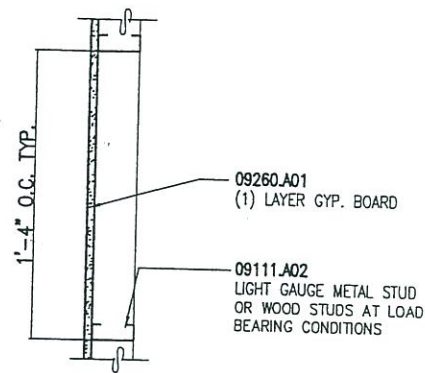

**S03.5A**

1 1/2" = 1'- 0" (half size: 3/4" = 1'- 0")


43

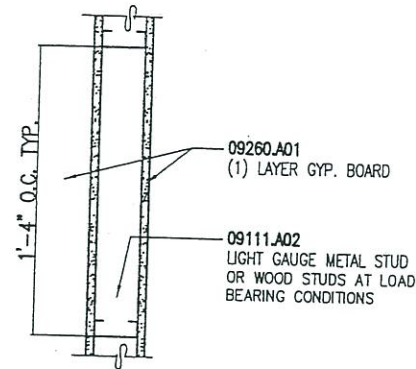

**S03.5B**

1 1/2" = 1'- 0" (half size: 3/4" = 1'- 0")


44

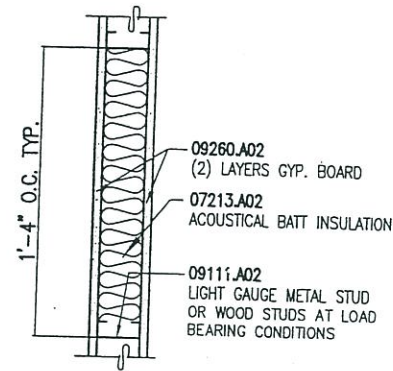

**S03.5C**

1 1/2" = 1'- 0" (half size: 3/4" = 1'- 0")


45

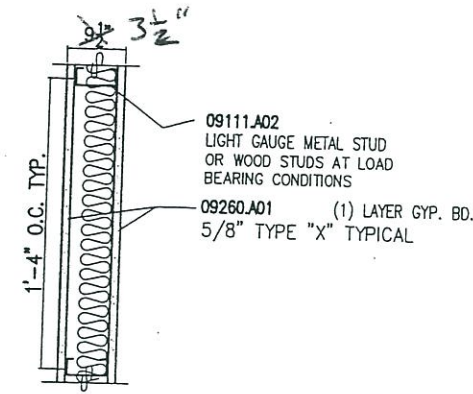

**S03.5G**

1 1/2" = 1'- 0" (half size: 3/4" = 1'- 0")

46

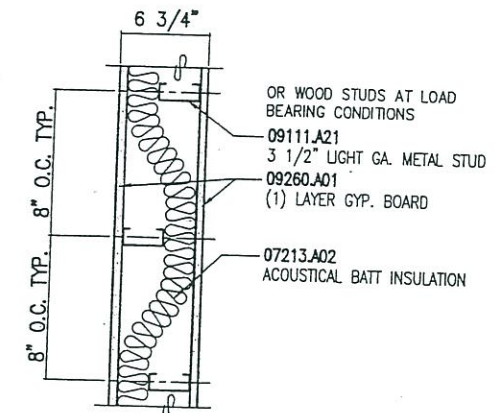


**S03.5K**

1 1/2" = 1'- 0" (half size: 3/4" = 1'- 0")

47


NOTE: BASE LAYER 5/8" TYPE X GYPSUM WALLBOARD APPLIED AT RIGHT ANGLES OR PARALLEL TO EACH SIDE OF STUDS 24" O.C. WITH 1" TYPE 5 DRYWALL SCREWS 8" O.C. TO VERTICAL EDGES AND 12" O.C. TO TOP AND BOTTOM RUNNERS AND INTERMEDIATE STUDS. STAGGER ALL VERTICAL AND HORIZONTAL JOINTS 24" O.C. EACH SIDE AND OPPOSITE SIDES.

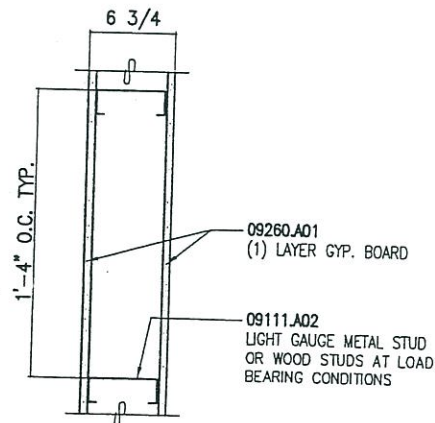

**S05.5A**

1 1/2" = 1'- 0" (half size: 3/4" = 1'- 0")



48

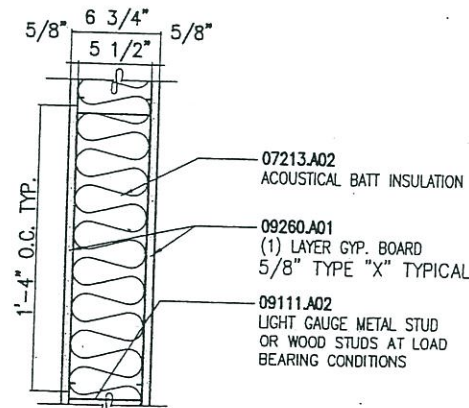

**S05.5C**

1 1/2" = 1'- 0" (half size: 3/4" = 1'- 0")



49

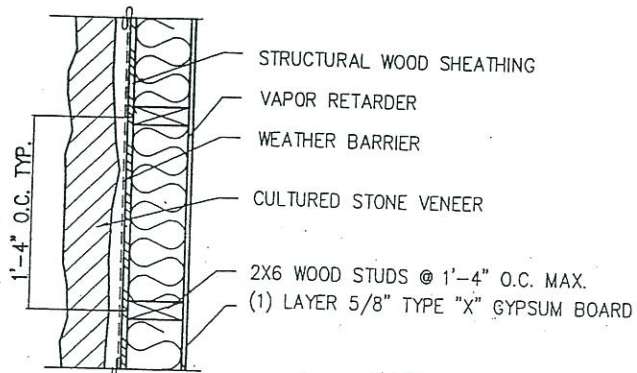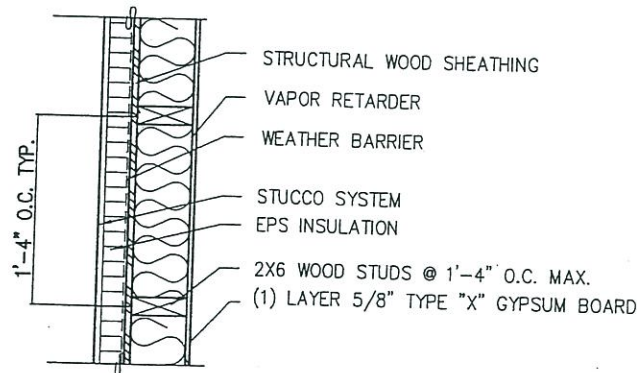

**W05.5A**

1 1/2" = 1'- 0" (half size: 3/4" = 1'- 0")

50

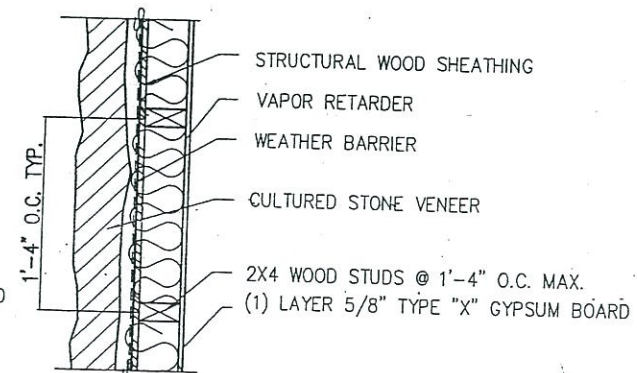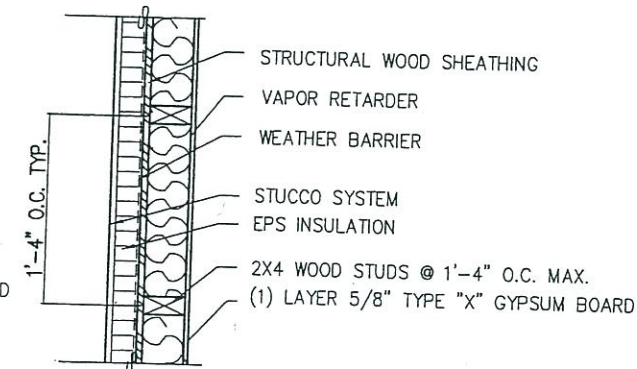

**W03.5A**

1 1/2" = 1'- 0" (half size: 3/4" = 1'- 0")

51

NOTE: BASE LAYER 5/8" TYPE X GYPSUM WALLBOARD APPLIED AT RIGHT ANGLES OR PARALLEL TO EACH SIDE OF STUDS 24" O.C. WITH 1" TYPE 5 DRYWALL SCREWS 8" O.C. TO VERTICAL EDGES AND 12" O.C. TO TOP AND BOTTOM RUNNERS AND INTERMEDIATE STUDS. STAGGER ALL VERTICAL AND HORIZONTAL JOINTS 24" O.C. EACH SIDE AND OPPOSITE SIDES.

Same as Wall Type W03.5A except replace the Structural Wood Sheathing with One Layer 5/8" Type "X" Gypsum Board

**W03.5B**

1 HR RATED ASSEMBLY  
SIM TO GA \* WF1200

55

GENERAL NOTE:  
AT LOAD BEARING WALLS, UTILIZE WOOD STUDS, TOP/BOTTOM PLATES AND HEADER MEMBERS PER STRUCTURAL PLANS/SPECS. SEE SHEET 3.50

50 SEE NUMBERED NOTES, SHEET 3.30

**Medical Design Group**  
Architecture for Health Care

2716 WESTLAND PLACE  
BOISE, IDAHO 83704-5863

BOISEARCHITECT@AOL.COM  
Fax (208) 378-1405  
Phone (208) 378-0817

© COPYRIGHT: MEDICAL DESIGN GROUP


REGISTERED ARCHITECT  
No. AR-1740  
19 March 2004

**WALL ASSEMBLIES**

Desert Sage Health Center  
2280 American Legion Blvd.  
Mountain Home, Idaho

SHEET  
3.35

Mar 2004 ds335.dwg 03/19/04 19:36

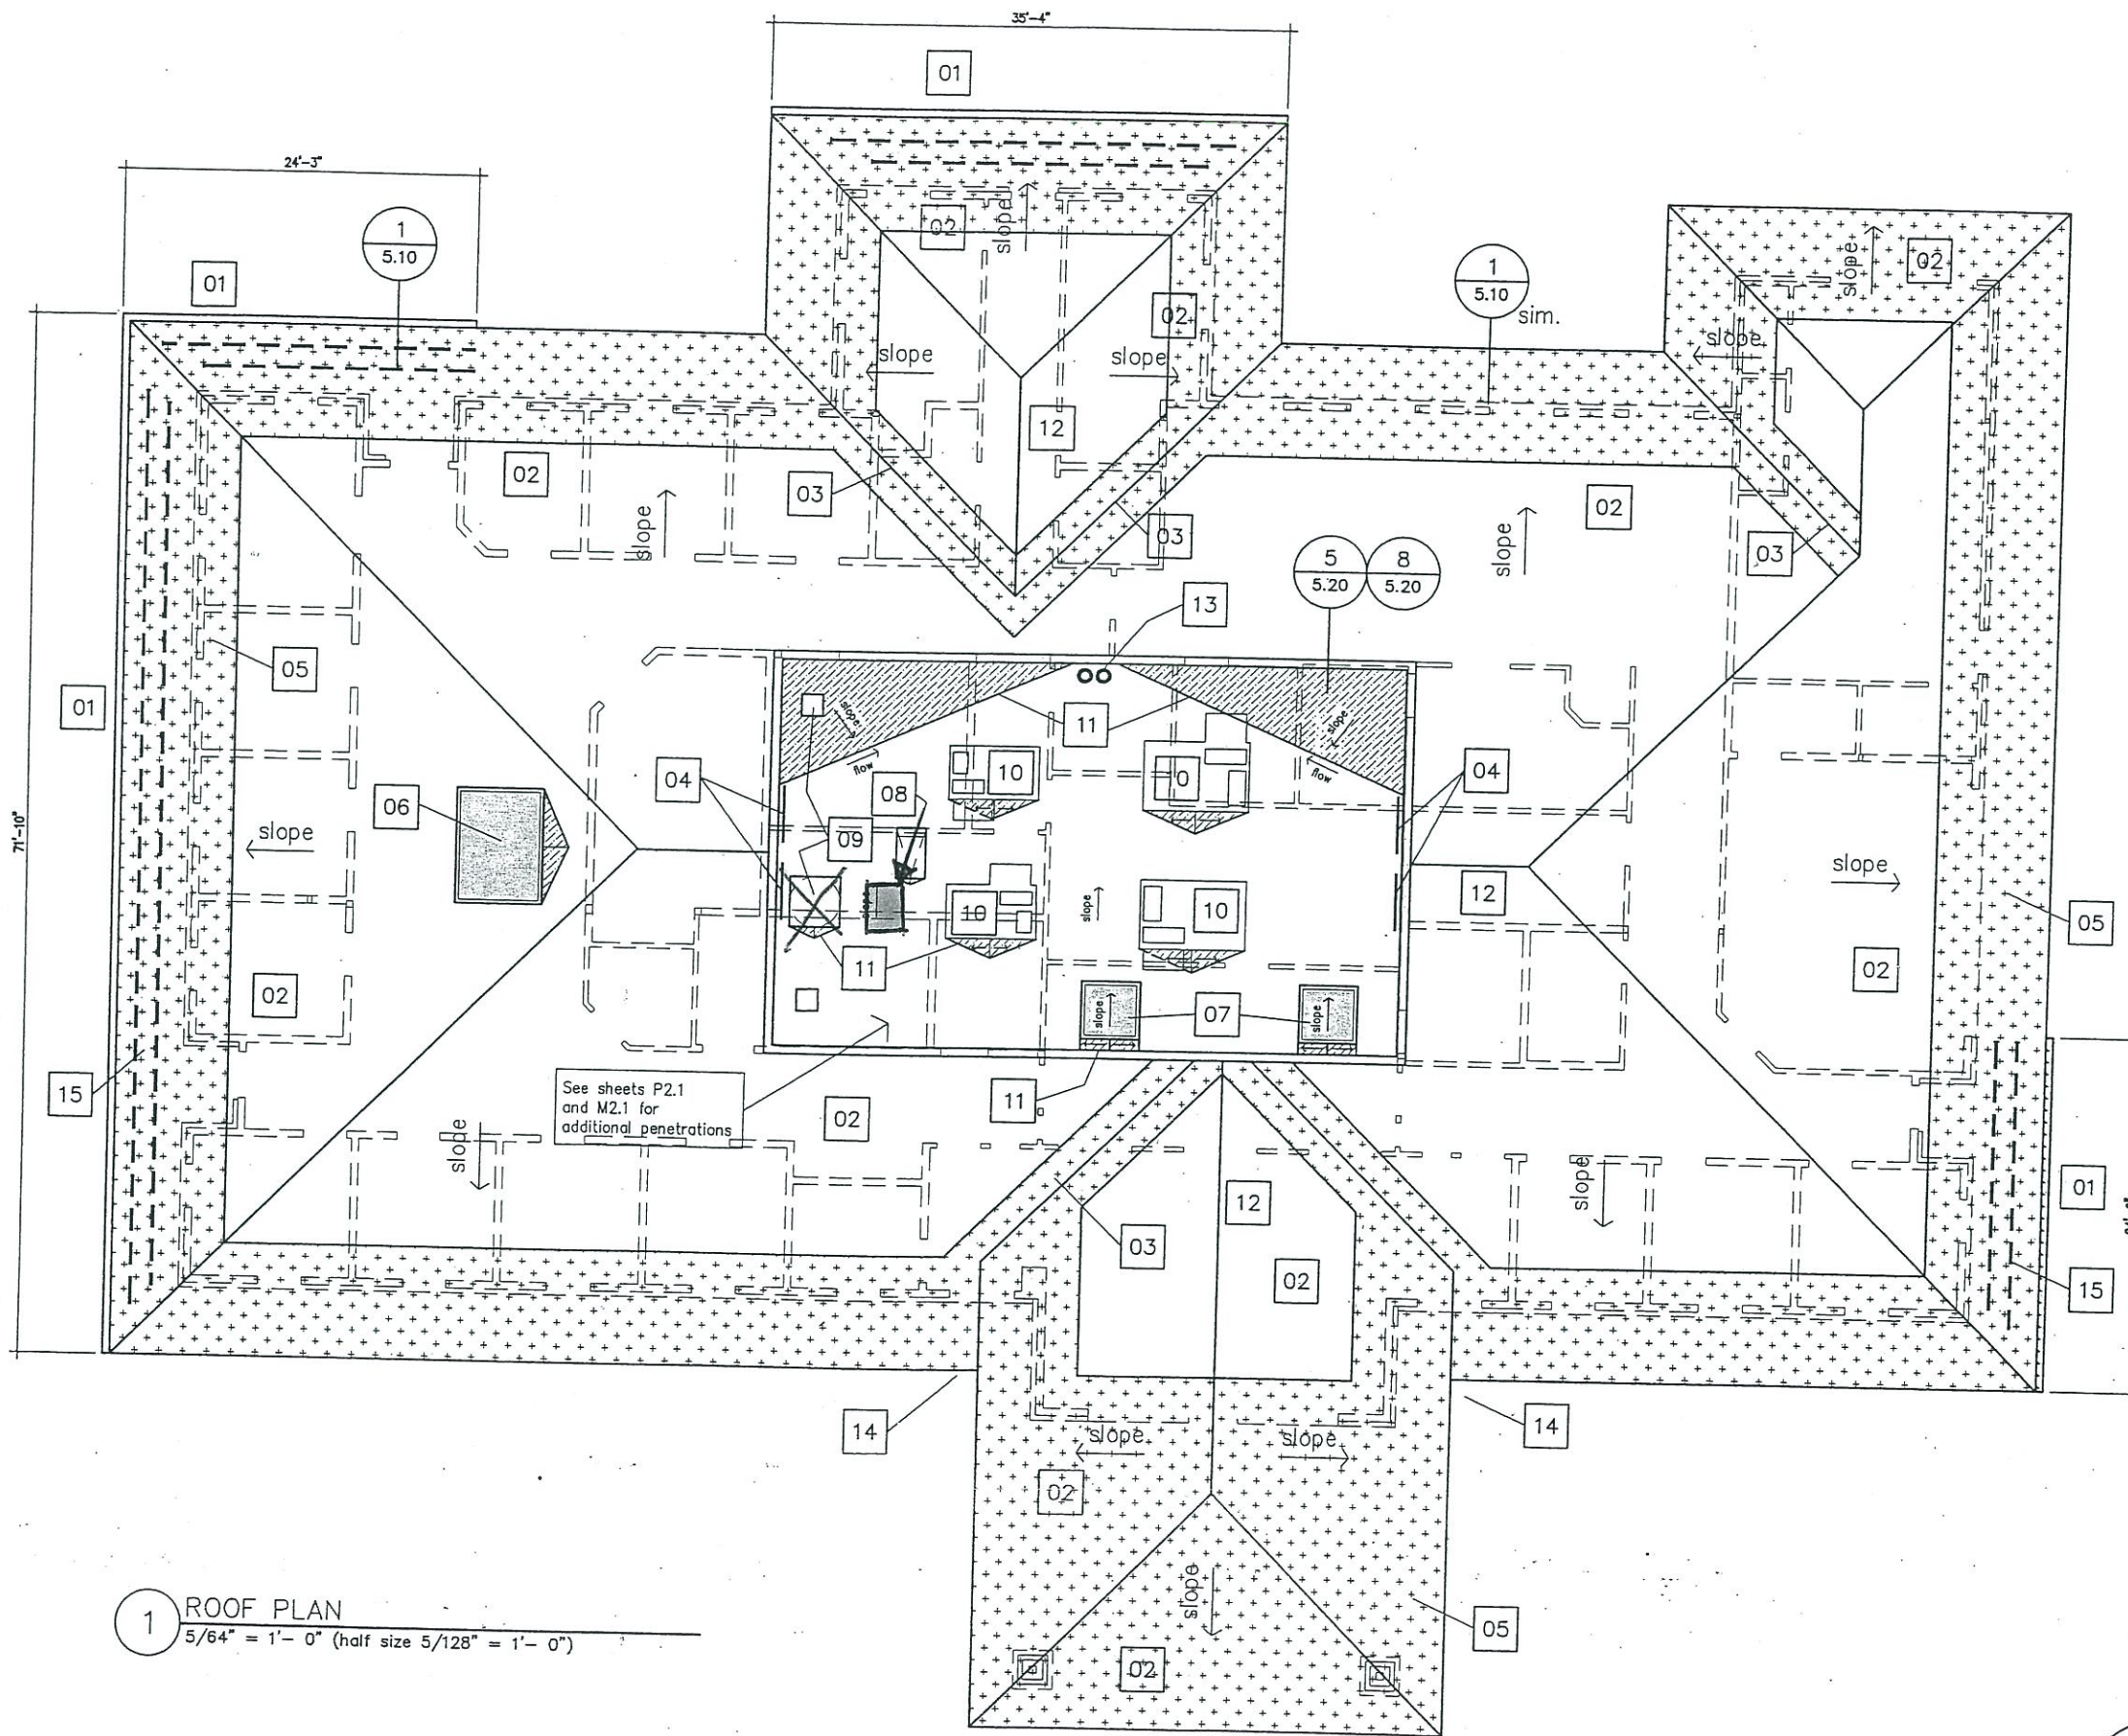


- NUMBERED NOTES**
01. Sheet Metal Gutter
  02. High Slope Roofing - See Bid Alternates
  03. Valley
  04. 24 x 48" Attic Vents. See sheet 5.00 and the architectural specs for more information.
  05. Ice and Water Shield shown hatched.
  06. 6' x 8' Skylight
  07. 4' x 4' Skylight - See bid alternate
  08. Roof Hatch
  09. HVAC Relief Air Vent and Fans
  10. HVAC Roof Top Unit
  11. Cricket - 1/2:12 min roof slope at valley
  12. Ridge
  13. Roof Drain and Overflow Drain - see sheet P2.1
  14. Extend Roofing at Lower roof under the canopy structure and properly flash.
  15. Heavy Dashed line represents line of Snow Cleats to help prevent damage to gutters by ice in winter.

Not Used

**1 ROOF PLAN**  
 5/64" = 1'-0" (half size 5/128" = 1'-0")

	<b>Medical Design Group</b> Architecture for Health Care	
	2716 WESTLAND PLACE BOISE, IDAHO 83704-5863 BOISEARCHITECT@AOL.COM Fax (208) 378-1405 Phone (208) 378-0817	
© COPYRIGHT: MEDICAL DESIGN GROUP		
REGISTERED ARCHITECT No. AR-1740 19 March 2004	<b>ROOF PLAN</b>	
	Desert Sage Health Center 2280 American Legion Blvd. Mountain Home, Idaho	<b>SHEET</b> <b>3.40</b>
	Mar 2004 ds340.dwg 01/31/04 15:31	

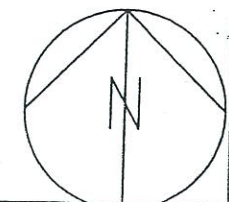


11/11/04 10:11 AM 11/11/04 10:11 AM 11/11/04 10:11 AM

# BARTILE

Installation specifications and guide

## STANDARD BARTILE SHEET METAL PRODUCTS

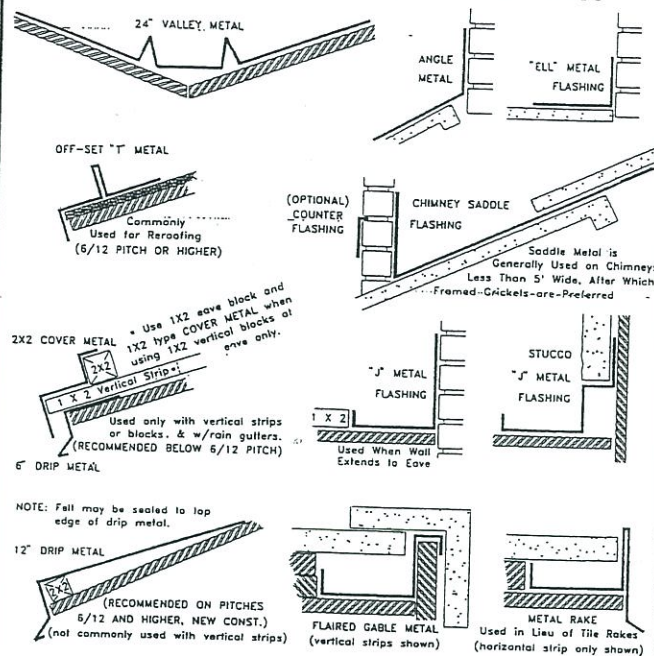


The Standard metal is Galvanized Iron. Optional Colored Metal is Readily Available, as Well as Copper. Aluminum is Stocked in White, Royal Brown, and Classic Cream. Lead is available in 2.5 lb. sheet. BARTILE also fabricates custom shapes for unique situations and special needs.

**PAGE 4**

# BARTILE

Installation specifications and guide

## BASIC FIELD TILE INSTALLATION OPTIONS

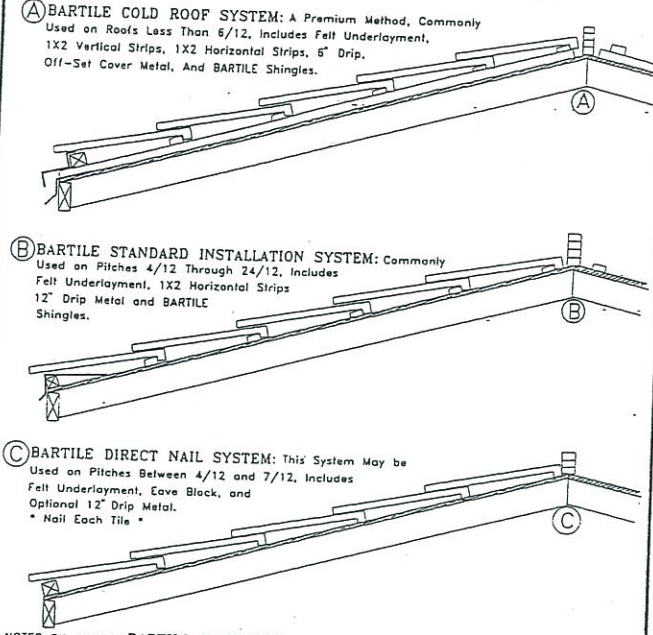


**NOTES ON NAILING:** BARTILE ULTRALITE Requires Each Tile to be Nailed. BARTILE Standard Wt. Requires (3 TILE) Periphery Nailing. (Includes Hips, Ridges, Rakes, and Eaves) On Pitches 2/12 To 5/12 (No Field Nailing Required), 6/12 To 9/12 (Nail 50%), 10/12 up (Nail each tile). The Nailing Requirements Under Severe Weather Conditions May Call For Additional Fastening. On Pitches Below 4/12, 1 Nail For Std. Wt./ 2 Nails For Ultralite is Required.

**PAGE 5**

# BARTILE

Installation specifications and guide

## BARTILE BATTEN LAYOUT

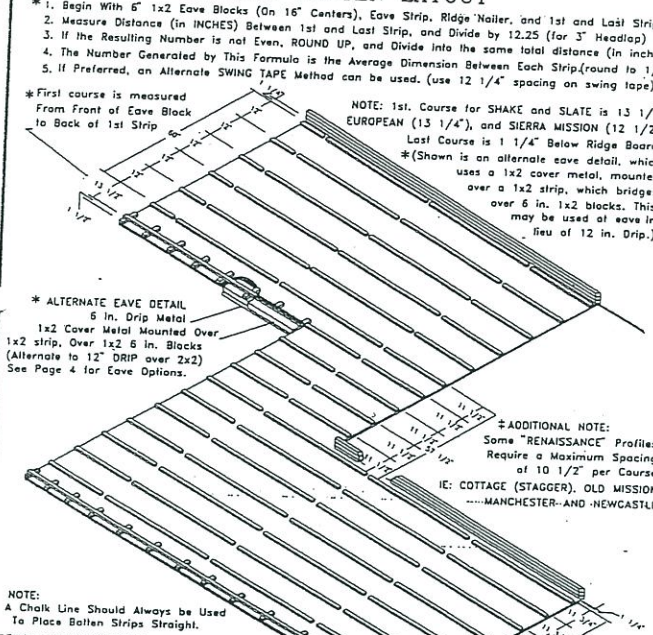


**GENERAL CONSIDERATIONS:**  
 A. Each Slope Should be Calculated Independently.  
 B. Maximum Course Dimension is 12 1/4" ± See Notes  
 C. On a Hip End (HIPS CONVERGING AT TOP) Use 12 1/4" After The Standard First Course Dimension.  
 D. ALWAYS USE TOP EDGE OF STRIP FOR PLACEMENT ON LINE.

**PAGE 6**

# BARTILE

Installation specifications and guide

## VALLEY METAL AND INSTALLATION

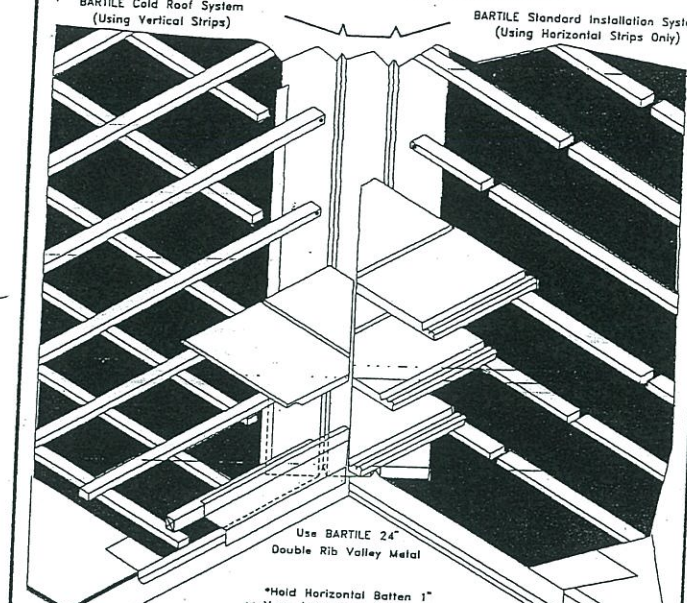


**NOTES:**  
 Underlayment may be sealed to drip metal and woven at valley. (or run bleeder sheet at valley). In ice and snow climates, valley metal should be set in mastic. Lap valley metal sections 6" min. Avoid penetrating valley metal while nailing tile. (use mastic instead) Avoid using small pieces. BARTILE recommends a closed valley (as shown), but an open valley is acceptable. (where deemed appropriate) Do not block valley metal channel, nor drainage next to ribs in any way.

**PAGE 7**

# BARTILE

Installation specifications and guide

## HIP AND RAKE DETAILS

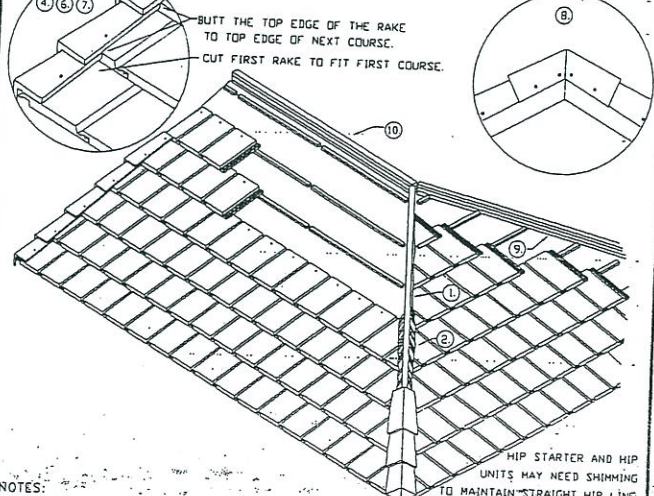


**NOTES:**  
 1. The Field Tile Must be Cut, (Mitered) to Fit Against the Hip Nailer Board.  
 2. Hip Cuts may be Grouled (Shown), or Covered With Flashing Tape, if Desired.  
 3. Hip Units are Nailed With Two 16d Galv. Nails. (One Nail is Exposed)  
 4. For Flat Tile, Every Other Course Must Start With a Cut Half Tile. (Half Band)  
 5. Universal Rake Units Cover Either Side, Nail Through Either Side. (Not Top Hole)  
 6. First Rake Must be Cut-to Fit First Course of Tile. (Drill as Required)  
 7. Each Rake Covers One Course of Tile. Butt into Top Edge of Next Course.  
 8. The Last Rake Units at Crown Must be Mitered Together. (Drill as Required)  
 9. Hip Nailer Boards are Usually a Stack of 1x2 Strips 4 or 5 High, as Required.  
 10. Ridge Nailer Boards are Usually 3 to 5 Strips High, as Required.  
 \*\*\*\*\*EUROPEAN AND SIERRA MISSION TILE ARE LAID STRAIGHT BOND, NOT OFF-SET.\*\*\*  
 (Lay 5 Tile Wide, From Eave to Ridge, Verify Straight, Then Repeat)

**PAGE 9**

# BARTILE

Installation specifications and guide

## CHIMNEY AND WALL FLASHING DETAILS

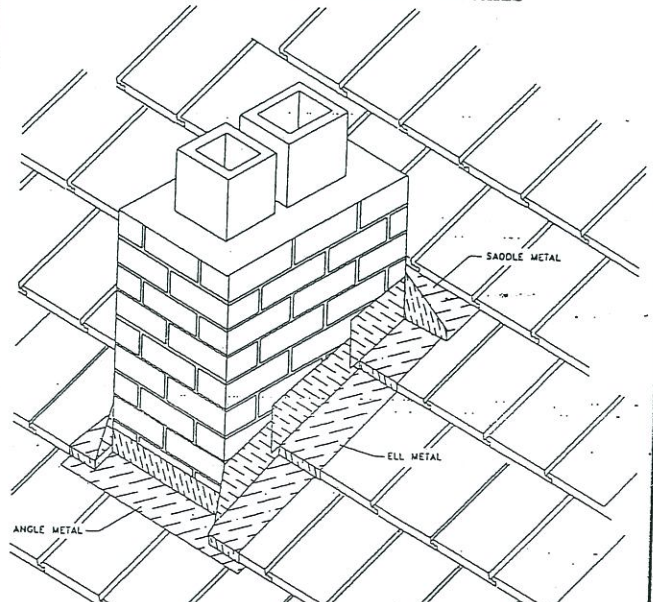

**NOTES:**  
 Roll the underlayment up the wall about 3" on all sides. Seal water tight. Leave a 1"-2" opening between battens and walls, for drainage. Install metal as shown, attaching only to wall, and seal. Counterflashing may be used. When wall terminates at or near eave, "J" METAL may be the preferred side wall flashing. Cut the sidewall tile within 1/2" of wall and seal with mastic. The EUROPEAN and SIERRA MISSION Profiles may require lead or gravel flashings at the tile level, with metal underneath the tile. It is recommended that the "J" METAL be cut into 16" lengths, and beyond wall and SADDLE METAL extends 6" beyond wall on each side, then is bent over at flange.

**PAGE 13**


# BARTILE

Installation specifications and guide

## FIELD TYPE ICE BRACKETS

\* In SEVERE WINTER CLIMATES, Massive Ice Buildup at the Eave Can Cause Damage. ICE RETENTION BRACKETS and/or HEAT CABLES can Reduce or Eliminate This Problem.

The ICE RETENTION BRACKETS are Nailed or Bolted to the Deck, Through the Vertical Strip (if Used) and Deck. The ICE RETENTION BRACKET is Designed to Hold the Ice Buildup in Place and Prevent it from Sliding Down the Roof, Causing Damage to Rain Gutters, Lower Roof Areas, Landscaping, Eave Tile, Etc. Mount the ICE RETENTION BRACKETS 16" to 24" Apart, on 1st, 3rd & 5th Row, and in Valley Areas, and Dormers. Slagger the Vertical Rows of Brackets in a zigzag Pattern.

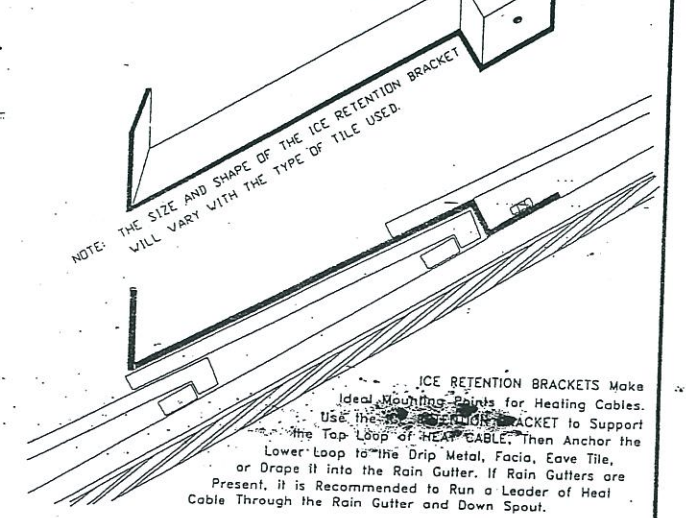

**NOTE:** THE SIZE AND SHAPE OF THE ICE RETENTION BRACKET WILL VARY WITH THE TYPE OF TILE USED.

ICE RETENTION BRACKETS Make Ideal Mounting Points for Heating Cables. Use the ICE RETENTION BRACKET to Support the Top Loop of HEAT CABLE. Then Anchor the Lower Loop to the Drip Metal, Fascia, Eave Tile, or Draps it into the Rain Gutter. If Rain Gutters are Present, it is Recommended to Run a Leader of Heat Cable Through the Rain Gutter and Down Spout.

**PAGE 16**


**Medical Design Group**  
 Architecture for Health Care  
 2716 WESTLAND PLACE  
 BOISE, IDAHO 83704-5863  
 BOISEARCHITECT@AOL.COM  
 Fax (208) 378-1405  
 Phone (208) 378-0817

REGISTERED ARCHITECT  
 No. AR-1740  
 19 March 2004


**TYPICAL ROOF DETAILS**

Desert Sage Health Center SHEET  
 2280 American Legion Blvd. 3.45  
 Mountain Home, Idaho


Mar 2004 ds345.dwg 03/19/04 19: 41

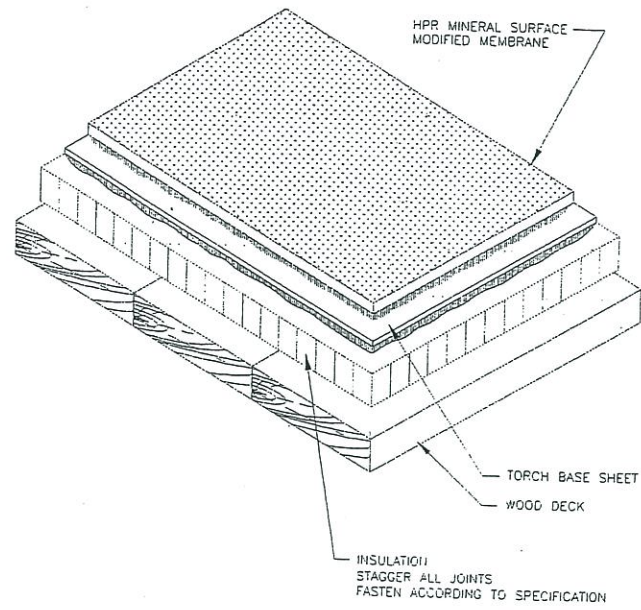


TYPICAL SECTIONS - MINERAL FINISH  
N.T.S.

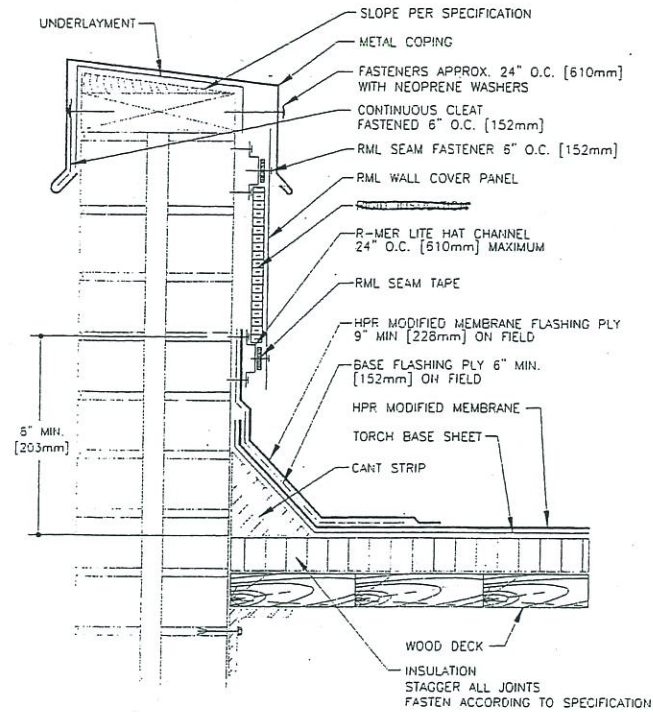


RML WALL PANEL W/MODIFIED BITUMEN ROOF/FLASHING  
N.T.S.

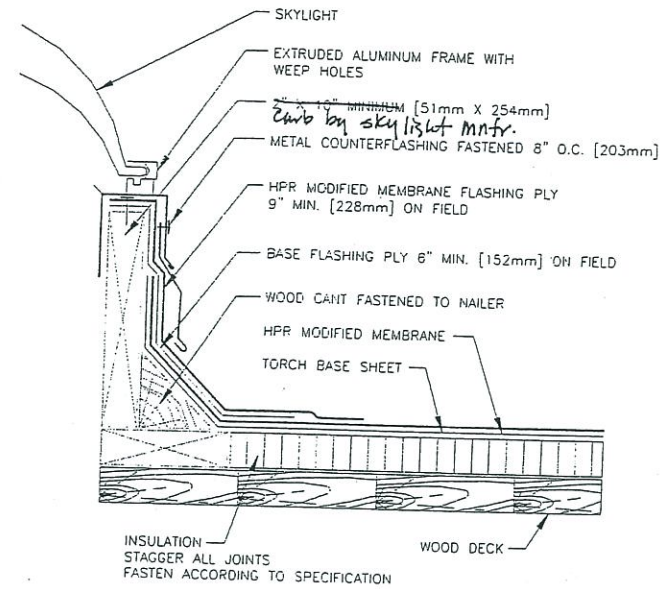


SKYLIGHT  
N.T.S.

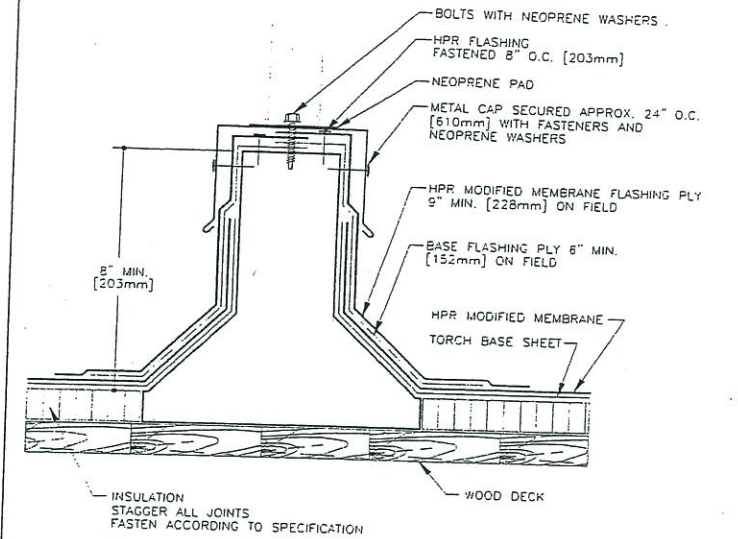

PREMANUFACTURED CURB FOR EQUIPMENT SUPPORT  
N.T.S.

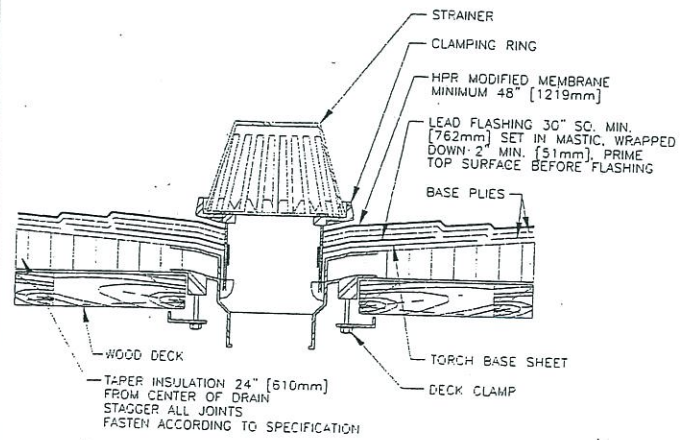

ROOF DRAIN - ALTERNATE  
N.T.S.

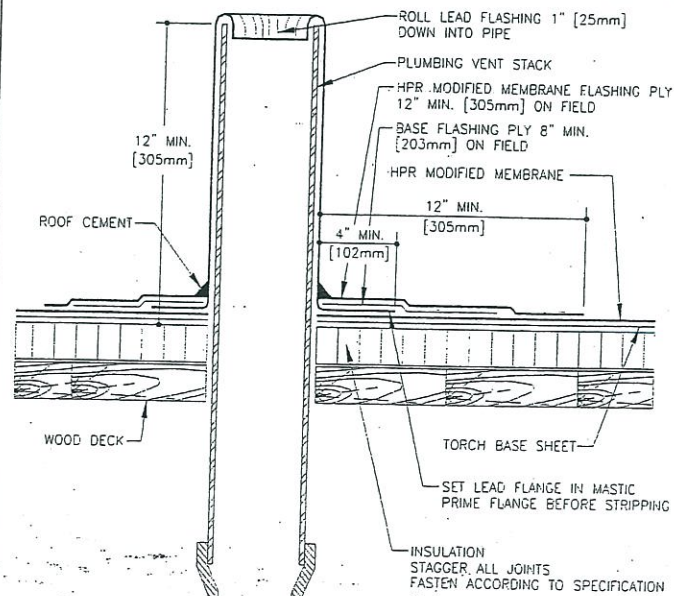

PLUMBING STACK  
N.T.S.

**Medical Design Group**  
Architecture for Health Care

2716 WESTLAND PLACE  
BOISE, IDAHO 83704-5863

BOISEARCHITECT@AOL.COM  
Fax (208) 378-1405  
Phone (208) 378-0817

© COPYRIGHT: MEDICAL DESIGN GROUP

REGISTERED ARCHITECT  
No. AR-1740  
19 March 2004

Desert Sage Health Center  
2280 American Legion Blvd.  
Mountain Home, Idaho

SHEET  
**3.46**

Mar 2004

ds346.dwg 03/19/04 19:42

# CAPSTONE PRODUCTS

## DIRECTIONS FOR APPLICATION


THESE APPLICATION INSTRUCTIONS ARE THE MINIMUM REQUIRED TO MEET ELK'S APPLICATION REQUIREMENTS. FAILURE TO USE THESE INSTRUCTIONS MAY VOID THE PRODUCT WARRANTY. IN SOME AREAS THE BUILDING CODES MAY REQUIRE ADDITIONAL APPLICATION TECHNIQUES OR METHODS BEYOND OUR INSTRUCTIONS. IN THESE CASES THE LOCAL CODE MUST BE FOLLOWED. UNDER NO CIRCUMSTANCES WILL ELK ACCEPT APPLICATION REQUIREMENTS THAT ARE LESS THAN THOSE PRINTED HERE. SHINGLES SHOULD NOT BE JAMMED TIGHTLY TOGETHER. ALL AT-TICES SHOULD BE PROPERLY VENTILATED.

## DECK PREPARATION

Roof decks should be dry, well seasoned 1" x 6" (2.54 cm x 15.24 cm) boards, exterior grade plywood at least 3/8" (0.95 cm) thick and conform to the specifications of the American Plywood Association, 7/16" (1.11 cm) oriented strandboard, or chipboard. Fire retardant plywood decking is NOT an approved substrate for Capstone shingles.

## UNDERLAYMENT

Use non-perforated 15 to 30 pound asphalt saturated felt. Underlayment is required on new construction and recommended for reroofing.

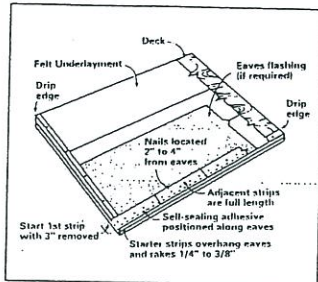

STANDARD SLOPE 4/12 to 21/12. Use one layer of underlayment, as shown in Drawing 1.A.

LOW SLOPE 2/12 to 4/12. Completely cover the deck with two plies of felt underlayment overlapping a minimum of 18" (45.72 cm). Begin by fastening an 18" (45.72 cm) wide felt underlayment along the eaves. Next, apply a full 36" (91.44 cm) wide felt sheet horizontally along the eaves. Next, apply a full 36" (91.44 cm) wide and overlap the preceding course by 18" (45.72 cm).

EAVE FLASHING (ICE DAMS) Eave flashing MUST be installed in localities where leaks may result by a water back up near an ice dam.

STANDARD SLOPE 4/12 to 21/12. Use coated roll roofing of not less than 50 pounds (22.68 kg) over the felt underlayment extending from the eave edge to a point at least 12" (30.48 cm) beyond the inside wall.

LOW SLOPE 2/12 to 4/12. Use a continuous layer of asphalt plastic cement between the two plies of underlayment from each edge up roof to a point at least 24" (60.96 cm) beyond the inside wall line.

## METAL DRIP EDGES

Metal drip edges are recommended along rake and eave edges of all decks. Consult the Elk Tuscaloosa, Alabama Sales Office for application specifications over other decks and other slopes.

## HIP AND RIDGE SHINGLE APPLICATION

## VALLEY CONSTRUCTION

## FASTENERS

## PROPER FASTENER LOCATION

## PROPER FASTENER LOCATION


## PROPER FASTENER LOCATION

## PROPER FASTENER LOCATION

## PROPER FASTENER LOCATION

## PROPER FASTENER LOCATION




## PRODUCT APPLICATION

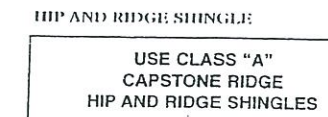

USE CLASS "A" CAPSTONE RIDGE HIP AND RIDGE SHINGLES. Exposure - Five inches (5" [12.7 cm]). IMPORTANT: Do not remove tape on back of shingle.

SHINGLE DIMENSIONS: 12-1/8" x 39-1/2" (30.8 cm x 100.33 cm). CAUTION: By careless and improper storage or handling, fiberglass shingles can be harmed. Keep these shingles completely covered, dry, reasonable cool, and protected from the weather. Do not store near steam pipes, radiators, furnaces, or other sources of heat. Do not store indirect sunlight until applied. The longest will be the first to be moved out.

FASTENERS Help stop blow-offs and eave-backs. While nailing is the "preferred" fastening method for Capstone shingles, Elk Corporation of Alabama will accept fastening methods according to the following instructions: Four to six fasteners must be driven into the DOUBLE THICKNESS area of the shingle. Nails or staples must be placed between the sealant dots.

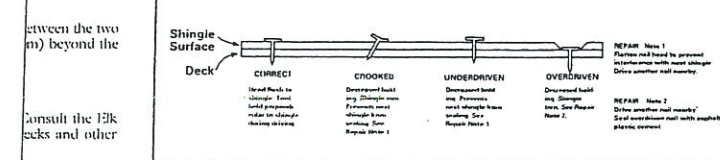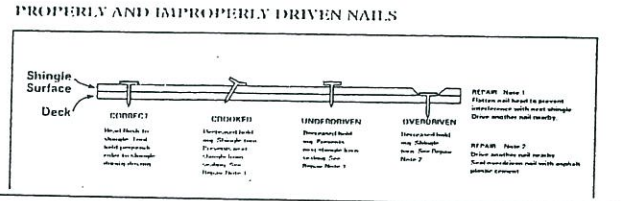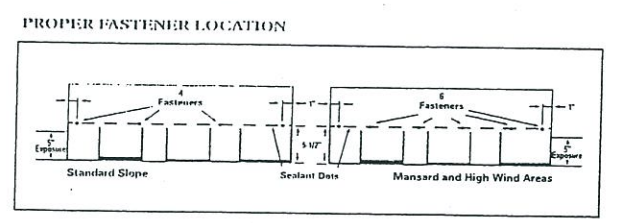

If you nail correctly, you will penetrate both layers of the shingle and the top portion of the shingle under it. This gives you double protection. You will reduce the chances of blow-offs, and you will not jeopardize your warranty. If you fasten above the sealant dots you will miss the shingle below and obtain no secondary fastening.

ELK Capstone shingles have a U.L. Wind Resistance Rating when using nails or staples on reroofs as well as new construction.

NAILS: Galvanized, 3/8" (0.95 cm) head, 10 to 12 gauge barbed shank roofing nails. Aluminum 3/4" (1.91 cm) penetration in deck, 1-1/4" (3.18 cm) nail required for new construction and 1-1/2" (3.81 cm) nail required for reroofing. Nails should be long enough to sink into and hold in a sound nailing base.

STAPLES: Galvanized, 16 gauge minimum, crown width minimum of 15/16" (2.38 cm), Aluminum 3/4" (1.91 cm) penetration in deck.

Special care must be taken in the use of staple guns. Staples must be driven with the gun accurately adjusted to ensure the entire crown bears tightly against the shingle buy does not cut the shingle surface. An improperly adjusted staple gun can result in raised staples which can cause a fish-mouthed appearance and can prevent sealing.

MANSARD AND HIGH WIND AREA FASTENER LOCATION Correct fastening is critical to the performance of the roof.


For slopes exceeding 60 degrees (or 21/12) use 6 fasteners. Locate fasteners in the fastener area 1" (2.54 cm) from each side edge with the remaining 4 fasteners equally spaced along the length of the double thickness area.

High wind areas are areas where sustained winds greater than 50 miles per hour (80.47 km/h) are normally experienced.

Correct fastening is critical to the performance of the roof. ELK CORPORATION will accept only fastening methods according to the above instructions.




## THE GARLAND COMPANY, INC. R-MER WALL FLUSH PANEL

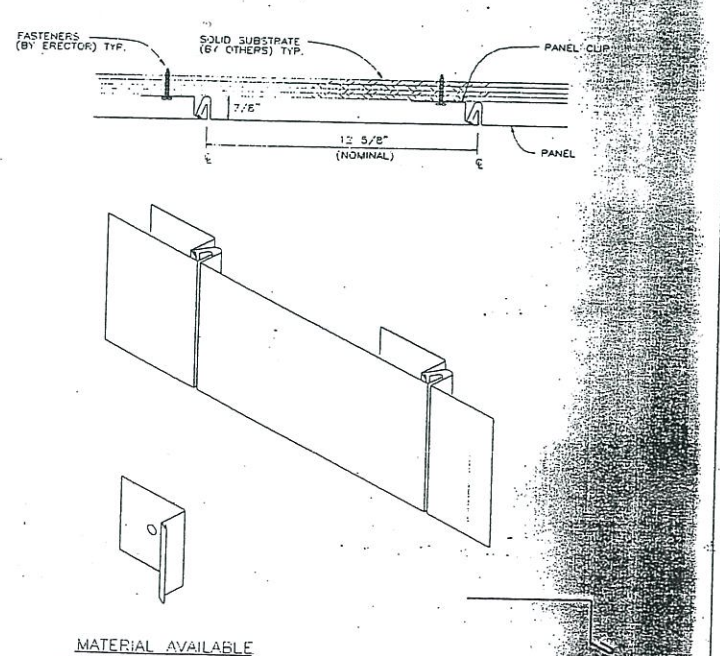


MATERIAL AVAILABLE MATERIAL: 24" GA GALVALUME STEEL MATERIAL: .032 ALUMINUM R-MER WALL FLUSH PANEL N.T.S.

## THE GARLAND COMPANY, INC. INSIDE CORNER

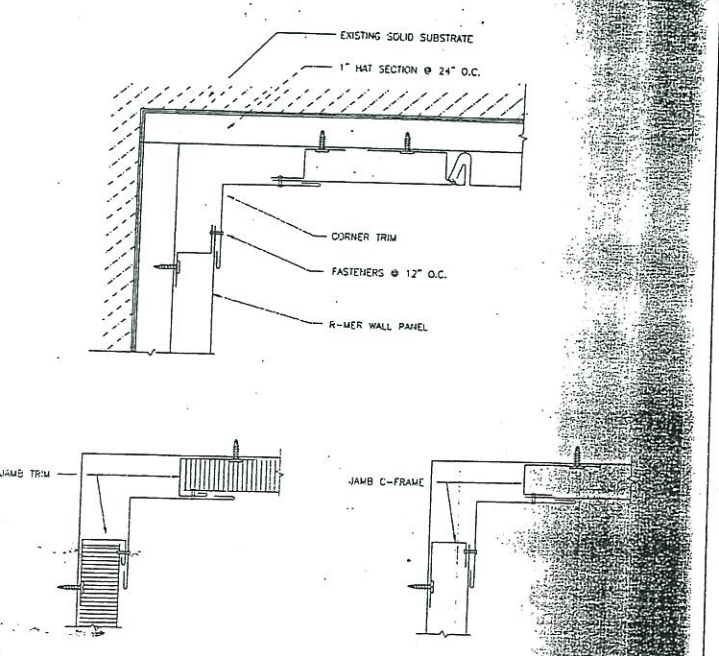

INSIDE CORNER N.T.S.

## THE GARLAND COMPANY, INC. SILL @ BASE

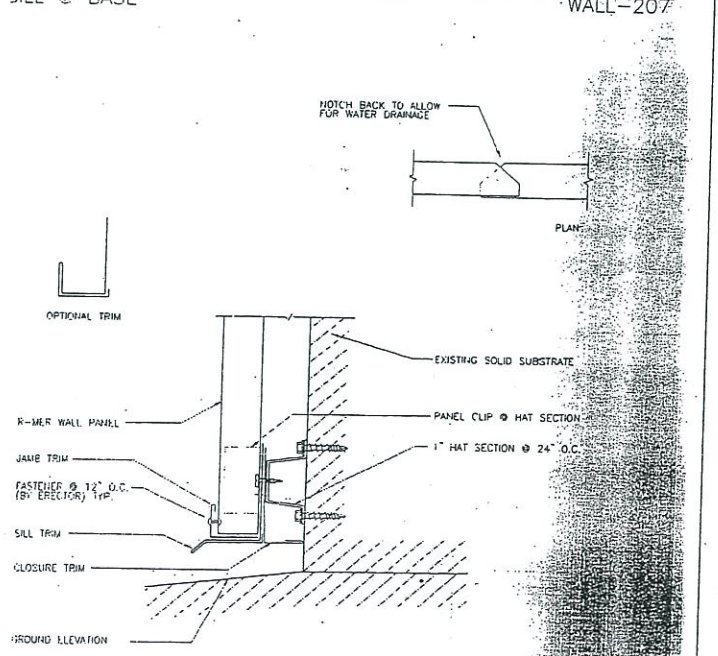

SILL @ BASE N.T.S.

**Medical Design Group**  
Architecture for Health Care

2716 WESTLAND PLACE  
BOISE, IDAHO 83704-5863  
BOISEARCHITECT@AOL.COM  
Fax: (208) 378-1405  
Phone: (208) 378-0817


REGISTERED ARCHITECT No. AR-1740 19 March 2004

DAVID R. DAVIES STATE OF IDAHO

ROOF/WALL PANEL DETAILS SHEET 3.47

Desert Sage Health Center  
2280 American Legion Blvd.  
Mountain Home, Idaho

Mar 2004 ds347.dwg 03/19/04 19:43

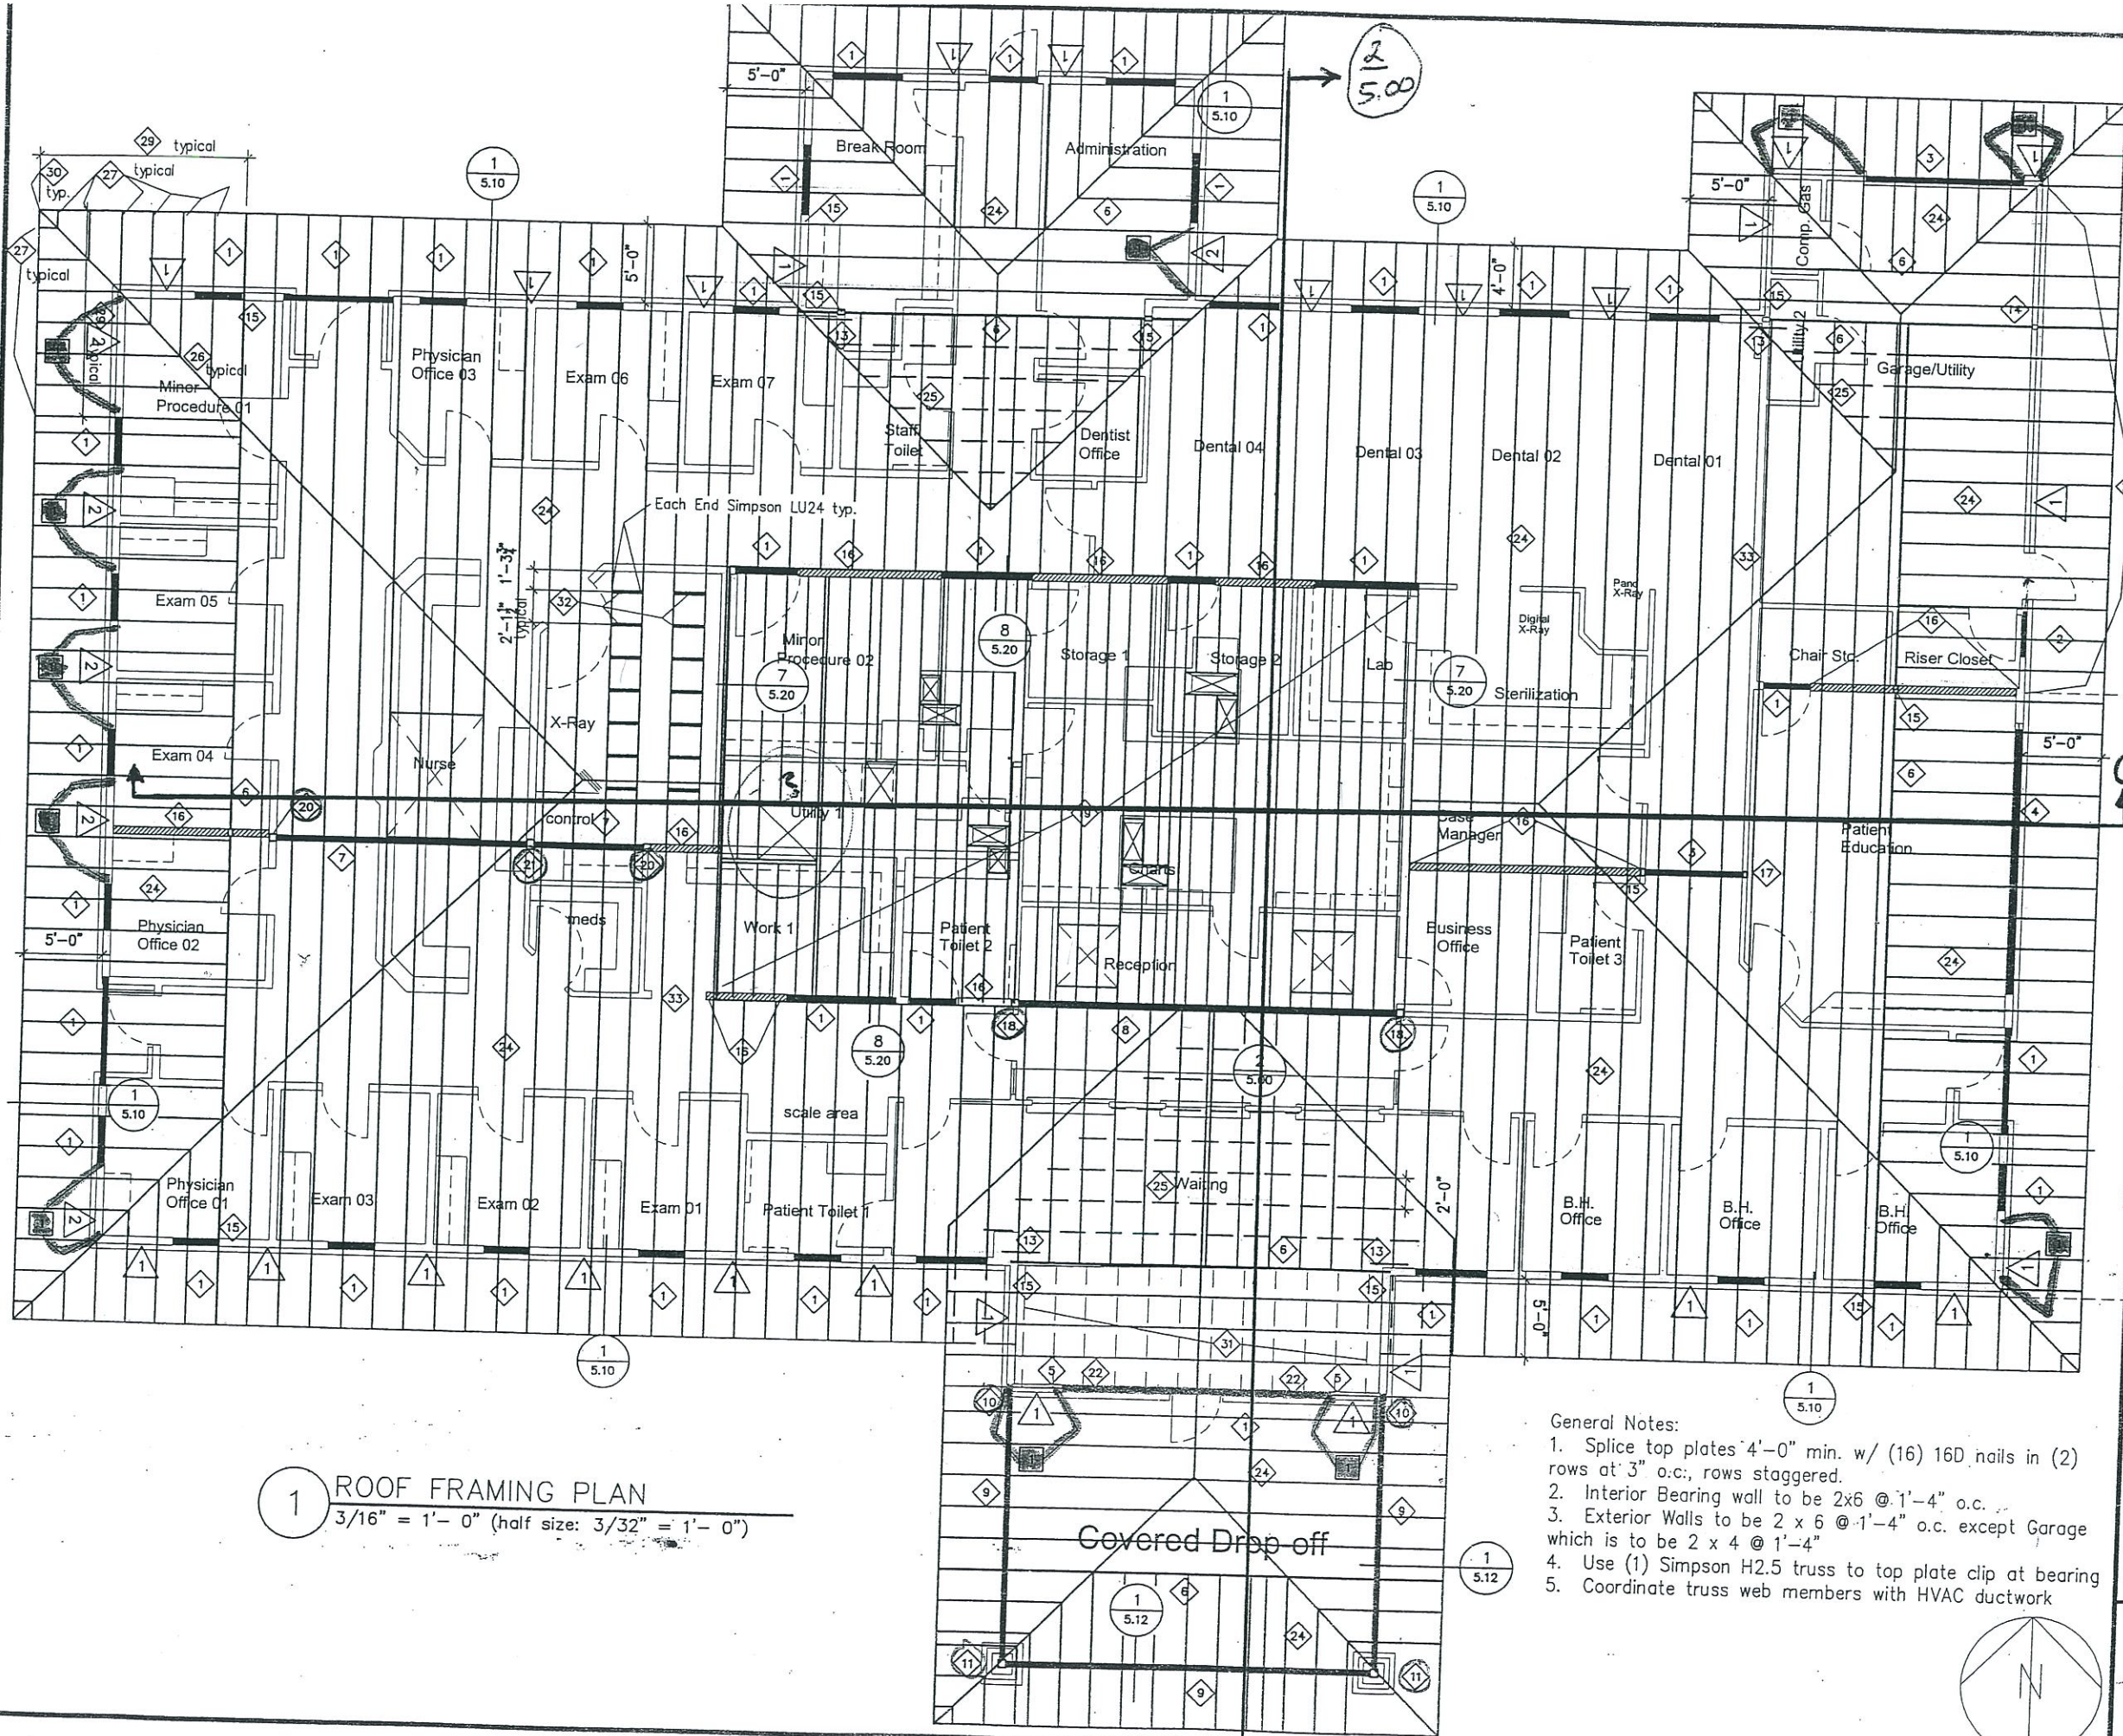

- ### Numbered Notes
01. 6 x 8 or (2) 1 3/4 x 9 1/4 LVL.
  02. 4 x 12
  03. (2) 1 3/4 x 9 1/4 LVL  
w/ (2) 2 x 4 Trimmers w/ (4) 2x4 King Sts
  04. (3) 1 3/4" x 11 7/8 LVL w/ (2)  
2 x 6 Trimmers w/ (3) 2 x 6 King Studs
  05. (3) 2 x 6 King Studs
  06. Girder Truss
  07. 5 1/4" x 14" PSL
  08. 5 1/8" x 24" GLB
  09. 5 1/8" x 16 1/2" GLB
  10. 6 x 6 #1 w/ ECC 5 1/4-6 cap *2 ea*
  11. 6 x 6 #1 w/ Simpson ECC 5 1/4-6 *2 ea*  
cap w/ GLT5 offset (for side beam) w/  
CB66 base.
  12. (2) 2 x 6 King Studs
  13. Strap G.T. to top Plates w/ (1) Simps.  
CMSTC16 (L=8') w/ 16D @ 3" o.c.  
staggered each end.
  14. (2) 2 x 4
  15. (2) 2 x 6
  16. 2 x 6 @ 1'-4" o.c.
  17. (3) 2 x 4
  18. 6 x 6 #1 w/ Simps. ECCQ5-6SDS2.5 cap *2 ea*
  19. 16" TJI Pro 250's @ 1'-4" o.c. max. *2 ea*
  20. 6 x 6 #1 w/ Simps. ECCQ5-6 SDS 2.5 *2 ea*  
cap
  21. 6 x 8 #1 w/ Simps. ECCQ5-6 SDS 2.5 *1 ea*  
cap
  22. Connect Truss to top plate w/ Simps.  
A35's @ 2'-0" o.c.
  23. 2 x 4 at 1'-4" o.c.
  24. Pre-engineered trusses @ 2'-0" oc max
  25. Overbuilt framing - 2 x 4 @ 1'-4" o.c.  
pony walls
  26. Hip Truss
  27. (1) Simpson HGA10 to truss
  28. End Nail Fascia to truss tail w/ (3)16d
  29. 2 x 10 LSL structural fascia.
  30. (1) simpson HUC210 to hip truss
  31. 2x6 @ 2'-0 o.c. Ceiling Joists
  32. 4x4 solid wood blocking between bot.  
truss chords flush with back of gyp.  
board to accomodate x-ray head mounts.  
Mounts to be two OFOI Rails. Each rail  
to hold 500 lbs dynamic load
  33. Install Header anticipating future door


**1 ROOF FRAMING PLAN**  
3/16" = 1'-0" (half size: 3/32" = 1'-0")

- ### General Notes:
1. Splice top plates 4'-0" min. w/ (16) 16D nails in (2) rows at 3" o.c.; rows staggered.
  2. Interior Bearing wall to be 2x6 @ 1'-4" o.c.
  3. Exterior Walls to be 2 x 6 @ 1'-4" o.c. except Garage which is to be 2 x 4 @ 1'-4"
  4. Use (1) Simpson H2.5 truss to top plate clip at bearing
  5. Coordinate truss web members with HVAC ductwork




**Medical Design Group**  
Architecture for Health Care  
2716 WESTLAND PLACE  
BOISE, IDAHO 83704-5863  
BOISEARCHITECT@AOL.COM  
Fax (208) 378-1405  
Phone (208) 378-0817

© COPYRIGHT: MEDICAL DESIGN GROUP

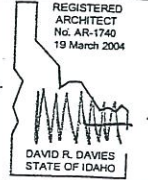

**ROOF FRAMING PLAN**  
Desert Sage Health Center SHEET  
2280 American Legion Blvd. 3.50  
Mountain Home, Idaho

2:\VIEW\PLATE\mag.dwg March 2003

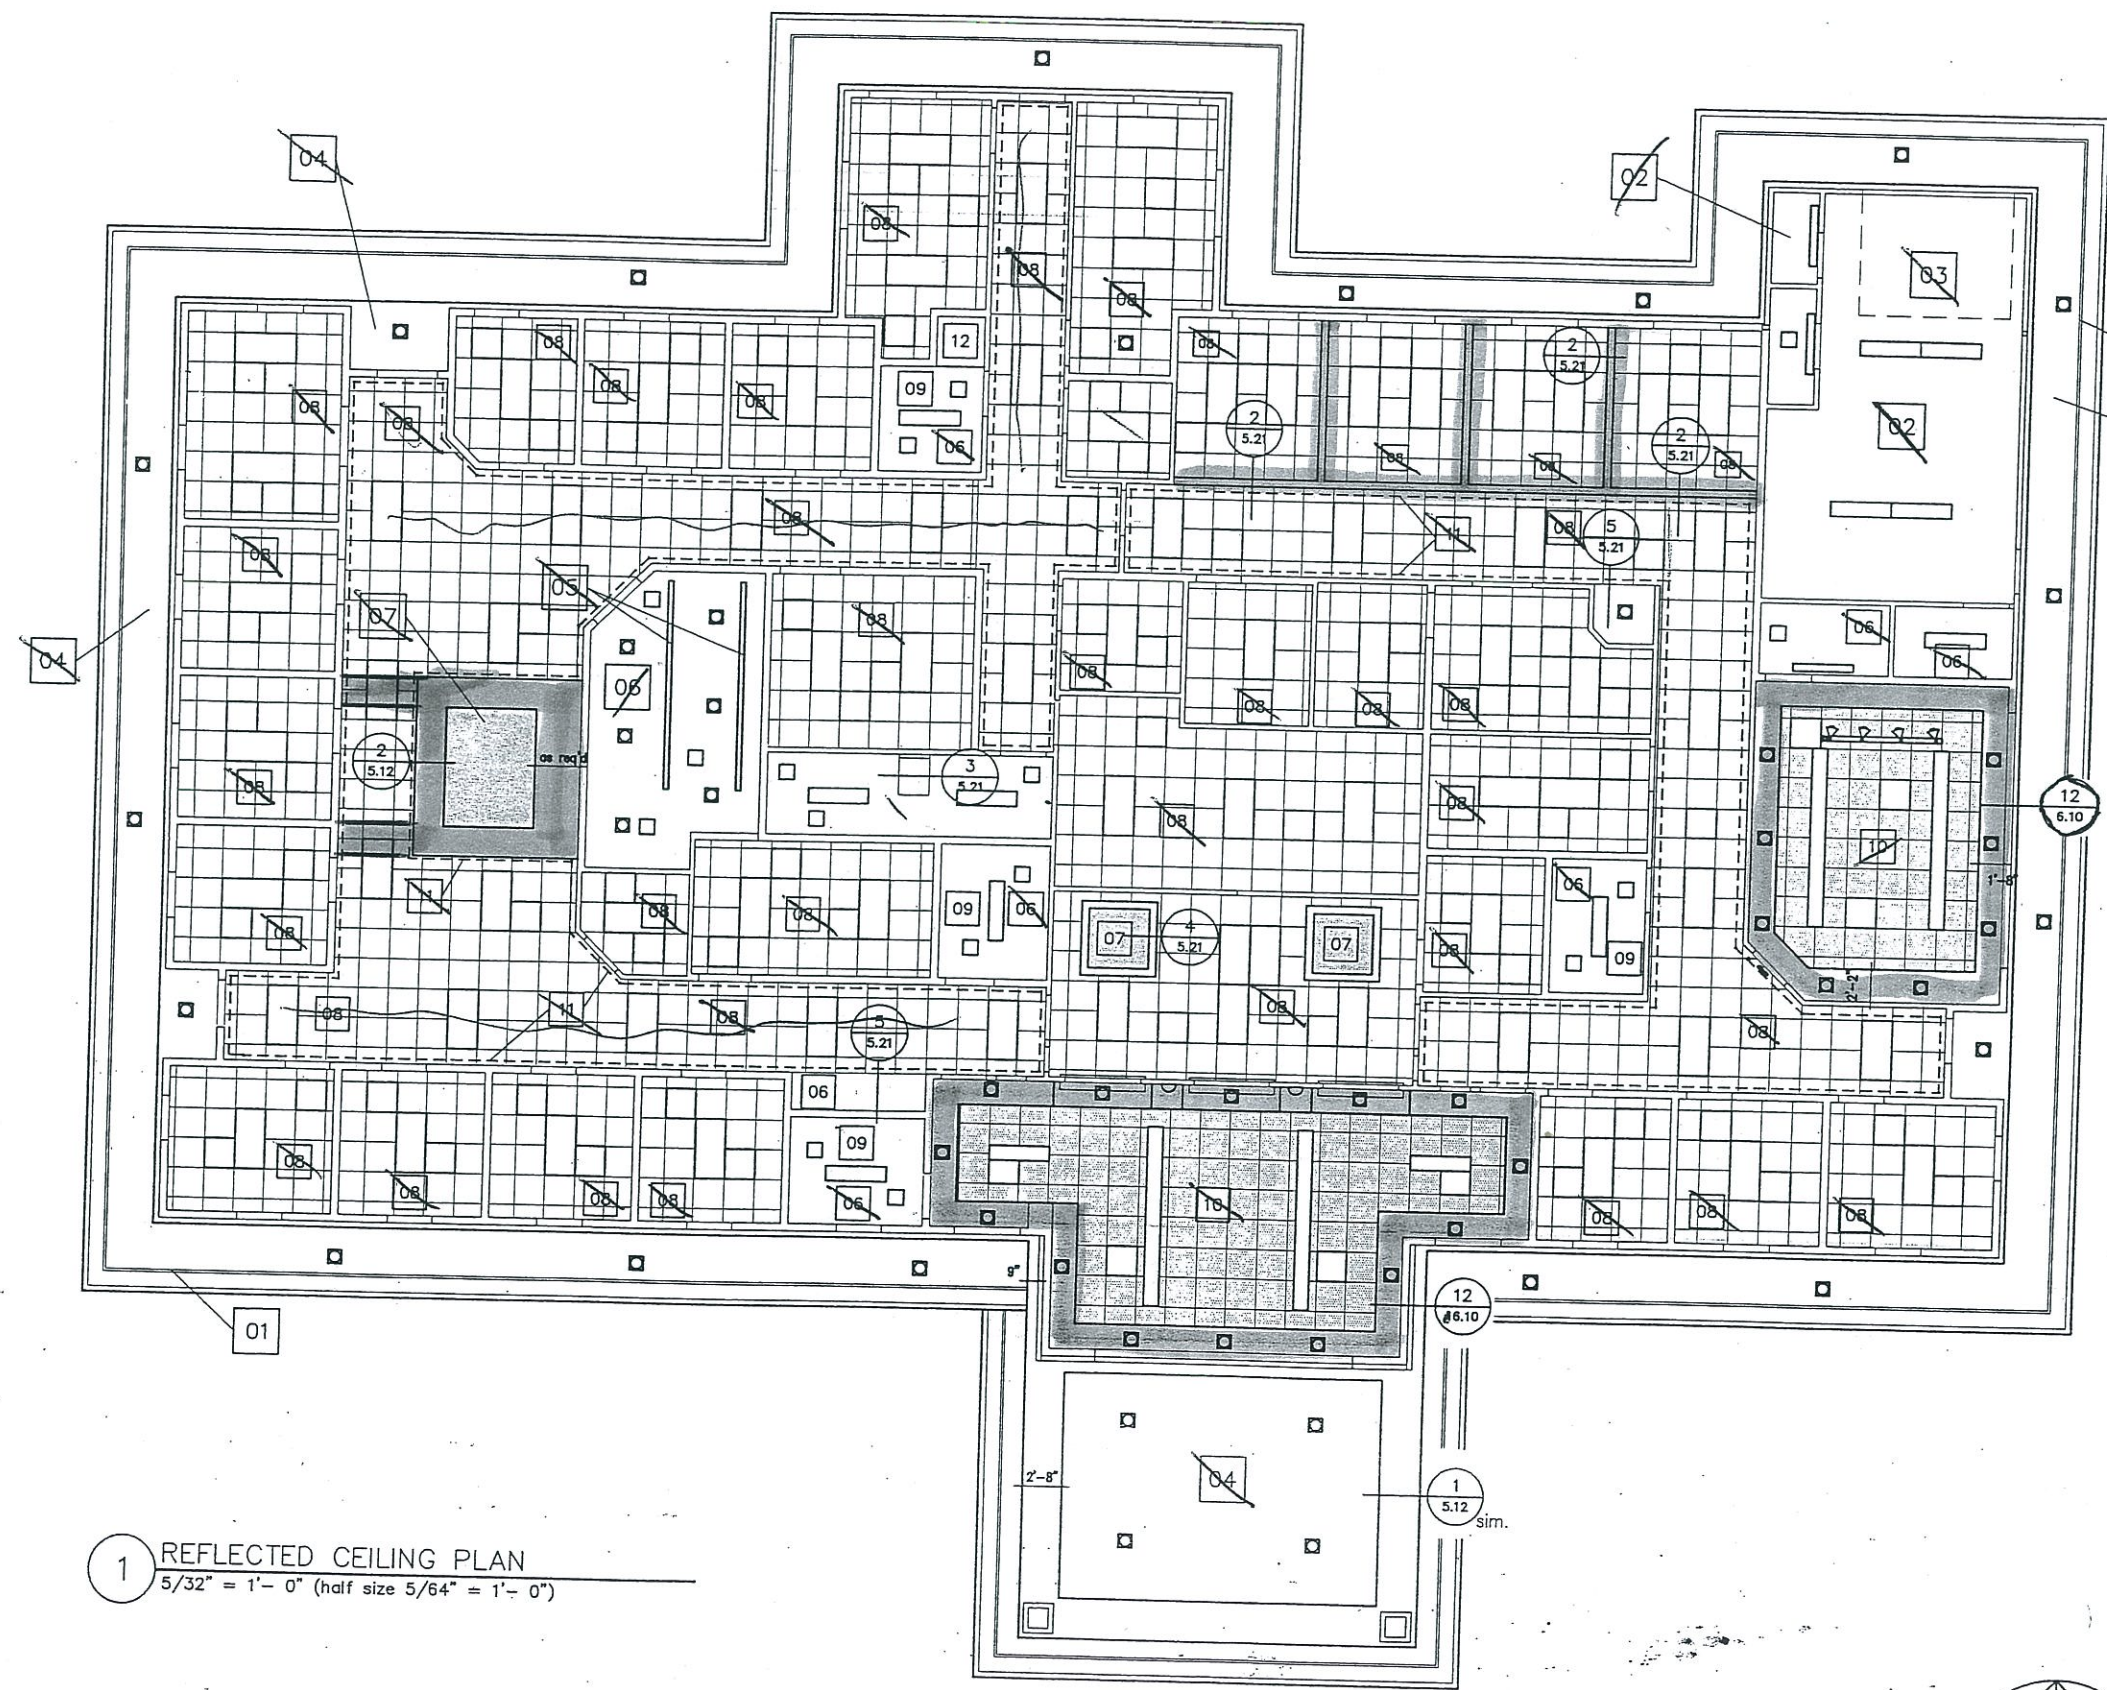

- NUMBERED NOTES**
- 01. Continuous Vent
  - 02. (2) layers 5/8" type x gypsum board
  - 03. Automatic Garage Door shown dashed
  - 04. Stucco Finish
  - 05. OF01 Xray Brackets bolted to blocking
  - 06. (1) layer gypsum board onto trusses
  - 07. Skylight
  - 08. Lay-in Ceiling System
  - 09. Epoxy Paint
  - 10. Type "B" ceiling tiles
  - 11. Crown Moulding - see detail 1/5.21
  - 12. Similar to Boise Moulding (BM) 1520
  - 12. Hard Ceiling at elev. 107'-6" - furr down

**Soffits**

**1 REFLECTED CEILING PLAN**  
 5/32" = 1'- 0" (half size 5/64" = 1'- 0")


**GENERAL NOTE:**  
 See sheet 5.10 for typical lay-in ceiling mounting height  
 Type "A" ceiling tiles typical UNO

**Medical Design Group**  
 Architecture for Health Care  
 2716 WESTLAND PLACE  
 BOISE, IDAHO 83704-5863  
 BOISEARCHITECT@AOL.COM  
 Fax (208) 378-1405  
 Phone (208) 378-0817

REGISTERED ARCHITECT  
 No. AR-1740  
 19 March 2004  
 DAVID R. DAVIES  
 STATE OF IDAHO


**REFLECTED CEILING PLAN**

Desert Sage Health Center SHEET  
 2280 American Legion Blvd.  
 Mountain Home, Idaho 3.60

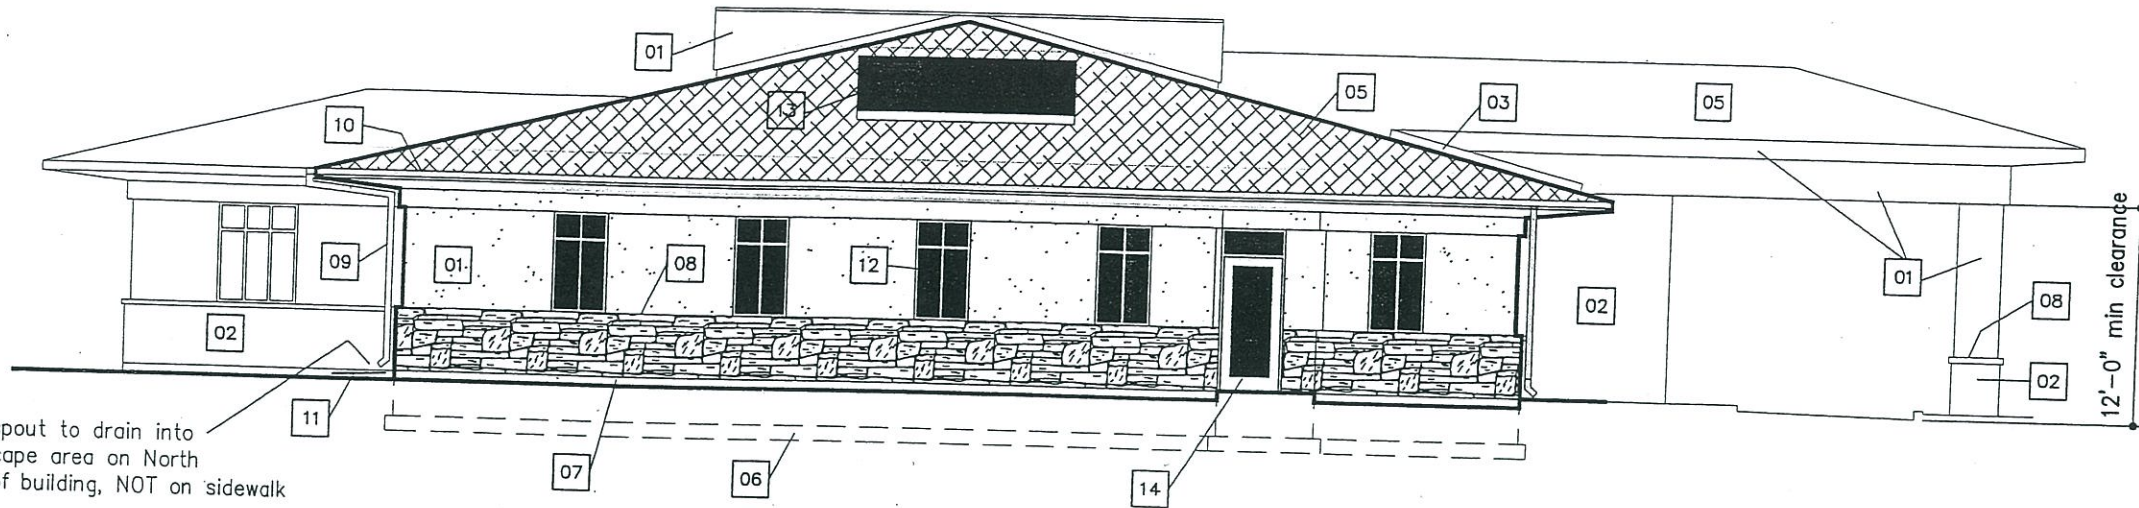


- NUMBERED NOTES:
- 01. Stucco
  - 02. Stone Veneer
  - 03. Metal Flashing
  - 04. Cast Letters
  - 05. Roofing
  - 06. Conc. Footing/Foundation
  - 07. Stucco Finish on exposed conc.
  - 08. Pre-manuf. stone cap
  - 09. Downspout
  - 10. Gutter
  - 11. Pre-cast Conc. Downspout
  - 12. Window Assembly
  - 13. Skylight Assembly
  - 14. Door Assembly
  - 15. Light Fixture

2 WEST EXTERIOR ELEVATION  
 3/16" = 1'- 0" (half size: 3/32" = 1' - 0")

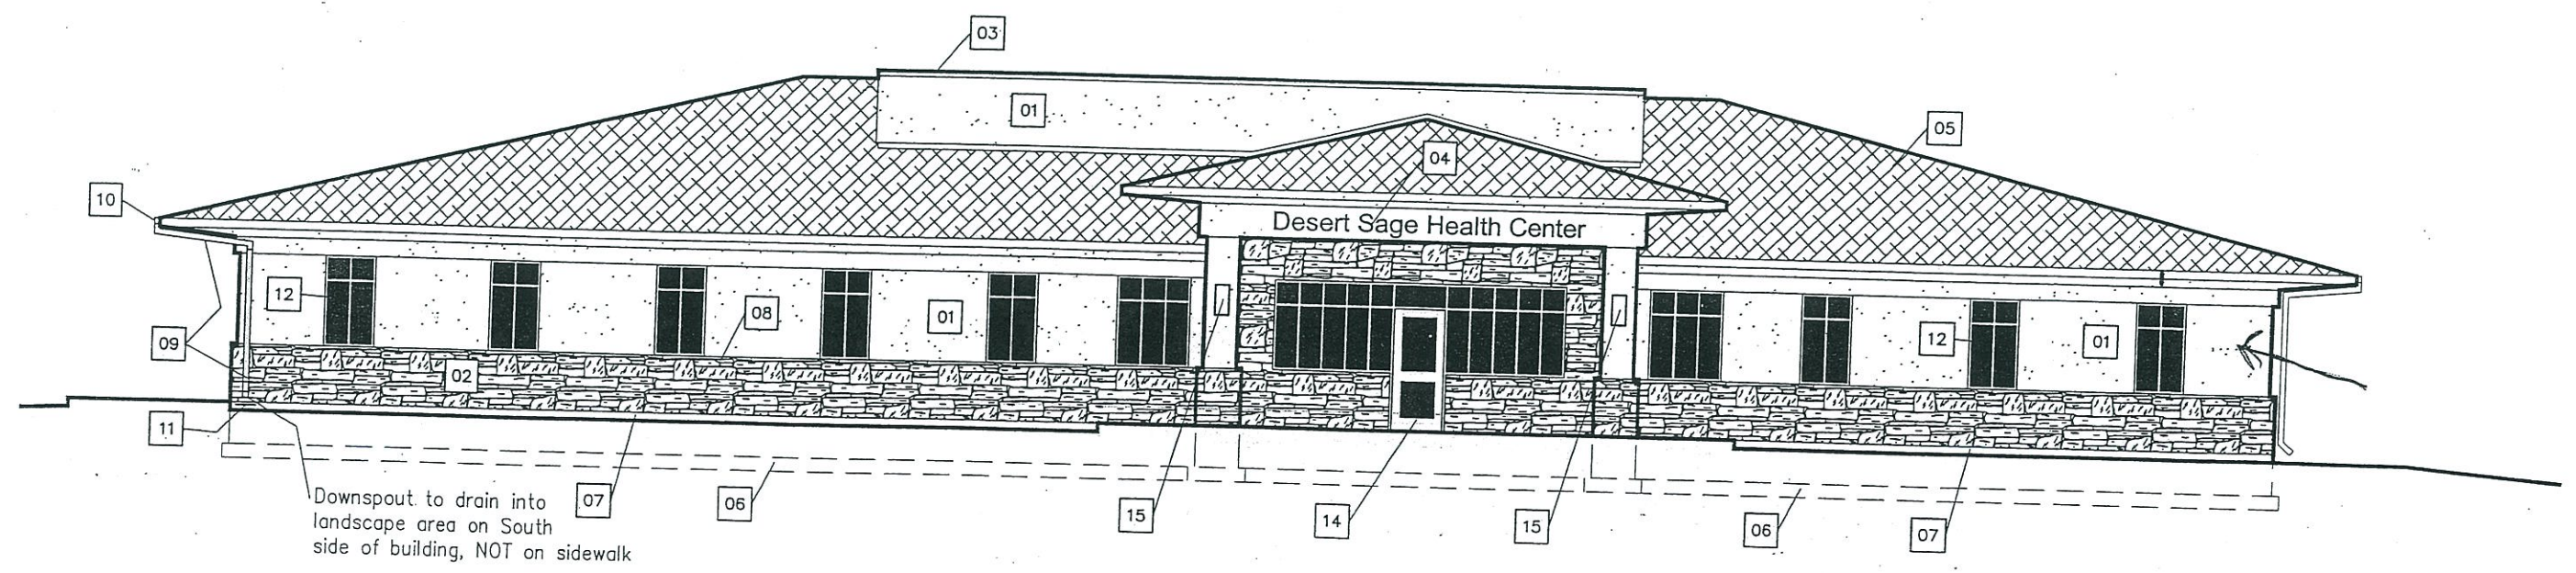

1 SOUTH EXTERIOR ELEVATION  
 3/16" = 1'- 0" (half size: 3/32" = 1' - 0")

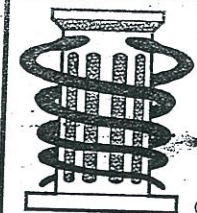

**Medical Design Group**  
 Architecture for Health Care

2716 WESTLAND PLACE  
 BOISE, IDAHO 83704-5863

BOISEARCHITECT@AOL.COM  
 Fax (208) 378-1405  
 Phone (208) 378-0817

© COPYRIGHT: MEDICAL DESIGN GROUP


REGISTERED ARCHITECT  
 No. AR-1740  
 19 March 2004

DAVID R. DAVIES  
 STATE OF IDAHO

<b>EXTERIOR ELEVATIONS</b>	
Desert Sage Health Center 2280 American Legion Blvd. Mountain Home, Idaho	<b>SHEET</b> <b>4.00</b>
Mar 2004	ds400.dwg 03/22/04 10:30


4:\PROJECTS\1004\1004.dwg March 2003



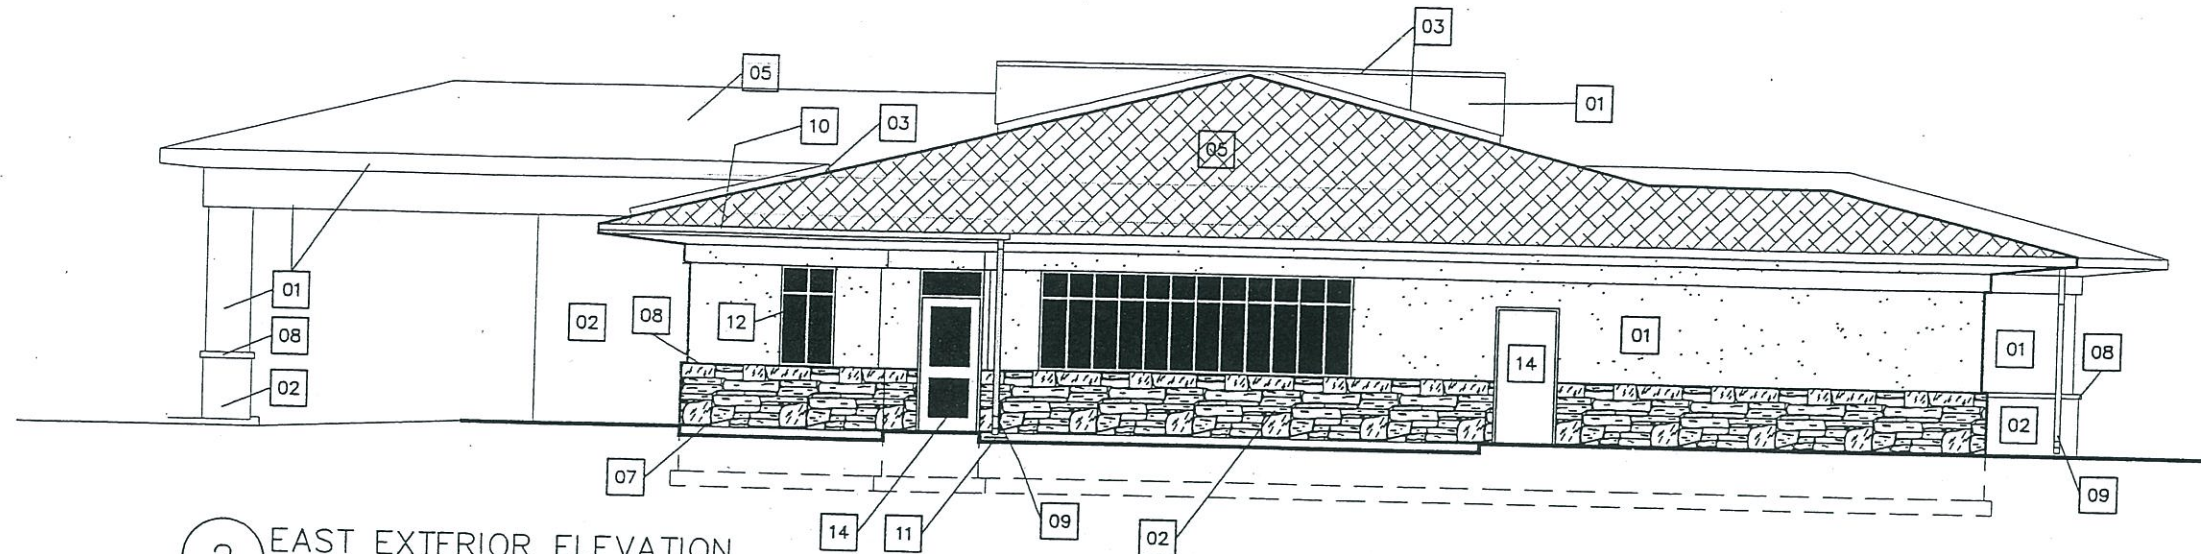


- NUMBERED NOTES:
01. Stucco
  02. Stone Veneer
  03. Metal Flashing
  04. Cast Letters
  05. Roofing
  06. Conc. Footing/Foundation
  07. Stucco Finish on exposed conc.
  08. Pre-manuf. stone cap
  09. Downspout
  10. Gutter
  11. Pre-cast Conc. Downspout
  12. Window Assembly
  13. Skylight Assembly
  14. Door Assembly
  15. Light Fixture

2 EAST EXTERIOR ELEVATION  
 3/16" = 1'- 0" (half size: 3/32" = 1' - 0")

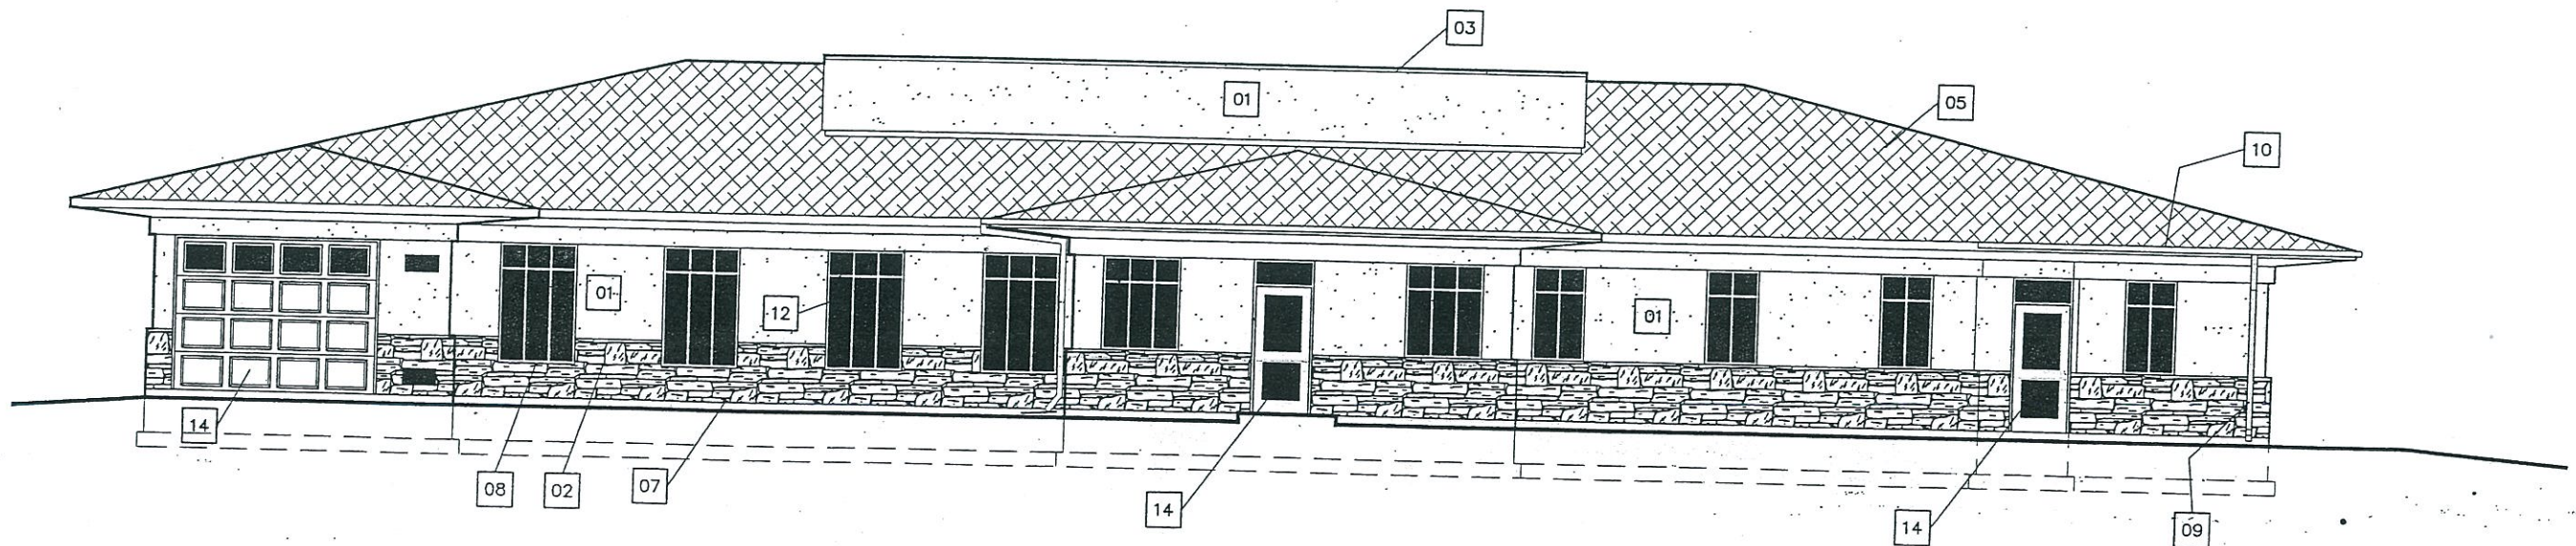


1 NORTH EXTERIOR ELEVATION  
 3/16" = 1'- 0" (half size: 3/32" = 1' - 0")

	<b>Medical Design Group</b> Architecture for Health Care 2716 WESTLAND PLACE BOISE, IDAHO 83704-5863 BOISEARCHITECT@AOL.COM Fax (208) 378-1405 Phone (208) 378-0817	
	© COPYRIGHT: MEDICAL DESIGN GROUP	
REGISTERED ARCHITECT No. AR-1746 19 March 2004 	<b>EXTERIOR ELEVATIONS</b>	
Desert Sage Health Center 2280 American Legion Blvd. Mountain Home, Idaho	SHEET <b>4.10</b>	
Mar 2004	ds410.dwg 03/22/04 10:50	

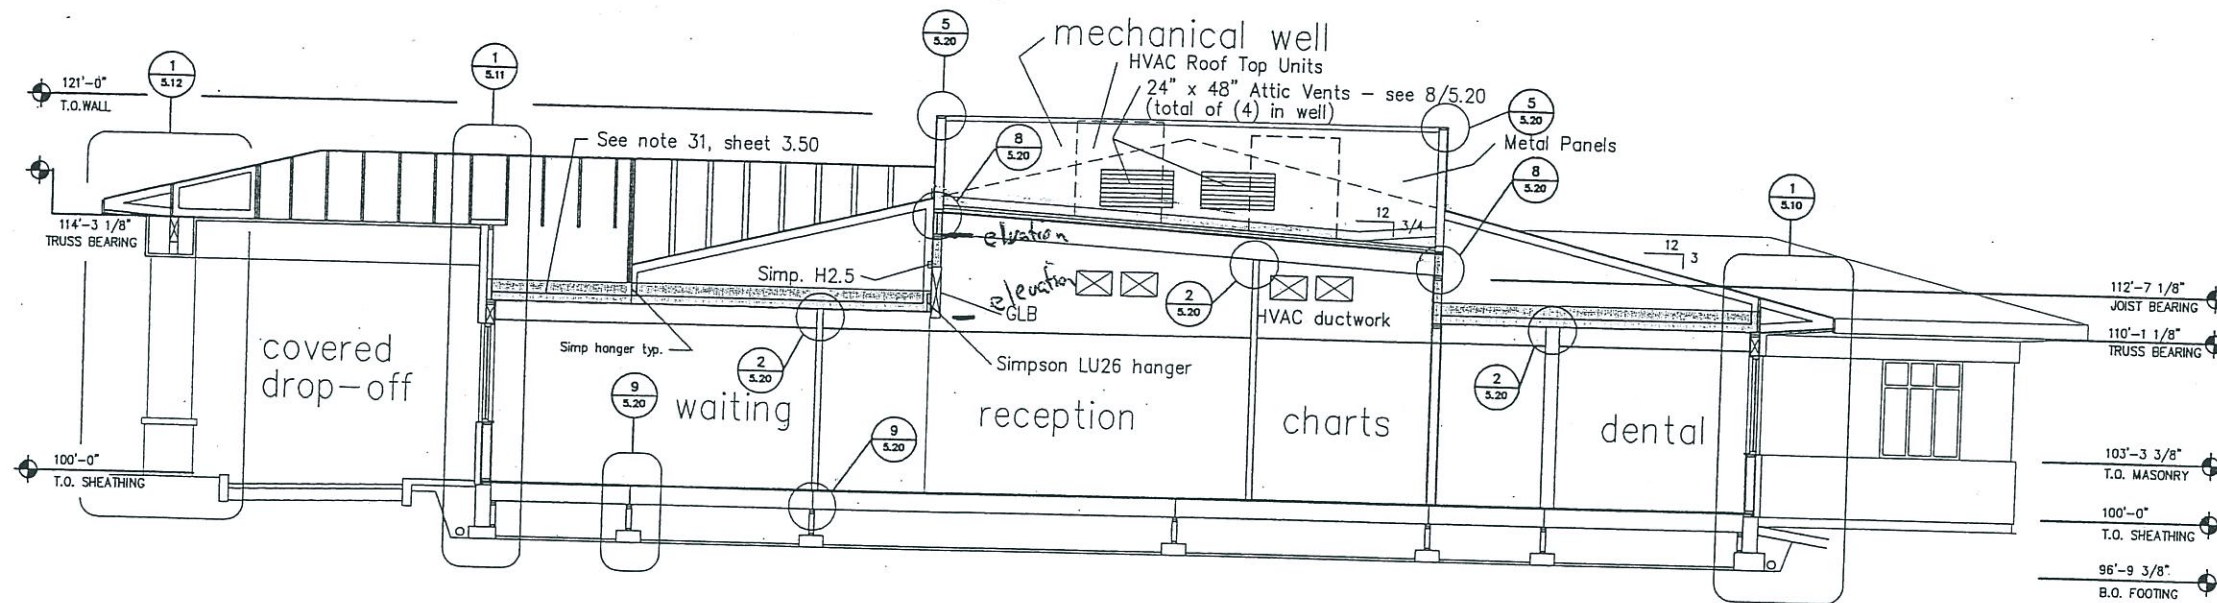

2 Building Section  
 3/16" = 1'-0" (half size: 3/32" = 1'-0")

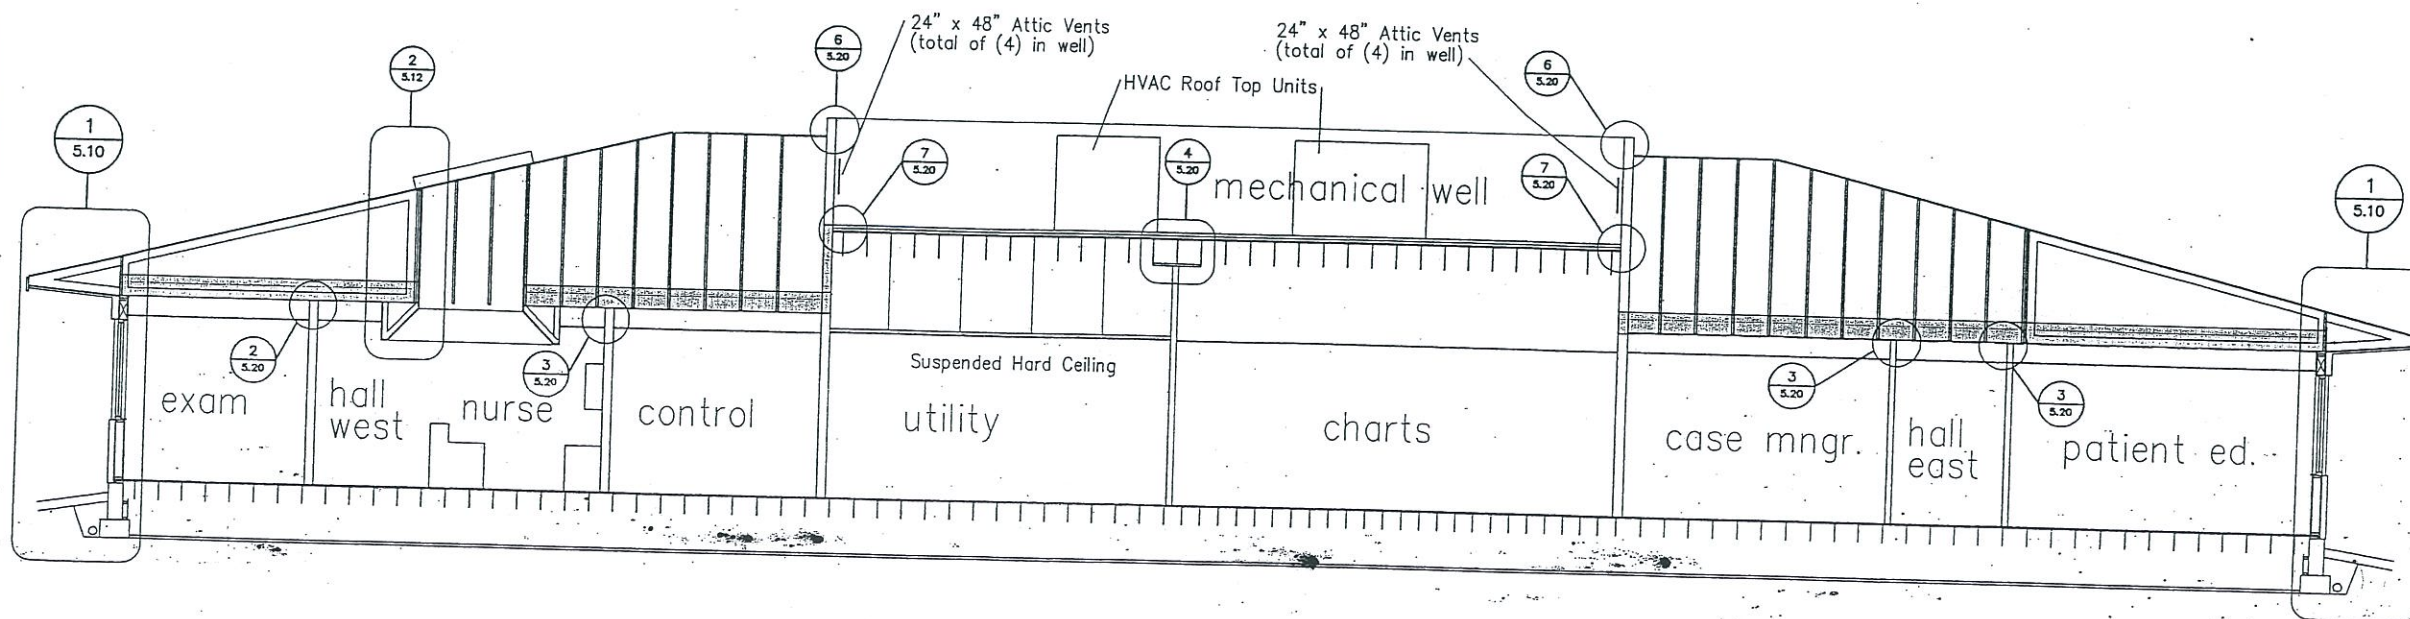

1 Building Section  
 3/16" = 1'-0" (half size: 3/32" = 1'-0")

**Medical Design Group**  
 Architecture for Health Care  
 2716 WESTLAND PLACE  
 BOISE, IDAHO 83704-5863  
 BOISEARCHITECT@AOL.COM  
 Fax (208) 778-1485  
 Phone (208) 378-6819

REGISTERED ARCHITECT  
 No. AR-1740  
 19 March 2004


**BUILDING SECTIONS**

Desert Sage Health Center  
 2280 American Legion Blvd.  
 Mountain Home, Idaho

SHEET  
 5.00


Mar 2004 ds500.dwg 01/31/04 09:16

2:\TEMPLATE\mdg.dwg March 2003

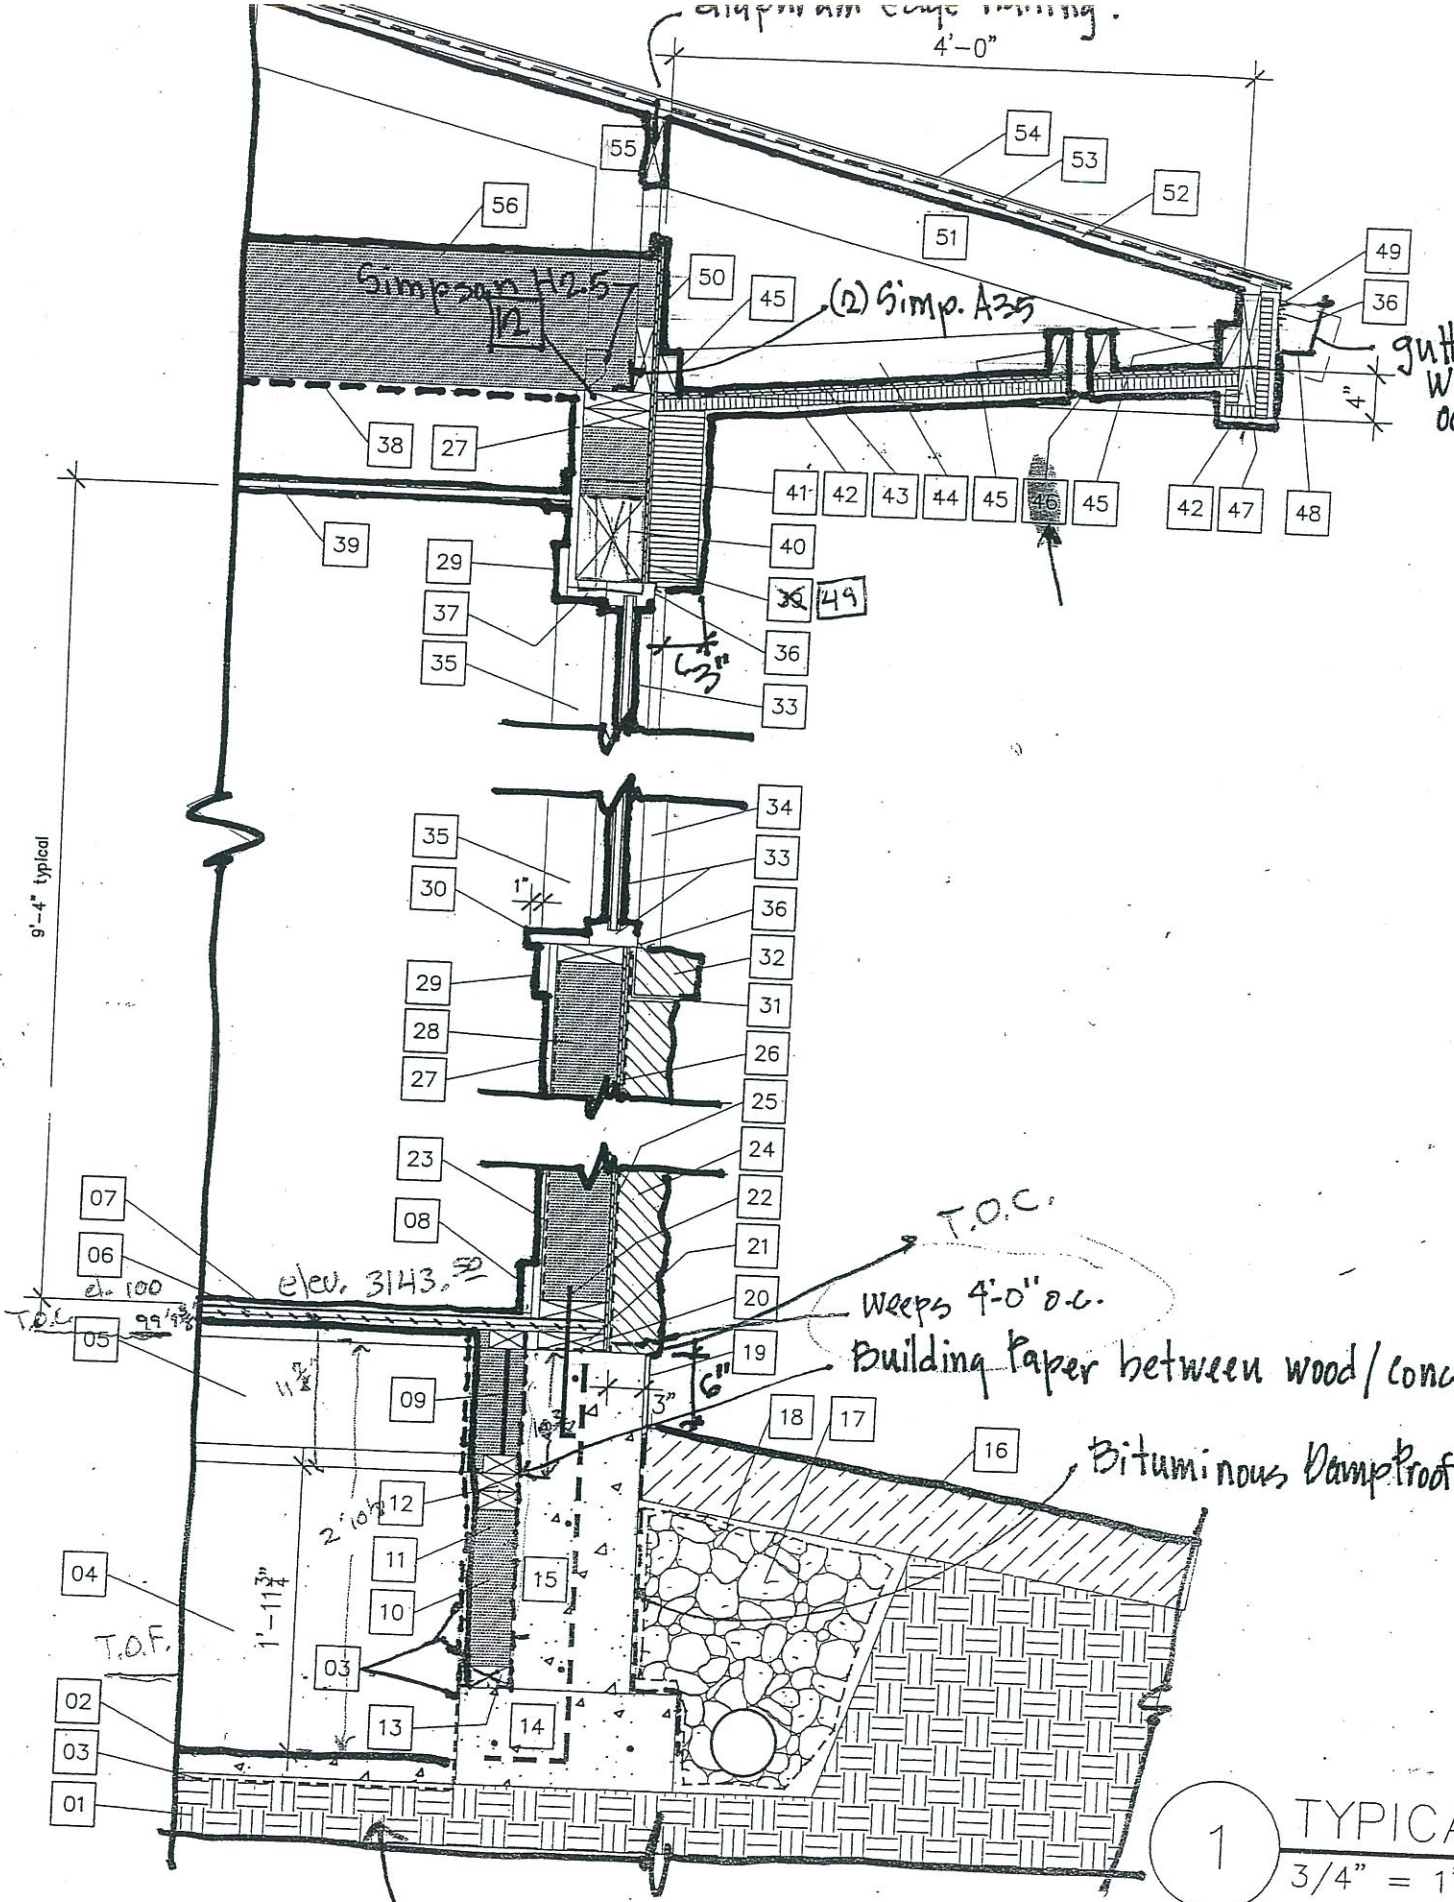

- NUMBERED NOTES:
01. Native Material OR Compacted Suitable Fill (see soils report)
  02. 2" thick Concrete Slab throughout entire crawl space
  03. 10 mil vapor retarder
  04. Crawl Space
  05. Floor Joist Beyond
  06. 1-1/8" Thick Sturdy-Floor T&G Wood Sheathing
  07. Floor Finish as noted. (see specs for req'd underlayment)
  08. Floor Base as noted (either rubber or hardwood)
  09. TJI Blocking
  10. R-13 Min. Batt Insulation with Vapor Retarder shown hatched
  11. 2x4 @ 1'-4" o.c. max.
  12. Double Top Plate
  13. Pressure Treated Bottom Plate
  14. Reinforced Concrete Footing - See sheet 3.10
  15. Reinforced Concrete Foundation Wall - See sheet 3.10
  16. 6" min. top soil - 12" thick at planter beds
  17. 3/4 to 2" drain rock around 4" perforated Foundation Drain
  18. Geotech Filter Wrap to prevent sediment from reaching Perf. Drain Pipe
  19. Stucco Finish Coat on Exposed Portions of the Concrete
  20. Sill Sealer
  21. Pressure Treated 2x6 Mud Sill
  22. Anchor Bolt - spacing per shear wall schedule - sheet 3.04  
Place additional anchor bolts within 6" of the end of each 2x sill member.
  23. Continuous Vapor Retarder
  24. Cultured Stone Veneer over Lath
  25. Weather Resistant Barrier (Tyvek)
  26. Wall Sheathing
  27. 5/8" Type "X" Gypsum Board
  28. 2x6 studs at 1'-4" o.c. max.
  29. 1x4 Hardwood Trim
  30. Sill
  31. 2 1/2 x 2 1/2 x 16 gauge sheet metal ledger for stone sill
  32. Cultured Stone Sill over lath onto ledger
  33. Aluminum window System
  34. Stucco system beyond
  35. Hardwood Casing beyond
  36. Caulking
  37. 1x Hardwood Window Casing
  38. Foil-Scrim-Kraft Vapor Retarder - seal all penetrations.
  39. Acoustical Lay-in Ceiling and Metal Grid Assembly
  40. Wood Header - See sheet 3.50
  41. Stucco Assembly with 4" Poly-iso
  42. Stucco Assembly with 1" Poly-iso
  43. Wall Sheathing
  44. 2x4 Framing to match truss spacing
  45. 2x4 Blocking
  46. 2" wide continuous galv. metal screen vent
  47. 2x10 sub-fascia member
  48. Cut Truss tails in the field
  49. Drip-edge flashing
  50. Extend Wall Sheathing up to baffle Roof Insulation
  51. Pre-manufactured Pre-engineered Wood Trusses beyond
  52. Roof sheathing
  53. Ice and Water-shield Membrane
  54. Roofing Finish Material (see alternates) over building paper
  55. Pre-manufactured Pre-Engineered Truss Blocking Panel (600 lb Axial Load) w/ (2) Simp. A35 clips each panel.
  56. Attic Insulation

1 TYPICAL WALL SECTION  
3/4" = 1'-0"



**Medical Design Group**  
Architecture for Health Care

2716 WESTLAND PLACE  
BOISE, IDAHO 83704-5863

BOISEARCHITECT@AOL.COM  
Fax (208) 378-1405  
Phone (208) 378-0817

© COPYRIGHT: MEDICAL DESIGN GROUP

---

REGISTERED ARCHITECT  
No. AR-1740  
14 Feb 2004

DAVID R. DAVES  
STATE OF IDAHO


---

WALL SECTIONS

Desert Sage Health Center 2280 American Legion Blvd. Mountain Home, Idaho	SHEET <b>5.10</b>
---	----------------------

Feb 2004 ds510.dwg 01/29/04 14:45

DATE: 01/29/04 14:45

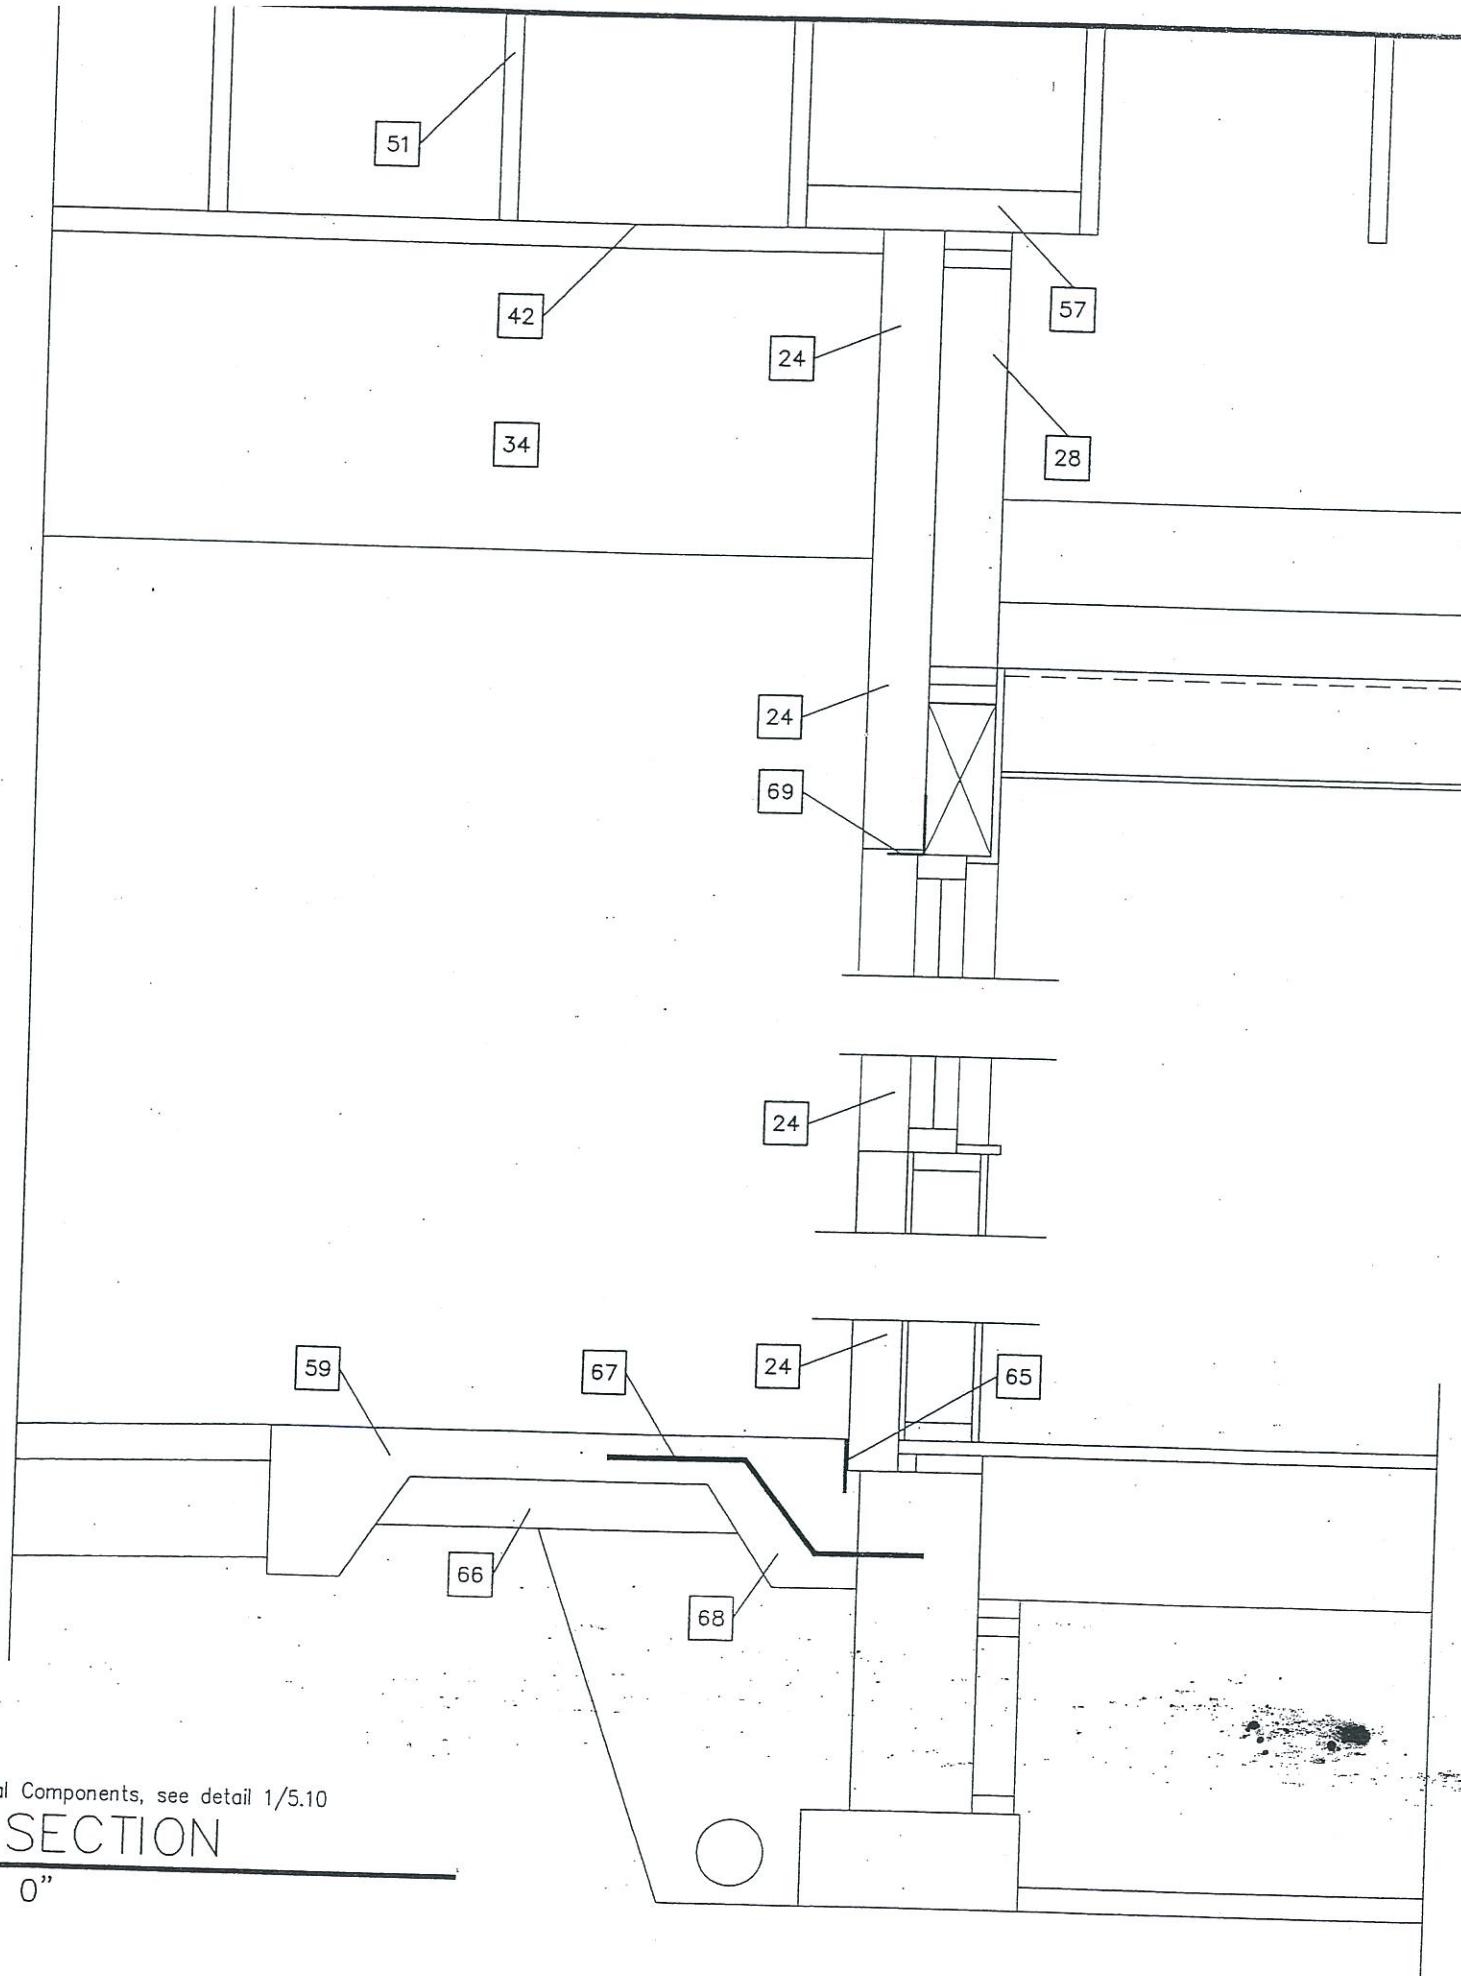


NUMBERED NOTES:

01. Native Material OR Compacted Suitable Fill (see soils report)
02. 2" thick Concrete Slab throughout entire crawl space
03. 10 mil vapor retarder
04. Crawl Space
05. Floor Joist Beyond
06. 1-1/8" Thick Sturdy-Floor T&G Wood Sheathing
07. Floor Finish as noted. (see specs for req'd underlayment)
08. Floor Base as noted (either rubber or hardwood)
09. TJI Blocking
10. R-13 Min. Batt Insulation with Vapor Retarder shown hatched
11. 2x4 @ 1'-4" o.c. max.
12. Double Top Plate
13. Pressure Treated Bottom Plate
14. Reinforced Concrete Footing - See sheet 3.10
15. Reinforced Concrete Foundation Wall - See sheet 3.10
16. 6" min. top soil - 12" thick at planter beds
17. 3/4 to 2" drain rock around 4" perforated Foundation Drain
18. Geotech Filter Wrap to prevent sediment fra reaching Perf. Drain Pipe
19. Stucco Finish Coat on Exposed Portions of the Concrete
20. Sill Sealer
21. Pressure Treated 2x6 Mud Sill
22. Anchor Bolt - spacing per shear wall schedule - sheet 3.04  
Place additional anchor bolts within 6" of the end of each 2x sill member.
23. Continuous Vapor Retarder
24. Cultured Stone Veneer over Lath
25. Weather Resistant Barrier (Tyvek)
26. Wall Sheathing
27. 5/8" Type "X" Gypsum Board
28. 2x6 studs at 1'-4" o.c. max.
29. 1x4 Hardwood Trim
30. 1x Hardwood Sill
31. 2 1/2 x 2 1/2 x 16 gauge sheet metal ledger for stone sill
32. Cultured Stone Sill over lath onto ledger
33. Aluminum window System
34. Stucco system beyond
35. Hardwood Casing beyond
36. Caulking
37. 1x Hardwood Window Casing
38. Foil-Scrim-Kraft Vapor Retarder - seal all penetrations.
39. Acoustical Lay-in Ceiling and Metal Grid Assembly
40. Wood Header - See sheet 3.50
41. Stucco Assembly with 4" Poly-iso
42. Stucco Assembly with 1" Poly-iso
43. Wall Sheathing
44. 2x4 Framing to match truss spacing
45. 2x4 Blocking
46. 2" wide min. continuous galv. metal screen vent
47. 2x10 sub-fascia member
48. Cut Truss tails in the field
49. Drip-edge flashing
50. Extend Wall Sheathing up to baffle Roof Insulation
51. Pre-manufactured Pre-engineered Wood Trusses beyond
52. Roof sheathing
53. Ice and Water shield Membrane
54. Roofing Finish Material (see alternates) over building paper
55. Pre-manufactured Pre-Engineered Truss Blocking Panel
56. Attic Insulation
57. 2x4 blocking 2'-0" o.c. max. between trusses
58. 2x4 @ 1'-4" o.c. max. pony wall
59. Concrete Sidewalk
60. 2x4 framing - match truss spacing
61. Beam - See structural
62. Skylight and curb assembly
63. Exposed to view truss - paint
64. Painted Gypsum Board Beyond
65. 1/4" thick control joint with caulking
66. Crushed Rock Base - see civil
67. #4 Bent Bars at 2'-0" o.c. max. with 6" min. embed into conc. foundation wall where sidewalk abuts building
68. Thicken Concrete at bent bar locations
69. 3 x 5 x 3/8" min. Steel Ledger with 3/8" x 4" Lag Bolts into wood header member at 2'-0" o.c. max.
70. 3 1/2" light gauge metal framing attached to trusses

Note: For Typical Components, see detail 1/5.10

WALL SECTION


3/4" = 1'-0"

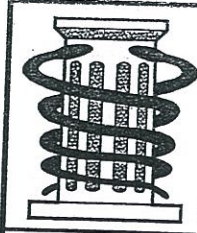

Medical Design Group  
Architecture for Health Care

2716 WESTLAND PLACE  
BOISE, IDAHO 83704-5863  
BOISEARCHITECT@AOL.COM  
Fax (208) 378-1405  
Phone (208) 378-0817

© COPYRIGHT: MEDICAL DESIGN GROUP

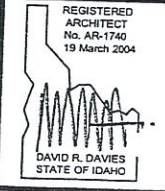


WALL SECTIONS

Desert Sage Health Center  
2280 American Legion Blvd.  
Mountain Home, Idaho

SHEET  
5.11

Mar 2004 ds511.dwg 03/22/04 11:22

Z:\EMPL\AIE\mtdg.dwg March 2003

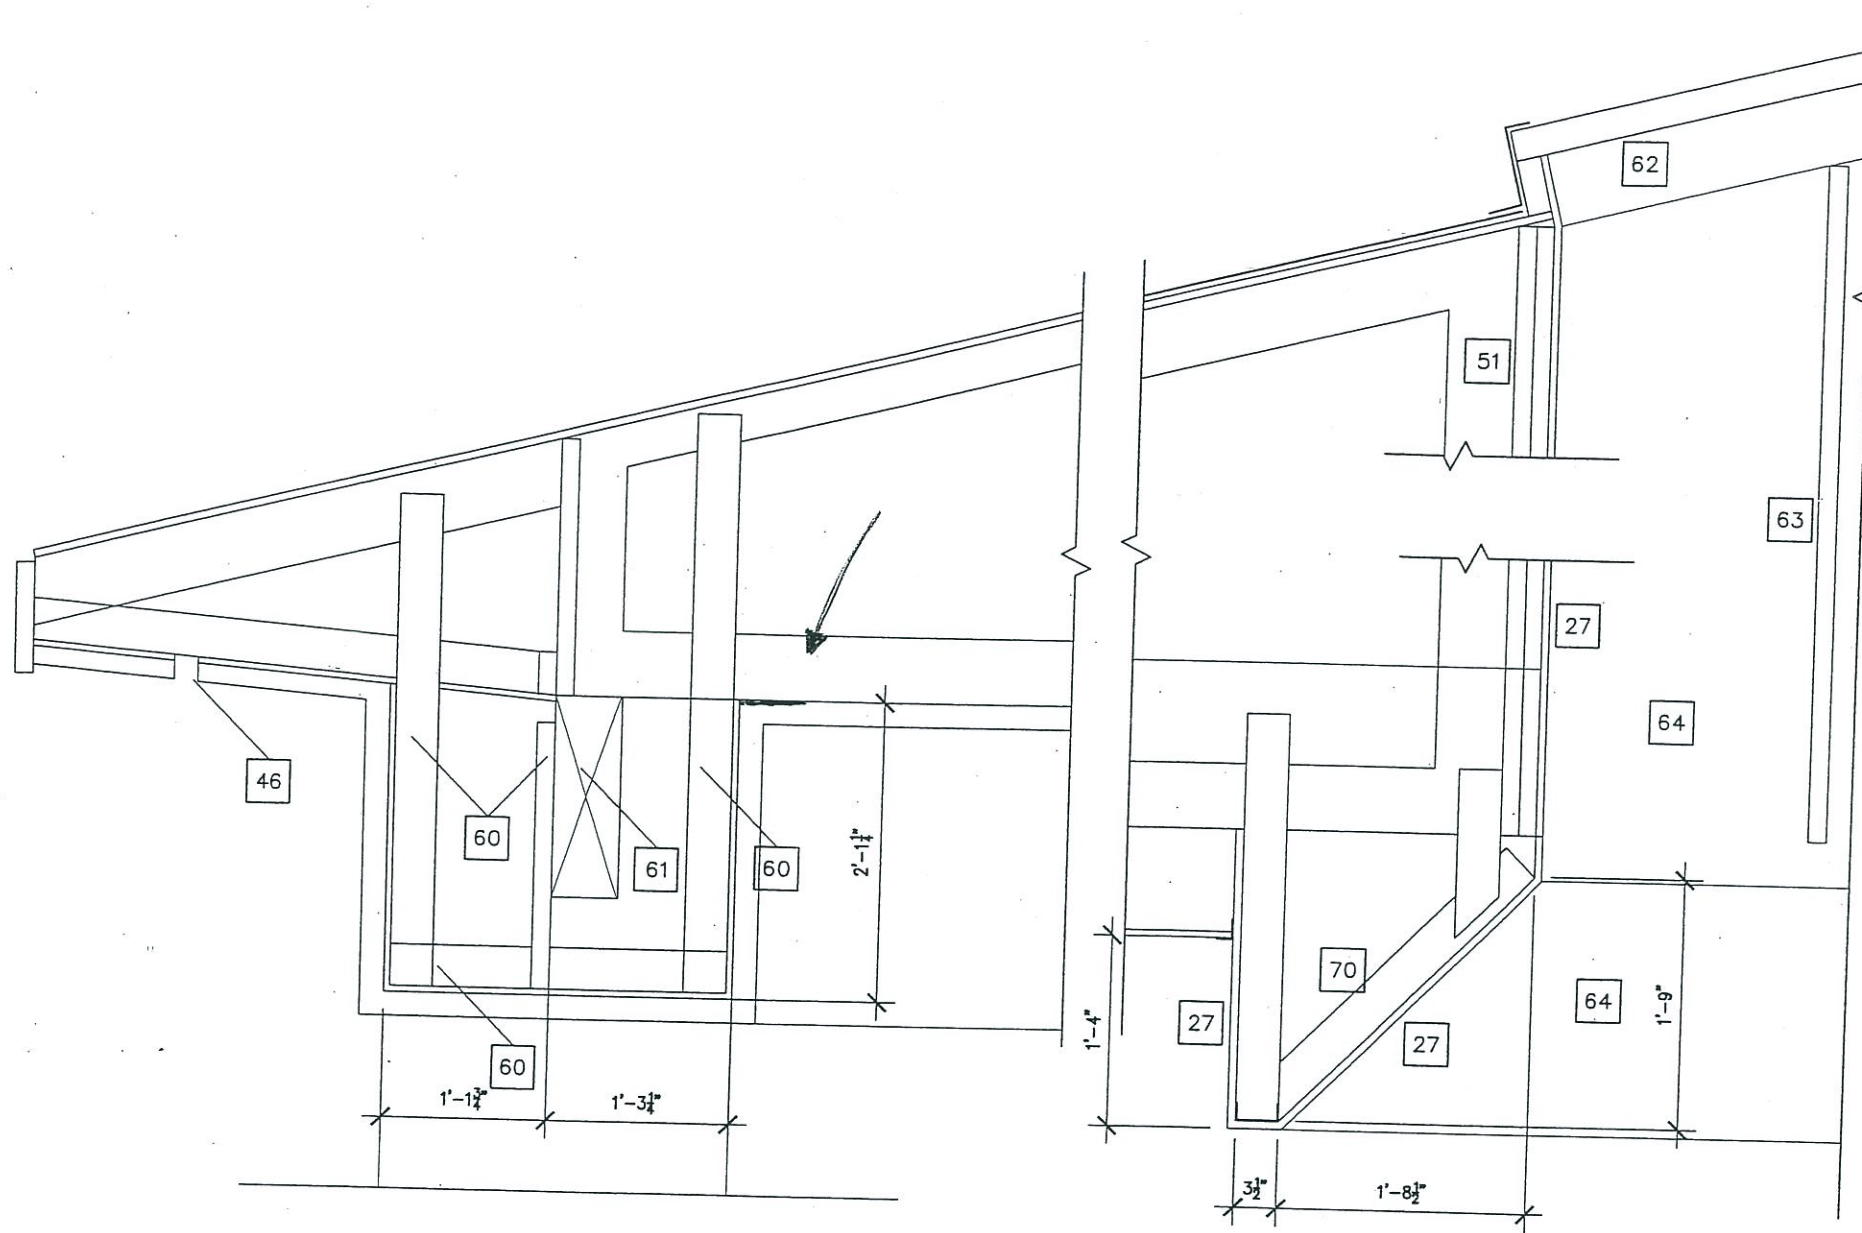

NUMBERED NOTES:


01. Native Material OR Compacted Suitable Fill (see soils report)
02. 2" thick Concrete Slab throughout entire crawl space
03. 10 mil vapor retarder
04. Crawl Space
05. Floor Joist Beyond
06. 1-1/8" Thick Sturdy-Floor T&G Wood Sheathing
07. Floor Finish as noted. (see specs for req'd underlayment)
08. Floor Base as noted (either rubber or hardwood)
09. TJI Blocking
10. R-13 Min. Batt Insulation with Vapor Retarder shown hatched
11. 2x4 @ 1'-4" o.c. max.
12. Double Top Plate
13. Pressure Treated Bottom Plate
14. Reinforced Concrete Footing - See sheet 3.10
15. Reinforced Concrete Foundation Wall - See sheet 3.10
16. 6" min. top soil - 12" thick at planter beds
17. 3/4 to 2" drain rock around 4" perforated Foundation Drain
18. Geotech Filter Wrap to prevent sediment fro reaching Perf. Drain Pipe
19. Stucco Finish Coat on Exposed Portions of the Concrete
20. Sill Sealer
21. Pressure Treated 2x6 Mud Sill
22. Anchor Bolt - spacing per shear wall schedule - sheet 3.04  
Place additional anchor bolts within 6" of the end of each 2x sill member.
23. Continuous Vapor Retarder
24. Cultured Stone Veneer over Lath
25. Weather Resistant Barrier (Tyvek)
26. Wall Sheathing
27. 5/8" Type "X" Gypsum Board
28. 2x6 studs at 1'-4" o.c. max.
29. 1x4 Hardwood Trim
30. 1x Hardwood Sill
31. 2 1/2 x 2 1/2 x 16 gauge sheet metal ledger for stone sill
32. Cultured Stone Sill over lath onto ledger
33. Aluminum window System
34. Stucco system beyond
35. Hardwood Casing beyond
36. Caulking
37. 1x Hardwood Window Casing
38. Foil-Scrim-Kraft Vapor Retarder - seal all penetrations.
39. Acoustical Lay-in Ceiling and Metal Grid Assembly
40. Wood Header - See sheet 3.50
41. Stucco Assembly with 4" Poly-iso
42. Stucco Assembly with 1" Poly-iso
43. Wall Sheathing
44. 2x4 Framing to match truss spacing
45. 2x4 Blocking
46. 2" wide min. continuous galv. metal screen vent
47. 2x10 sub-fascia member
48. Cut Truss tails in the field
49. Drip-edge flashing
50. Extend Wall Sheathing up to baffle Roof Insulation
51. Pre-manufactured Pre-engineered Wood Trusses beyond
52. Roof sheathing
53. Ice and Water shield Membrane
54. Roofing Finish Material (see alternates) over building paper
55. Pre-manufactured Pre-Engineered Truss Blocking Panel
56. Attic Insulation
57. 2x4 blocking 2'-0" o.c. max. between trusses
58. 2x4 @ 1'-4" o.c. max. pony wall
59. Concrete Sidewalk
60. 2x4 framing - match truss spacing
61. Beam - See structural
62. Skylight and curb assembly
63. Exposed to view truss - paint
64. Painted Gypsum Board Beyond
65. 1/4" thick control joint with caulking
66. Crushed Rock Base - see civil
67. #4 Bent Bars at 2'-0" o.c. max. with 6" min. embed into conc. foundation wall where sidewalk abuts building
68. Thicken Concrete at bent bar locations
69. 3 x 5 x 3/8" min. Steel Ledger with 3/8" x 4" Lag Bolts into wood header member at 2'-0" o.c. max.
70. 3 1/2" light gauge metal framing attached to trusses

Note: For Typical Components, see detail 1/5.10

1 WALL SECTION  
3/4" = 1'-0"

Note: For Typical Components, see detail 1/5.10

2 WALL SECTION  
3/4" = 1'-0"

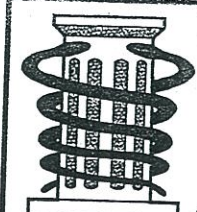

**Medical Design Group**  
Architecture for Health Care

2716 WESTLAND PLACE  
BOISE, IDAHO 83704-5863

BOISEARCHITECT@AOL.COM  
Fax (208) 378-1405  
Phone (208) 378-0817

© COPYRIGHT: MEDICAL DESIGN GROUP

---

REGISTERED ARCHITECT  
No. AR-1740  
19 March 2004

DAVID R. DAVIES  
STATE OF IDAHO

---

**WALL SECTIONS**








Desert Sage Health Center  
2280 American Legion Blvd.  
Mountain Home, Idaho

SHEET  
**5.12**

---

Mar 2004 ds512.dwg 03/22/04 11:38

Z:\TEMPLATE\mdg.dwg March 2003

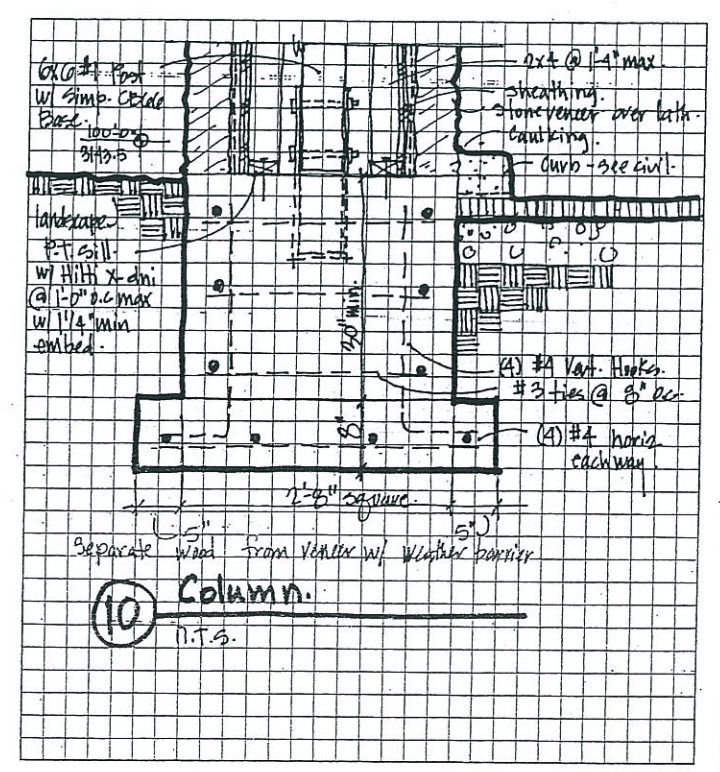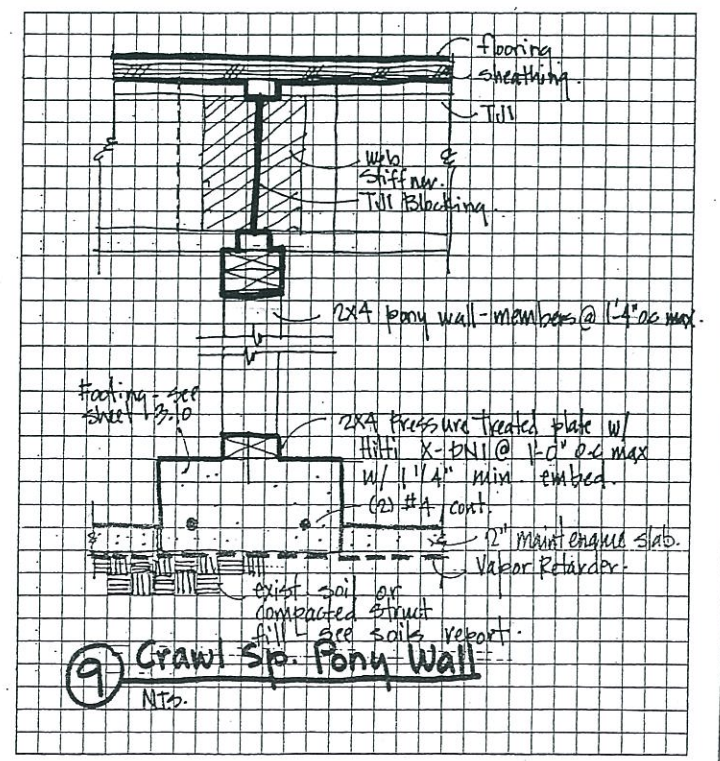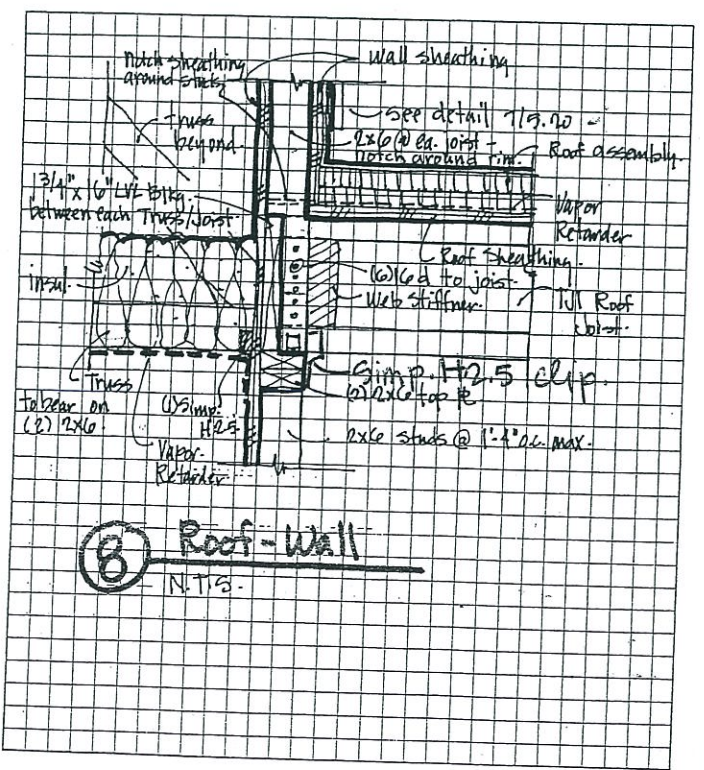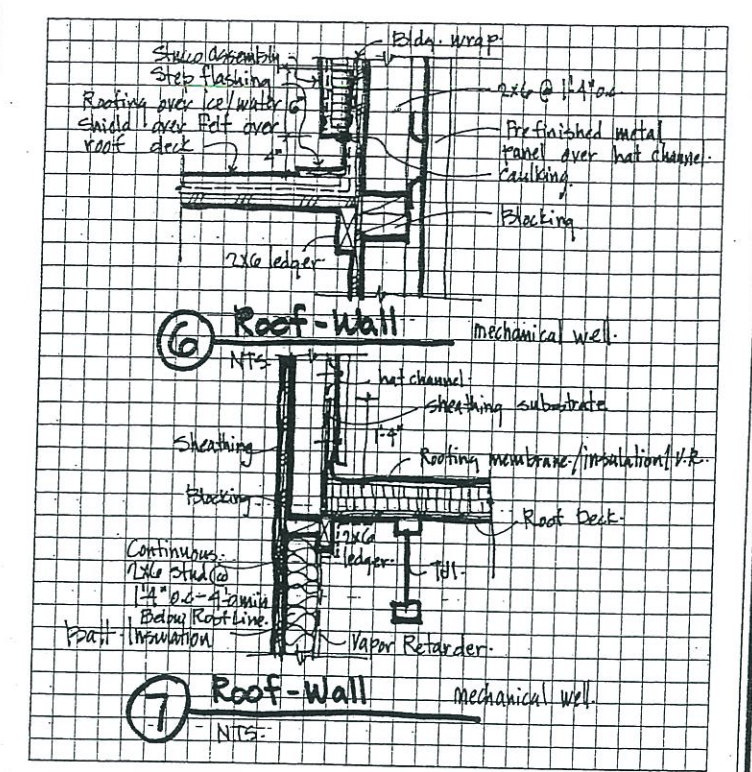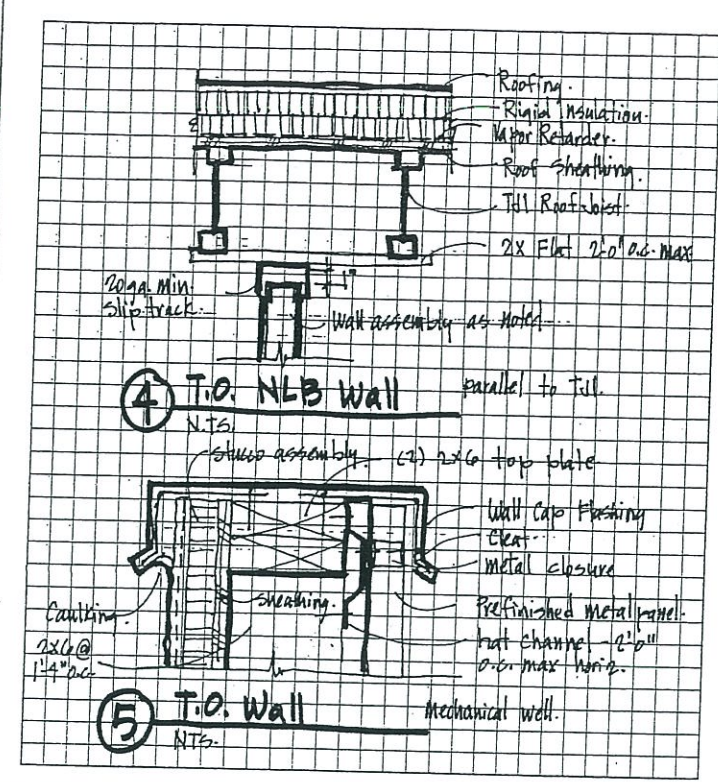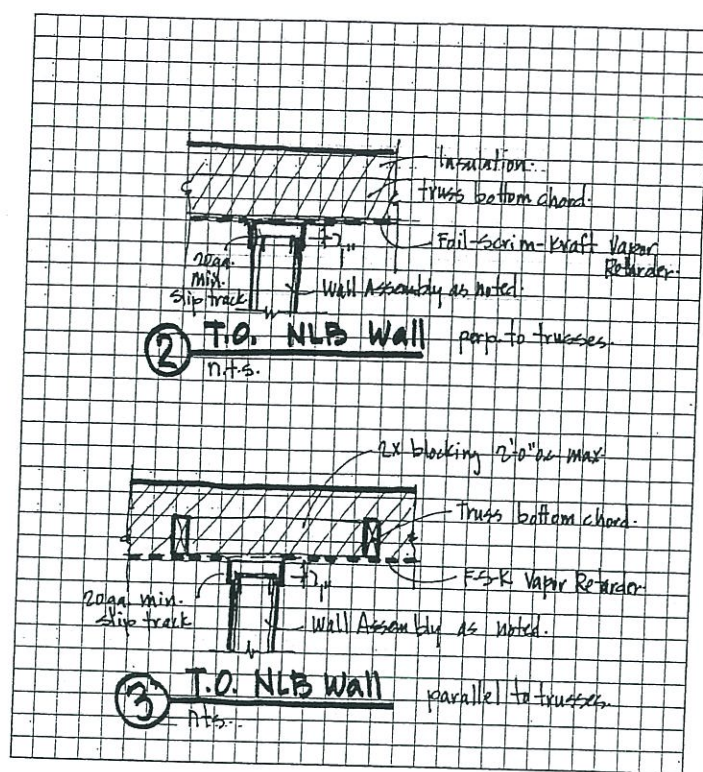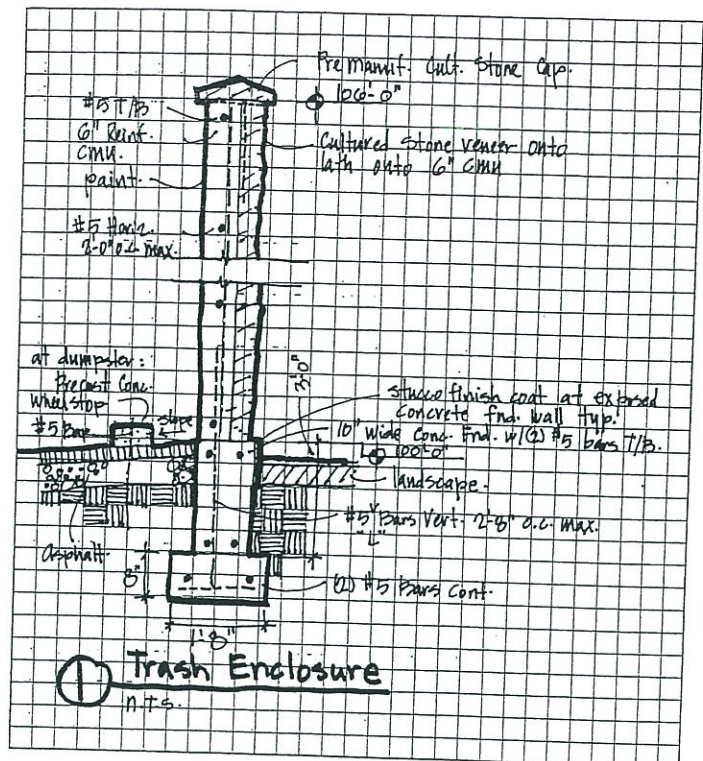

**Medical Design Group**  
 Architecture for Health Care  
 2716 WESTLAND PLACE  
 BOISE, IDAHO 83704-5863  
 BOISEARCHITECT@AOL.COM  
 Fax (208) 378-1405  
 Phone (208) 378-0817

© COPYRIGHT: MEDICAL DESIGN GROUP

REGISTERED ARCHITECT  
 No. AR-1740  
 19 March 2004






**DETAILS**

Desert Sage Health Center  
 2280 American Legion Blvd.  
 Mountain Home, Idaho

SHEET  
 5.20

Mar 2004 ds520.dwg 03/22/04 11:35

C:\Users\james\Documents\Architectural\2\TEMPLATE\mdg.dwg March 2003

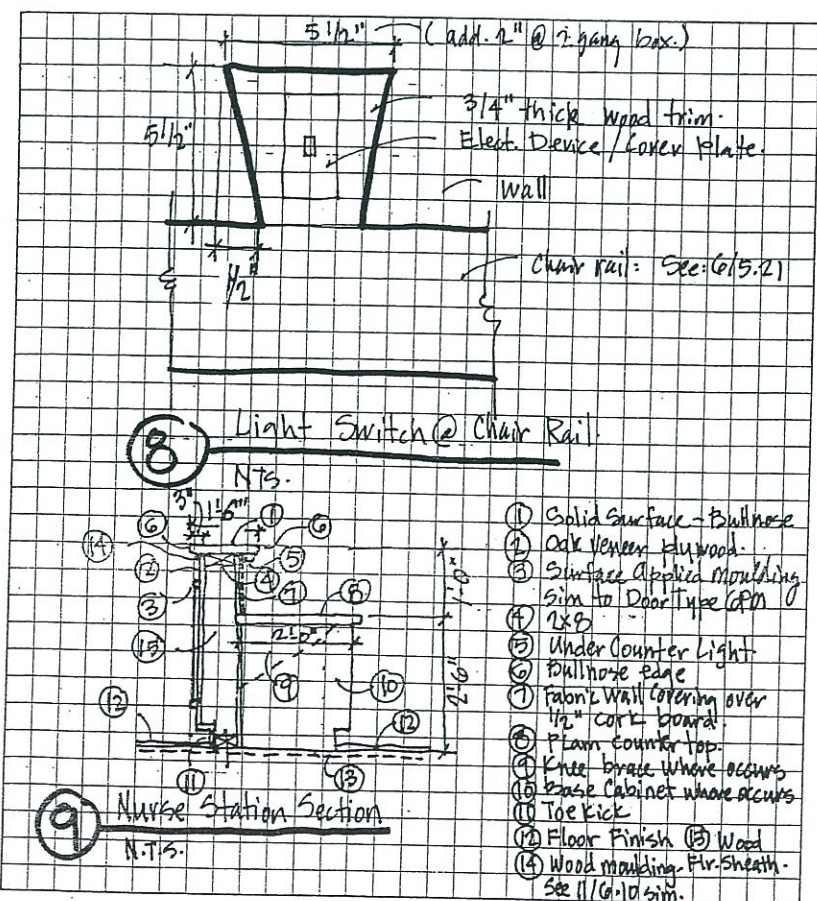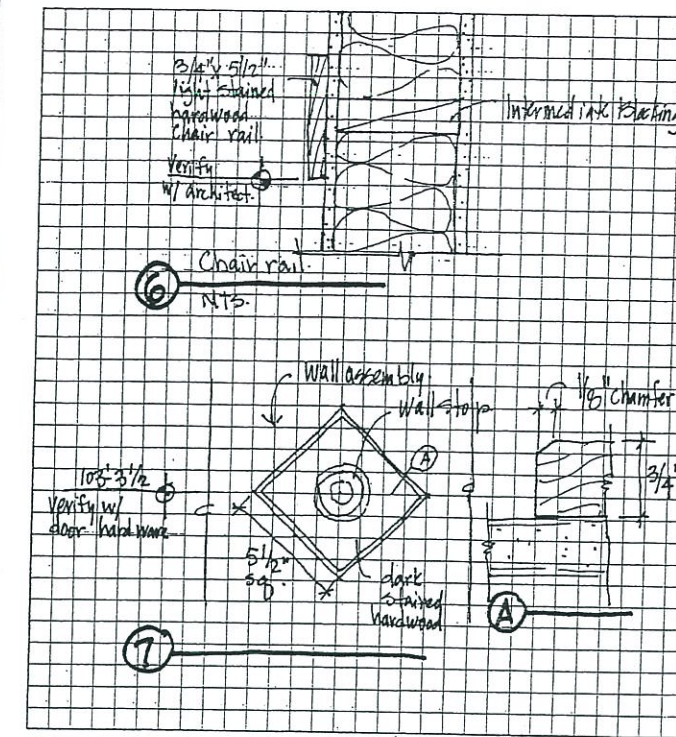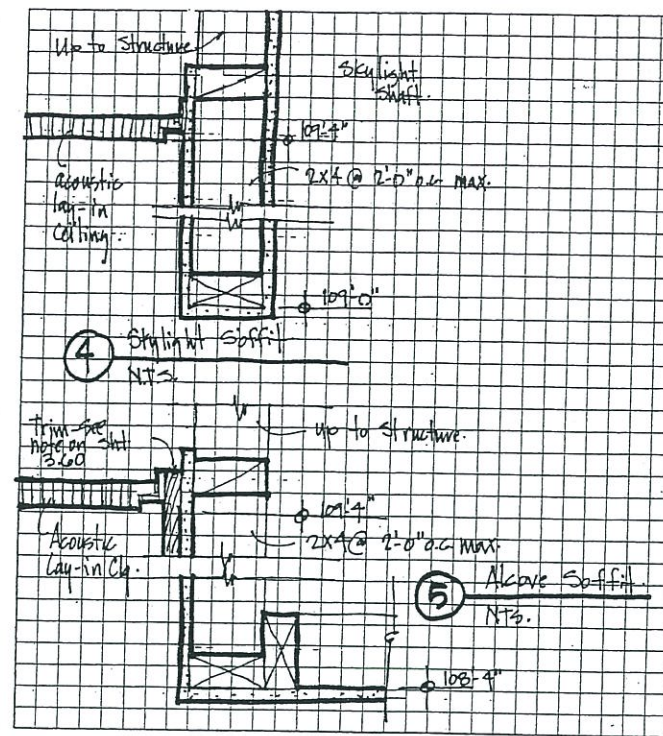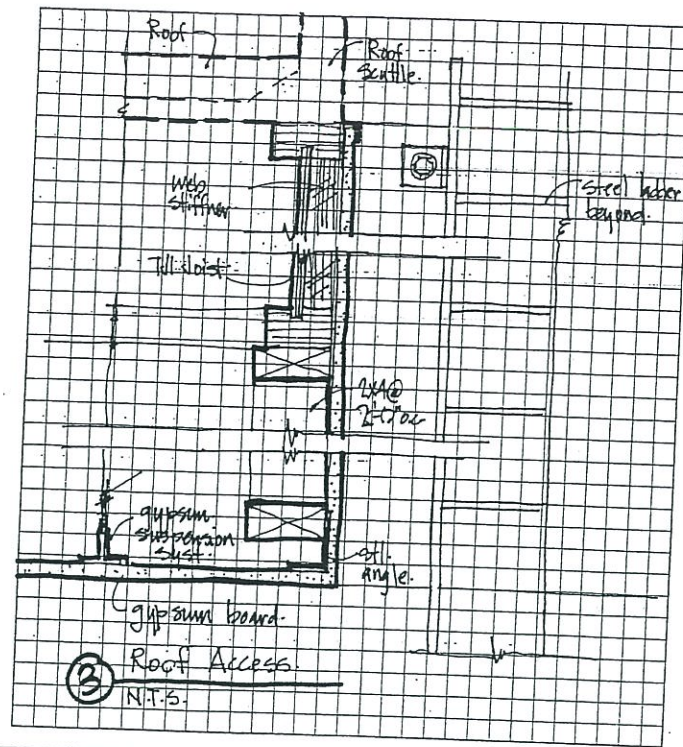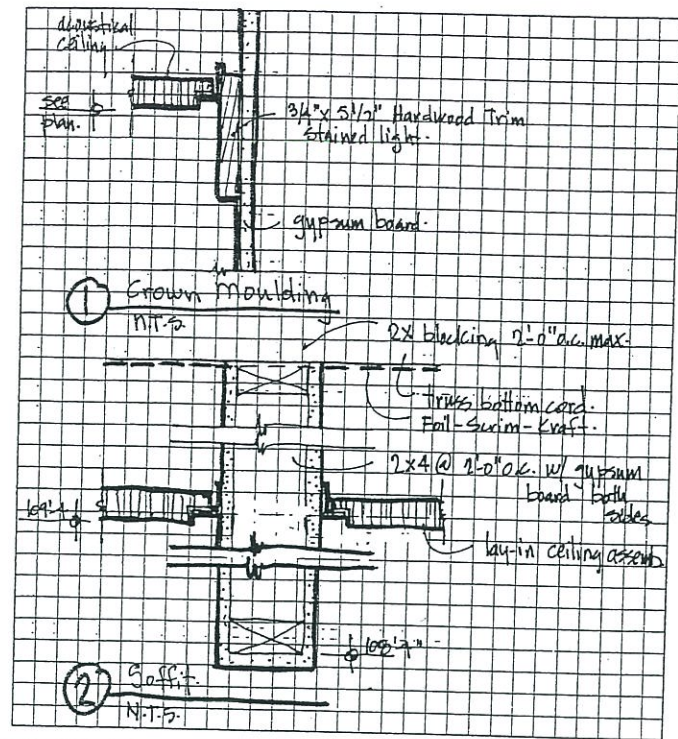

- ① Solid Surface - Bullnose
- ② Oak Veneer Plywood
- ③ Surface Applied Moulding
- ④ Sim to Door Type (PM)
- ⑤ 2x2
- ⑥ Under Counter Light
- ⑦ Bullnose Edge
- ⑧ Fabric Wall covering over 1/2\"/>
- ⑨ Plain counter top
- ⑩ Knee brace where occurs
- ⑪ Base Cabinet where occurs
- ⑫ Toe Kick
- ⑬ Floor Finish
- ⑭ Wood
- ⑮ Wood moulding Fir Sheath
- See 11/G-10 sim.

**Medical Design Group**  
 Architecture for Health Care  
 2716 WESTLAND PLACE  
 BOISE, IDAHO 83704-5863  
 BOISEARCHITECT@AOL.COM  
 Fax (208) 378-1405  
 Phone (208) 378-0817

REGISTERED ARCHITECT  
 No. AR-1740  
 19 March 2004


DAVID R. DAVIES  
 STATE OF IDAHO

DETAILS


Desert Sage Health Center  
 2280 American Legion Blvd.  
 Mountain Home, Idaho

SHEET  
 5.21


Mar 2004

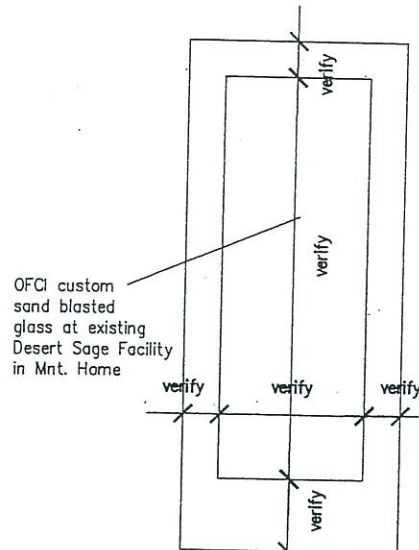


**FG** Door Type  
 $3/4" = 1'-0"$  (half size:  $3/8" = 1'-0"$ )

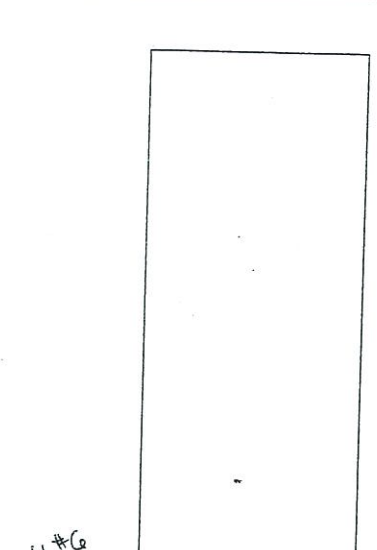


**F** Door Type  
 $3/4" = 1'-0"$  (half size:  $3/8" = 1'-0"$ )

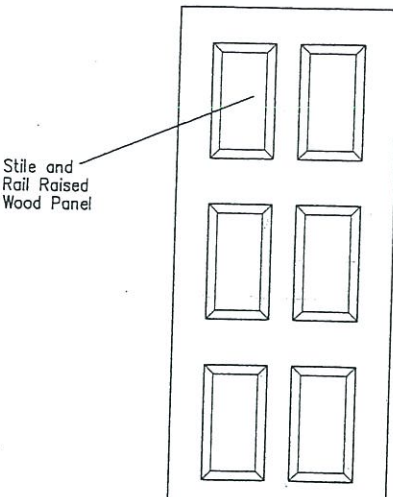


**6P** Door Type  
 $3/4" = 1'-0"$  (half size:  $3/8" = 1'-0"$ )

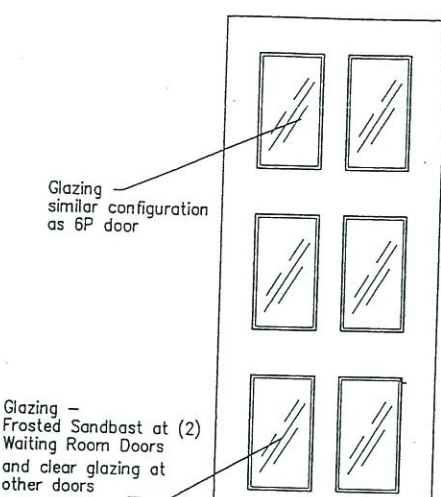


**6PG** Door Type  
 $3/4" = 1'-0"$  (half size:  $3/8" = 1'-0"$ )

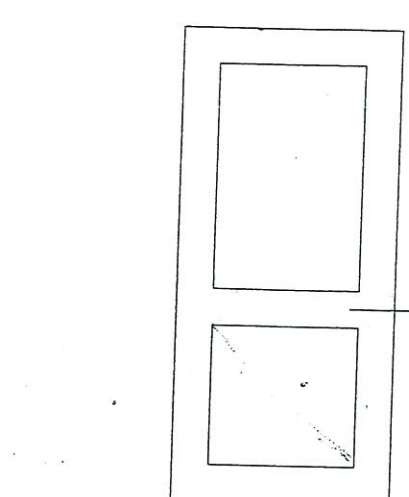


**2H** Door Type  
 $3/4" = 1'-0"$  (half size:  $3/8" = 1'-0"$ )

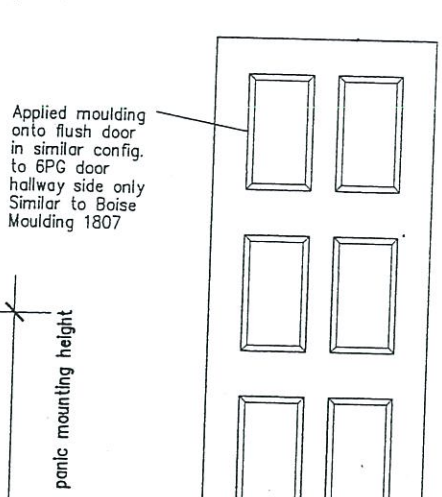


**6PM** Door Type  
 $3/4" = 1'-0"$  (half size:  $3/8" = 1'-0"$ )

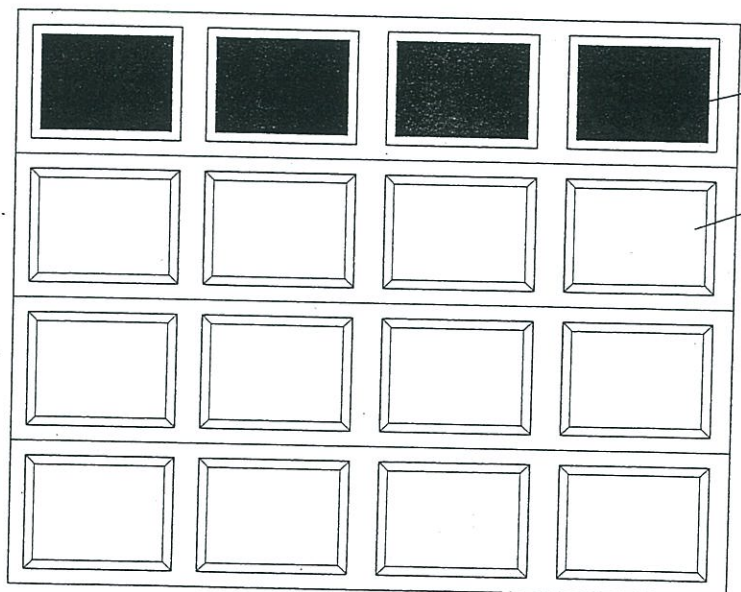

**G** Door Type  
 $3/4" = 1'-0"$  (half size:  $3/8" = 1'-0"$ )

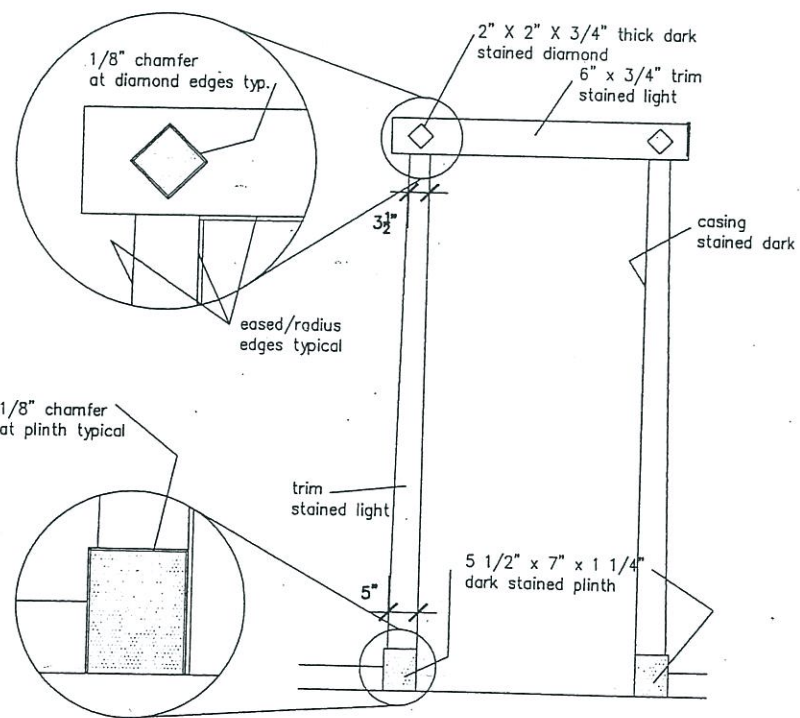

**A** Frame Type  
 $3/4" = 1'-0"$  (half size:  $3/8" = 1'-0"$ )

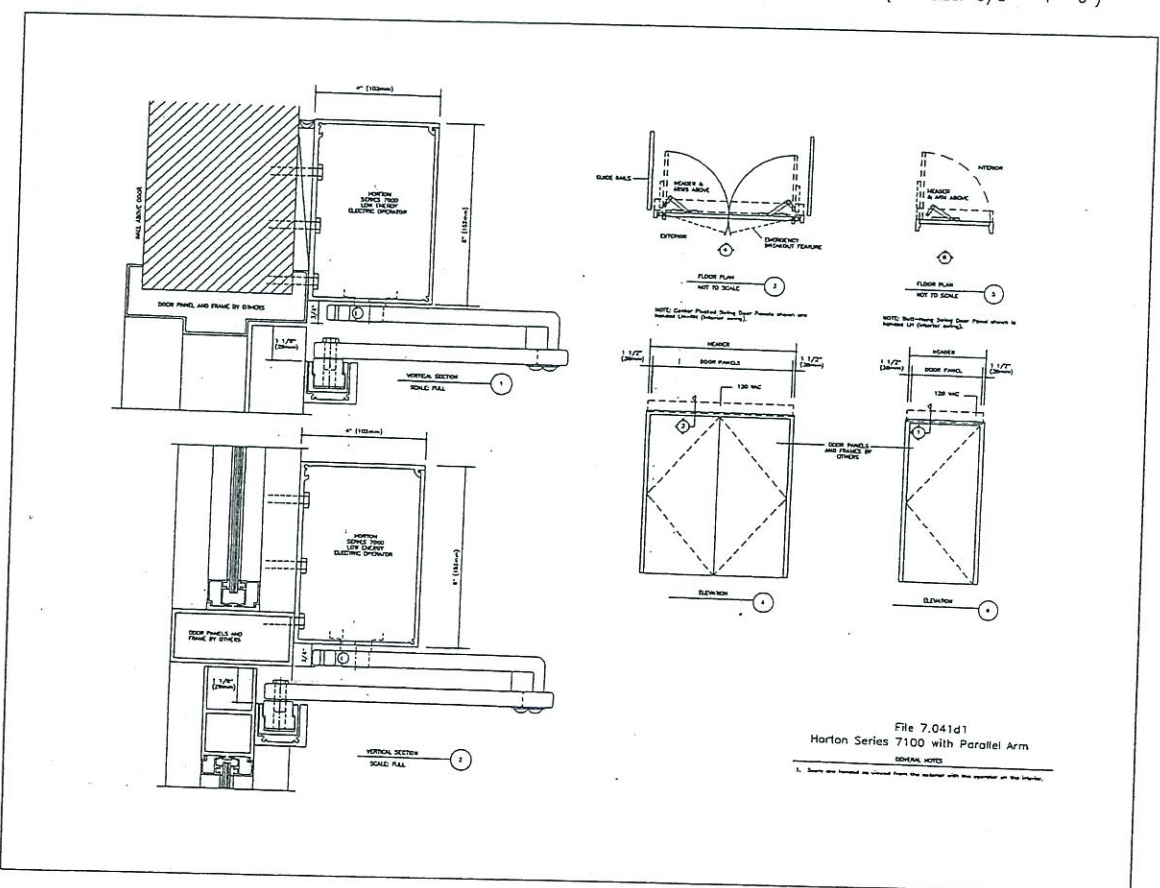

**1** Power Assist Door Detail  
 NTS

**Medical Design Group**  
 Architecture for Health Care  
 2716 WESTLAND PLACE  
 BOISE, IDAHO 83704-5863  
 BOISEARCHITECT@AOL.COM  
 Fax (208) 378-1405  
 Phone (208) 378-0817

REGISTERED ARCHITECT  
 No. AR-1740  
 19 March 2004


DOOR/FRAME TYPES

Desert Sage Health Center  
 2280 American Legion Blvd.  
 Mountain Home, Idaho


SHEET  
 6.00

Mar 2004 ds600.dwg 03/22/04 12:13




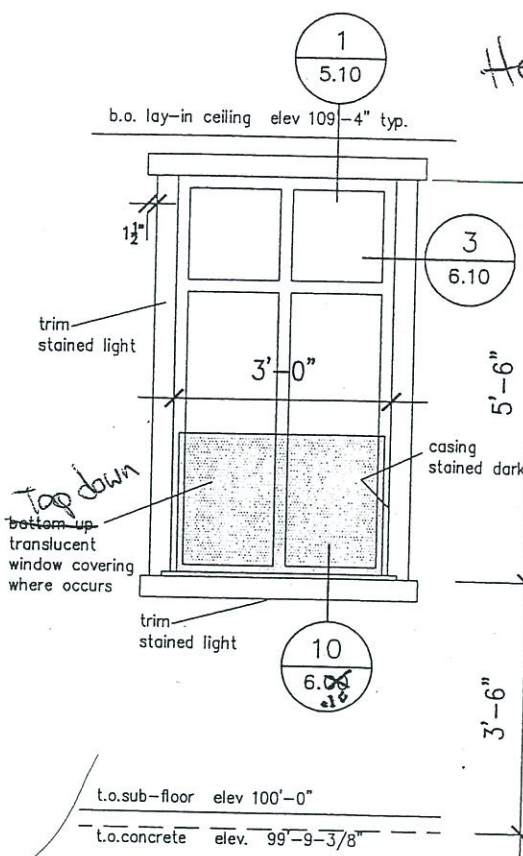


**A Window Type**  
 3/4" = 1'-0" (half size: 3/8" = 1'-0")

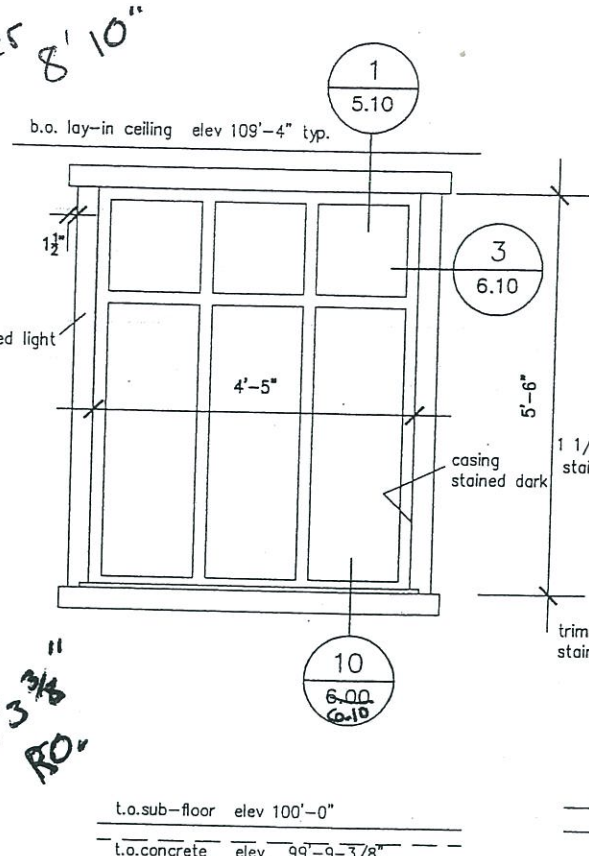


**B Window Type**  
 3/4" = 1'-0" (half size: 3/8" = 1'-0")

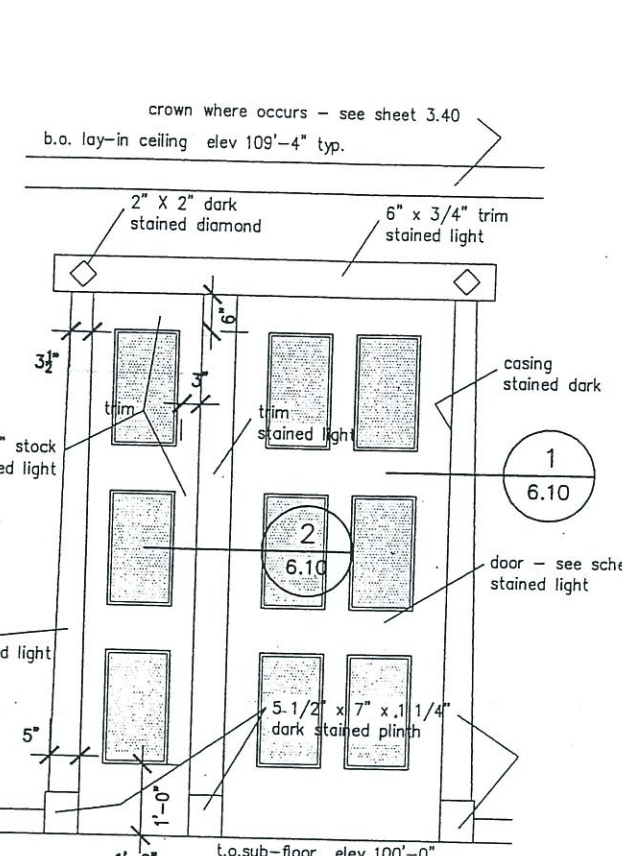


**C Window Type**  
 3/4" = 1'-0" (half size: 3/8" = 1'-0")

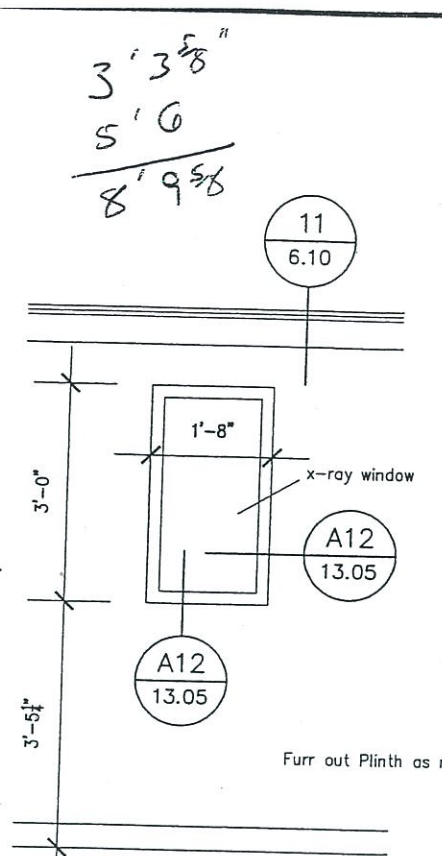


**G Window Type**  
 3/4" = 1'-0" (half size: 3/8" = 1'-0")

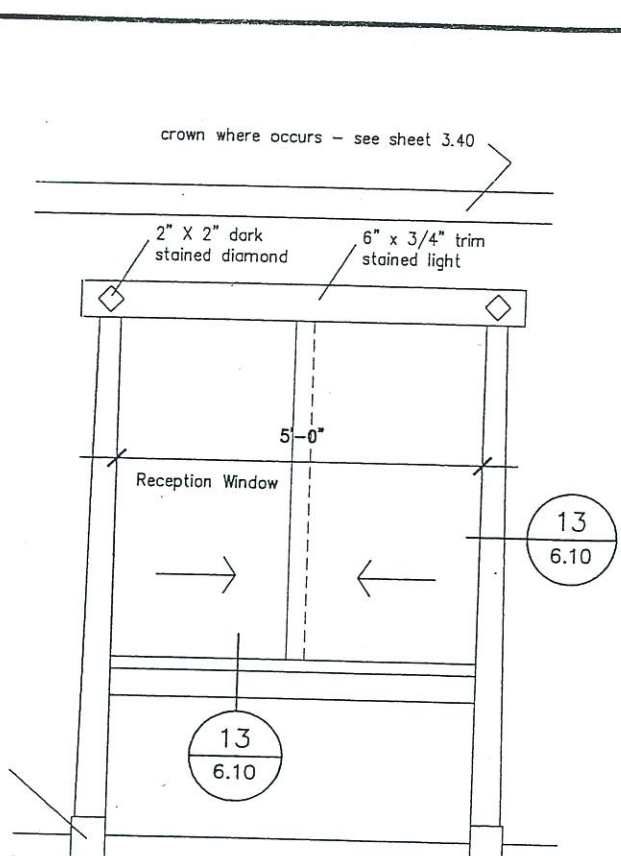

**H Window Type**  
 3/4" = 1'-0" (half size: 3/8" = 1'-0")

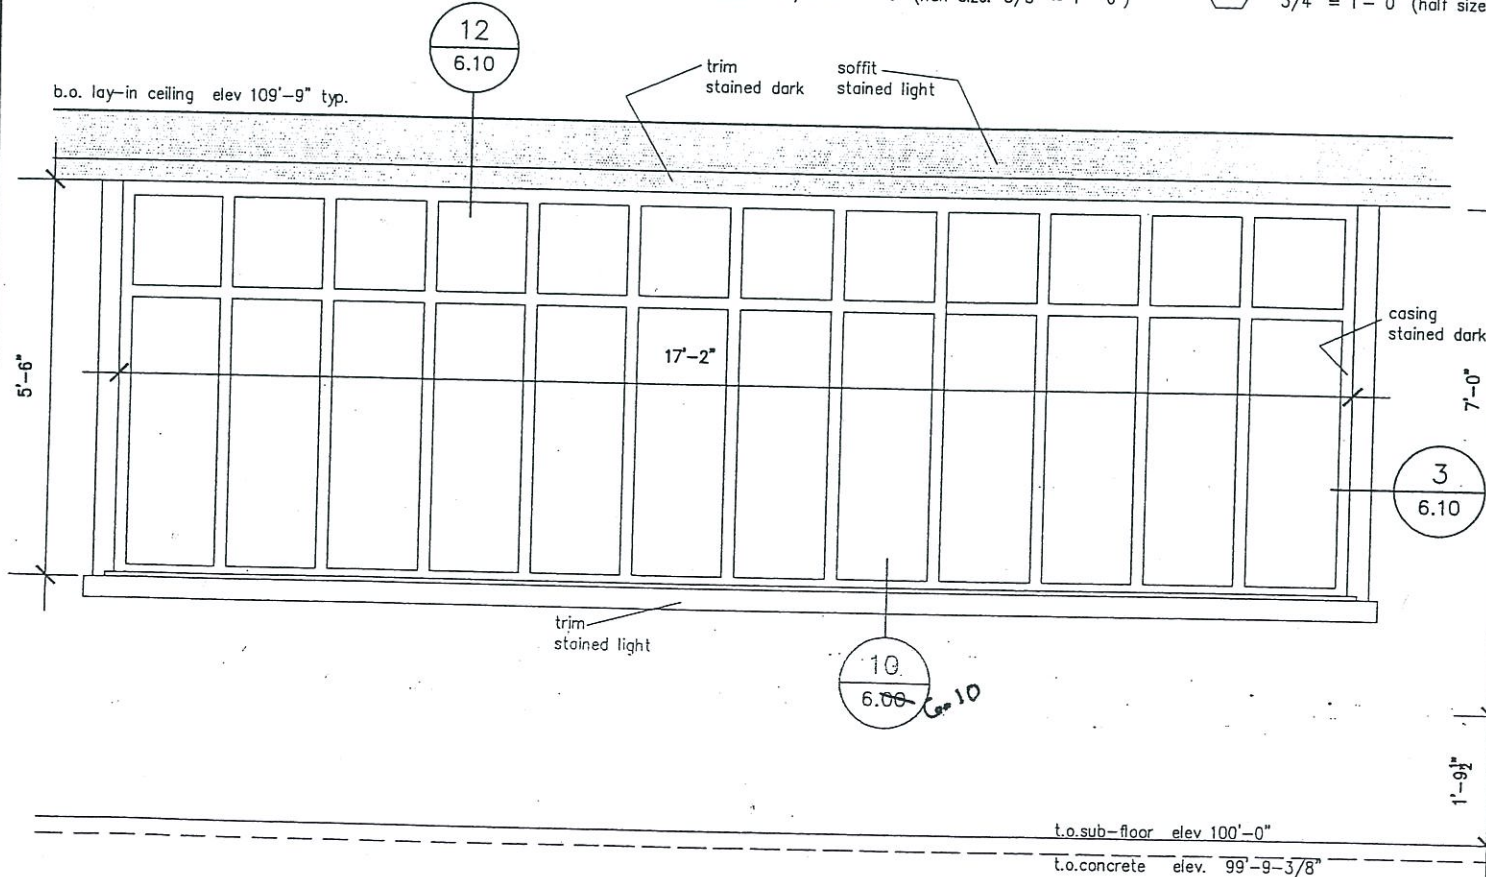

**E Window Type**  
 3/4" = 1'-0" (half size: 3/8" = 1'-0")

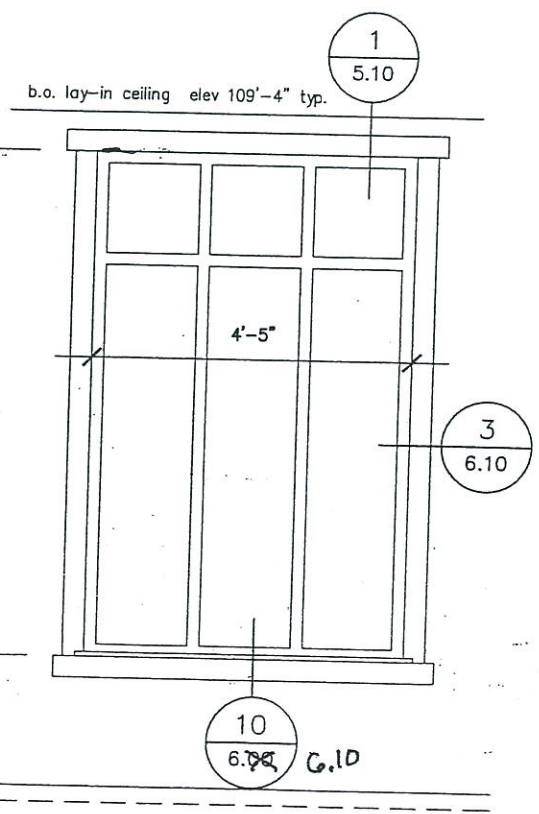

**F Window Type**  
 3/4" = 1'-0" (half size: 3/8" = 1'-0")

Header Height for window verify?

3' 3 5/8"  
 5' 6"  
 8' 9 5/8"

**Medical Design Group**  
 Architecture for Health Care

2716 WESTLAND PLACE  
 BOISE, IDAHO 83704-5863  
 BOISEARCHITECT@AOL.COM  
 Fax (208) 378-1405  
 Phone (208) 378-0817

© COPYRIGHT: MEDICAL DESIGN GROUP

REGISTERED ARCHITECT  
 No. AR-1740  
 22 March 2004

**WINDOW TYPES**





Desert Sage Health Center  
 2280 American Legion Blvd.  
 Mountain Home, Idaho

SHEET 6.01





Mar 2004 ds601.dwg 03/22/04 16:45

03/22/04 16:45:00 ARCHITECTURAL 2\EM3\LATE\MDG.dwg March 2003


RFI 43.50

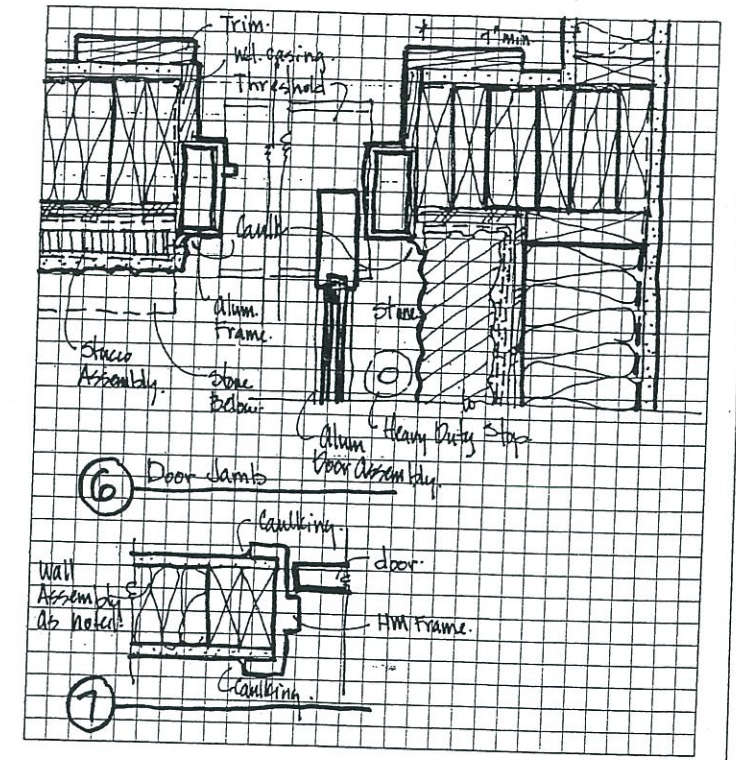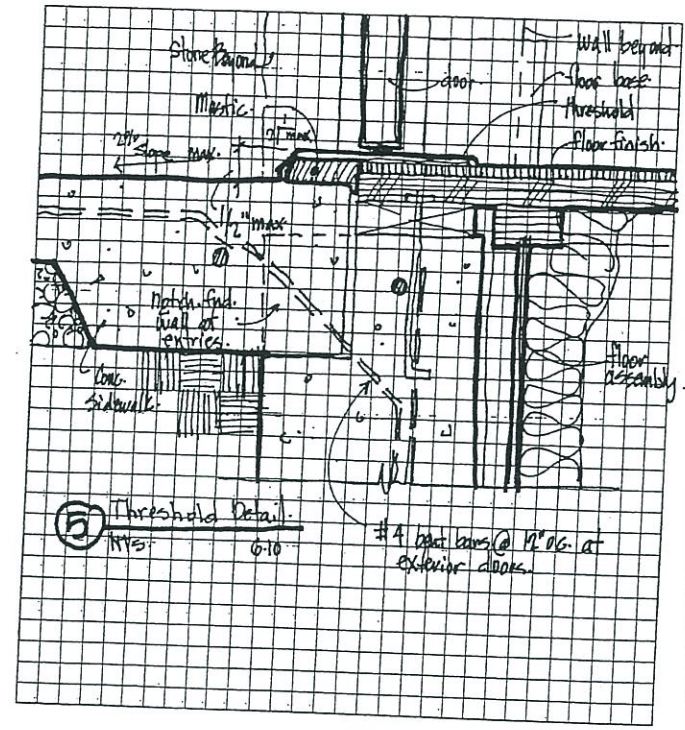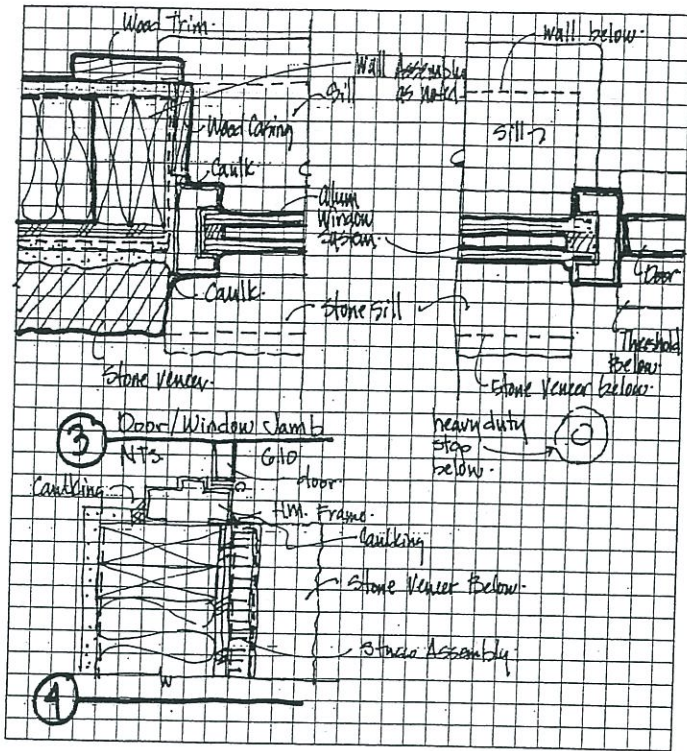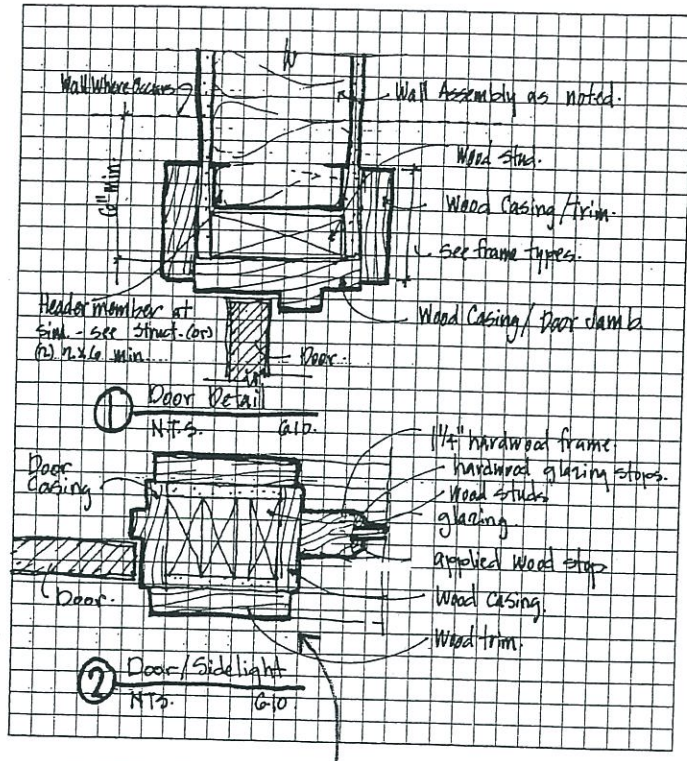

width Mullion

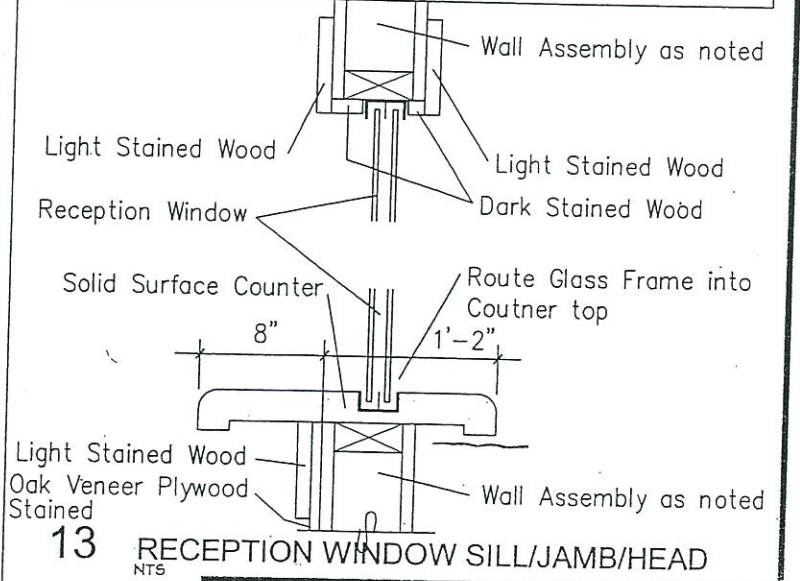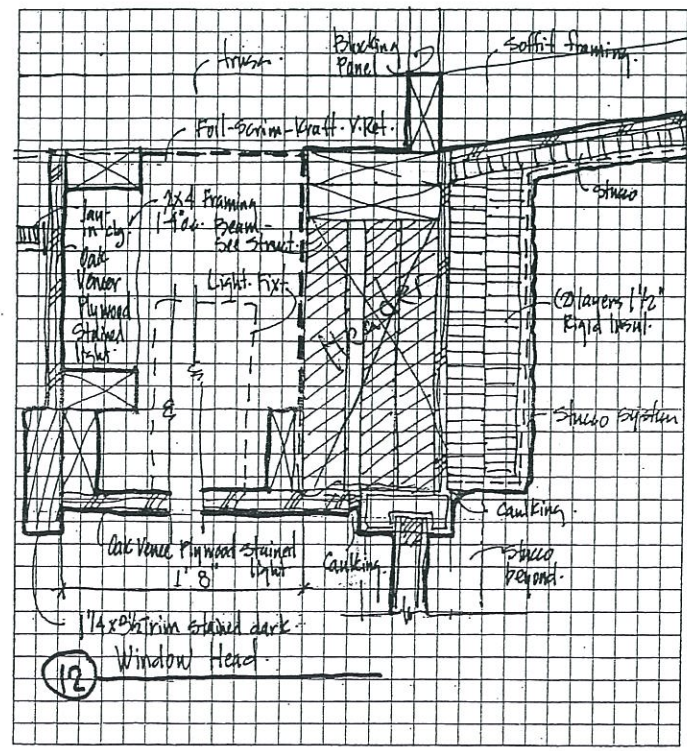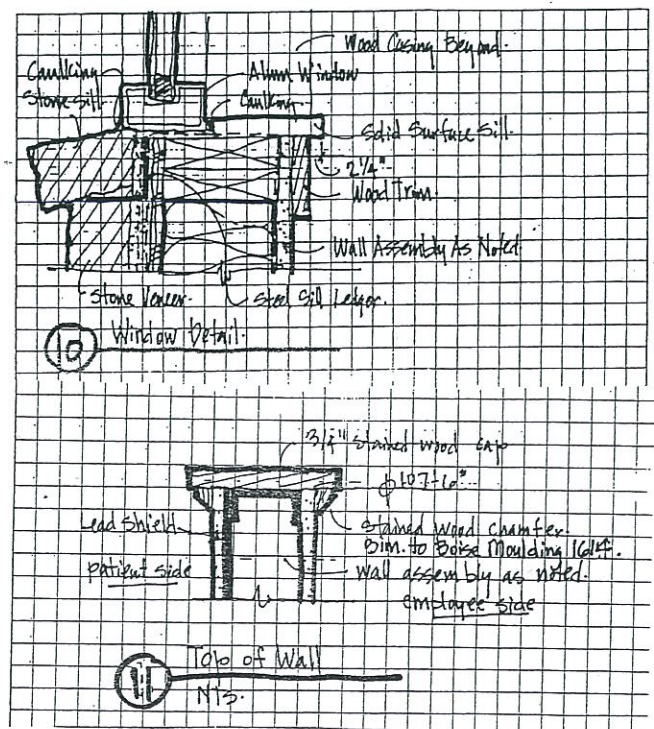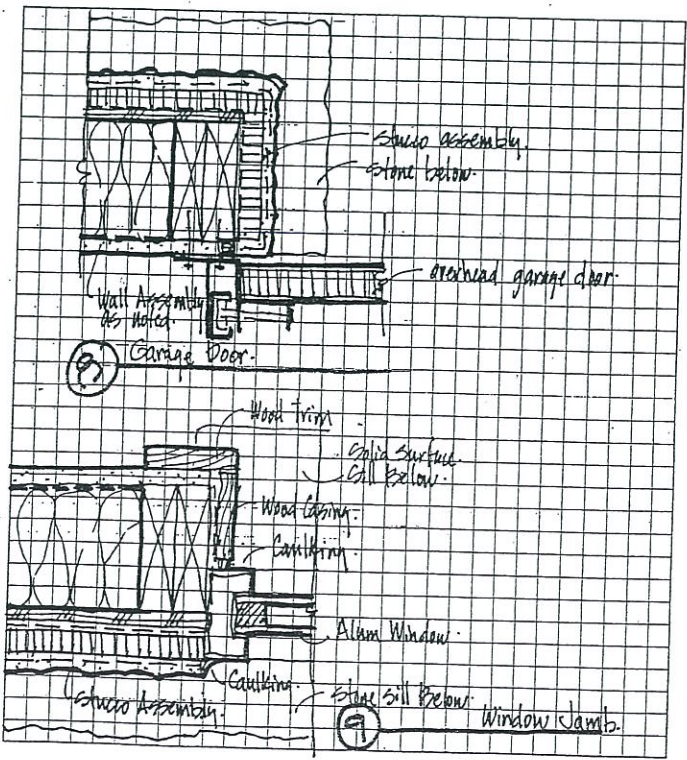

**Medical Design Group**  
Architecture for Health Care  
2716 WESTLAND PLACE  
BOISE, IDAHO 83704-5863  
BOISEARCHITECT@AOL.COM  
Fax (208) 378-1405  
Phone (208) 378-0817  
© COPYRIGHT: MEDICAL DESIGN GROUP

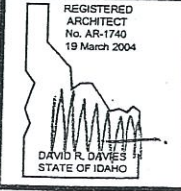

DOOR/WINDOW DEATILS  
Desert Sage Health Center  
2280 American Legion Blvd.  
Mountain Home, Idaho  
SHEET  
6.10  
Mar 2004 ds610.dwg 03/22/04 12:55

DOOR SCHEDULE

MARK	SIZE	DOOR MAT'L	DOOR TYPE	DOOR FINISH	FRAME MAT'L	FRAME TYPE	FRAME FINISH	DETAIL JAMB	DETAIL HEAD	DETAIL THRESH.	REMARKS	HARDWARE GROUP	MARK
101	36X84X1 3/4	WD	STN	WD	A/B	STN	STN	1/6.10	1/6.10 sim			101	101
102	36X84X1 3/4	WD	STN	WD	A/B	STN	STN	1/6.10	1/6.10 sim			102	102
103	36X84X1 3/4	WD	STN	WD	A/B	STN	STN	1/6.10	1/6.10 sim			103	103
104	36X84X1 3/4	WD	STN	WD	A/B	STN	STN	1/6.10	1/6.10 sim			104	104
105	36X84X1 3/4	WD	STN	WD	A/B	STN	STN	1/6.10	1/6.10 sim			105	105
106	36X90X1 3/4	WD	STN	WD	A/B	STN	STN	1/6.10	1/6.10 sim			106	106
107	36X36X1 3/4	WD	STN	WD	A/A	STN	STN	2/6.10	1/6.10 sim			107	107
108	36X89X1 3/4	ALUM	DD	STN	WD	A/B	STN	2/6.10				108	108
109	36X36X1 3/4	WD	DD	STN	WD	A/B	STN	6/6.10	6/6.10 sim	5/6.10		109	109
110								2/6.10				110	110
111	36X90X1 3/4	WD	STN	WD	A/B	STN	STN	2/6.10	1/6.10 sim			111	111
112	36X84X1 3/4	WD	STN	WD	A/B	STN	STN	1/6.10	1/6.10 sim			112	112
113	36X84X1 3/4	WD	STN	WD	A/B	STN	STN	1/6.10	1/6.10 sim			113	113
114	36X84X1 3/4	WD	STN	WD	A/B	STN	STN	1/6.10	1/6.10 sim			114	114
115	36X89X1 3/4	ALUM	PT	ALUM	D	PT	PT	6/6.10	6/6.10 sim	5/6.10		115	115
116	36X84X1 3/4	WD	STN	WD	A/A	STN	STN	1/6.10	1/6.10 sim			116	116
117	48X84X1 3/4	WD	STN	WD	A/B	STN	STN	1/6.10	1/6.10 sim			117	117
118	36X84X1 3/4	HM	F	PT	HM	D	PT	7/6.10	7/6.10 sim			118	118
119	36X84X1 3/4	HM	F	PT	HM	D	PT	4/6.10	4/6.10 sim			119	119
120												120	120
121	36X84X1 3/4	HM	F	PT	HM	D	PT	7/6.10	7/6.10 sim			121	121
122	36X84X1 3/4	HM	F	PT	HM	D	PT	7/6.10	7/6.10 sim			122	122
123	96X120X1 3/8	STL	G	PT	STL	-	PT	8/6.10	8/6.10 sim		60 min. rated power operator	123	123
124	36X84X1 3/4	WD	STN	WD	A/B	STN	STN	1/6.10	1/6.10 sim			124	124
125	36X84X1 3/4	WD	FG	STN	WD	A/B	STN	1/6.10	1/6.10 sim			125	125
126	36X84X1 3/4	WD	2H	PT	ALUM	D	PT	6/6.10	6/6.10 sim	5/6.10	OFCI glazing	126	126
127	36X89X1 3/4	ALUM	STN	WD	A/B	STN	STN	1/6.10	1/6.10 sim		OFCI card reader	127	127
128	36X84X1 3/4	WD	STN	WD	A/B	STN	STN	1/6.10	1/6.10 sim			128	128
129	36X84X1 3/4	WD	STN	WD	A/B	STN	STN	1/6.10	1/6.10 sim			129	129
130	36X84X1 3/4	WD	STN	WD	A/A	STN	STN	1/6.10	1/6.10 sim			130	130

DOOR SCHEDULE

HARDWARE GROUP	QUANTITY	DESCRIPTION
HARDWARE GROUP 01	1 1/2 pr	Hinges
	1	Latchset (R)
	1	Wallstop
HARDWARE GROUP 02	1 1/2 pr	Hinges
	1	Latchset (D)
	1	Wallstop
HARDWARE GROUP 03	1 1/2 pr	Hinges - 180 degree
	1	Latchset (ON)
	1	Overhead Stop
HARDWARE GROUP 04	1 1/2 pr	Hinges
	1	Latchset (ON)
	1	Wallstop
HARDWARE GROUP 05	2 pr	Hinges
	1	Latchset (D)
	1	Wallstop
HARDWARE GROUP 06	1 1/2 pr	Hinges
	1	Closer
	1	Push
	1	Pull (waiting)
	1	Wallstop
HARDWARE GROUP 07	1 1/2 pr	Hinges
	1	Latchset (OL)
	1	Wallstop
HARDWARE GROUP 08	1 1/2 pr	Hinges
	1	Panic
	1	Pull
	1	Closer
	1	Threshold
	1	Weatherstrip
HARDWARE GROUP 09	1 1/2 pr	Hinges
	1	Panic
	1	Pull
	1	Closer
	1	Threshold
	1	Weatherstrip
	1	Electric Strike
HARDWARE GROUP 10	1 pr	Hinges
	1	Latchset (OL)
	1	Wallstop
HARDWARE GROUP 11	1 1/2 pr	Hinges
	1	Latchset (AB)
	1	HD Stop
	1	Kickplate
	1	Closer
	1	Weatherstrip
	1	Threshold
HARDWARE GROUP 12	1 1/2 pr	Hinges
	1	Latchset (D)
	1	Closer
	1	Smoke seal
HARDWARE GROUP 13	1 1/2 pr	Hinges
	1	Latchset (D)
	1	Sound Seal
	1	Door Sound Sweep
HARDWARE GROUP 14	hardware by dor	manuf.
HARDWARE GROUP 15	1 1/2 pr	Hinges
	1	Keyless Push Button
	1	Combination Lock
	1	Latch Set
HARDWARE GROUP 16	2	Hinges
	1	Keyless Push Button
	1	Combination Lock
	1	Latch Set
HARDWARE GROUP 17	1 1/2 pr	Hinges
	1	Latchset (ON)
	1	Closer w/ cush stop
	1	Perimeter Air Seal
HARDWARE GROUP 18	1 1/2 pr	Hinges
	1	Panic
	1	Pull
	1	Closer
	1	Threshold
	1	Weatherstrip
	1	Automatic Door Operator
HARDWARE GROUP 19	1 1/2 pr	Hinges - Non Removable Pins
	1	Latchset (D)
	1	Wallstop

DOOR SCHEDULE

MARK	SIZE	DOOR MAT'L	DOOR TYPE	DOOR FINISH	FRAME MAT'L	FRAME TYPE	FRAME FINISH	DETAIL JAMB	DETAIL HEAD	DETAIL THRESH.	REMARKS	HARDWARE GROUP	MARK
131	36X84X1 3/4	WD	STN	WD	A/B	STN	STN	1/6.10	1/6.10 sim			131	131
132	36X84X1 3/4	WD	STN	WD	A/B	STN	STN	1/6.10	1/6.10 sim			132	132
133	36X84X1 3/4	WD	STN	WD	A/B	STN	STN	1/6.10	1/6.10 sim			133	133
134	42X89X1 3/4	ALUM	2H	PT	ALUM	D	PT	6/6.10	6/6.10 sim	5/6.10	OFCI card reader	134	134
135	42X84X1 3/4	WD	STN	WD	A/B	STN	STN	1/6.10	1/6.10 sim			135	135
136	36X84X1 3/4	WD	STN	WD	A/B	STN	STN	1/6.10	1/6.10 sim			136	136
137	36X84X1 3/4	WD	STN	WD	A/B	STN	STN	1/6.10	1/6.10 sim			137	137
138	36X84X1 3/4	WD	STN	WD	A/B	STN	STN	1/6.10	1/6.10 sim			138	138
139	36X89X1 3/4	ALUM	2H	PT	ALUM	D	PT	6/6.10	6/6.10 sim	5/6.10		139	139
140												140	140
141	36X84X1 3/4	WD	STN	WD	A/B	STN	STN	1/6.10	1/6.10 sim		keyless lock	15	141
142												142	142
143	36X84X1 3/4	WD	STN	WD	A/B	STN	STN	1/6.10	1/6.10 sim			143	143
144	36X84X1 3/4	WD	STN	WD	A/B	STN	STN	1/6.10	1/6.10 sim			144	144
145	36X84X1 3/4	WD	STN	WD	A/B	STN	STN	1/6.10	1/6.10 sim			145	145
146	36X84X1 3/4	WD	STN	WD	A/B	STN	STN	1/6.10	1/6.10 sim			146	146
147	36X84X1 3/4	WD	STN	WD	A/B	STN	STN	1/6.10	1/6.10 sim			147	147
148	36X84X1 3/4	WD	STN	WD	A/B	STN	STN	1/6.10	1/6.10 sim			148	148
149	36X84X1 3/4	WD	STN	WD	A/B	STN	STN	1/6.10	1/6.10 sim			149	149
150												150	150
151	36X84X1 3/4	WD	F	STN	WD	A/B	STN	1/6.10	1/6.10 sim			2	151
152	36X84X1 3/4	WD	F	STN	WD	A/B	STN	1/6.10	1/6.10 sim			1	152
153	36X84X1 3/4	WD	F	STN	WD	A/B	STN	1/6.10	1/6.10 sim			2	153
154	42X84X1 3/4	WD	STN	WD	A/B	STN	STN	1/6.10	1/6.10 sim			4	154
155	42X84X1 3/4	WD	6PM	STN	HM	C	PT	sht 13.05	sht. 13.05 sim.		X-ray side Hallway side Lead Lined door/ frame per sht 13.01	16	155

STN = factory applied clear finish over natural wood  
 WD = Wood  
 HM = Hollow Metal  
 ALUM = Aluminum  
 PT = Paint  
 FPT = Factory Paint  
 STL = Steel  
 PT custom = Field Paint garage door

Note: Frame Silencers typical except at openings with seals.

DD - dutch door

GFHC - Desert Sage

GFHC - Desert Sage

**Medical Design Group**  
 Architecture for Health Care

2716 WESTLAND PLACE  
 BOISE, IDAHO 83704-5863


BOISEARCHITECT@AOL.COM  
 Fax (208) 378-1405  
 Phone (208) 378-0817

REGISTERED ARCHITECT  
 No. AR-1740  
 19 March 2004

DOOR SCHEDULES SHEET  
 Desert Sage Health Center  
 2280 American Legion Blvd.  
 Mountain Home, Idaho 6.11

© COPYRIGHT: MEDICAL DESIGN GROUP




MATERIAL KEYING LEGEND

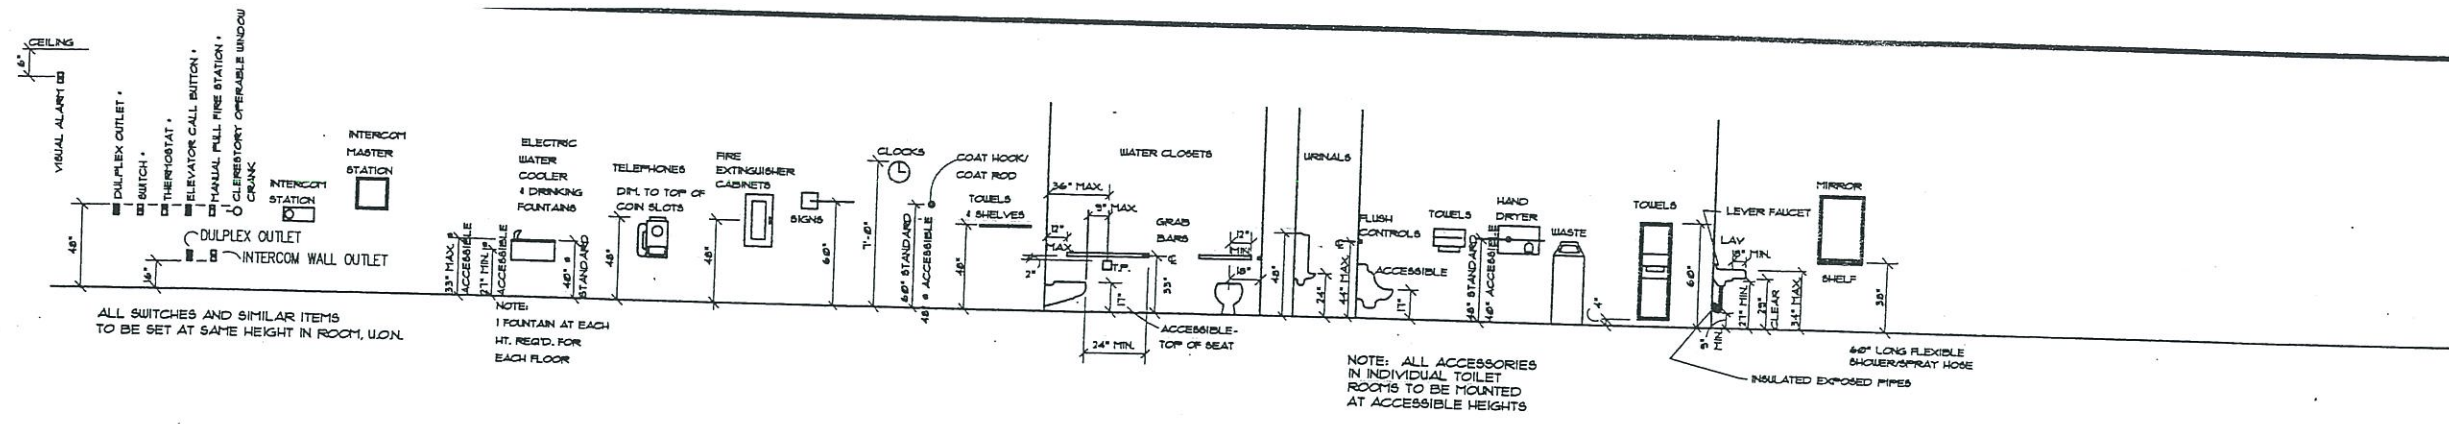

**H** STANDARD MOUNTING HEIGHT

H = STANDARD MOUNTING HEIGHT

NOTE: ALL ITEMS SHOWN ABOVE MAY NOT EXIST IN THIS PROJECT

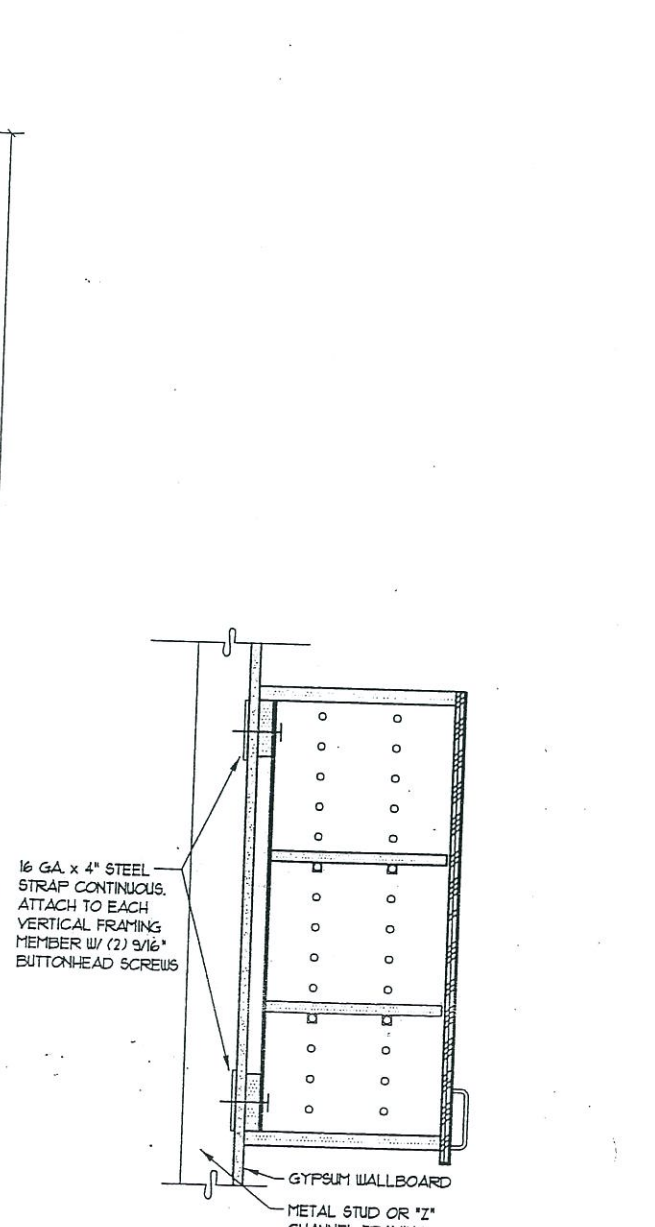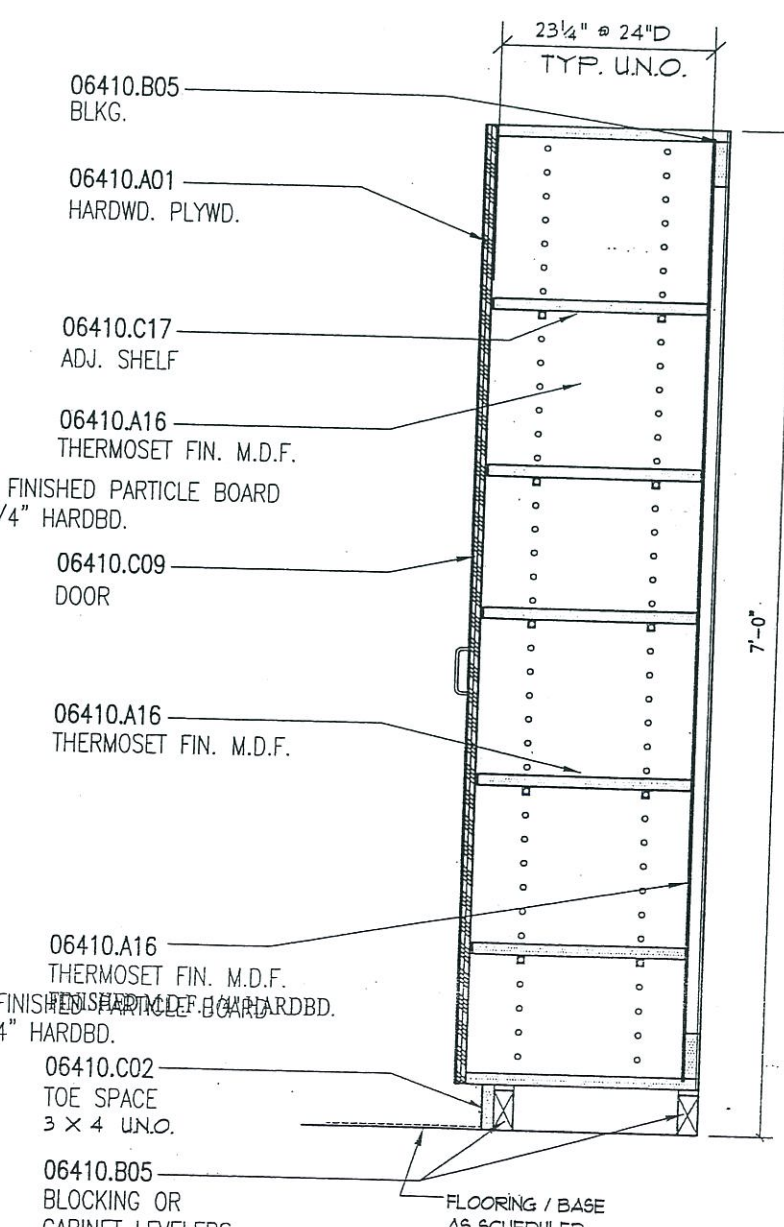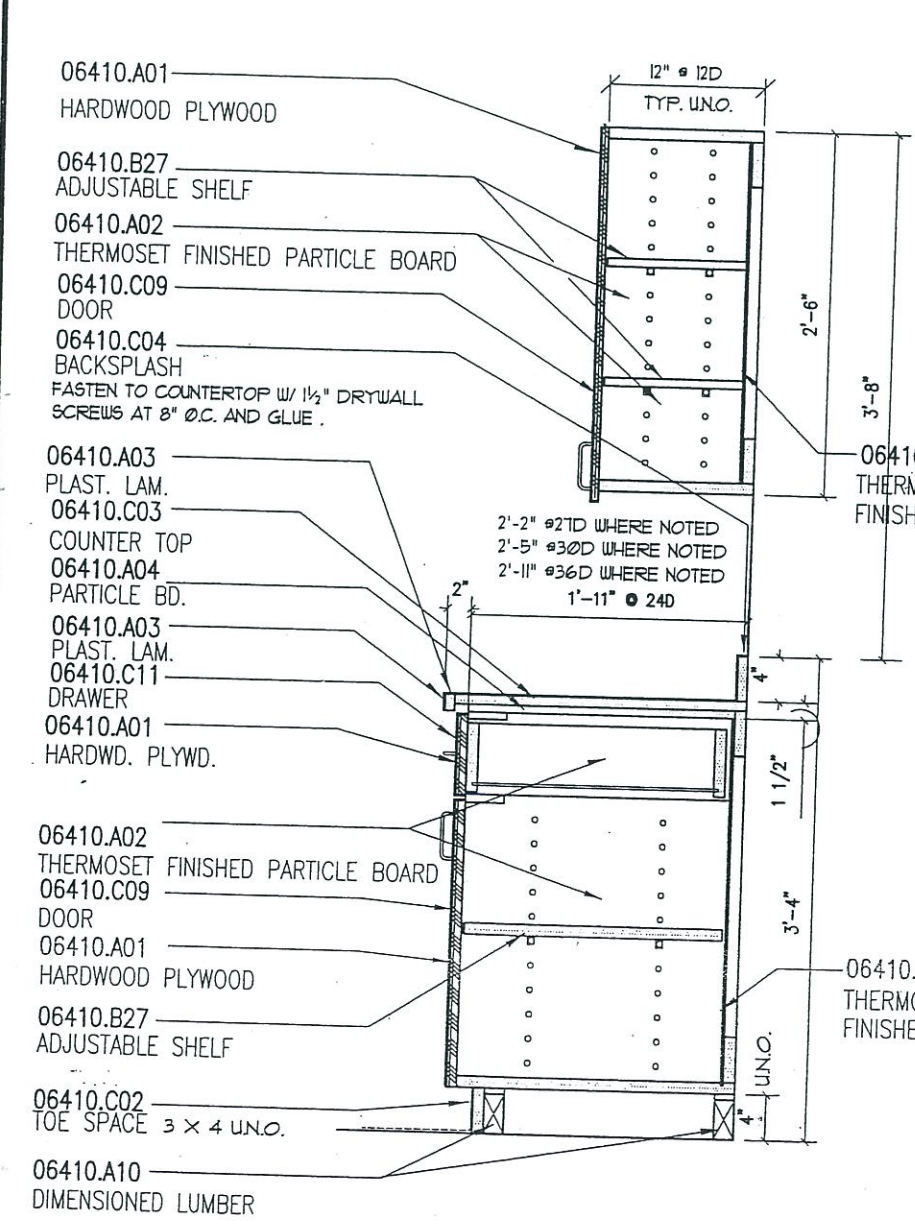

1 TYPICAL CASEWORK SECTION  
N.T.S.

2 TYPICAL CASEWORK SECTION  
N.T.S.


3 BACKING AT STEEL STUD WALLS  
N.T.S.

**Medical Design Group**  
Architecture for Health Care  
2716 WESTLAND PLACE  
BOISE, IDAHO 83704-5863  
BOISEARCHITECT@AOL.COM  
Fax (208) 378-1405  
Phone (208) 378-0817  
© COPYRIGHT: MEDICAL DESIGN GROUP


REGISTERED ARCHITECT  
No. AR-1740  
19 March 2004  
DAVID R. DAVIES  
STATE OF IDAHO

INTERIOR DETAILS SHEET  
Desert Sage Health Center  
2280 American Legion Blvd.  
Mountain Home, Idaho  
7.00  
Mar 2004 ds700.dwg 03/22/04 12:59


c:\Program Files\AutoCAD Architectural 2\TEMPLATE\acad MDG B.dwt August 2002

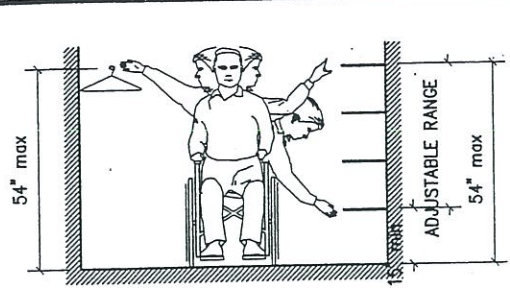


STORAGE SHELVES AND CLOSETS

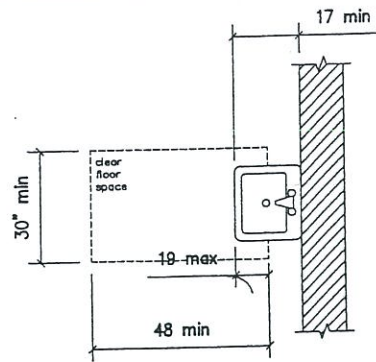


SINK CLEARANCES

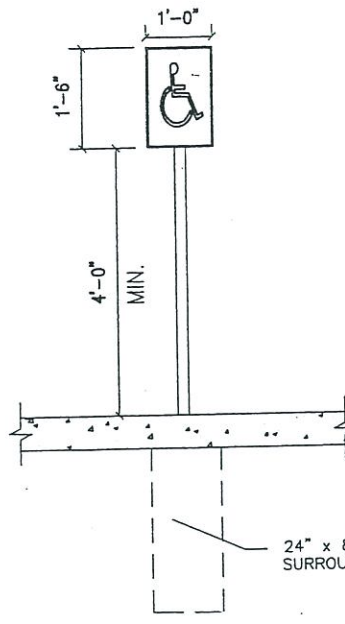

SIGNAGE DETAIL

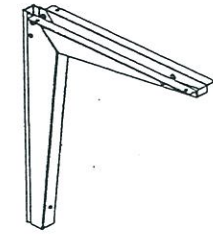

STEEL UNDER COUNTER SUPPORT BRACKET as req. for top depth

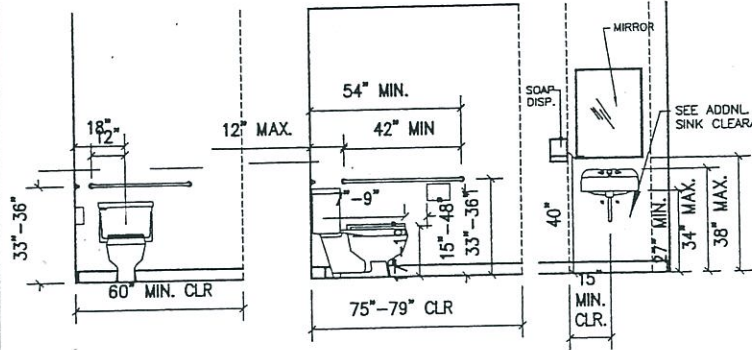

TOILET FRONT

TOILET SIDE

SINK FRONT


SINK SIDE

SPOUT HEIGHT AND KNEE CLEARANCE


3 INTERIOR ACCESSIBILITY DETAILS not to scale

4 EXT. SIGN not to scale



5 COUNTER SUPPORT not to scale

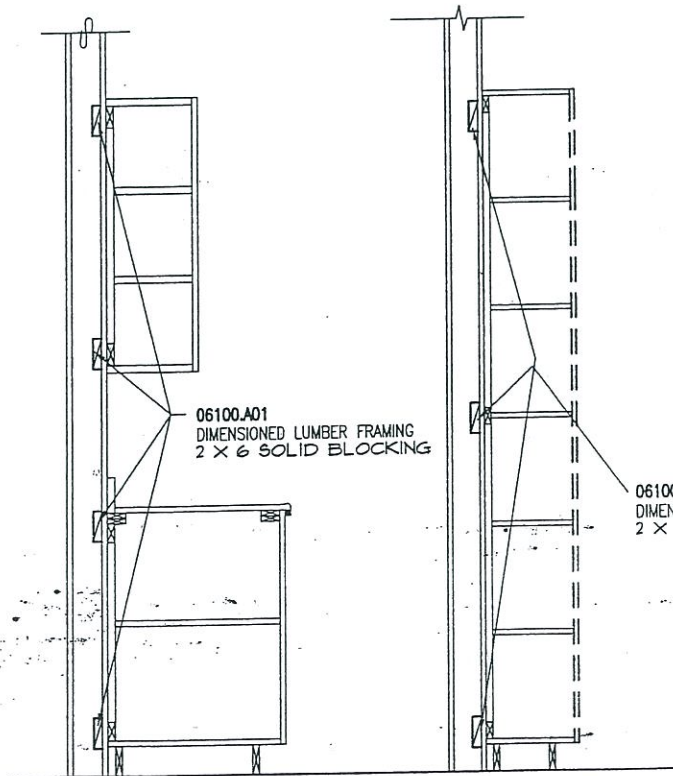

1 TYPICAL CASEWORK ANCHORAGE not to scale

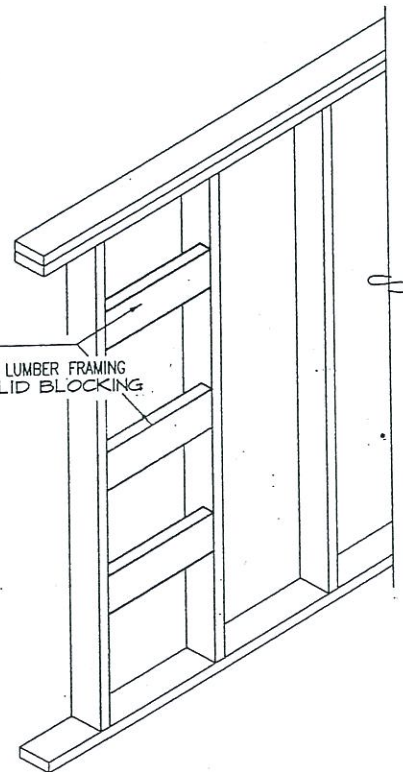

2 TYPICAL CASEWORK ANCHORAGE not to scale

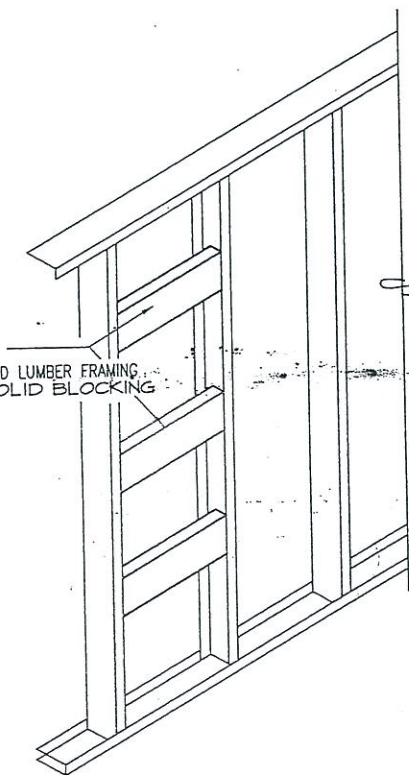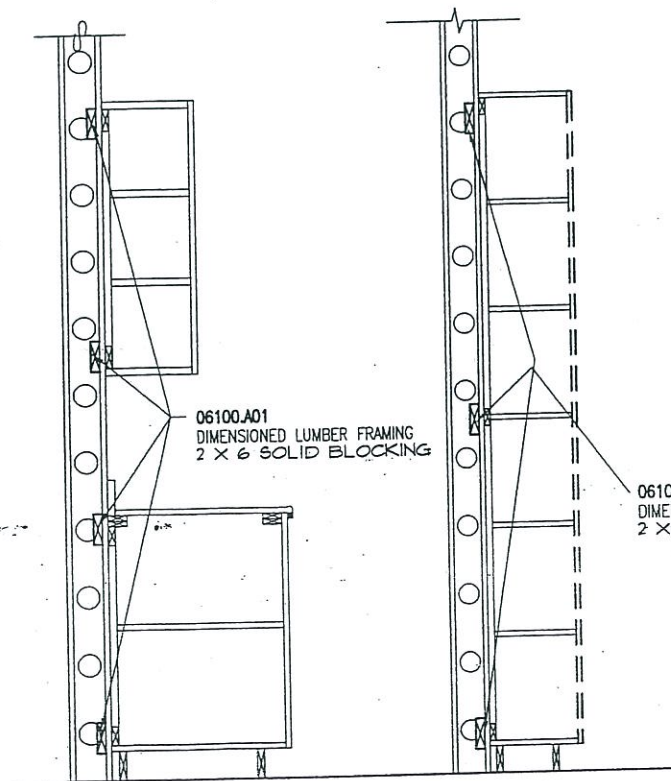

c:\Program Files\AutoCAD Architectural 2\TEMPLATE\acad MDG B.dwt August 2002

**Medical Design Group**  
 Architecture for Health Care  
 2716 WESTLAND PLACE  
 BOISE, IDAHO · 83704-5863  
 BOISEARCHITECT@AOL.COM  
 Fax (208) 378-1405  
 Phone (208) 378-0817

© COPYRIGHT: MEDICAL DESIGN GROUP

REGISTERED ARCHITECT  
 No. AR-1740  
 19 March 2004




DAVID R. DRABBS  
 STATE OF IDAHO

INTERIOR DETAILS

Desert Sage Health Center  
 2280 American Legion Blvd.  
 Mountain Home, Idaho

SHEET 7.01

Mar 2004 ds701.dwg 02/24/04 07:40

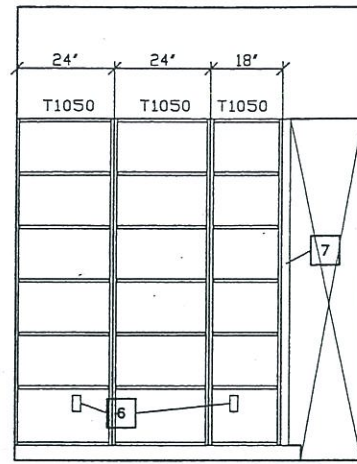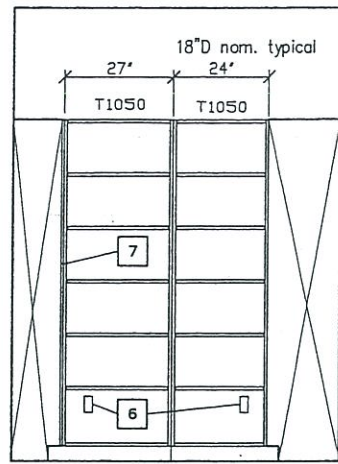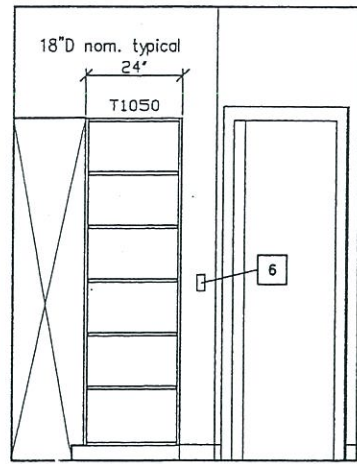





Keynotes:

1. OFOI Rolling Computer Cart
2. Cabinet Lock typical
3. Sink - See Mech
4. Full Height 3/4" thick PLam Backsplash
5. Paper Towel Dispenser
6. Electrical Device
7. Filler Panel as required
8. Under Counter Light Fixture
9. OFOI U.C. Refrigerator - Verify size
10. OFOI Microwave - Verify Size
11. Vertical 3/8" thick masonit dividers @ 3 1/2" o.c.  
Depth of slot: 16" with false back.
12. OFOI Floor Mounted Equipment - Verify size
13. OFOI Computer Monitor
14. Lead Shielded Window and Frame
15. OFOI Controller
16. Counter Top Cleat
17. Chair Rail - See detail 6/5.21
18. Set Rail in Clear Silicon Caulking at Counter top
19. OFOI Refrigerator
20. Decorative Wood Trim Around Light Switch  
See detail 8/5.21
21. Applied Wood Moulding - Stained Dark
22. Stained Hardwood Veneer Plywood
23. Solid Surface Counter Top
24. Stained Wood Moulding
25. Wider Counter Top Area - See Plan
26. Skylight Shaft
27. Fabric Wall Covering over 1/2" Cork brd.
28. Crown Moulding - see 1/5.21
29. Floor Base
30. OFOI Keyboard Pull-Out

8 Meds  
1/2" = 1'-0" (half size: 1/4" = 1'-0")

9 Meds  
1/2" = 1'-0" (half size: 1/4" = 1'-0")

10 Meds  
1/2" = 1'-0" (half size: 1/4" = 1'-0")

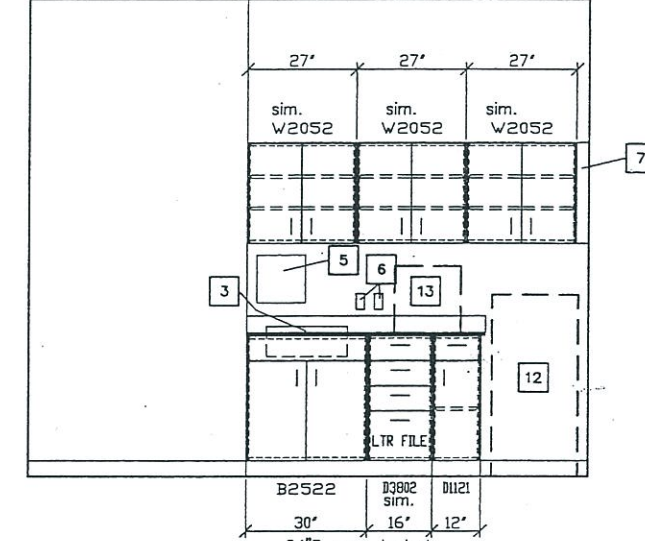
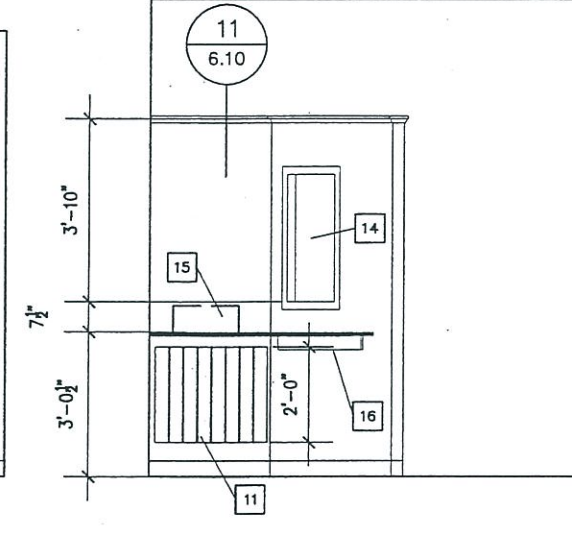
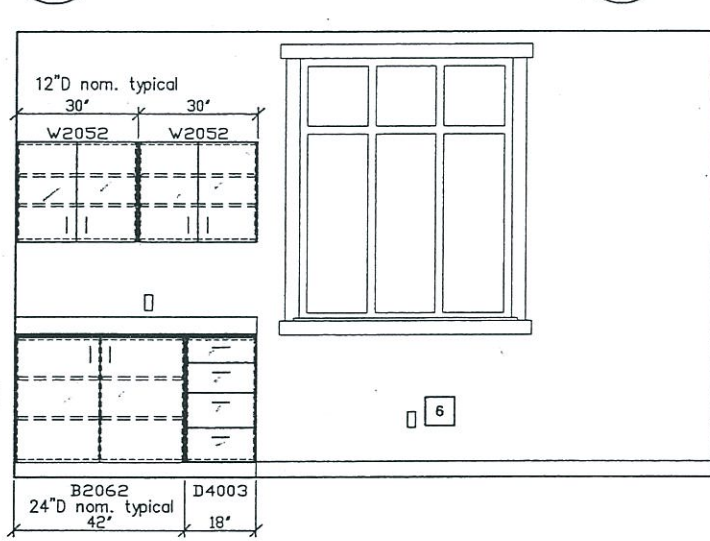
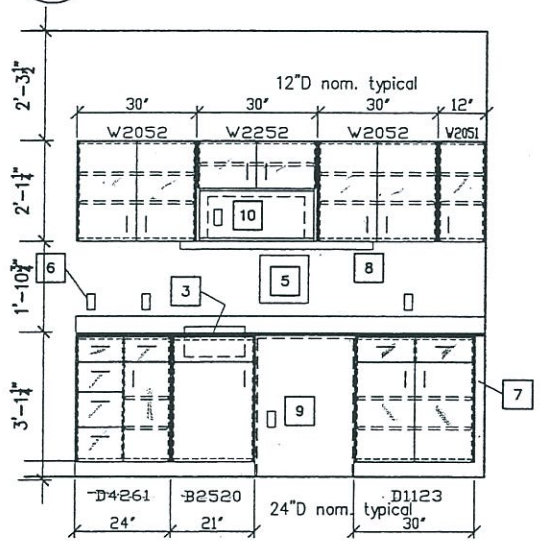


4 Break Room  
1/2" = 1'-0" (half size: 1/4" = 1'-0")

5 Break Room  
1/2" = 1'-0" (half size: 1/4" = 1'-0")

6 X-Ray Room  
1/2" = 1'-0" (half size: 1/4" = 1'-0")

7 X-Ray Room  
1/2" = 1'-0" (half size: 1/4" = 1'-0")

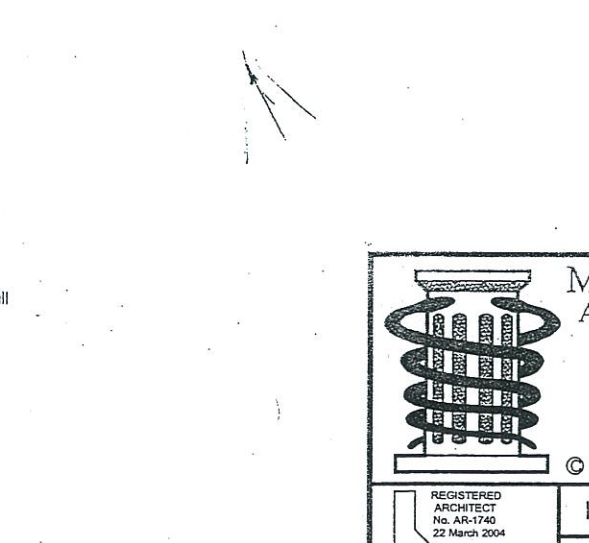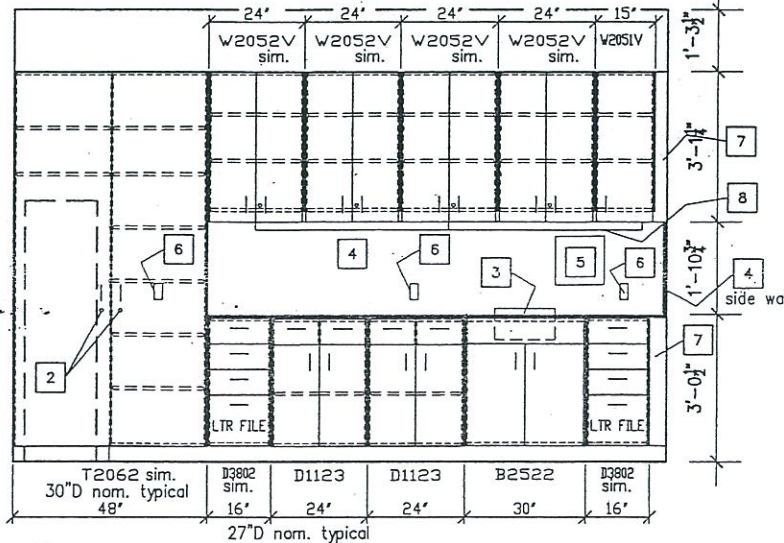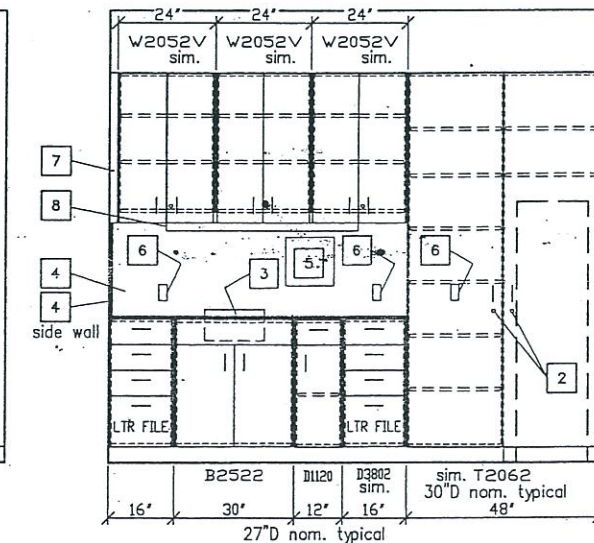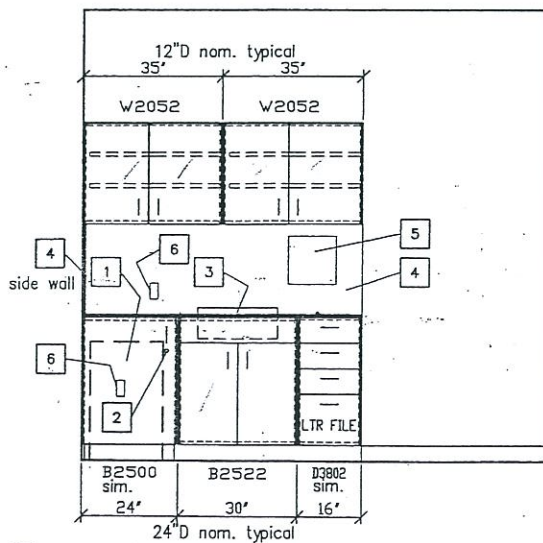

Exam Room  
1/2" = 1'-0" (half size: 1/4" = 1'-0")

2 M. Procedure 01  
1/2" = 1'-0" (half size: 1/4" = 1'-0")

3 M. Procedure 02  
1/2" = 1'-0" (half size: 1/4" = 1'-0")

**Medical Design Group**  
Architecture for Health Care

2716 WESTLAND PLACE  
BOISE, IDAHO 83704-5863

BOISEARCHITECT@AOL.COM  
Fax (208) 378-1405  
Phone (208) 378-0817

REGISTERED ARCHITECT  
No. AR-1740  
22 March 2004

DAVID R. DAVIES  
STATE OF IDAHO

INTERIOR ELEVATIONS


Desert Sage Health Center  
2280 American Legion Blvd.  
Mountain Home, Idaho

SHEET  
7.10

COPYRIGHT: MEDICAL DESIGN GROUP


Mar 2004 ds710.dwg 03/22/04 14:12

c:\Program Files\AutoCAD Architectural 2\TEMPLATE\mdg.dwg March 2003

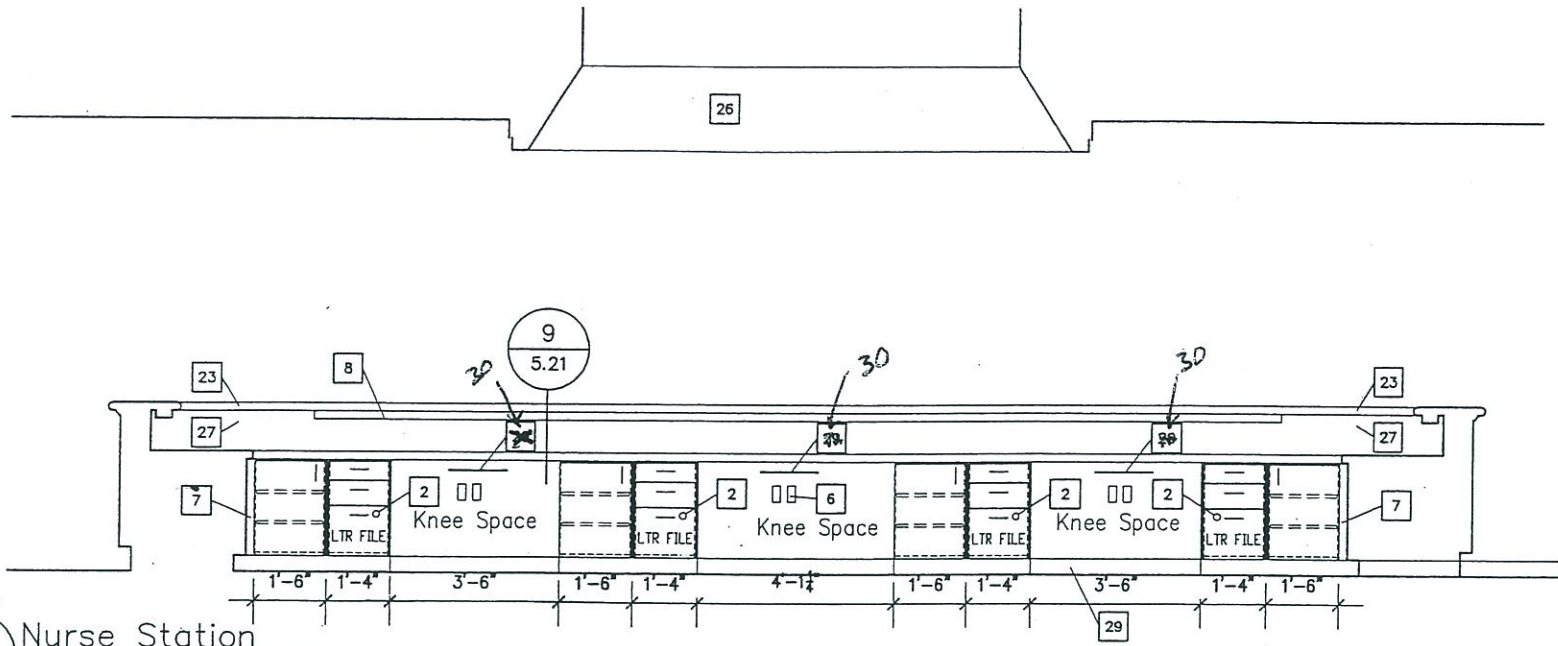


5 Nurse Station  
 1/2" = 1'-0" (half size: 1/4" = 1'-0")


- Keynotes:
- OFOI Rolling Computer Cart
  - Cabinet Lock typical
  - Sink - See Mech
  - Full Height 3/4" thick PLam Backsplash
  - Paper Towel Dispenser
  - Electrical Device
  - Filler Panel as required
  - Under Counter Light Fixture
  - OFOI U.C. Refrigerator - Verify size
  - OFOI Microwave - Verify Size
  - Vertical 3/8" thick masonit dividers @ 3 1/2" o.c. Depth of slot: 16" with false back.
  - OFOI Floor Mounted Equipment - Verify size
  - OFOI Computer Monitor
  - Lead Shielded Window and Frame
  - OFOI Controller
  - Counter Top Cleat
  - Chair Rail - See detail 6/5.21
  - Set Rail in Clear Silicon Caulking at Counter top
  - OFOI Refrigerator
  - Decorative Wood Trim Around Light Switch See detail 8/5.21
  - Applied Wood Moulding - Stained Dark
  - Stained Hardwood Veneer Plywood
  - Solid Surface Counter Top
  - Stained Wood Moulding
  - Wider Counter Top Area - See Plan
  - Skylight Shaft
  - Fabric Wall Covering over 1/2" Cork brd.
  - Crown Moulding - see 1/5.21
  - Floor Base
  - OFOI Keyboard Pull-Out

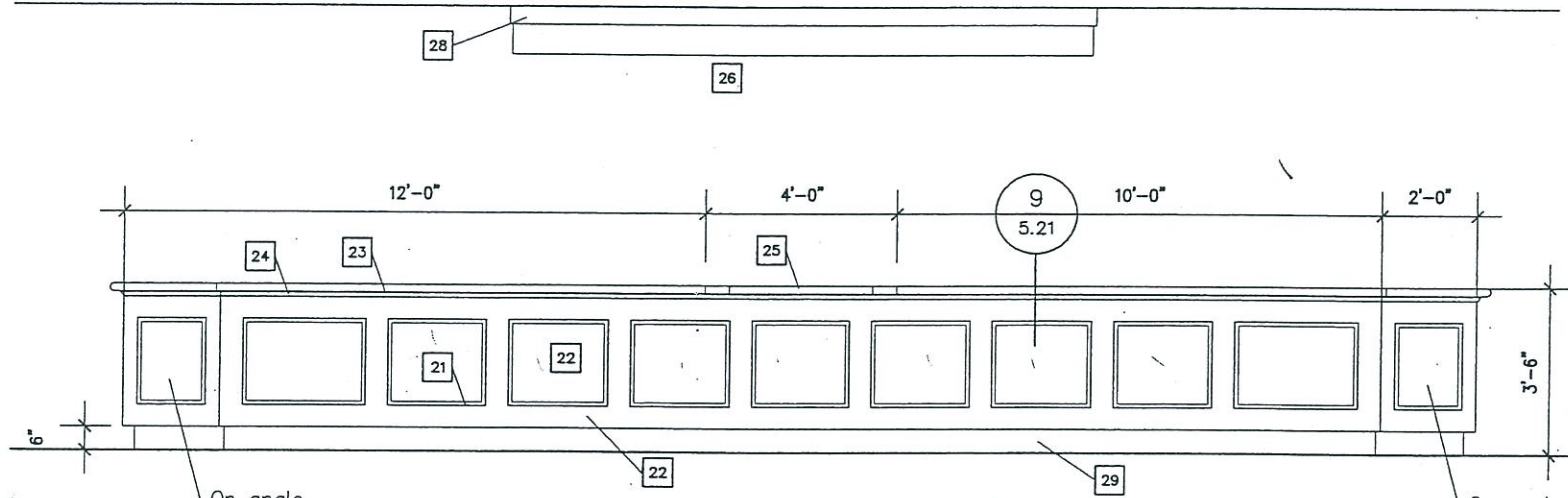


2 Nurse Station  
 1/2" = 1'-0" (half size: 1/4" = 1'-0")

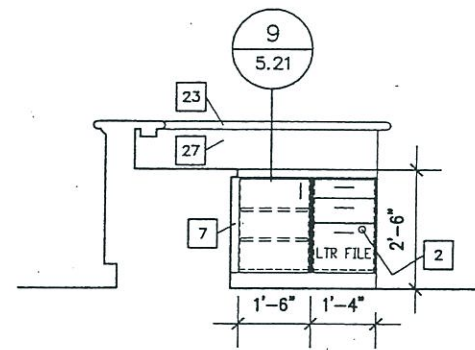

3 Nurse Station  
 1/2" = 1'-0" (half size: 1/4" = 1'-0")  
 Note: This Elevation is Mirrored on the other end

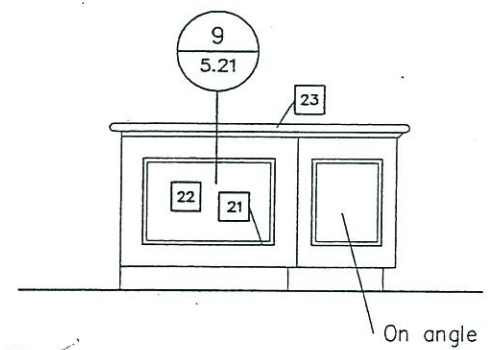

4 Nurse Station  
 1/2" = 1'-0" (half size: 1/4" = 1'-0")  
 Note: This Elevation is Mirrored on the other end

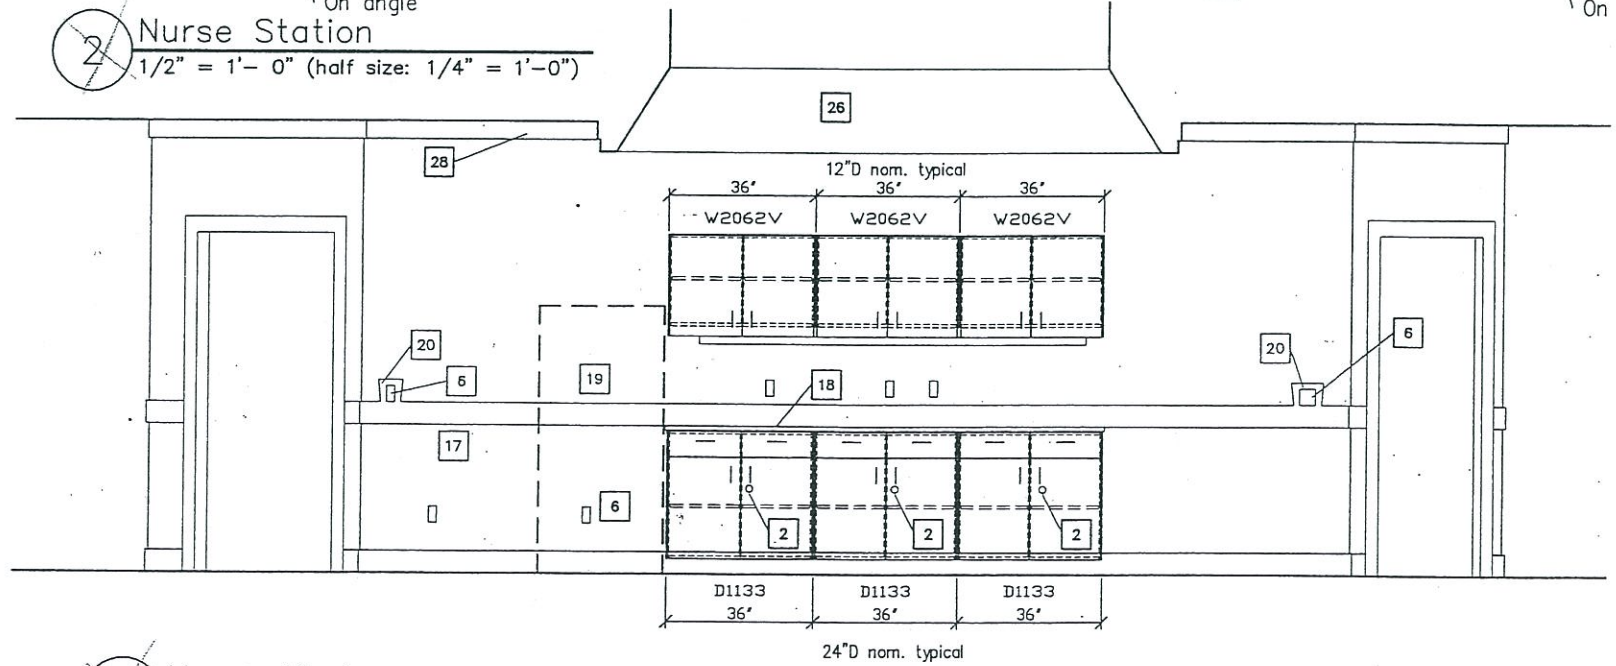

6 Nurse Work  
 1/2" = 1'-0" (half size: 1/4" = 1'-0")

**Medical Design Group**  
 Architecture for Health Care

2716 WESTLAND PLACE  
 BOISE, IDAHO 83704-5863

BOISEARCHITECT@AOL.COM  
 Fax (208) 378-1405  
 Phone (208) 378-0817

© COPYRIGHT: MEDICAL DESIGN GROUP

REGISTERED ARCHITECT  
 No. AR-1740  
 22 March 2004

DAVID R. DAVIES  
 STATE OF IDAHO


INTERIOR ELEVATIONS

Desert Sage Health Center  
 2280 American Legion Blvd.  
 Mountain Home, Idaho

SHEET  
 7.11

Mar 2004 ds711.dwg 03/22/04 14:14






c:\Program Files\AutoCAD Architecture\2\TEMPLATE\mdg.dwg March 2003

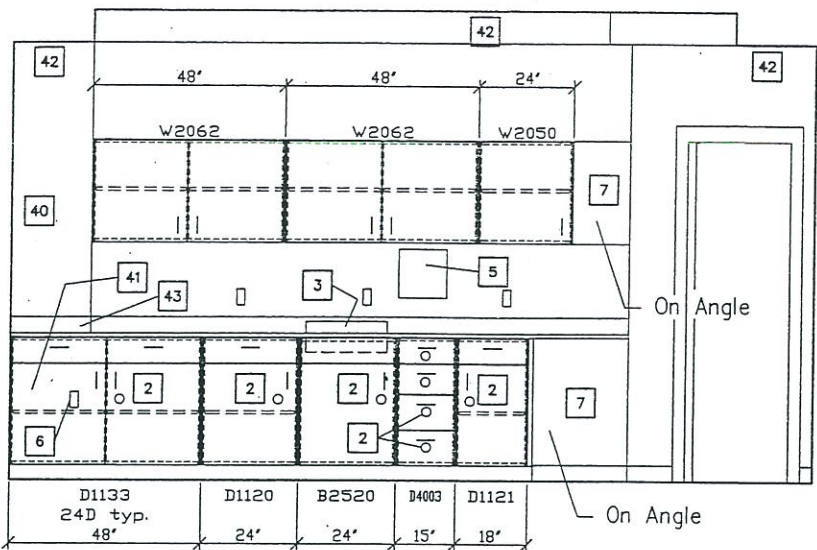

Keynotes:

1. OFOI Rolling Computer Cart
2. Cabinet Lock typical
3. Sink - See Mech
4. Full Height 3/4" thick PLam Backsplash
5. Paper Towel Dispenser
6. Electrical Device
7. Filler Panel as required
8. Under Counter Light Fixture
9. OFOI U.C. Refrigerator - Verify size
10. OFOI Microwave - Verify Size
11. Vertical 3/8" thick masonite dividers @ 3 1/2" o.c. Depth of slot: 16" with false back.
12. OFOI Floor Mounted Equipment - Verify size
13. OFOI Computer Monitor
14. Lead Shielded Window and Frame
15. OFOI Controller
16. Counter Top Cleat
17. Chair Rail - See detail 6/5.21
18. Set Rail in Clear Silicon Caulking at Counter top
19. OFOI Refrigerator
20. Decorative Wood Trim Around Light Switch See detail 8/5.21
21. Applied Wood Moulding - Stained Dark
22. Stained Hardwood Veneer Plywood
23. Solid Surface Counter Top
24. Stained Wood Moulding
25. Wider Counter Top Area - See Plan
26. Skylight Shaft
27. Fabric Wall Covering over 1/2" Cork brd.
28. Crown Moulding - see 1/5.21
29. Floor Base
30. OFOI Keyboard Pull-Out
31. 6" deep cabinet recessed into Stud Space
32. Grab Bar
33. Wall Mounted Toilet
34. Mirror - ~~OFOI OFCI~~
35. Knee Brace into Solid blocking
36. Specimen Pass-Through
37. Furr Down hard Ceiling over Shower
38. Pre-Manufactured Shower Assembly
39. Two Vert. Dividers and 1/4" horiz. dividers at 2 1/8" o.c. behind two doors
40. Chase as Required for Electrical
41. Ventilate Cabinet for Owner Equipment
42. Soffit Assembly - see 12/6.10
43. Cope Counter around Chase As Req'd
44. Removable piece of chair rail to 4" x 3" min access Trap Primer - provide removable fasteners into blocking

~~10~~ Patient Education  
 1/2" = 1'-0" (half size: 1/4" = 1'-0")

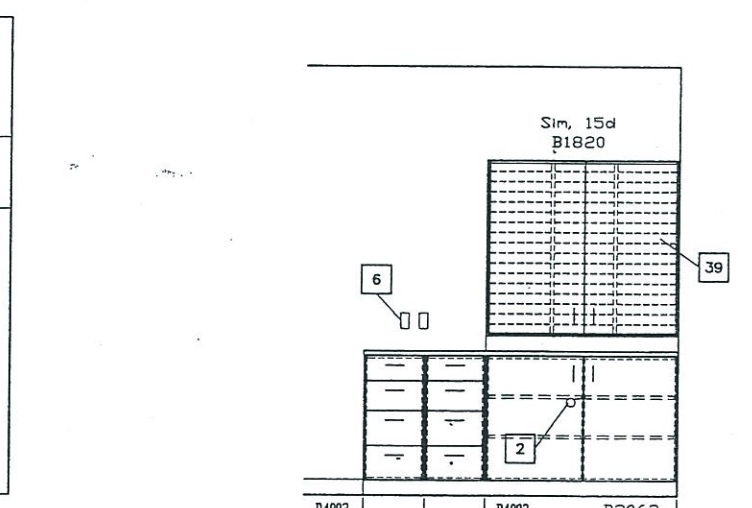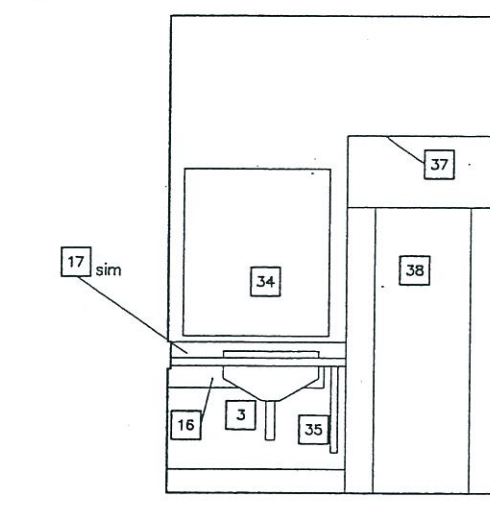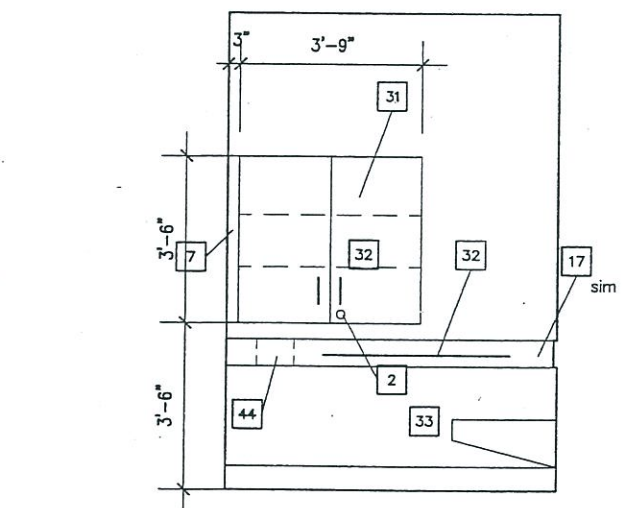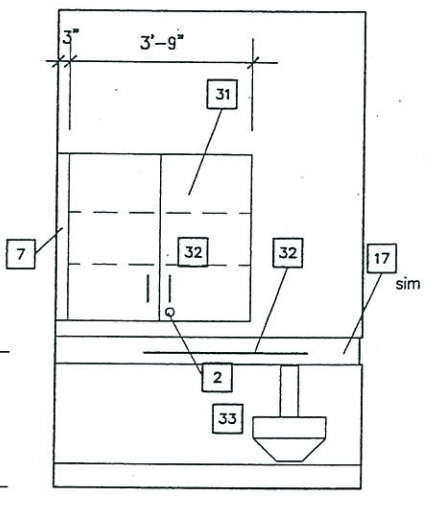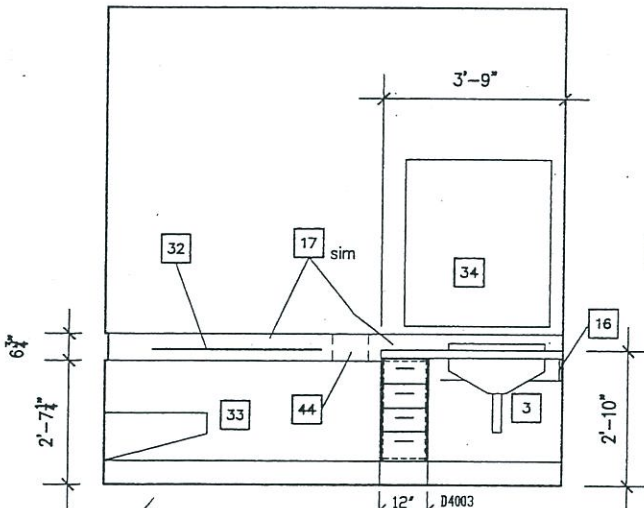





~~5~~ Patient Toilet 3  
 1/2" = 1'-0" (half size: 1/4" = 1'-0")

~~6~~ Patient Toilet 3  
 1/2" = 1'-0" (half size: 1/4" = 1'-0")

~~7~~ Staff Toilet  
 1/2" = 1'-0" (half size: 1/4" = 1'-0")

~~8~~ Staff Toilet  
 1/2" = 1'-0" (half size: 1/4" = 1'-0")

~~9~~ Reception  
 1/2" = 1'-0" (half size: 1/4" = 1'-0")

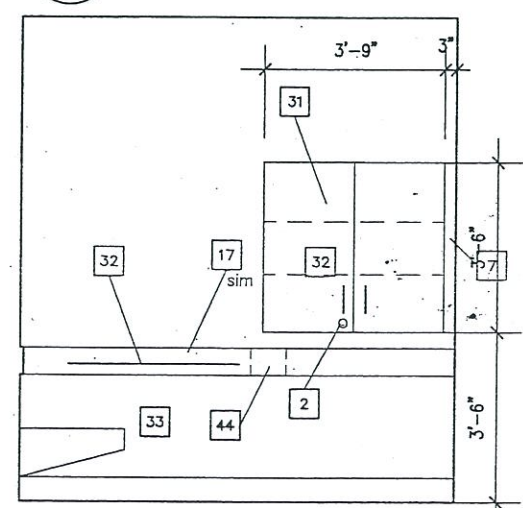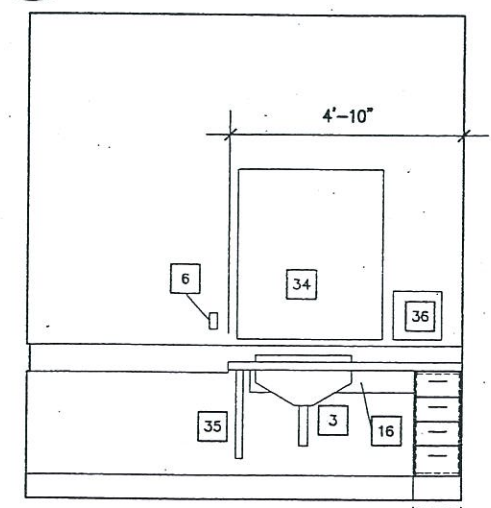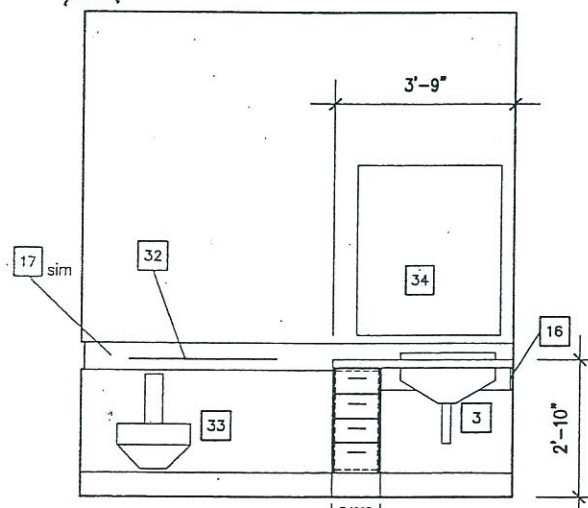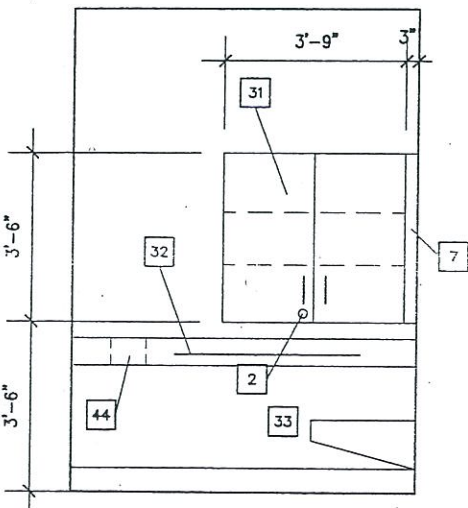

~~1~~ Patient Toilet 1  
 1/2" = 1'-0" (half size: 1/4" = 1'-0")

~~2~~ Patient Toilet 1  
 1/2" = 1'-0" (half size: 1/4" = 1'-0")

~~3~~ Patient Toilet 2  
 1/2" = 1'-0" (half size: 1/4" = 1'-0")

~~4~~ Patient Toilet 2  
 1/2" = 1'-0" (half size: 1/4" = 1'-0")


**Medical Design Group**  
 Architecture for Health Care  
 2716 WESTLAND PLACE  
 BOISE, IDAHO 83704-5863  
 BOISEARCHITECT@AOL.COM  
 Fax (208) 378-1405  
 Phone (208) 378-0817  
 © COPYRIGHT: MEDICAL DESIGN GROUP

REGISTERED ARCHITECT  
 No. AR-1740  
 22 March 2004  
 DAVID R. DAVIES  
 STATE OF IDAHO

INTERIOR ELEVATIONS  
 Desert Sage Health Center  
 2280 American Legion Blvd.  
 Mountain Home, Idaho  
 SHEET 7.12  
 Mar 2004 ds712.dwg 03/16/04 21:26

c:\Program Files\AutoCAD Architectural 2\TEMPLATE\mdg.dwt March 2003





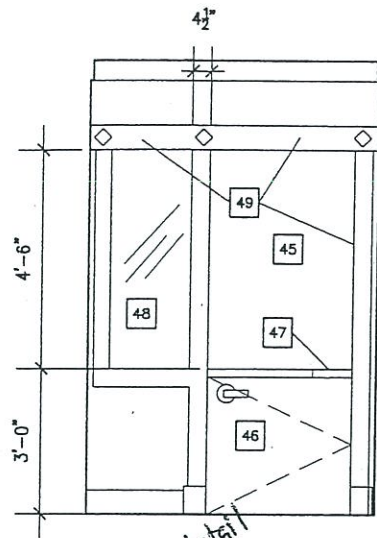

Keynotes:

- |   |  |   |  |
|---|--|---|--|
| 1. OFOI Rolling Computer Cart   | 15. OFOI Controller  | 31. 6" deep cabinet recessed into Stud Space  | 45. Open to Reception beyond                         |
| 2. Cabinet Lock typical   | 16. Counter Top Cleat  | 32. Grab Bar  | 46. Dutch Door with 8" min. wide shelf               |
| 3. Sink - See Mech  | 17. Chair Rail - See detail 6/5.21                             | 33. Wall Mounted Toilet   | 47. Bevel Door Shelf to allow door to open           |
| 4. Full Height 3/4" thick PLam Backsplash   | 18. Set Rail in Clear Silicon Caulking at Counter top          | 34. Mirror - <del>OFOI OFCI</del>   | 48. Glazing  |
| 5. Paper Towel Dispenser  | 19. OFOI Refrigerator  | 35. Knee Brace into Solid blocking  | 49. Modified frame type A                            |
| 6. Electrical Device  | 20. Decorative Wood Trim Around Light Switch See detail 8/5.21 | 36. Specimen Pass-Through   | 50. Light Stained Oak Veneer Plywood                 |
| 7. Filler Panel as required   | 21. Applied Wood Moulding - Stained Dark                       | 37. Furr Down hard Ceiling over Shower  | 51. Wall Mounted Light                               |
| 8. Under Counter Light Fixture  | 22. Stained Hardwood Veneer Plywood                            | 38. Pre-Manufactured Shower Assembly  | 52. Sliding Reception Window                         |
| 9. OFOI U.C. Refrigerator - Verify size   | 23. Solid Surface Counter Top                                  | 39. Two Vert. Dividers and 1/4" horiz. dividers at 2 1/8" o.c. behind two doors                                 | 53. Recessed Light Fixture in Soffit                 |
| 10. OFOI Microwave - Verify Size  | 24. Stained Wood Moulding                                      | 40. Chase as Required for Electrical  | 54. OFOI Tackboard                                   |
| 11. Vertical 3/8" thick masonite dividers @ 3 1/2" o.c. Depth of slot: 16" with false back. | 25. Wider Counter Top Area - See Plan                          | 41. Ventillate Cabinet for Owner Equipment  | 55. PLam Counter top                                 |
| 12. OFOI Floor Mounted Equipment - Verify size  | 26. Skylight Shaft   | 42. Soffit Assembly - see 12/6.10   | 56. 1/4" masonite shelf dividers 2" o.c. (removable) |
| 13. OFOI Computer Monitor   | 27. Fabric Wall Covering over 1/2" Cork brd.                   | 43. Cope Counter around Chase As Req'd  | 57. Specimen Pass-through                            |
| 14. Lead Shielded Window and Frame  | 28. Crown Moulding - see 1/5.21                                | 44. Removable piece of chair rail to 4" x 3" min access Trap Primer - provide removable fasteners into blocking |  |
|   | 29. Floor Base   |   |  |
|   | 30. OFOI Keyboard Pull-Out                                     |   |  |



5 Check-Out Door  
1/2" = 1'- 0" (half size: 1/4" = 1'-0")

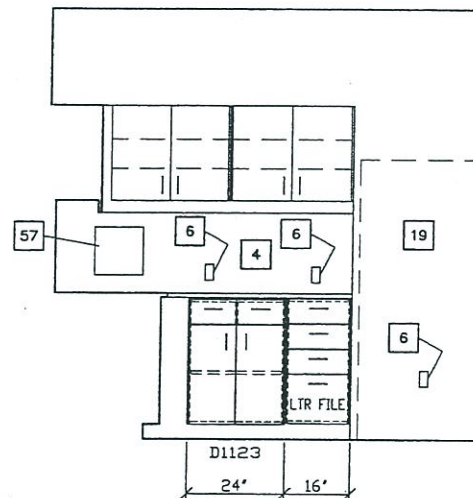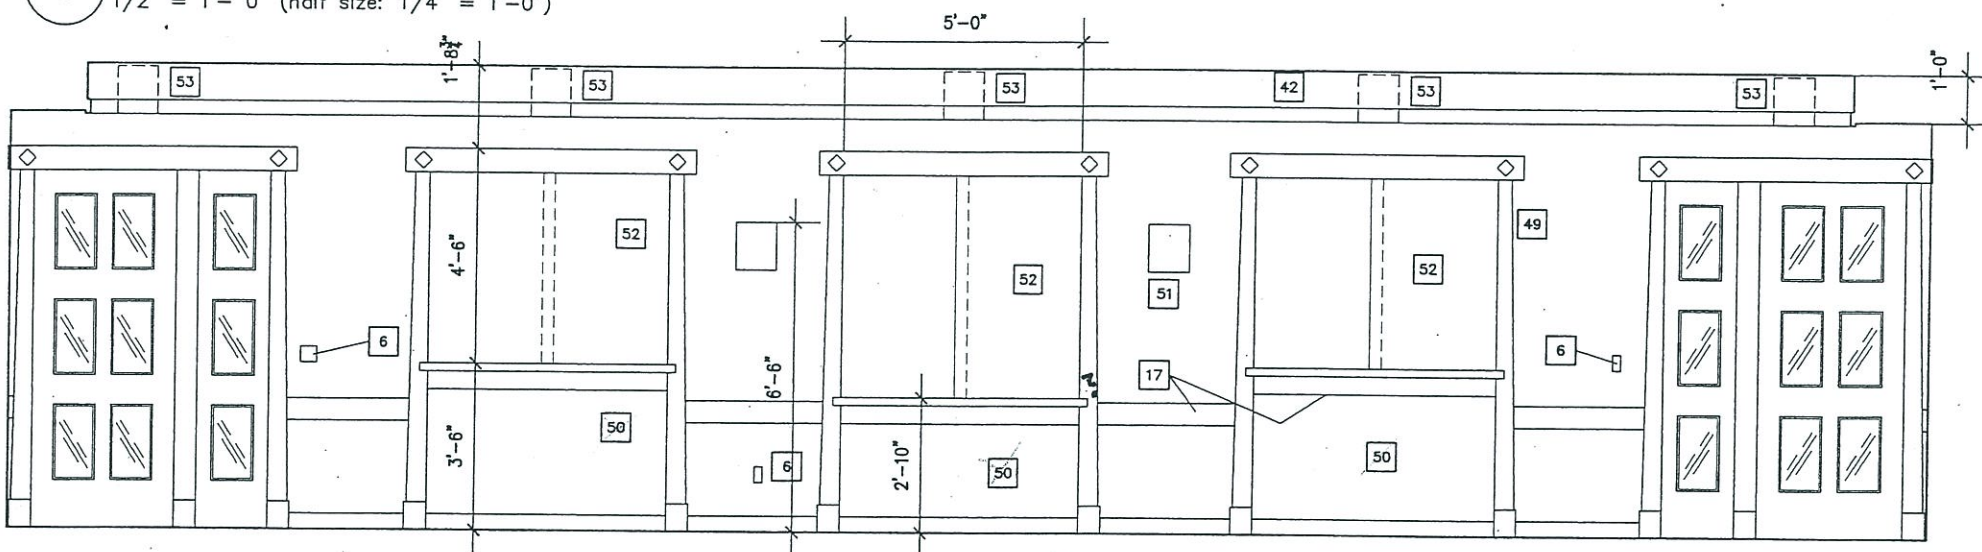

3 Reception Counter  
1/2" = 1'- 0" (half size: 1/4" = 1'-0")

Dimensions?

Work 1  
1/2" = 1'- 0" (half size: 1/4" = 1'-0")

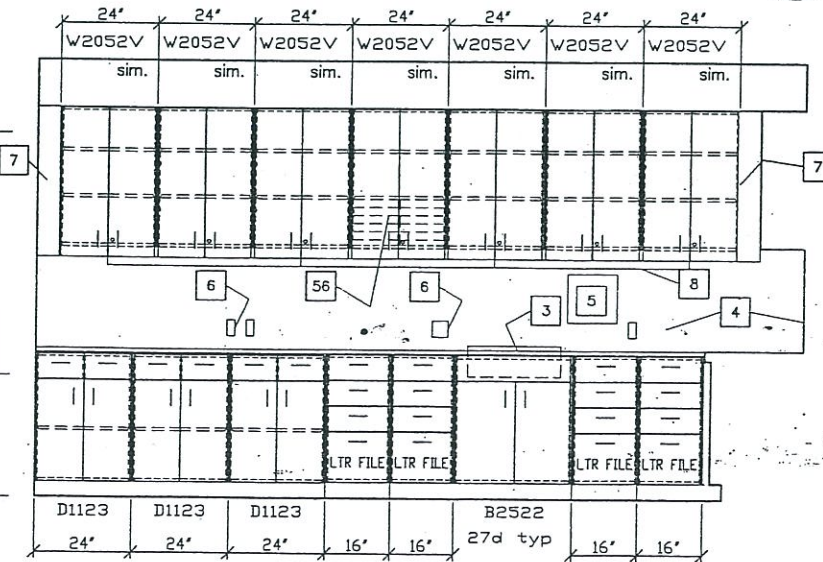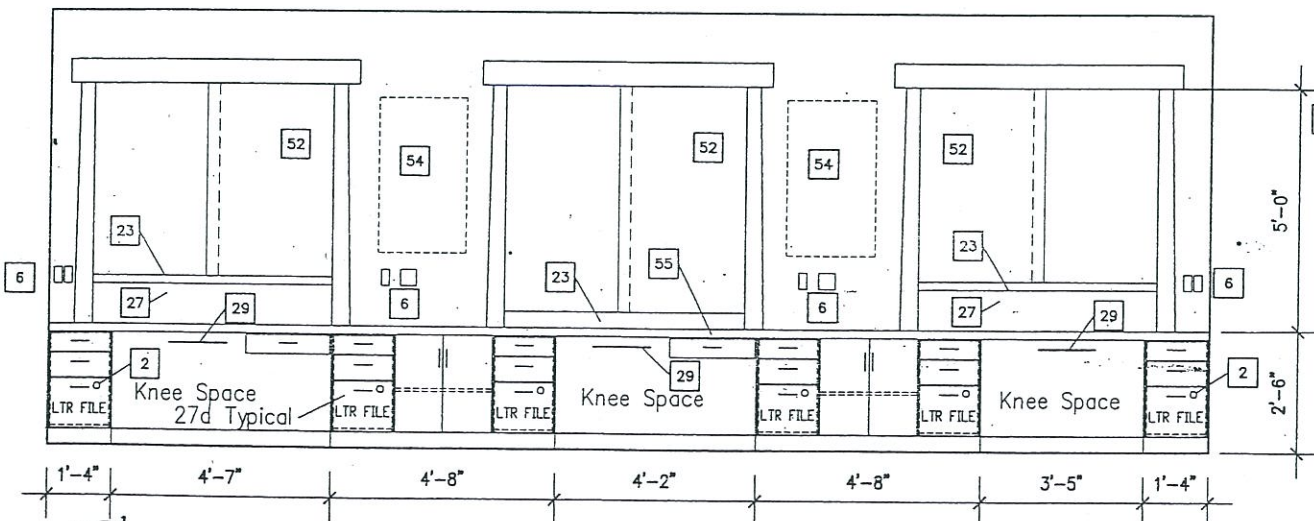

Reception Counter  
1/2" = 1'- 0" (half size: 1/4" = 1'-0")

Work 1  
1/2" = 1'- 0" (half size: 1/4" = 1'-0")

**Medical Design Group**  
Architecture for Health Care  
2716 WESTLAND PLACE  
BOISE, IDAHO 83704-5863  
BOISEARCHITECT@AOL.COM  
Fax (208) 378-1405  
Phone (208) 378-0817

REGISTERED ARCHITECT  
No. AR-1740  
22 March 2004

DAVID R. DAVIES  
STATE OF IDAHO

COPYRIGHT: MEDICAL DESIGN GROUP


INTERIOR ELEVATIONS

Desert Sage Health Center  
2280 American Legion Blvd.  
Mountain Home, Idaho


SHEET  
7.13

Mar 2004 ds713.dwg 03/22/04 20:39


- |  |   |  |   |  |
|--|---|--|---|--|
| 1. OFOI Rolling Computer Cart  | 15. OFOI Controller   | 31. 6" deep cabinet recessed into Stud Space   | 45. Open to Reception beyond                          | 60. Counter Recessed OFCI Dental Ultra Sonic Cleaner |
| 2. Cabinet Lock typical  | 16. Counter Top Cleat   | 32. Grab Bar   | 46. Dutch Door with 8" min. wide shelf                | 61. Pull out drawer for Dental Statum Sterilizer     |
| 3. Sink - See Mech   | 17. Chair Rail - See detail 6/5.21                                | 33. Wall Mounted Toilet  | 47. Bevel Door Shelf to allow door to open            | 62. Counter mounted Dental Auto-clave Sterilizer     |
| 4. Full Height 3/4" thick PLam Backsplash  | 18. Set Rail in Clear Silicon Caulking at Counter top             | 34. Mirror - <del>OFOI OFCI</del>  | 48. Glazing   | 63. Plaster Trap                                     |
| 5. Paper Towel Dispenser   | 19. OFOI Refrigerator   | 35. Knee Brace into Solid blocking   | 49. Modified frame type A                             | 64. Model Trimmer                                    |
| 6. Electrical Device   | 20. Decorative Wood Trim Around Light Switch<br>See detail 8/5.21 | 36. Specimen Pass-Through  | 50. Light Stained Oak Veneer Plywood                  | 65. Wall Mounted air Valve                           |
| 7. Filler Panel as required  | 21. Applied Wood Moulding - Stained Dark                          | 37. Furr Down hard Ceiling over Shower   | 51. Wall Mounted Light                                | 66. Call Light Panel                                 |
| 8. Under Counter Light Fixture   | 22. Stained Hardwood Veneer Plywood                               | 38. Pre-Manufactured Shower Assembly   | 52. Sliding Reception Window                          | <del>52. Sliding Reception Window</del>              |
| 9. OFOI U.C. Refrigerator - Verify size  | 23. Solid Surface Counter Top                                     | 39. Two Vert. Dividers and 1/4" horiz. dividers<br>at 2 1/8" o.c. behind two doors                                 | 53. Recessed Light Fixture in Soffit                  | <del>53. Recessed Light Fixture in Soffit</del>      |
| 10. OFOI Microwave - Verify Size   | 24. Stained Wood Moulding   | 40. Chase as Required for Electrical   | 54. OFOI Tackboard                                    | <del>54. OFOI Tackboard</del>                        |
| 11. Vertical 3/8" thick masonite dividers @ 3 1/2" o.c.<br>Depth of slot: 16" with false back. | 25. Wider Counter Top Area - See Plan                             | 41. Ventilatte Cabinet for Owner Equipment   | 55. PLam Counter top                                  |  |
| 12. OFOI Floor Mounted Equipment - Verify size   | 26. Skylight Shaft  | 42. Soffit Assembly - see 12/6.10  | 56. 1/4" masonite shelf dividers 2" o.c. (removable)  |  |
| 13. OFOI Computer Monitor  | 27. Fabric Wall Covering over 1/2" Cork brd.                      | 43. Cope Counter around Chase As Reg'd   | 57. Specimen Pass-through                             |  |
| 14. Lead Shielded Window and Frame   | 28. Crown Moulding - see 1/5.21                                   | 44. Removable piece of chair rail to 4" x 3" min access<br>Trap Primer - provide removable fasteners into blocking | 58. OFOI Floor Mounted ditigal x-ray                  |  |
|  | 29. Floor Base  |  | 59. Masonite Dividers to support Dental Tray - verify |  |
|  | 30. OFOI Keyboard Pull-Out  |  |   |  |

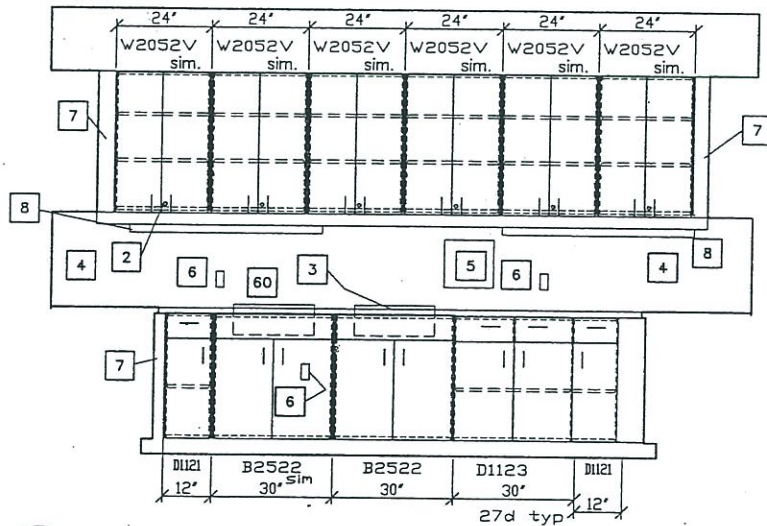


3 Dental Sterilization  
1/2" = 1'-0" (half size: 1/4" = 1'-0")

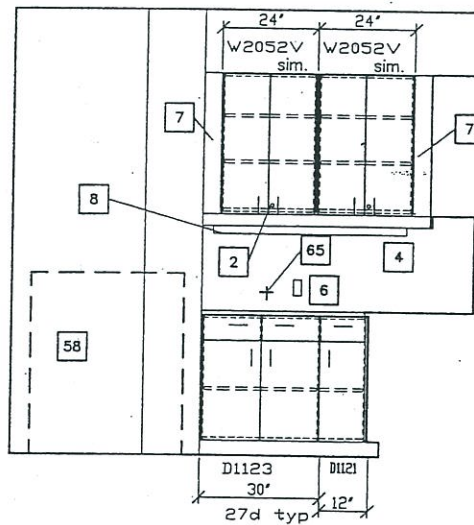


4 Dental Sterilization  
1/2" = 1'-0" (half size: 1/4" = 1'-0")

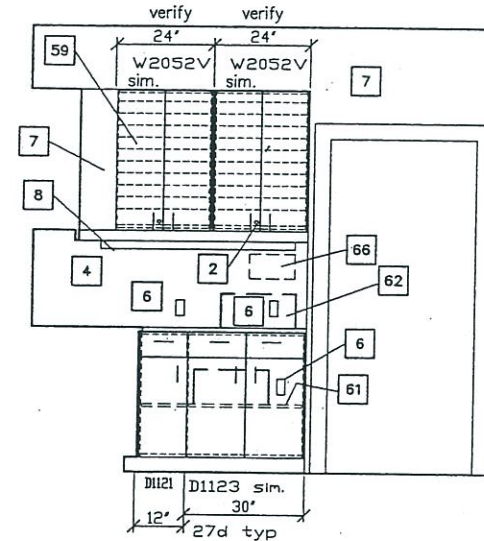


5 Dental Sterilization  
1/2" = 1'-0" (half size: 1/4" = 1'-0")

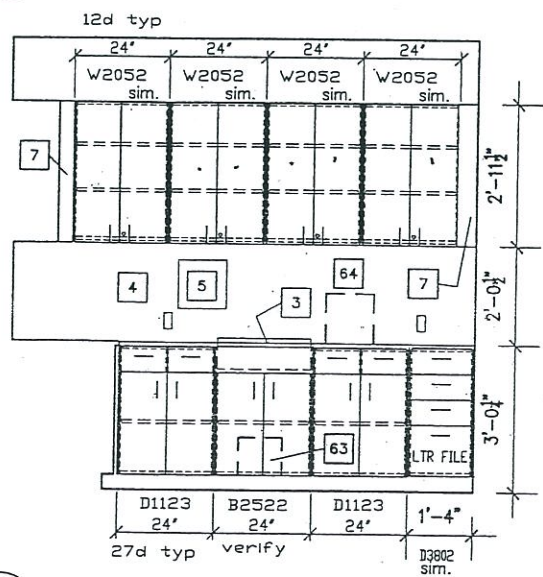

1 Dental Lab  
1/2" = 1'-0" (half size: 1/4" = 1'-0")

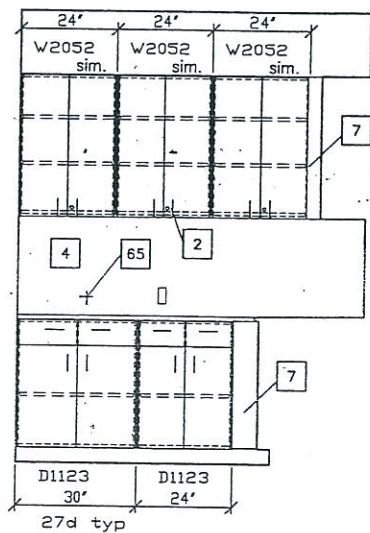

2 Dental Lab  
1/2" = 1'-0" (half size: 1/4" = 1'-0")



**Medical Design Group**  
Architecture for Health Care

2716 WESTLAND PLACE  
BOISE, IDAHO 83704-5863

BOISEARCHITECT@AOL.COM  
Fax (208) 378-1405  
Phone (208) 378-0817

© COPYRIGHT: MEDICAL DESIGN GROUP

---

REGISTERED ARCHITECT  
No. AR-1740  
22 March 2004

DAVID R. DAVIES  
STATE OF IDAHO

**INTERIOR ELEVATIONS**

Desert Sage Health Center SHEET  
2280 American Legion Blvd. 7.14  
Mountain Home, Idaho

Mar 2004 ds714.dwg 03/22/04 21:59

**TREASURE VALLEY MEDICAL PHYSICS, INC.**

2475 Parkside Dr.  
Boise, Idaho 83712  
(208) 345-7490

October 21, 2003

David R. Davies A.I.A.  
2716 Westland Place  
Boise, ID. 83704

Dear Mr. Davies:

The general objective of radiation shielding is to provide protection for both the radiation worker as well as the general public. To meet this need, the walls in the Desert Sage Health Center which will be located in Mountain Home, Idaho, will need to be lined with lead. In general, the walls will need to be shielded to a height of seven (7) feet. All openings and switch or receptacle boxes will have to be backed with shielding material (preferably lead). All penetrations for fasteners in the shielding will have to be backed with lead. There is no occupancy above or below the x-ray room, therefore no shielding is required for the floor or ceiling.

The following shielding recommendations were arrived at using NCRP 49, and The Health Physics and Radiological Health Handbook (1992). You provided the drawings for the room layout with the x-ray machine placement. Workloads used in the calculations were for a busy installation.

Please see the enclosed data set for the specifications.

Early visual inspection of the rooms during construction by a Medical Physicist is advantageous to ensure compliance with the specifications and possible revealing of faulty materials or workmanship. If there are problems they can be remedied more economically at this early stage.

Thank you for letting me be of service. If you have any questions, please feel free to call.

Sincerely,



Roger G. Stano, M.S., FACR  
Medical Physicist

**SPECIFICATIONS**

**DESERT SAGE HEALTH CENTER  
MOUNTAIN HOME, IDAHO**

OCTOBER 21, 2003

North wall	- Common to corridor and chest board	4.0 lbs./sq. ft. lead
Northwest wall and door		4.0 lbs./sq. ft. lead
East Wall	- Common to work area	3.0 lbs./sq. ft. lead
Operators console area and window		4.0 lbs./sq. ft. lead
West Wall	- Common to nursing	3.0 lbs./sq. ft. lead
South wall	- common to work area	3.0 lbs./sq.ft. lead
Floor and ceiling		none required

*RGS  
10-21-03*

**13.01 Radiation Protection**

1. Includes Lead Backed Gypsum Board, Lead Sheet Accessories, Gypsum Panel Fasteners, Lead Lined flush wood doors, Lead Lined Steel telescopic viiw window frames, Radiation resistant glass, Glazing accessories.
2. References: NCRP Report No. 49, Structural Shielding Design and Evaluation for Medical Use of X-rays and Gamma Rays of Energies up to 10 MeV.

**3. System Description:**

- A. Installed radiation protection materials shall comply with National Council on Radiation Protection, NCRP Report No. 49 for diagnostic rooms.
- B. Electrical installer shall install electrical boxes centered between studs and connect conduit at the top of electrical boxes, where possible at walls with lead lining.


4. Submittals: Product Data, Shop Drawings, Certificates, Door Hardware, Site Inspection Report prepared by a Radiation shielding inspector within 10 days after site inspection of exposed radiation resistant assemblies.

5. Distributors: Wave Barriers, Shielded Building Materials, 20811 NW Cornell Rd. Ste 500, Hillsboro, OR 97124-9804 Bill Zander 1-800-498-1460

**6. Components:**

- A. Lead Backed Gypsum Board Panels: ASTM C36, Beveled, Type X with lead backing sheet backing meeting FS QQ-L-201, Grade C.
- B. Lead Sheet Accessories: FS QQ-L-201, Grade C. Batten Strips: Same thickness or greater as lead sheet on back face of adj. Wall panels, 2" wide, 7 feet long.
- C. Wall Penetration Covers: Same thickness or greater than thickness of lead sheet on back face of adjacent wall panels. Size as required for not less than 1 inch wide lap with lead sheet on back face of adjacent wall panels.
- D. Fastener Tabs: Same or greater thickness than thickness of lead sheet on back face of adjacent wall panels. Size not less than 1 inch wide by 2 inches long. Note: these tabs are used for screw application of gypsum panels to steel studs without batten strips and for all wood studs. See details.
- E. Door Jamb Lining: Same or greater thickness than thickness of lead sheet on back face of adjacent wall panels. Size 7 foot long by width required by door frame.
- F. Lockset Rose and Knob Lining: Same or greater thickness than thickness of lead sheet within adjacent door. Size as required to fill lockset rose and knob.
- G. Frame Lining: Same or greater thickness than thickness of lead sheet on back face of adjacent wall panels. Continuous length at head and jamb, 3 pieces with 1 inch laps at frame corners.
- G. Gypsum Panels Fasteners: Screws: ASTM 1002, 1 inch long, bugle head. Adhesive: ASTM C557.
- H. Radiation Shielding Glass: Glass type: Polished radiation shielding

(Window)



**Medical Design Group**  
Architecture for Health Care  
2716 WESTLAND PLACE  
BOISE, IDAHO 83704-5863  
BOISEARCHITECT@AOL.COM  
Fax (208) 378-1405  
Phone (208) 378-0817

© COPYRIGHT: MEDICAL DESIGN GROUP

---

REGISTERED ARCHITECT  
No. AR-1740  
15 March 2004

**X-RAY SPECS/DETAILS**

Desert Sage Health Center  
2280 American Legion Blvd.  
Mountain Home, Idaho

**SHEET 13.01**

Feb 2004 dsl301.dwg 11/17/03 15:59

glass containing not less than 50 percent lead oxide. Glass Quality:  
 Surface: Mirror polished, 1/4" thick min. Lead Equivalency of Glass: 1.58 mm min.  
 I. Glazing Accessories: Setting Blocks: Solid Neoprene, 80 to 90 Shore A hardness. Glazing Tape: Foam neoprene.

7. Lead Lined Flush Wood Doors: AWI Custom PC-5, Lead Lined, Face Veneer to match other wood doors in facility as specified in section 08. Thickness: 1 3/4". Finish: comply with requirements of section 09. Door fitting requirements: 1/8" space max at perimeter except 1/2" max space at door bottom.

8. Lead Lined steel Telescopic View Window Frames: Frame: ASTM A568 and ASTM 366 with Lead Sheet Lining FS QQ-L-201, Grade C, single un-pierced strip, 1/16" thick. Frame Profile: 2 inches wide with 7/16 inch high integral fixed stop and 16 gauge applied cold rolled steel stop. Frame Construction: Two telescoping steel frames with continuous welded corner seams and lead sheet applied with adhesive to inside face of the outside frame, shop primed.


9. Execution:

- A. Installation of Radiation Resistant Wall Assemblies: Screw lead battens to steel studs at 12 inches o.c. from floor to ceiling. If wood studs are used, secure lead battens to wood studs with adhesive or brad nails from floor to ceiling behind vertical gypsum panel joints.
- B. Install lead backed gypsum board in compliance with GA-216 and ASTM C840. Install with long edges vertical. Install to within 1/4" of floor. Screw lead backed gypsum board to steel framing members at 8 inches o.c. at panel edges and 12 inches o.c. in the field. Utilize fastener tabs at wood studs.
- C. Install Steel Door Frames using adhesive to apply lead lining in door jambs. Otherwise, install in accordance with section 08.
- D. Install Wood Doors and Door Hardware to comply with AWI Quality Standards, Section 1700.
- E. Install Lead Lined Steel Telescopic View Window Frames setting unleaded frame plumb and square in wall opening on control room side of wall with shims. Set leaded frame inside unleaded frame on X-ray side of wall and compress adjustable frame against face of wall. Secure both frames with equal spaced screws through each jamb. Install setting blocks, shims and glazing tape in glazing channel to prevent glass from touching the steel frame. Install radiation resistant glazing in telescoping frame. Place steel stops.
- F. Install wall penetration covers by cutting the covers from lead sheet making allowance for required laps. Install penetrating wall boxes and raceways centered between studs using steel telescoping mounting brackets. Adhesive apply lead sheet penetration covers on penetrating boxes and raceways and return penetration covers to backside of lead backed wall panels with 1 inch minimum laps.
- G. Install pipe penetrations in Walls and Ceilings by wrapping pipe with wall penetration covers lapping lead joints 1 inch minimum. To prevent

radiation passage through pipe openings, offset pipe direction as close behind wall lead lining as possible so that the pipe can be backed with lead sheet sufficient to prevent radiation passage at an angle.

10. Completion:

- A. Prior to applying gypsum panels to back face of radiation resistant interior walls, employ a qualified radiation shielding inspector for field inspection of installed radiation resistant materials. Contractor to include cost for this inspection in price for construction. Written report to be issued to Architect and Owner within ten days of inspection. Repair and replace work found defective by radiation shielding inspector or testing by a qualified health physicist. Cost for re-inspection if necessary shall be borne by the contractor.
- B. Tape temporary paper signs on radiation resistant walls with the following text: "DO NOT MOUNT EQUIPMENT ON THIS WALL WITHOUT COVERING PENETRATING FASTENERS WITH LEAD SHEET OF THICKNESS REQUIRED BY ORIGINAL CONTRACT DOCUMENTS"

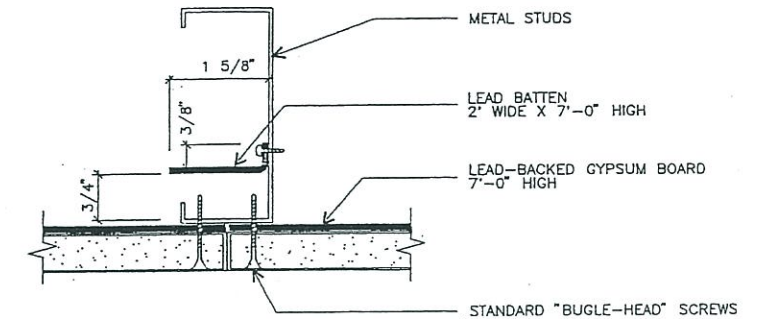

SCALE	1"=1'-0"	METAL STUD DETAIL	
DRAWN BY		PROJECT	DWG NO
CHECKED			A01
APPROVED			OF
PROJECT/JOB NUMBER	A01		
CAO F#			
REVISION DATE	5-21-90		
LAST PLOT DATE	5-31-90		

**Medical Design Group**  
 Architecture for Health Care  
 2716 WESTLAND PLACE  
 BOISE, IDAHO 83704-5863  
 BOISEARCHITECT@AOL.COM  
 Fax (208) 378-1405  
 Phone (208) 378-0817

REGISTERED ARCHITECT  
 No. AR-1740  
 15 March 2004


DAVID R. DAVIES  
 STATE OF IDAHO

X-RAY SPECS/DETAILS

Desert Sage Health Center  
 2280 American Legion Blvd.  
 Mountain Home, Idaho


SHEET  
 13.02

Feb 2004 dsl302.dwg 11/17/03 15:59

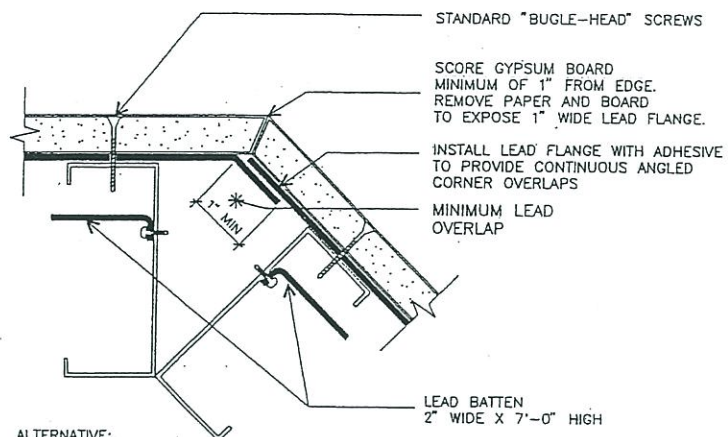


ALTERNATIVE:

IF CORNER IS CONSTRUCTED WITH (SUPPORT) BACKING DIRECTLY BEHIND THE ANGLE POINT, LEAD-BACKED GYPSUM BOARD MAY BE SCORED ON THE FACE AND "BROKEN" AROUND THE ANGLE POINT TO MAKE A CONTINUOUS SHIELDING BARRIER. (WILL REQUIRE ADDITION OF METAL CORNER GUARD.)

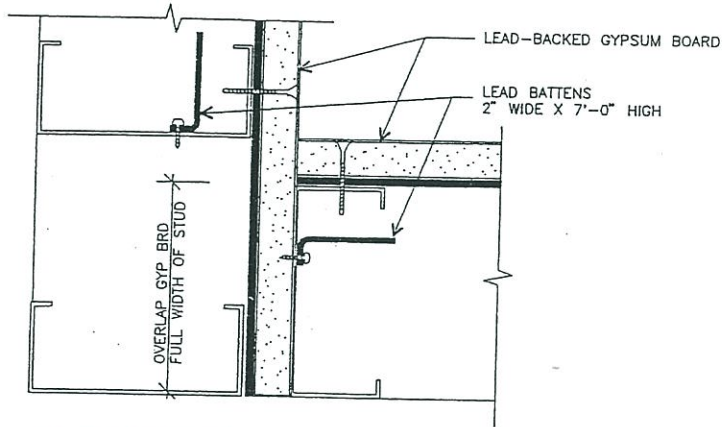

INSIDE CORNER

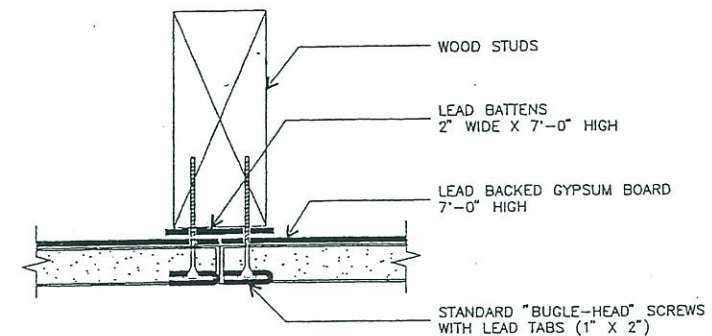

	SCALE	1/2"=1'-0"	<b>METAL STUD DETAIL</b>		DWG NO <b>A02</b>	REV
	DRAWN BY					
	CHECKED					
	APPROVED					
	PROJECT/JOB NUMBER					
CAD FILE	A02	PROJECT				
REVISION DATE	5-31-99					
LAST PLOT DATE	5-31-99					

	SCALE	1/2"=1'-0"	<b>METAL STUD DETAIL</b>		DWG NO <b>A03</b>	REV
	DRAWN BY					
	CHECKED					
	APPROVED					
	PROJECT/JOB NUMBER					
CAD FILE	A03	PROJECT				
REVISION DATE	5-31-99					
LAST PLOT DATE	5-31-99					

	SCALE	1/2"=1'-0"	<b>WOOD STUD DETAIL</b>		DWG NO <b>A05</b>	REV
	DRAWN BY					
	CHECKED					
	APPROVED					
	PROJECT/JOB NUMBER					
CAD FILE	A05	PROJECT				
REVISION DATE	5-31-99					
LAST PLOT DATE	5-31-99					

**Medical Design Group**  
 Architecture for Health Care  
 2716 WESTLAND PLACE  
 BOISE, IDAHO 83704-5863  
 BOISEARCHITECT@AOL.COM  
 Fax (208)-378-1405  
 Phone (208) 378-0817


REGISTERED ARCHITECT  
 No. AR-1740  
 15 March 2004

**X-RAY SPECS/DETAILS**

Desert Sage Health Center  
 2280 American Legion Blvd.  
 Mountain Home, Idaho


SHEET  
**13.03**

Feb 2004 dsl303.dwg 11/17/03 15:59

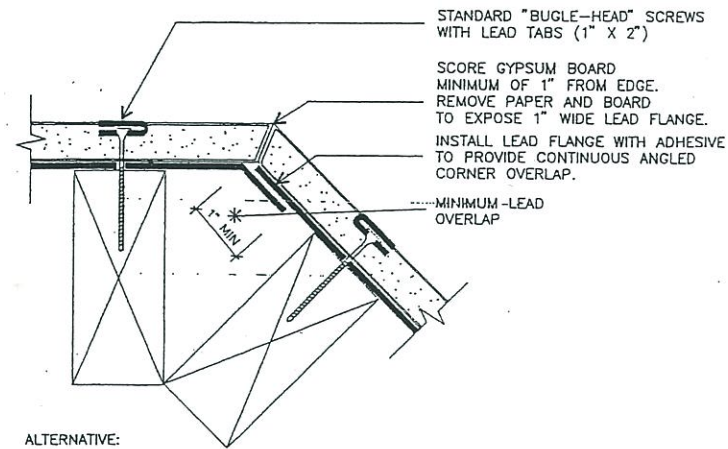


ALTERNATIVE:

IF CORNER IS CONSTRUCTED WITH (SUPPORT) BACKING DIRECTLY BEHIND THE ANGLE POINT, LEAD-BACKED GYPSUM BOARD MAY BE SCORED ON THE FACE AND "BROKEN" AROUND THE ANGLE POINT TO MAKE A CONTINUOUS SHIELDING BARRIER. (WILL REQUIRE ADDITION OF METAL CORNER GUARD.)

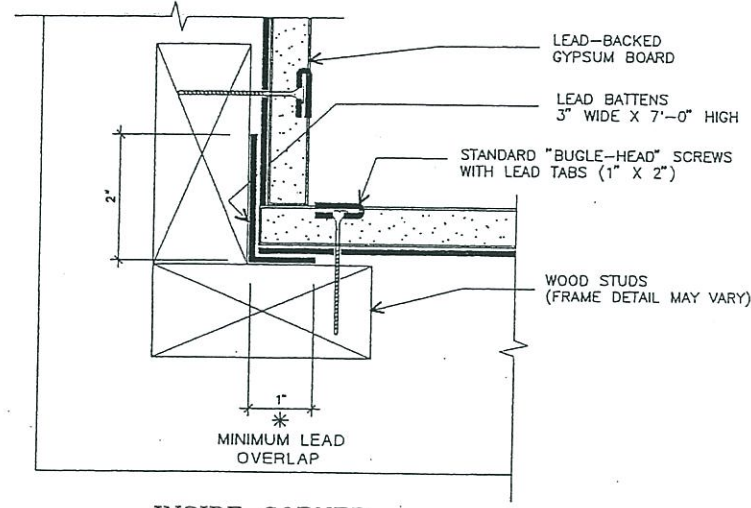

INSIDE CORNER

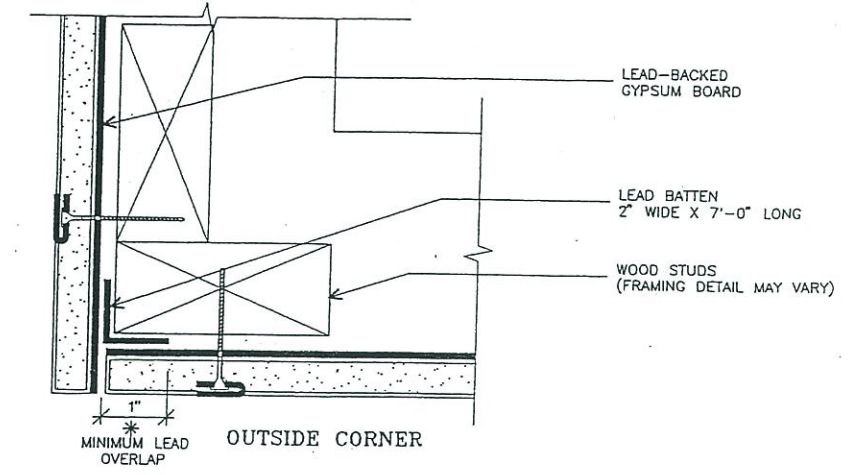

OUTSIDE CORNER

	SCALE	1"=1'-0"	WOOD STUD DETAIL		
	DRAWN BY				
	CHECKED				
	APPROVED				
	PROJECT/JOB NUMBER	A06	PROJECT	DWG NO	A06
	LAST PLOT DATE	5-31-90		REV	

	SCALE	1"=1'-0"	WOOD STUD DETAIL		
	DRAWN BY				
	CHECKED				
	APPROVED				
	PROJECT/JOB NUMBER	A07	PROJECT	DWG NO	A07
	LAST PLOT DATE	5-31-90		REV	

	SCALE	1"=1'-0"	WOOD STUD DETAIL		
	DRAWN BY				
	CHECKED				
	APPROVED				
	PROJECT/JOB NUMBER	A08	PROJECT	DWG NO	A08
	LAST PLOT DATE	5-31-90		REV	

**Medical Design Group**  
Architecture for Health Care

2716 WESTLAND PLACE  
BOISE, IDAHO 83704-5863

BOISEARCHITECT@AOL.COM  
Fax (208) 378-1405  
Phone (208) 378-0817

© COPYRIGHT: MEDICAL DESIGN GROUP




REGISTERED ARCHITECT  
No. AR-1740  
15 March 2004

**X-RAY SPECS/DETAILS**

Desert Sage Health Center  
2280 American Legion Blvd.  
Mountain Home, Idaho

SHEET  
**13.04**

Feb 2004 ds1304.dwg 11/17/03 15:58

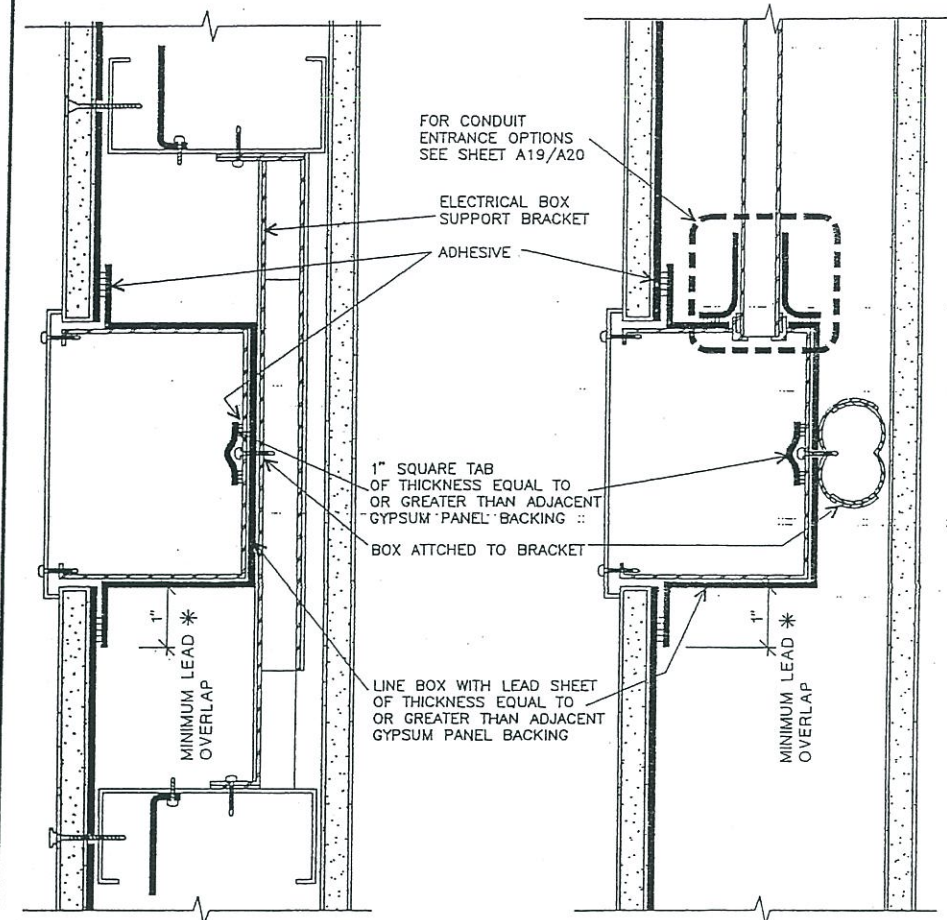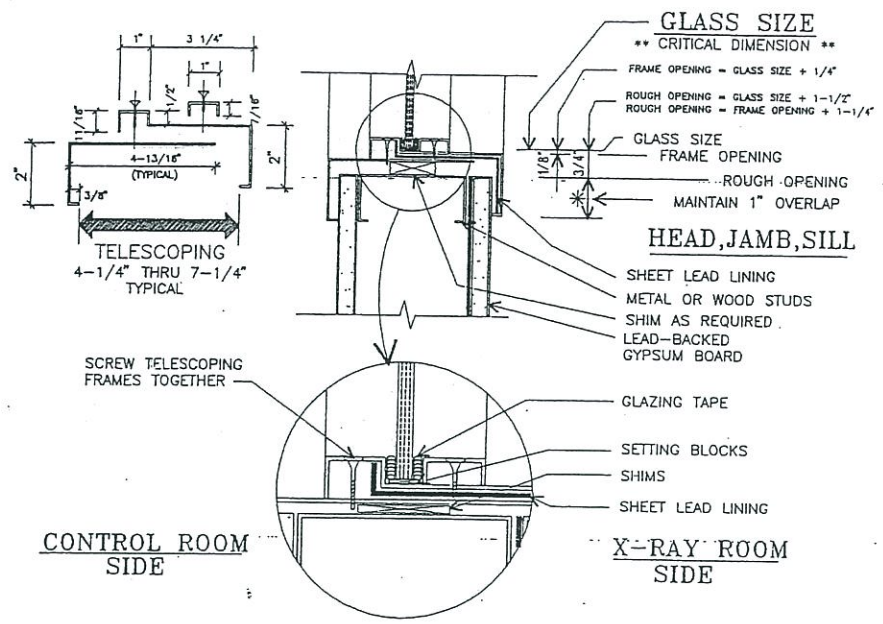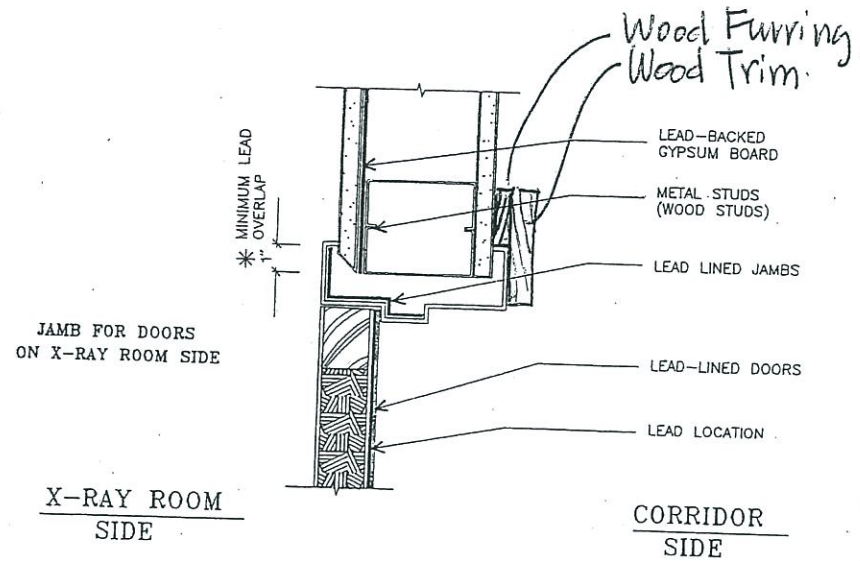

	SCALE	3'-11"	<b>DOOR, JAMB, ASTRAGAL</b>	PROJECT	DWG NO <b>A09</b>	REV
	DRAWN BY					
	CHECKED					
	APPROVED					
	PROJECT/JOB NUMBER					
	CAD FILE	A09				
REVISION DATE	5-31-99					
LAST PLOT DATE	5-31-99					

	SCALE	3'-11"	<b>STRAIGHT TELESCOPIC WINDOW</b>	PROJECT	DWG NO <b>A12</b>	REV
	DRAWN BY					
	CHECKED					
	APPROVED					
	PROJECT/JOB NUMBER	A12				
	CAD FILE	A12				
REVISION DATE	5-31-99					
LAST PLOT DATE	5-31-99					

	SCALE	6'-11"	<b>ELECTRICAL PANEL OR BOX</b>	PROJECT	DWG NO <b>A17</b>	REV
	DRAWN BY					
	CHECKED					
	APPROVED					
	PROJECT/JOB NUMBER					
	CAD FILE	A17				
REVISION DATE	5-31-99					
LAST PLOT DATE	5-31-99					

**Medical Design Group**  
Architecture for Health Care  
2716 WESTLAND PLACE  
BOISE, IDAHO 83704-5863  
BOISEARCHITECT@AOL.COM  
Fax (208) 378-1405  
Phone (208) 378-0817

© COPYRIGHT: MEDICAL DESIGN GROUP


REGISTERED ARCHITECT  
No. AR-1740  
15 March 2004

**X-RAY SPECS/DETAILS**

Desert Sage Health Center  
2280 American Legion Blvd.  
Mountain Home, Idaho

SHEET  
**13.05**


Feb 2004 dsl1305.dwg 11/17/03 15:58

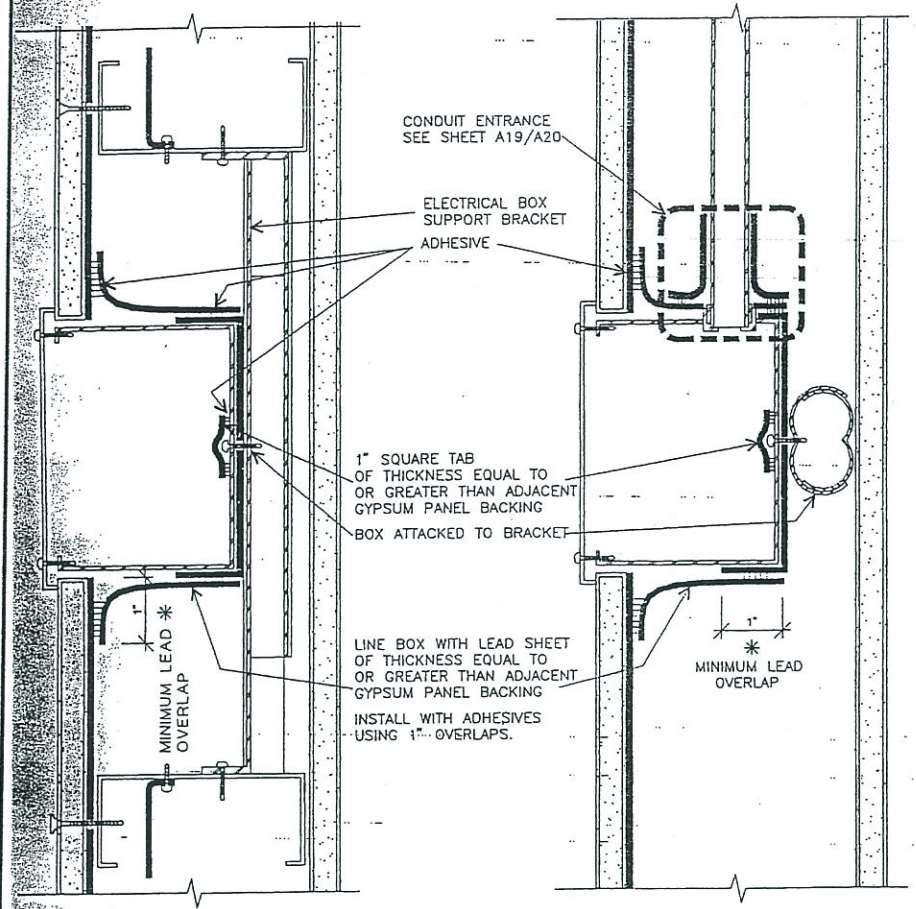

PLAN SECTION

**JOB-FORMED SHIELDING**


	SCALE	1"=1'-0"	ELECTRICAL PANEL OR BOX		
	DRAWN BY		PROJECT	DWG NO	REV
	CHECKED			A18	
	APPROVED				
	PROJECT/JOB NUMBER				
	CAD FILE	A18			
REVISION DATE	5-31-90				
LAST PLOT DATE	5-31-90				

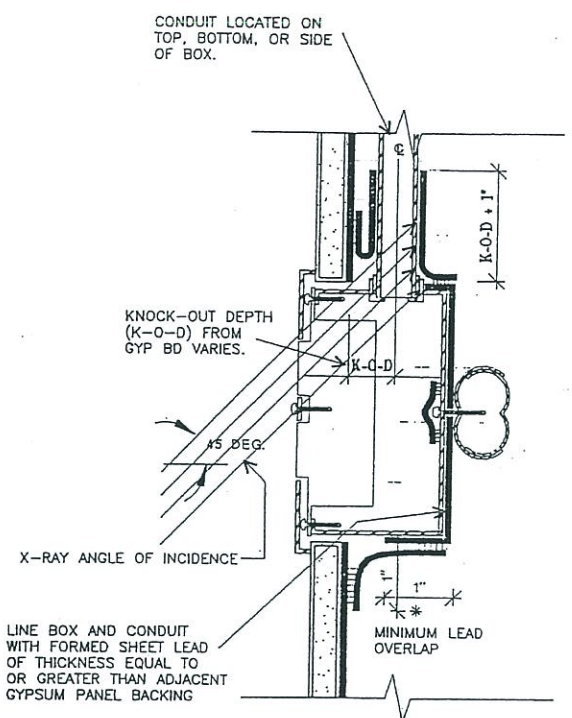

PLAN OR SECTION

**CONDUIT ENTRANCE SHIELDING**  
JOB-FORMED SHEET LEAD LINING

	SCALE	1"=1'-0"	CONDUIT ENTRANCE SHIELDING		
	DRAWN BY		PROJECT	DWG NO	REV
	CHECKED			A19	
	APPROVED				
	PROJECT/JOB NUMBER				
	CAD FILE	A18			
REVISION DATE	5-31-90				
LAST PLOT DATE	5-31-90				

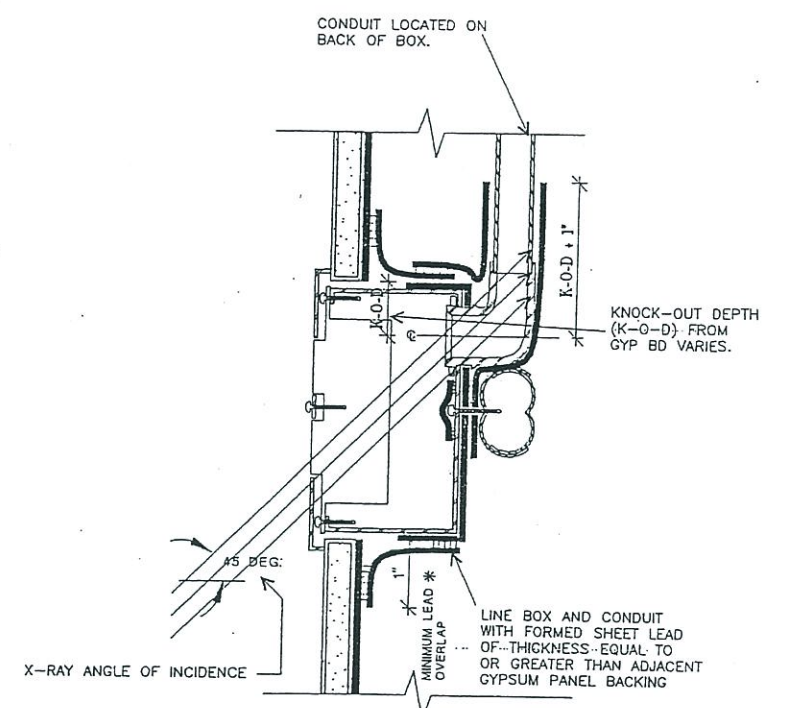

PLAN OR SECTION

**CONDUIT ENTRANCE SHIELDING**  
JOB-FORMED SHEET LEAD LINING


	SCALE	1"=1'-0"	CONDUIT ENTRANCE SHIELDING		
	DRAWN BY		PROJECT	DWG NO	REV
	CHECKED			A20	
	APPROVED				
	PROJECT/JOB NUMBER				
	CAD FILE	A20			
REVISION DATE	5-31-90				
LAST PLOT DATE	5-31-90				



**Medical Design Group**  
Architecture for Health Care

2716 WESTLAND PLACE  
BOISE, IDAHO 83704-5863  
BOISEARCHITECT@AOL.COM  
Fax (208) 378-1405  
Phone (208) 378-0817

© COPYRIGHT: MEDICAL DESIGN GROUP

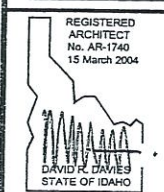

X-RAY SPECS/DETAILS

Desert Sage Health Center SHEET  
2280 American Legion Blvd.  
Mountain Home, Idaho 13.06

Feb 2004 ds1306.dwg 11/17/03 15:57



## PLUMBING AND PIPING ABBREVIATIONS

(E) EXISTING (F) FUTURE (N) NEW (D) DEPTH (L) LENGTH (W) WIDTH AT DIAMETER/PHASE ANGLE NUMBER/POUND	CW DOMESTIC COLD WATER CW/ COORDINATE WITH CWR CONDENSER WATER RETURN CWS CONDENSER WATER SUPPLY CX CONNECT TO EXISTING DBL DOUBLE DCBP DOUBLE CHECK BACKFLOW PREVENTOR DEG DEGREE DES DENTAL EQUIPMENT SUPPLIER DET DETAIL DIM DIMENSION DISCH DISCHARGE DN DOWN DSN DOWNSPOUT NOZZLE DSP DRY STANDPIPE DWG DRAWING	HW POTABLE HOT WATER SUPPLY HWC DOMESTIC HOT WATER RECIRC HWR HEATING WATER RETURN HWS HEATING WATER SUPPLY IA INSTRUMENT AIR IBC INTERNATIONAL BUILDING CODE ID INSIDE DIAMETER IDW INDIRECT WASTE IE INVERT ELEVATION IMC INTERNATIONAL MECHANICAL CODE IN INCH IND INDIRECT INSUL INSULATION INT INTERIOR IPC INTERNATIONAL PLUMBING CODE J-BOX JUNCTION BOX JST JOIST KWH KILOWATT KWH KILOWATT HOUR LAV LAVATORY LBS POUNDS LF LINEAL FEET/FOOT LPC LOW PRESSURE CONDENSATE LPG LIQUEFIED PETROLEUM GAS LPS LOW PRESSURE STEAM MAT MATERIAL MAX MAXIMUM MC MECHANICAL CONTRACTOR MECH MECHANICAL MEZZ MEZZANINE MFG MANUFACTURER MIN MINIMUM MISC MISCELLANEOUS MOP MOTOR OPERATED MPC MEDIUM PRESSURE CONDENSATE MPS MEDIUM PRESSURE STEAM MSG MANUFACTURED STANDARD GAUGE MTD MOUNTED MTG MOUNTING MTL METAL N NORTH N/A NOT APPLICABLE NC NORMALLY CLOSED NEC NATIONAL ELECTRIC CODE NFPA NATIONAL FIRE PROTECTION ASSOCIATION NG NATURAL GAS NIC NOT IN CONTRACT NO NORMALLY OPEN NOM NOMINAL NPW NON-POTABLE WATER NTS NOT TO SCALE NUM NUMBER OC ON CENTER OD OUTSIDE DIAMETER ODL OVERFLOW DRAIN LEADER OH OVERHEAD OFI OWNER FURNISHED OFI OWNER INSTALLED OFI OWNER FURNISHED CONTRACTOR INSTALLED OS&Y OUTSIDE STEM & YOKE OZ OUNCE	UNFIN UNFINISHED UNO UNLESS NOTED OTHERWISE UPC UNIFORM PLUMBING CODE V VENT/VOLT VA VALVE VAC VACUUM VEL VELOCITY VENT VENTILATION VERT VERTICAL VFI VERIFY IN FIELD VIL VOLUME VIR VACUUM RELIEF VALVE VTR VENT THRU ROOF W WEST/WASTE W/ WITH W/O WITHOUT WC WATER CLOSET/WATER COLUMN WCO WALL CLEANOUT WH WATERHEATER WP WATERPROOF WPD WATER PRESSURE DROP WT WEIGHT CO2 CARBON DIOXIDE HE HELIUM MA MEDICAL AIR MV MEDICAL VACUUM N2 NITROGEN N2O NITROUS OXIDE O2 OXYGEN WAGD WASTE ANESTHETIC GAS DISPOSAL
---	---	--	--

### MEDICAL GAS

## PLUMBING DRAWINGS GENERAL NOTES:

- PRINTS MUST BE REVIEWED FOR ACCURACY BEFORE STARTING THE JOB. ABSOLUTE ACCURACY OF THE DRAWINGS AND SPECIFICATIONS CANNOT BE GUARANTEED. WHILE EVERY EFFORT HAS BEEN MADE TO COORDINATE THE LOCATIONS OF EQUIPMENT & PIPING, IT IS THE RESPONSIBILITY OF THE CONTRACTOR TO COORDINATE EXACT REQUIREMENTS GOVERNED BY ACTUAL JOB CONDITIONS. CHECK ALL INFORMATION AND REPORT ANY DISCREPANCIES BEFORE SUBMITTING BID OR FABRICATING AND INSTALLING WORK.
- THESE GENERAL NOTES APPLY TO ALL PLUMBING DRAWINGS IN THIS SET AND SHOULD BE TREATED AS IF THEY ARE REFERENCED TO THE ENTIRE SET.
- THE CONTRACTOR IS TO PROVIDE A FULLY OPERATIONAL WASTE AND VENT AND DOMESTIC WATER SYSTEM. THE CONTRACTOR IS TO INSTALL ALL OF THE PIPING, ACCESSORIES, AND FIXTURES PER THE 2000 IPC, IMC, IBC, NFPA, AND THE AHJ (AUTHORITY HAVING JURISDICTION). NOTHING IN THESE PLANS IS TO BE INTERPRETED AS TO ALLOW THE CONTRACTOR TO PROVIDE INSTALLATIONS THAT ARE NOT PER CODE OR THE AHJ.
- ALL DESIGN PRODUCT DATA IS FOR THE ITEM LISTED ONLY. SUBMITTAL DEVIATIONS WILL BE THE SOLE RESPONSIBILITY OF THE CONTRACTOR. REVIEW BY THE ARCHITECT OR ENGINEER DOES NOT RELIEVE THE CONTRACTOR FROM HIS RESPONSIBILITIES FOR THE PRODUCT TO PERFORM OR PHYSICALLY FIT FOR THE APPLICATION AS INDICATED IN THESE DRAWINGS. ALL COORDINATION FOR THE NEW PRODUCT WITH THE OTHER TRADES IS THE SOLE RESPONSIBILITY OF THE CONTRACTOR. THIS INCLUDES, BUT IS NOT LIMITED TO, PHYSICAL DIMENSIONS, WEIGHTS, ELECTRICAL CHARACTERISTICS, ETC. NO ADDITIONAL COSTS TO THE OWNER WILL BE ALLOWED DUE TO SUBSTITUTIONS.
- THE CONTRACTOR FOR THIS WORK NEEDS TO PROVIDE ALL CONNECTIONS TO THE CIVIL WORK FOR ALL UTILITIES AND SERVICES SPECIFIED OR DRAWN IN THIS SET.
- ALL PIPING INSTALLED IN EXTERIOR WALLS SHALL BE INSTALLED ON WARM SIDE OF INSULATION.
- CONTRACTOR TO VERIFY ALL DENTAL TERMINATIONS, TYPE AND LOCATION, WITH THE OWNER AND DENTAL EQUIPMENT SUPPLIER (D.E.S.) PRIOR TO INSTALLATION.
- INFORMATION REGARDING THE SIZE AND LOCATION OF EXISTING UTILITIES IS BASED ON OUR UNDERSTANDING OF THE EXISTING SYSTEMS. THERE ARE NO AS-BUILT OR VERIFIED DESIGN DRAWINGS AVAILABLE. ALL EXISTING CONDITIONS THAT COULD AFFECT THIS INSTALLATION SHALL BE VERIFIED BY THIS CONTRACTOR PRIOR TO BEGINNING NEW WORK.
- ALL MEDICAL AIR, MEDICAL VACUUM LINES TO BE TYPE "K" OR "L" COPPER, PRE-CLEANED, DEGREASED, AND CAPPED. SYSTEMS MUST BE TESTED FOR LEAKS WITH DRY NITROGEN FOR 24 HOURS AT 150 PSI. ALL JOINTS MUST BE SILVER SOLDERED WITH 1000° F MELTING POINT.

NOTE: ALL ABBREVIATIONS LISTED ABOVE MAY NOT APPEAR ON THESE DOCUMENTS.

## PLUMBING LEGEND

SYMBOL	DESCRIPTION	SYMBOL	DESCRIPTION
SS	SANITARY SEWER		PRESSURE REDUCING VALVE
CW	DOMESTIC COLD WATER		BALL VALVE
HW	DOMESTIC HOT WATER		GATE VALVE
V	WASTE VENT		ADA RATED NATURAL GAS VALVE
NG	NATURAL GAS		UNION
RDL	ROOF DRAIN LEADER		HOSE BIBB
ODL	OVERFLOW DRAIN LEADER		REDUCED PRESSURE BACKFLOW ASSY.
	DIRECTION OF FLOW		DOUBLE CHECK ASSEMBLY
	REDUCER		PIPE CAP
C	PIPE DROP		FLOOR DRAIN (ROUND OR SQUARE)
	PIPE DROP		FLOOR SINK
	PIPE RISE		CHECK VALVE
	PIPE RISE		BUTTERFLY VALVE
	PIPE RISE		OVERFLOW DRAIN
	VENT THRU ROOF		ROOF DRAIN
	WALL CLEAN-OUT		POINT OF CONNECTION TO EXISTING
	FLOOR CLEAN-OUT		
	GRADE CLEAN-OUT		



**Medical Design Group**  
Architecture for Health Care

2716 WESTLAND PLACE  
BOISE, IDAHO 83704-5863

BOISEARCHITECT@AOL.COM  
Fax (208) 378-1405  
Phone (208) 378-0817

© COPYRIGHT: MEDICAL DESIGN GROUP



### PLUMBING LEGENDS & ABBREV.

Desert Sage Health Care  
2280 American Legion Blvd.  
Mountain Home, Idaho

SHEET  
P0.0

March 2004

3-15-04

# PART 1 - GENERAL

## 1.1 SCOPE OF WORK

- A. PROVIDE ALL LABOR, EQUIPMENT AND MATERIALS THAT ARE REQUIRED TO PROVIDE A COMPLETE INSTALLATION AS INDICATED ON THE DRAWINGS AND IN THE SPECIFICATIONS INCLUDING THAT REASONABLY INFERRED BY INDUSTRY STANDARDS FOR PROPER EXECUTION OF WORK IN THIS DIVISION.
- B. PROVIDE CARPENTRY, MASONRY, CONCRETE AND METAL WORK REQUIRED FOR WORK OF THIS SECTION.
- C. COORDINATE WORK DONE TO ACCOMMODATE REQUIREMENTS OF THIS DIVISION TO ENSURE ADEQUACY OF SPACE AND PROPER LOCATION, WHETHER OR NOT WORK IS UNDER THIS DIVISION.
- D. PROVIDE CUTTING AND PATCHING AS REQUIRED FOR EXECUTION OF WORK PERFORMED UNDER THIS SECTION AND NOT PROVIDED UNDER OTHER SECTIONS.
- E. ANY DAMAGE THAT OCCURS DUE TO WORK OF THIS DIVISION CAUSED BY LEAKS, BREAKS, DISCHARGE OF NORMAL WORK OF CONTRACT, INADVERTENT ACTS, ETC., ARE THE RESPONSIBILITY OF THIS CONTRACTOR. DAMAGED MATERIAL OR EQUIPMENT SHALL BE REPAIRED OR REPLACED WITH LIKE MATERIAL TO THE SATISFACTION OF THE OWNER AND/OR OWNER'S REPRESENTATIVE. REPAIRS OR REPLACEMENT WORK SHALL BE DONE BY CRAFTSMEN SKILLED IN THE TRADE OF THE WORK INVOLVED AND SHALL BE APPROVED BY THE OWNER AND/OR OWNER'S REPRESENTATIVE. DAMAGE CAUSED SHALL INCLUDE BUT NOT BE LIMITED TO UTILITIES OR OTHER ITEMS WHICH ARE TO REMAIN IN USE.
- F. VALVES AND TRIM NOT SPECIFICALLY INDICATED, BUT REQUIRED FOR PROPER FUNCTIONING OF EQUIPMENT, SHALL BE FURNISHED AND INSTALLED BY THE TRADE INSTALLING THE EQUIPMENT.
- G. CONTRACTOR SHALL NOT PERFORM ANY WORK THAT HE EXPECTS ADDITIONAL PAYMENT FOR, WITHOUT WRITTEN PRIOR APPROVAL FROM THE ARCHITECT.

## 1.2 PROTECTION, STORAGE AND DELIVERY

- A. COORDINATE WITH OWNER NECESSARY STORAGE AND SHOP AREAS AT THE SITE FOR SAFE AND PROPER STORAGE AND USE OF TOOLS AND MATERIALS IN OWNER APPROVED LOCATIONS WHICH DO NOT INTERFERE WITH THE WORK. RESTORE AREA(S) TO ORIGINAL CONDITION AT COMPLETION OF PROJECT.
- B. PROTECT EQUIPMENT AND MATERIALS FROM PHYSICAL DAMAGE, CONSTRUCTION DIRT AND THE ELEMENTS, FROM THE TIME THEY ARE SHIPPED BY THE MANUFACTURER TO THE TIME THE BUILDING IS ACCEPTED BY THE OWNER.
- C. ARRANGE DELIVERY OF PRODUCTS IN TIMELY FASHION TO COORDINATE WITH WORK IN PROGRESS. STORAGE SPACE ON SITE MAY BE LIMITED.
- D. DELIVER PRODUCTS IN THE MANUFACTURER'S ORIGINAL PACKAGING WITH IDENTIFYING LABELS INTACT AND LEGIBLE. LEGIBLY IDENTIFY UNITS OR ITEMS AS TO INSTALLATION LOCATION AND/OR DRAWING DESIGNATIONS TO PERMIT CHECK BY OWNER'S REPRESENTATIVE AGAINST APPROVED MATERIAL LIST AND SHOP DRAWINGS.
- E. IMMEDIATELY UPON DELIVERY INSPECT SHIPMENT(S), INCLUDING OWNER FURNISHED ITEMS, TO ASSURE THAT PRODUCTS ARE UNDAMAGED AND IN ACCORDANCE WITH SPECIFICATION REQUIREMENTS. SHOULD THE PRODUCT BE DAMAGED OR NOT IN COMPLIANCE WITH REQUIREMENTS, IMMEDIATELY REPAIR AS DIRECTED OR APPROVED, OR ORDER REPLACEMENT AT NO INCREASE IN CONTRACT SUM.
- F. REPLACE LOST OR DAMAGED MATERIALS AND EQUIPMENT AT NO INCREASE IN CONTRACT SUM.

## 1.3 FEES AND PERMITS

- A. SECURE AND PAY FEES FOR PERMITS, LICENSES, INSPECTIONS AND ROYALTIES REQUIRED FOR WORK OF THIS DIVISION.

## 1.4 REGULATIONS AND STANDARDS

- A. WORK AND MATERIALS SHALL BE IN FULL ACCORDANCE WITH THE RULES AND REGULATIONS OF THE LATEST ADOPTED EDITION, INCLUDING ALL ELEMENTS OF THE FOLLOWING:
  1. 2000 INTERNATIONAL BUILDING CODE (IBC)
  2. 2000 INTERNATIONAL MECHANICAL CODE (IMC)
  3. 2000 INTERNATIONAL PLUMBING CODE (IPC)
  4. 2000 INTERNATIONAL FIRE CODE (IFC)
  5. NATIONAL FIRE PROTECTION ASSOCIATION (NFPA)
  6. ANY OTHER APPLICABLE FEDERAL, STATE, AND LOCAL LAWS, AND REGULATIONS.
- B. DO NOT CONSTRUE ANYTHING IN THESE DRAWINGS AND SPECIFICATIONS TO PERMIT WORK NOT CONFORMING TO THESE REQUIREMENTS. THE REGULATIONS SHALL GOVERN WHERE THEY REQUIRE HIGHER STANDARDS OR ARE IN CONFLICT WITH THE DRAWINGS AND SPECIFICATIONS. CONSIDER RULINGS AND INTERPRETATIONS OF THE ENFORCING AGENCIES AS PART OF THESE SPECIFICATIONS. COMPLY WITH THE DRAWINGS AND SPECIFICATIONS SHOWING WORK EXCEEDING MINIMUM CODE REQUIREMENTS.
- C. PROVIDE ALL WORK REQUIRED BY THE GOVERNING AUTHORITY, EVEN IF IT IS NOT INDICATED ON DRAWINGS OR IN THE SPECIFICATIONS.

## 1.5 DRAWINGS AND SPECIFICATIONS

- A. CONSIDER ALL DRAWINGS AND THESE SPECIFICATIONS AS A WHOLE AND PROVIDE WORK OF THIS SECTION AS SHOWN ANYWHERE THEREIN. DRAWINGS INCLUDE ALL ARCHITECTURAL, STRUCTURAL, CIVIL, AND ELECTRICAL DRAWINGS. PRINTS MUST BE REVIEWED FOR ACCURACY BEFORE STARTING THE JOB. ABSOLUTE ACCURACY OF THE DRAWINGS AND SPECIFICATIONS CANNOT BE GUARANTEED. WHILE EVERY EFFORT HAS BEEN MADE TO COORDINATE THE LOCATIONS OF EQUIPMENT COVERED BY THESE SPECIFICATIONS AND WORK OF OTHER TRADES, IT IS THE RESPONSIBILITY OF THE CONTRACTOR TO COORDINATE EXACT REQUIREMENTS GOVERNED BY ACTUAL JOB CONDITIONS. CHECK ALL INFORMATION AND REPORT ANY DISCREPANCIES BEFORE SUBMITTING BID OR FABRICATING WORK.

## 1.6 SUBMITTAL DATA

- A. SUBMIT FOR REVIEW ALL ATTACHMENTS TO STRUCTURE, ARCHITECTURAL ACCESS PANELS, ALL FIXTURES AND PIECES OF EQUIPMENT TO BE INSTALLED ON THE JOB. SUBMITTALS SHALL INCLUDE BUT NOT BE LIMITED TO VALVES AND PIPE LINE ACCESSORIES AND INSULATION. PROVIDE ALL REQUIRED SUBMITTAL DATA IN COMPLETE SETS, BOUND AND INDEXED BY CATEGORY, USE, ETC. CLEARLY IDENTIFY EACH ITEM IN THE SUBMITTAL FOR INSTALLATION INTO THE PROJECT. PROVIDE A COPY OF THE REVIEWED SUBMITTALS FOR OWNERS O&M MANUAL.

## 1.7 SUBMITTALS

- A. PREPARE THREE (3 PLUS THE NUMBER REQUIRED FOR THE GENERAL CONTRACTORS USE) COPIES FOR ALL EQUIPMENT AND MATERIALS. SUBMIT TO ARCHITECT FOR REVIEW AND DISTRIBUTION.

## 1.8 WORKMANSHIP AND MATERIALS

- A. EMPLOY ONLY EXPERIENCED, COMPETENT AND PROPERLY EQUIPPED PERSONNEL ON THE JOB.
- B. PROVIDE HIGH QUALITY WORKMANSHIP IN INSTALLATION OF EQUIPMENT AND MATERIALS.
- C. USE ONLY NEW MATERIALS IN PERFECT CONDITION, INSPECT ALL MATERIALS UPON ARRIVAL AT JOB SITE AND IMMEDIATELY REMOVE DEFECTIVE ITEMS FROM THE SITE.

## 1.9 INSPECTION

- A. WORK MAY BE INSPECTED AT ANY TIME BY THE OWNER OR HIS REPRESENTATIVE. OWNER OR REPRESENTATIVE SHALL BE NOTIFIED 48HRS PRIOR TO COVER. WORK COVERED OR CONCEALED BEFORE BEING INSPECTED AND APPROVED SHALL BE OPENED AND UNCOVERED UPON REQUEST.

## 1.10 OPERATION AND MAINTENANCE MANUAL INSTRUCTIONS

- A. PREPARE TWO (2) COPIES FOR ALL EQUIPMENT INCLUDING THE FINAL AIR/WATER BALANCE REPORT.

## 1.11 SITE CLEAN-UP

- A. AFTER ALL OTHER WORK HAS BEEN ACCOMPLISHED, CLEAN ALL EXPOSED PIPING, DUCTWORK, FIXTURES, EQUIPMENT AND SUPPORTS. TOUCH UP PAINT, ON ANY EQUIPMENT SCRAPED, SCRATCHED OR DAMAGED DURING CONSTRUCTION.
- B. LEAVE ALL AREAS INVOLVING MECHANICAL WORK IN A CONDITION SATISFACTORY TO THE OWNER. REMOVE ALL CRATES, CARDBOARD, PACKING MATERIAL, WASTE MATERIAL, AND OTHER DEBRIS LEFT OVER FROM CONSTRUCTION.

# PART 2 - PRODUCTS

## 2.1 SPECIFIC MANUFACTURER AND MODEL


- A. TRADE NAMES ARE USED TO ESTABLISH STANDARDS. SIMILAR PRODUCTS FROM OTHER MANUFACTURERS MAY BE SUBSTITUTED AFTER SUBMITTAL IS REVIEWED BY THE ENGINEER.
- B. CONTRACTOR IS RESPONSIBLE FOR ANY AND ALL CHANGES DUE TO SUBSTITUTIONS OR ALTERNATES TO THE DESIGN DRAWINGS. AREAS OF COORDINATION CONCERN INCLUDE BUT NOT LIMITED TO; DIMENSIONS, STRUCTURAL IMPACTS, ELECTRICAL CHARACTERISTICS, ETC... THIS CONTRACTOR WILL BE RESPONSIBLE FOR ANY INCREASE IN PROJECT COST OR IMPACT TO SCHEDULE DUE TO THESE SUBSTITUTIONS.


## 2.2 U.L. LABEL

- A. FURNISH UL LABELED AND LISTED MATERIALS AND EQUIPMENT EXCEPT WHEN EQUIPMENT IS OF A TYPE FOR WHICH LABELING OR LISTING SERVICES ARE NOT AVAILABLE FROM UL.

## 2.3 FINISHES AND PAINTING

- A. PROVIDE ALL EQUIPMENT WITH A FACTORY FINISH. TOUCH UP ANY CHIPS OR SCRAPES THAT MAY OCCUR DURING HANDLING OR INSTALLATION.

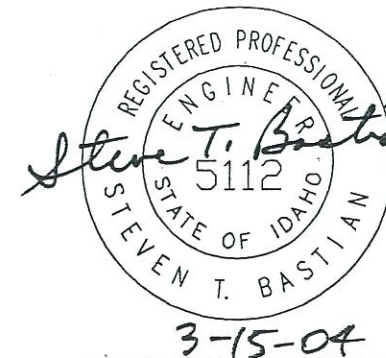

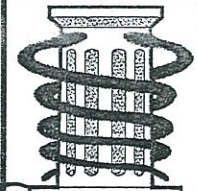 <b>Medical Design Group</b> Architecture for Health Care	
2716 WESTLAND PLACE BOISE, IDAHO 83704-5863 BOISEARCHITECT@AOL.COM Fax (208) 378-1405 Phone (208) 378-0817	
© COPYRIGHT: MEDICAL DESIGN GROUP	
<b>PLUMBING SPECIFICATIONS</b>	
Desert Sage Health Care 2280 American Legion Blvd. Mountain Home, Idaho	<b>SHEET</b>  <b>P0.1</b>
March 2004	

S:\Projects\03MDG002\Drawings\03MDG002P01.dwg, 3/15/2004 11:55:31 AM, thompson, ANSI B (11.00 x 17.00 inches), 1:1

# PART 2 - PRODUCTS (continued from P0.1)

## 2.4 GENERAL PIPE MATERIALS

- A. LPG PROPANE: STEEL: BLACK OR GALVANIZED CONFORMING TO ASTM SPECIFICATIONS A-53A. PIPE SIZE 2 1/2" AND LARGER SHALL BE SCHEDULE 40. ASTM A-120 IS ALLOWED FOR THREADED PIPE 2" AND SMALLER.
- B. WATER: COPPER: SEAMLESS TYPE K OR L, HARD DRAWN, CONFORMING TO ASTM SPECIFICATION B-88.
- C. SANITARY WASTE VENT: ABS: ACRYLONITRILE - BUTADIENE - STYRENE PLASTIC PIPE, SCHEDULE 40 CONFORMING TO ASTM D 2661.
- D. NATURAL GAS AND WATER PIPE WRAPPING: WRAP PIPE BURIED IN GROUND WITH "SCOTCHWRAP" OR EQUAL. WRAP STRAIGHT RUNS WITH .010" THICK TAPE DOUBLY SPIRALLY APPLIED IN HALF-LAP LAYERS. PRE-WRAP ALL JOINTS, VALVES, AND SIMILAR IRREGULAR SURFACES WITH .010" THICK TAPE.
- E. MA: MEDICAL GRADE COPPER TUBE TYPE K OR L, CLEANED DEGREASED CAPPED COPPER FOR MEDICAL USE ONLY.
- F. MV TO BE SCHEDULE 40 PVC WASTE AND VENT FITTINGS.

## 2.5 PIPE FITTINGS

- A. WELDED: PIPING 2 1/2" AND LARGER SHALL HAVE BUTT WELDED STEEL FITTINGS.
- B. THREADED: PIPING 2" AND SMALLER SHALL HAVE AAR CLASS 300 MALLEABLE IRON FOR UNIONS AND CLASS 1 MALLEABLE IRON FOR ALL OTHER FITTINGS. MATERIAL SHALL CORRESPOND TO ASTM SPECIFICATION A-197. GALVANIZED OR BLACK TO MATCH PIPE.
- C. SOLDERED: WROUGHT COPPER CONFORMING TO ANSI SPECIFICATION B16.22 OR CAST BRASS CONFORMING TO ANSI SPECIFICATIONS B16.18 SPECIFICALLY DESIGNED FOR SOLDERING.
- D. BRAZED: WROUGHT COPPER CONFORMING TO ANSI SPECIFICATION B16.22 SPECIFICALLY DESIGNED FOR BRAZING.
- E. CAST IRON SOIL: SERVICE WEIGHT HUBLESS PER CISPI STANDARD 301. HOT COAL TAR PITCH COATING INSIDE AND OUT.

## 2.6 PIPE JOINTS

- A. FLANGED PIPE: PROVIDE WELD NECK FLANGES WITH 1/8" GASKETS SUITABLE FOR APPLICATIONS. BOLTS, WASHERS AND NUTS SHALL BE CADMIUM PLATED, OR ZINC CHROMATE.
- B. SCREWED METALLIC PIPE: APPLY RECTORSEAL NO. 5 LUBRICANT OR PERMACEL, P-412 1/2" WIDE WHITE TEFLON PIPE JOINT SEALANT TAPE TO MALE PIPE THREADS WHEN MAKING UP JOINTS.
- C. SOLDERED: USE 95/5 LEAD FREE SILVER SOLDER AND WATER SOLUBLE FLUX. JOINTS SHALL CONFORM TO ASTM B828.
- D. BRAZED: USE BCUP PHOS-COPPER BRAZING ALLOY. JOINTS SHALL CONFORM TO ANSI B2.2.
- E. HUBLESS: 304 STAINLESS STEEL BAND AND CLAMP WITH NEOPRENE SLEEVE PER CISPI STANDARD 301. CLAMP-ALL, TYLER OR HUSKY STANDARD CISPI COUPLINGS.

## F. UNIONS:

- 1. STEEL PIPE: 300 LB. BRONZE TO IRON GROUND JOINT.
- 2. COPPER TUBING: BRONZE SWEAT UNIONS WITH COPPER TO IPS ADAPTERS.

## 2.7 VALVES + PIPING SPECIALTIES

- A. PROVIDE ISOLATION VALVES AT EACH BRANCH FROM MAIN DISTRIBUTION ON ALL PIPING SYSTEMS. LOCATE VALVES AS CLOSE TO MAIN AS POSSIBLE.
- B. INSTALL ALL VALVES SO THEIR STEMS ARE LOCATED ABOVE HORIZONTAL PLANE OF THE PIPE IN WHICH THEY ARE INSTALLED. IN GENERAL, LOCATE VALVES IN ACCESSIBLE LOCATIONS WITH ADEQUATE CLEARANCE AROUND HAND WHEELS OR LEVERS FOR EASY OPERATION.
- C. PROVIDE ALL VALVES AND STRAINERS, FULL PIPE SIZE UNLESS INDICATED OTHERWISE.
- D. RENEWABLE PARTS, INCLUDING DISCS, PACKING AND SEALS SHALL BE OF TYPES RECOMMENDED BY VALVE MANUFACTURER FOR INTENDED SERVICE. INSTALL ALL VALVES SO THEIR STEMS ARE LOCATED ABOVE HORIZONTAL PLANE OF THE PIPE.
- E. FOR GENERAL USE VALVES (PLUMBING AND HVAC):
  - 1. BALL (FULL PORT THROUGH 3"): WATTS FBVS-1 SERIES.
  - 2. GATE (THROUGH 4"): WATTS WGV-1 SERIES.
  - 3. GAS (THROUGH 1"): WATTS GBV SERIES.
  - 4. GLOBE (THROUGH 2"): WATTS GLV SERIES.
  - 5. CHECK (THROUGH 3"): WATTS WCV-2 SERIES.
  - 6. STRAINER (THROUGH 2"): WATTS S777SI SERIES.
  - 7. BALANCE (THROUGH 3"): WATTS CSM-61-M1 SERIES.
  - 8. BUTTERFLY (3" & LARGER)

## F. WATER HAMMER ARRESTER: SOUX CHEIF, PPP, SMITH.

- 1. INSTALL PER MANUFACTURERS SIZING CRITERIA.
- 2. PROVIDE ACCESS PANELS AS NEEDED.

ALTERNATE MANUFACTURERS: APOLLO, RED & WHITE, MILWAUKEE, NIBCO, ARMSTRONG, AND B&G.

## 2.8 PIPE HANGERS AND SUPPORTS

- A. DESIGN CRITERIA:
  - 1. ALL PIPE WILL BE SUPPORTED WITH MANUFACTURED PIPE SUPPORTS AND SHALL BE IN ACCORDANCE WITH THE REQUIREMENTS OF THE FOLLOWING: (A) MSS SP-58 PIPE HANGERS AND SUPPORTS - MATERIALS, DESIGN, AND MANUFACTURER, (B) MSS SP-69 PIPE HANGERS AND SUPPORTS - SELECTION AND APPLICATION, (C) MSS SP-89 PIPE HANGERS AND SUPPORTS - FABRICATION AND INSTALLATION PRACTICE, (D) ASME B31.1 AND B31.9.
- B. GENERAL:
  - 1. USE SUPERSTRUT, B-LINE, GRINNELL, PHD, OR TOLCO HANGERS, SUPPORTS AND STRUCTURAL ATTACHMENTS.
  - 2. SUPPORT ALL PIPE LINES INDIVIDUALLY WITH HANGERS, EACH BRANCH HAVING AT LEAST ONE HANGER.
  - 3. SUPPORT ALL PIPING SO THAT IT IS FIRMLY HELD IN PLACE BY APPROVED HANGERS AND SUPPORTS AND SPECIAL HANGERS AS REQUIRED.

- 4. SIZE HANGERS PROPERLY TO FIT AROUND BARE PIPE OR INSULATION AS REQUIRED. INSULATION SHALL BE CONTINUOUS, USE INSULATION SHIELDS AT HANGERS.
- 5. SPACE HANGERS OR SUPPORTS FOR HORIZONTAL WITH THE MAXIMUM DISTANCE BETWEEN HANGERS AS FOLLOWS OR AS SHOWN ON DRAWINGS.

- A. COPPER 2" AND SMALLER - 6'-0"
- B. STEEL 1" AND SMALLER - 6'-0"
- C. COPPER 2 1/2" AND LARGER - 10'-0"
- D. STEEL 1 1/4" AND LARGER - 10'-0"
- E. CAST IRON SOIL - LOCATE HANGERS WITHIN 18" OF EACH JOINT AT A MAXIMUM 8'-0" SEPARATION BETWEEN HANGERS.


- 6. SUPPORT VERTICAL PIPING AT EVERY STORY. COPPER PIPING SUPPORTS SHALL NOT EXCEED 10 FEET.
- 7. DO NOT USE WIRE, PLUMBER'S TAPE OR OTHER MAKESHIFT DEVICES FOR HANGERS.
- 8. NO VALVE, PIECE OF PIPE, OR PIECE OF EQUIPMENT SHALL BE USED TO SUPPORT THE WEIGHT OF ANY PIPE.
- 9. PROVIDE A SUPPORT OR HANGER CLOSE TO EACH CHANGE OF DIRECTION IN THE PIPE, EITHER HORIZONTAL OR VERTICAL.
- 10. SUPPORT ROOF TOP PIPING A MINIMUM OF 6" ABOVE ROOF SURFACE USING EITHER MANUFACTURED PIPING SUPPORTS OR 4x6x12 REDWOOD BLOCKS WITH "U" STRAPS.

## C. MATERIALS:

- 1. GENERAL PIPING: INDIVIDUAL SUSPENDED PIPING - HANGERS AS SCHEDULED BELOW, COMPLETE WITH THREADED ROD. SUPERSTRUT OR B-LINE.

PIPE SIZE	HANGER	MINIMUM ROD SIZE
1/2" TO 2"	SUPERSTRUT C-711	1/4"
2 - 1/2" TO 3"	SUPERSTRUT C-711	3/8"
4" TO 6"	SUPERSTRUT C-710	1/2"

- D. STEEL SHAPES: ASTM A-36.
- E. BEAM CLAMPS: B-LINE B751 WITH B753 SWIVEL NUT ARE TO BE USED FOR LESS THAN 300 LB LOADS.
- F. PENETRATIONS AND ESCUTCHEONS: PROVIDE ESCUTCHEON PLATES THAT ARE NEAT, RIGID, SECURELY ATTACHED WHERE WORK OF THIS SECTION PENETRATES WALLS OR OTHER SURFACES. PROVIDE STAINLESS STEEL OR CHROME PLATED BRASS.
- G. SEISMIC: PROVIDE SEISMIC RESTRAINT AS REQUIRED PER UBC.

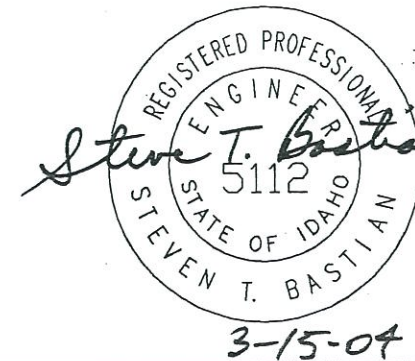

**Medical Design Group**  
Architecture for Health Care

2716 WESTLAND PLACE  
BOISE, IDAHO 83704-5863  
BOISEARCHITECT@AOL.COM  
Fax (208) 378-1405  
Phone (208) 378-0817

© COPYRIGHT: MEDICAL DESIGN GROUP

PLUMBING SPECIFICATIONS	
Desert Sage Health Care 2280 American Legion Blvd. Mountain Home, Idaho	SHEET <b>P0.2</b>
March 2004	

S:\Projects\03MDG002(DesertSageHealth)\Drawings\03MDG002P02.dwg, 3/15/2004 11:55:25 AM, thompson, ANSI B (11.00 x 17.00 Inches), 1:1

## PART 2 - PRODUCTS (continued from P0.2)

### 2.9 PIPE INSULATION

- A. PIPES SHALL BE INSTALLED WITH PRE FORMED FIBERGLASS PIPE INSULATION WITH ALL SERVICE JACKET. VALVES AND FITTINGS SHALL BE INSULATED WITH FIBERGLASS BATT THAT IS COVERED WITH PLASTIC OR CLOTH COVERS. SEAL ALL JOINTS VAPOR TIGHT.
- B. PROVIDE ALUMINUM JACKET OVER ALL OUT-DOOR INSULATED PIPING. SEAL WATER TIGHT.
- C. THICKNESSES SHALL BE AS FOLLOWS:
  - 1. DOMESTIC HOT, COLD WATER, AND HOT WATER RECIRC-  
1-1/2" AND SMALLER-1/2" THICK  
2" THRU 4"-1" THICK

### 2.10 ARCHITECTURAL ACCESS PANELS AND DOORS

- A. WHERE REQUIRED: WHEREVER A PIECE OF EQUIPMENT IS INACCESSIBLE AND REQUIRES ACCESS FOR MAINTENANCE, REPAIR OR ADJUSTMENT.
- B. SIZE: SIZE IS DEPENDENT UPON THE RELATIONSHIP OF THE DOOR TO THE PRODUCT BEING SERVICED. THEREFORE, THE SIZE OF THE DOOR SHALL BE SELECTED TO PROVIDE CONVENIENT ACCESS TO ITS CONTENTS.
- C. FRAME: THE FRAME SHALL BE FLUSH MOUNTED AND SHALL BE SUITABLE FOR THE BUILDING SURFACE IN WHICH IT IS BEING MOUNTED. PROVIDE FURRING AROUND THE DOOR FRAME AS DIRECTED WHERE THERE IS INSUFFICIENT DEPTH TO ALLOW A FLUSH MOUNTED FRAME AND DOOR.
- D. DOOR: STEEL OR STAINLESS STEEL AS INDICATED HEREIN; AND OF SUFFICIENT GAUGE TO PREVENT PERMANENT DEFLECTION FROM NORMAL USE.
- E. HINGES: THE DOOR SHALL HAVE A MINIMUM OF TWO SWING OUT TYPE HINGES WHICH ALLOW THE DOOR TO BE OPENED 180 DEGREES; QUANTITY AS REQUIRED TO SUIT DOOR HEIGHT.
- F. LOCK: SCREW DRIVER LOCK, QUANTITY AS REQUIRED TO SUIT DOOR HEIGHT AND WIDTH.
- G. FIRE RATED DOORS: PROVIDE WHEN LOCATED IN FIRE RATED SURFACES.
- H. FURNISH DOORS TO SUBCONTRACTORS FOR INSTALLATION AND COORDINATE LOCATIONS.
- I. MANUFACTURER: CESCO OR EQUAL.
- J. LOCATION:

	TYPE	FINISH
DRYWALL	STYLE "DW"	BAKED ENAMEL PRIME COAT
CERAMIC TILE	STYLE "M" STAINLESS	STAINLESS STEEL
FIRE RATED SURFACES	FIRE RATED ACCESS DOOR	BAKED ENAMEL PRIME COAT

- K. PENETRATIONS PER ARCHITECTURAL DRAWINGS, PROVIDE UL LISTED FIRE PENETRATION ASSEMBLIES AND CAULKING WHERE REQUIRED.

## PART 3 - EXECUTION

### 3.1 COORDINATION

- A. CUTTING AND REPAIRING: INCLUDE IN THE WORK ALL CUTTING AND REPAIRING NECESSARY AND REQUIRED FOR THE INSTALLATION. REPAIRING SHALL BE PERFORMED BY WORKMEN SKILLED IN THE TRADE INVOLVED, IN A MANNER SATISFACTORY TO THE OWNER.
- B. COORDINATION WITH OTHER DIVISIONS: COORDINATE ELECTRICAL AND CONTROL INTERLOCKS OF MECHANICAL EQUIPMENT WITH THE ELECTRICAL DIVISION.

### 3.2 STRUCTURAL MODIFICATION

- A. DO NOT CUT STRUCTURAL MEMBERS, WITHOUT PERMISSION FROM ARCHITECT.

### 3.3 WORKMANSHIP

- A. WORKMANSHIP SHALL BE FIRST CLASS THROUGHOUT, PERFORMED ONLY BY COMPETENT AND EXPERIENCED WORKMEN IN A MANNER SATISFACTORY TO THE OWNER. REPLACE WORK FALLING BELOW THESE STANDARDS AS DIRECTED BY THE OWNER. CONSTANT SUPERVISION OF THE WORK EITHER BY THE CONTRACTOR OR HIS COMPETENT REPRESENTATIVE SHALL BE MAINTAINED.

### 3.4 GENERAL PIPING REQUIREMENTS

- A. ALL PIPING SHALL BE CONCEALED UNLESS SPECIFICALLY INDICATED OR DIRECTED OTHERWISE. INSTALL PIPING PARALLEL TO BUILDING SURFACES WITH A MINIMUM OF FITTINGS.
- B. INSTALL ALL GRAVITY LINES 3" AND SMALLER AT 2% SLOPE MINIMUM, 4" AND LARGER AT 2% SLOPE OR AS NOTED ON THE DRAWINGS.
- C. PREPARE ALL PIPING TRENCHES AND BACKFILL PER RECOGNIZED, WRITTEN INDUSTRY STANDARDS.
- D. CLOSE ENDS OF PIPE IMMEDIATELY AFTER INSTALLATION. LEAVE CLOSURE IN PLACE UNTIL REMOVAL IS NECESSARY FOR COMPLETION OF THE INSTALLATION.
- E. EACH PIPING SYSTEM SHALL BE THOROUGHLY FLUSHED AND PROVEN CLEAN.
- F. INSTALL PIPING AT COILS, SO THAT EQUIPMENT CAN BE REMOVED AND/OR SERVICED WITH A MINIMUM OF PIPE DISLOCATION. PROVIDE UNIONS AT ALL COILS FOR EASE OF REMOVAL.
- G. SERVICE SHUT-OFF VALVES SHALL BE INSTALLED ON EACH BRANCH OFF ALL PIPING MAINS.
- H. CUT PIPING ACCURATELY TO JOB MEASUREMENTS AND INSTALL IT WITHOUT SPRINGING OR FORCING, TRUE TO LINE AND GRADE, GENERALLY SQUARE WITH BUILDING AND ADEQUATELY SUPPORTED TO PREVENT SAGGING OR UNDUE STRESS ON PIPE, FITTINGS AND ACCESSORIES.
- I. INSTALL DIELECTRIC UNIONS AT POINTS OF CONNECTION BETWEEN DISSIMILAR MATERIALS.
- J. PROVIDE UNIONS OR FLANGES AT ALL CONNECTIONS TO EQUIPMENT, ON BOTH SIDES OF CONTROL VALVES AND ELSEWHERE AS REQUIRED TO FACILITATE MAINTENANCE AND EASY REMOVAL.
- K. PROVIDE CHROME PLATED ESCUTCHEONS FOR PIPING PENETRATIONS THROUGH WALLS, FLOORS OR CEILINGS THAT ARE EXPOSED TO VIEW. ARRANGE PIPING AND HANGERS TO ALLOW FOR EXPANSION, CONTRACTION AND STRUCTURAL SETTLEMENT.
- L. MAKE CHANGES IN SIZE OR DIRECTION WITH MANUFACTURED FITTINGS.
- M. INSTALL PIPING FULL SIZE THROUGH SHUT-OFF VALVES, BALANCING VALVES, ETC.
- N. CORE DRILLING: PROVIDE ALL EQUIPMENT, LABOR AND MATERIAL FOR CORE DRILLING HOLES WHERE PIPING PENETRATES EXISTING CONCRETE WALLS OR FLOORS. DRILL HOLES 1" LARGER THAN O.D. OF PIPE. PROTECT ALL SURROUNDING AREAS FROM DAMAGE BY WATER OR DUST WHILE CORE DRILLING. WHERE PIPES PASS THROUGH SLEEVES OR CORE DRILLED HOLES, PROVIDE BACKER ROD AND FILL OUTER 1/2" DEPTH OF THE ANNULAR SPACE WITH SEALER.

### 3.5 GENERAL EQUIPMENT INSTALLATION REQUIREMENTS

- A. POSITION EQUIPMENT TO RESULT IN GOOD APPEARANCE. PROVIDE EASY ACCESS TO ALL COMPONENTS FOR MAINTENANCE AND ADEQUATE SPACE FOR TUBE REMOVAL OR OTHER REPAIRS. INSTALL THE PIPING AND PIPE LINE ACCESSORIES SO THEY DO NOT INTERFERE WITH EQUIPMENT ACCESS. INSTALL EQUIPMENT ISOLATION VALVES IN SUCH A MANNER TO ALLOW COMPLETE MAINTENANCE AND DISASSEMBLY OF EQUIPMENT WITHOUT HAVING TO REMOVE EQUIPMENT ISOLATION VALVES.

### 3.6 CLEANING

- A. FLUSH PIPES FREE FROM FOREIGN SUBSTANCES BEFORE INSTALLING VALVES, STOPS OR MAKING FINAL CONNECTIONS. FURNISH AND INSTALL VALVED CONNECTIONS TO PIPING SYSTEMS TO FACILITATE FLUSHING, OTHER THAN FOR EQUIPMENT CONNECTIONS. WHEN FLUSHING PIPING SYSTEMS, CIRCULATE WATER AT A VELOCITY OF 8 FPS TO THOROUGHLY FLUSH THE PIPING SYSTEM ELIMINATING THE FOREIGN SUBSTANCES. CLEAN ALL PIPING AND EQUIPMENT BEFORE INSTALLATION AS ACCEPTED BY THE OWNER. REMOVE ANY PIECE OF EQUIPMENT (COILS, ETC.) WHICH MAY GET DAMAGED AS A RESULT OF INADEQUATE OR IMPROPER FLUSHING. INSTALL LOOPS AT END OF LINE OR AT RUN OUTS TO EQUIPMENT TO ENABLE FLUSHING OR BLOWDOWN ACTIVITIES. PROVIDE CLEANING PER UPC OR AHJ (WHICHEVER IS MOST STRINGENT).

### 3.7 TESTS

- A. PROVIDE ALL LABOR, EQUIPMENT AND MATERIALS REQUIRED TO PERFORM TESTS. ALL TESTS SHALL BE PER UPC.
- B. PROTECT VALVES AND EQUIPMENT FROM DAMAGE DURING TESTS. INCLUDE CONNECTION TO PREVIOUSLY TESTED SECTIONS, IF THE SYSTEMS ARE TESTED IN SECTIONS. PROTECT OWNER'S EQUIPMENT AND MECHANICAL SYSTEMS AS REQUIRED.
- C. FINAL TESTING TO BE DONE ON COMPLETE SYSTEMS, NOT SEGMENTS.
- D. PROVIDE MEDICAL GAS PIPING TESTS PER NFPA 99.

### 3.8 BALANCING AND ADJUSTING

- A. ADJUST ALL BALANCING VALVES, HOT WATER THERMOSTATS, FLOW AND PRESSURE REGULATORS AND ANY OTHER ADJUSTABLE EQUIPMENT FOR OPTIMUM PERFORMANCE AND TO SUIT JOB CONDITIONS.
- B. ADJUST ALL PIPING BALANCE VALVES TO FLOW INDICATED GPM AS NOTED ON DRAWINGS, PLUS OR MINUS 10%.
- C. SUBMIT COMPLETE BALANCE REPORT TO ARCHITECT AND ENGINEER. LIST ALL EQUIPMENT & FLOWS. PROVIDE REVIEWED REPORT TO OWNER IN O&M MANUAL.

### 3.9 START-UP SERVICES

- A. CONTRACTOR SHALL ALLOT A MINIMUM OF 2 HOURS FOR START UP SERVICES. START AND OPERATE ALL SYSTEMS AS REQUIRED BY THE OWNER. INSTRUCT OWNER'S REPRESENTATIVE ON THE PROPER OPERATION AND MAINTENANCE OF THE SYSTEMS AND EQUIPMENT.

### 3.10 OPERATING AND MAINTENANCE INSTRUCTIONS (O+M MANUAL)

- A. PREPARE TWO (2) COPIES FOR ALL EQUIPMENT INCLUDING THE FINAL AIR/WATER BALANCE REPORT.

### 3.11 WARRANTY

- A. THE CONTRACTOR SHALL WARRANTY HIS WORK FOR A PERIOD OF ONE YEAR FROM THE DATE OF COMPLETION. THIS INCLUDES WORKMANSHIP, MATERIALS, AND EQUIPMENT. CONTRACTOR SHALL PROVIDE LABOR, MATERIALS AND EQUIPMENT TO CORRECT ANY FAULTY INSTALLATIONS AND WORKMANSHIP.
- B. THE OWNER IS RESPONSIBLE FOR ROUTINE MAINTENANCE AND CARE.



<b>Medical Design Group</b> Architecture for Health Care	
2716 WESTLAND PLACE BOISE, IDAHO 83704-5863 BOISEARCHITECT@AOL.COM Fax (208) 378-1405 Phone (208) 378-0817	
© COPYRIGHT: MEDICAL DESIGN GROUP	
<b>PLUMBING SPECIFICATIONS</b>	
Desert Sage Health Care 2280 American Legion Blvd. Mountain Home, Idaho	SHEET <b>P0.3</b>
March 2004	

# PLUMBING FIXTURE AND EQUIPMENT SCHEDULE

MINIMUM CONNECTION SIZE UNLESS INDICATED OTHERWISE ON PLANS

ROUGH-IN SIZE									ROUGH-IN SIZE									
TAG	DESCRIPTION	WASTE	VENT	TRAP	CW	HW	REMARKS	MANUFACTURER & MODEL	TAG	DESCRIPTION	WASTE	VENT	TRAP	CW	HW	REMARKS	MANUFACTURER & MODEL	
WC-1	WATER CLOSET	3"	2"	INTEGRAL	1"	--	WALL HUNG, SIPHON JET (ADA COMPLIANT) LEVER TO BE ON WIDE SIDE OF STALL	MODEL - KOHLER K-4330 MATERIAL - VITREOUS CHINA, SIZE - ELONGATED BOWL, SEAT - K-4670-C OPEN FRONT, WHITE, VALVE - ZURN ZR-6000-WS1 CARRIER - JAY R. SMITH 200 SERIES WITH M51 SUPPORT MOUNT PER ADA REQUIREMENTS.	DS-1	DENTAL SINK - COUNTER	1-1/2"	1-1/2"	1-1/4"	1/2"	1/2"	OVAL, COUNTERTOP (ROUGH-IN ONLY, FINAL CONNECTION BY CONTRACTOR)	MANUFACTURER - BY D.E.S. MODEL - BY D.E.S.	
L-1	LAVATORY- COUNTER	1-1/2"	1-1/2"	1-1/4"	1/2"	1/2"	OVAL, COUNTERTOP	MODEL - KOHLER PENNINGTON K-2196-4, MATERIAL - VITREOUS CHINA, SIZE - 20-1/4" x 17-1/2", FAUCET - DELTA 501-WF-HGMHDF SINGLE LEVER FAUCET WITH .5 GPM VANDEL RESISTANT AERATOR, TRAP - KOHLER K-8999, SUPPLIES - EBC LAH16K-R15-CT3-CF, DRAIN - KOHLER K-13885 OFFSET GRID DRAIN ASSEMBLY FOR WHEELCHAIR. INSULATION - PER ADA REQUIREMENTS	WCO-1	WALL CLEANOUT	--	--	--	--	--	SIZE TO MATCH SS PIPE.	MODEL - JAY R SMITH #(4472T).	
S-1	SINK (SINGLE COMPARTMENT)	2"	1-1/2"	1-1/2"	1/2"	1/2"	SELF RIM COUNTERTOP	MODEL - ELKAY BLR-15, MATERIAL - 18 GAUGE STAINLESS STEEL, TYPE 304 SIZE - 15"x15"x6" FAUCET - JUST JWF-200 MODIFIED SPOUT SU-357-HAS TRAP - EBC TAN150-BF 1-1/2"x1-1/2", 17 GA. SUPPLIES - EBC LAH16K-R20-CT3-CF, DRAIN - ELKAY LK-36	FS-1	FLOOR SINK	2"	2"	2"	1/2"	TRAP PRIME CONN.	CAST-IRON P-TRAP.	MODEL - JAY R SMITH #(3101-Y-12) WITH HALF GRATE AND SEDIMENT BUCKET, TRAP PRIMER CONNECTION. NOTE: VERIFY TRAP PRIMER.	
S-2	SINK (DOUBLE COMPARTMENT)	2"	1-1/2"	1-1/2"	1/2"	1/2"	SELF RIM COUNTERTOP (TAP MASTER FOOT CONTROL PROVIDED BY D.E.S., INSTALLED BY CONTRACTOR)	MODEL - ELKAY LR-3321, MATERIAL - 18 GAUGE STAINLESS STEEL, TYPE 304 SIZE - 33"x21"x8" FAUCET - ELKAY LKC-2433 WITH HOSE AND SPRAY (SINK SHALL BE PUNCHED TO ACCOMMODATE FAUCET AND SPRAY) TRAP - EBC TAN150-BF 1-1/2"x1-1/2", 17 GA. SUPPLIES - EBC LAH16K-R20-CT3-CF DRAIN - ELKAY LKJ-35 ACCESSORIES - EBC WE150L16, 17 GA. CONTINUOUS DRAIN ASSEMBLY	RD-1	ROOF DRAIN	SEE PLANS	--	--	--	--	--	FURNISH WITH UNDER-DECK CLAMP, ADJUSTABLE EXTENSION, VANDAL-PROOF DOME AND SUMP RECEIVER.	MODEL - JAY R SMITH FIG. #(1015-Y-C-U-R). FURNISH WITH UNDER-DECK CLAMP, ADJUSTABLE EXTENSION, VANDAL-PROOF DOME, SUMP RECEIVER, RAIN SHIELD AND PVC WATER DAM EXTENSION FOR OVERFLOW SERVICE.
ES-1	EXAM SINK (SINGLE COMPARTMENT)	2"	1-1/2"	1-1/2"	1/2"	1/2"	SELF RIM COUNTERTOP	MODEL - ELKAY BLH-15-C, MATERIAL - 18 GAUGE STAINLESS STEEL, TYPE 302 SIZE - 15"x15"x7" FAUCET - ELKAY LKA-2438 WITH BH-4 4" WRISTBLADES TRAP - 1-1/2". SUPPLIES - BRASSCRAFT STR-1715-J, DRAIN - ELKAY LK-36	OD-1	OVERFLOW ROOF DRAIN	SEE PLANS	--	--	--	--	--	FURNISH WITH UNDER-DECK CLAMP, ADJUSTABLE EXTENSION, VANDAL-PROOF DOME, SUMP RECEIVER, RAIN SHIELD AND PVC WATER DAM EXTENSION FOR OVERFLOW SERVICE.	MODEL - JAY R SMITH FIG. #(1074-Y-C-U-R-RS). FURNISH WITH UNDER-DECK CLAMP, ADJUSTABLE EXTENSION, VANDAL-PROOF DOME, SUMP RECEIVER, RAIN SHIELD AND PVC WATER DAM EXTENSION FOR OVERFLOW SERVICE.
ES-2	EXAM SINK - COUNTER	1-1/2"	1-1/2"	1-1/4"	1/2"	1/2"	OVAL, COUNTERTOP	MODEL - KOHLER PENNINGTON K-2196-4, MATERIAL - VITREOUS CHINA, SIZE - 20-1/4" x 17-1/2", FAUCET - DELTA 501-WF-HGMHDF SINGLE LEVER FAUCET WITH .5 GPM VANDEL RESISTANT AERATOR, TRAP - KOHLER K-8999, SUPPLIES - EBC LAH16K-R15-CT3-CF, DRAIN - KOHLER K-13885 OFFSET GRID DRAIN ASSEMBLY FOR WHEELCHAIR.	DF-1	DRINKING FOUNTAIN	2"	1-1/2"	1-1/4"	1/2"	--	WALL HUNG	MODEL - HAWS 1011 MATERIAL - STAINLESS STEEL ELECTRICAL - 120V/1Ø, 244W, SIZE - 32"x18-1/2"	
REF-1	NAT. GAS REFRIGERATOR	--	--	--	--	--	NAT. GAS REFRIGERATOR TO HAVE 10-12 INCHES CLEARANCE ON TOP AND 4-6 INCHES ON THE SIDES	MODEL - CRYSTAL COLD MODEL # CC15NG, SIZE - 63-1/2"H x 28-1/2"W x 34-1/2"D, GAS SUPPLY PRESSURE - 11.5" WATER COLUMN, ACCESSORIES - PROVIDE WITH NATURAL GAS CONVERSION, 3 YEAR EXTENDED WARRANTY.	IM-1	ICE MAKER	--	--	--	1/2"	--	PROVIDE WALL VALVE BOX.	MODEL - GUY GRAY MODEL BIM875 SUPPLY - 1/2"x1/4" STOP	
SH-1	SHOWER	2"	2"	2"	1/2"	1/2"	ADA COMPLIANT	SHOWER - FIBERGLASS SYSTEMS INC. # CS-3838ADA.5 ACCESSORIES - PROVIDE WITH DELTA #1323, AMERICAN STANDARD #1674, #1675 OR HANSGRÖHE #06909003 SHOWER VALVE, SOAP DISH, GLIDE BAR/HAND SHOWER, CURTAIN AND ROD, DRAIN ASSEMBLY, AND ADA COMPLIANT THRESHOLD.	SS-1	SERVICE SINK	3"	2"	3"	1/2"	1/2"	FLOOR MOUNTED, SQUARE	MODEL - FIAT #(MSB-24-24) MATERIAL - MOLDED STONE FAUCET - 830-AA WITH VACUUM BREAKER TRAP - 3", CAST IRON SUPPLIES - INTEGRAL STOPS DRAIN - INTEGRAL ACCESSORIES - 832-AA HOSE AND WALL HOOK, 889-CC STAINLESS STEEL MOP HANGER, MSG2424 SPLASH CATCHER PANELS	
									RPBP-1	REDUCED PRESSURE BACKFLOW PREVENTER	--	--	--	LINE SIZE	--	WITH 1/4 TURN BALL VALVE AND BRONZE STRAINER, WALL MOUNT @ +36" AFF NOTE: PIPE DRAIN ASSEMBLY TO FLOOR DRAIN.	MODEL - WATTS SERIES #909-QT-S ACCESSORIES - AIR GAP DRAIN ASSEMBLY NOTE: PIPE DRAIN ASSEMBLY TO FLOOR DRAIN.	
									WH-1	WATER HEATER	--	(2) 3"	--	3/4"	3/4"	GAS FIRED, HIGH EFFICIENCY CONCENTRIC VENT THRU ROOF (2) 3" PVC PIPES, FLUE VENT PROVIDED AND INSTALLED BY PLUMBING CONTRACTOR.	MODEL - BRADFORD WHITE PDV-100S-200-3N (100 GALLON) BURNER - 199,999 BTU INPUT, HIGH EFFICIENCY RECOVERY - 194 GPH @ 100°F RISE ACCESSORIES - T&P RELIEF, ASME RATED, PIPE TO FLOOR DRAIN FEATURES: GLASS LINED TANK, ANODE RODS, FOAM INSULATED TANK, INTERNAL THERMOTRAP SYSTEM, ENERGY SAVER THERMOSTAT WITH SAFETY SHUT-OFF, TOP CONNECTION OPENINGS, 10 YEAR WARRANTY, A.G.A. CERTIFIED, DIFFUSER DIP TUBE.	
									FD-1	FLOOR DRAIN	2"	2"	2"	1/2"	--	6" ROUND GRATE CAST IRON P-TRAP.	MODEL - JAY R SMITH #(2006-A5-CP) CHROME STRAINER AND TRAP PRIMER CONNECTION.	
									D-1	DISPOSAL	1-1/2"	--	1-1/2"	--	--	COORDINATE SWITCHED DUPLEX OUTLET WITH DIVISION 16.	MODEL - IN-SINK-ERATOR MODEL BADGER 1, 1/3 HP, 120V ACCESSORIES - PROVIDE COMPLETE WITH PLUG-IN TYPE CORD.	
									DGCO-1	DOUBLE GRADE CLEANOUT	--	--	--	--	--	ROUND, UNFINISHED FLOORS EXTRA HEAVY DUTY.	MODEL - JAY R SMITH SERIES (4223L) W/ CAST IRON TOP.	
									PT-1	PLASTER TRAP	--	--	--	--	--	SIZE TO MATCH SS	OWNER FURNISHED, CONTRACTOR INSTALLED	
									WB-1	WASHER HOOK-UP BOX	2"	1-1/2"	2"	1/2"	1/2"	FLUSH WALL MOUNTED	MODEL - GUY GRAY #(B200), 1/2" HOT, COLD, AND WASTE	

## MANUFACTURER'S APPROVED FOR SUBMITTAL OF COMPARABLE PRODUCTS

<p>ENAMELED CAST IRON AND VITREOUS CHINA WATER COOLERS STAINLESS STEEL SINKS SERVICE SINKS FAUCETS SENSOR FAUCETS SHOWER VALVES, MIXING VALVES FLUSH VALVES FIXTURE SUPPORTS TOILET SEATS ROOF DRAINS, FLOOR SINKS, FLOOR DRAINS AND TRAPS BACKFLOW PREVENTION DEVICES, PRESSURE REDUCING VALVES EMERGENCY SHOWER/EYEWASH TRAP PRIMERS AND SHOCK ABSORBERS WATER HEATERS</p>	<p>KOHLER, AMERICAN STANDARD HALSEY TAYLOR, OASIS, ELKAY, HAWS, SUN ROC ELKAY, JUST, DAYTON FIAT, BRADLEY, ACORN T &amp; S, CHICAGO, DELTA HDF, ELKAY, JUST, KOHLER, ZURN CHICAGO, SLOAN, DELANY, BRADLEY, ZURN POWERS, LEONARD, SYMMONS SLOAN ROYAL SMITH, WADE, ZURN CHURCH, OLSONITE, BEMIS SMITH, WATTS, ZURN, WADE, JOSAM WATTS, WILKENS, FEBCO HAWS, BRADLEY, GUARDIAN PPP, SIOUX CHIEF, SMITH STATE, A.O. SMITH, BRADFORD WHITE</p>
--	--



**Medical Design Group**  
Architecture for Health Care

2716 WESTLAND PLACE  
BOISE, IDAHO 83704-5863

BOISEARCHITECT@AOL.COM  
Fax: (208) 378-1405  
Phone: (208) 378-0817

© COPYRIGHT: MEDICAL DESIGN GROUP

**PLUMBING SCHEDULES**


Desert Sage Health Care  
2280 American Legion Blvd.  
Mountain Home, Idaho

SHEET  
**P0.4**

March 2004

D:\Projects\U3MDG002P04.dwg, 3/15/2004 11:55:13 AM, ttompson, ANSI B (11.00 x 17.00 inches), 1:1

**Built As Shown**

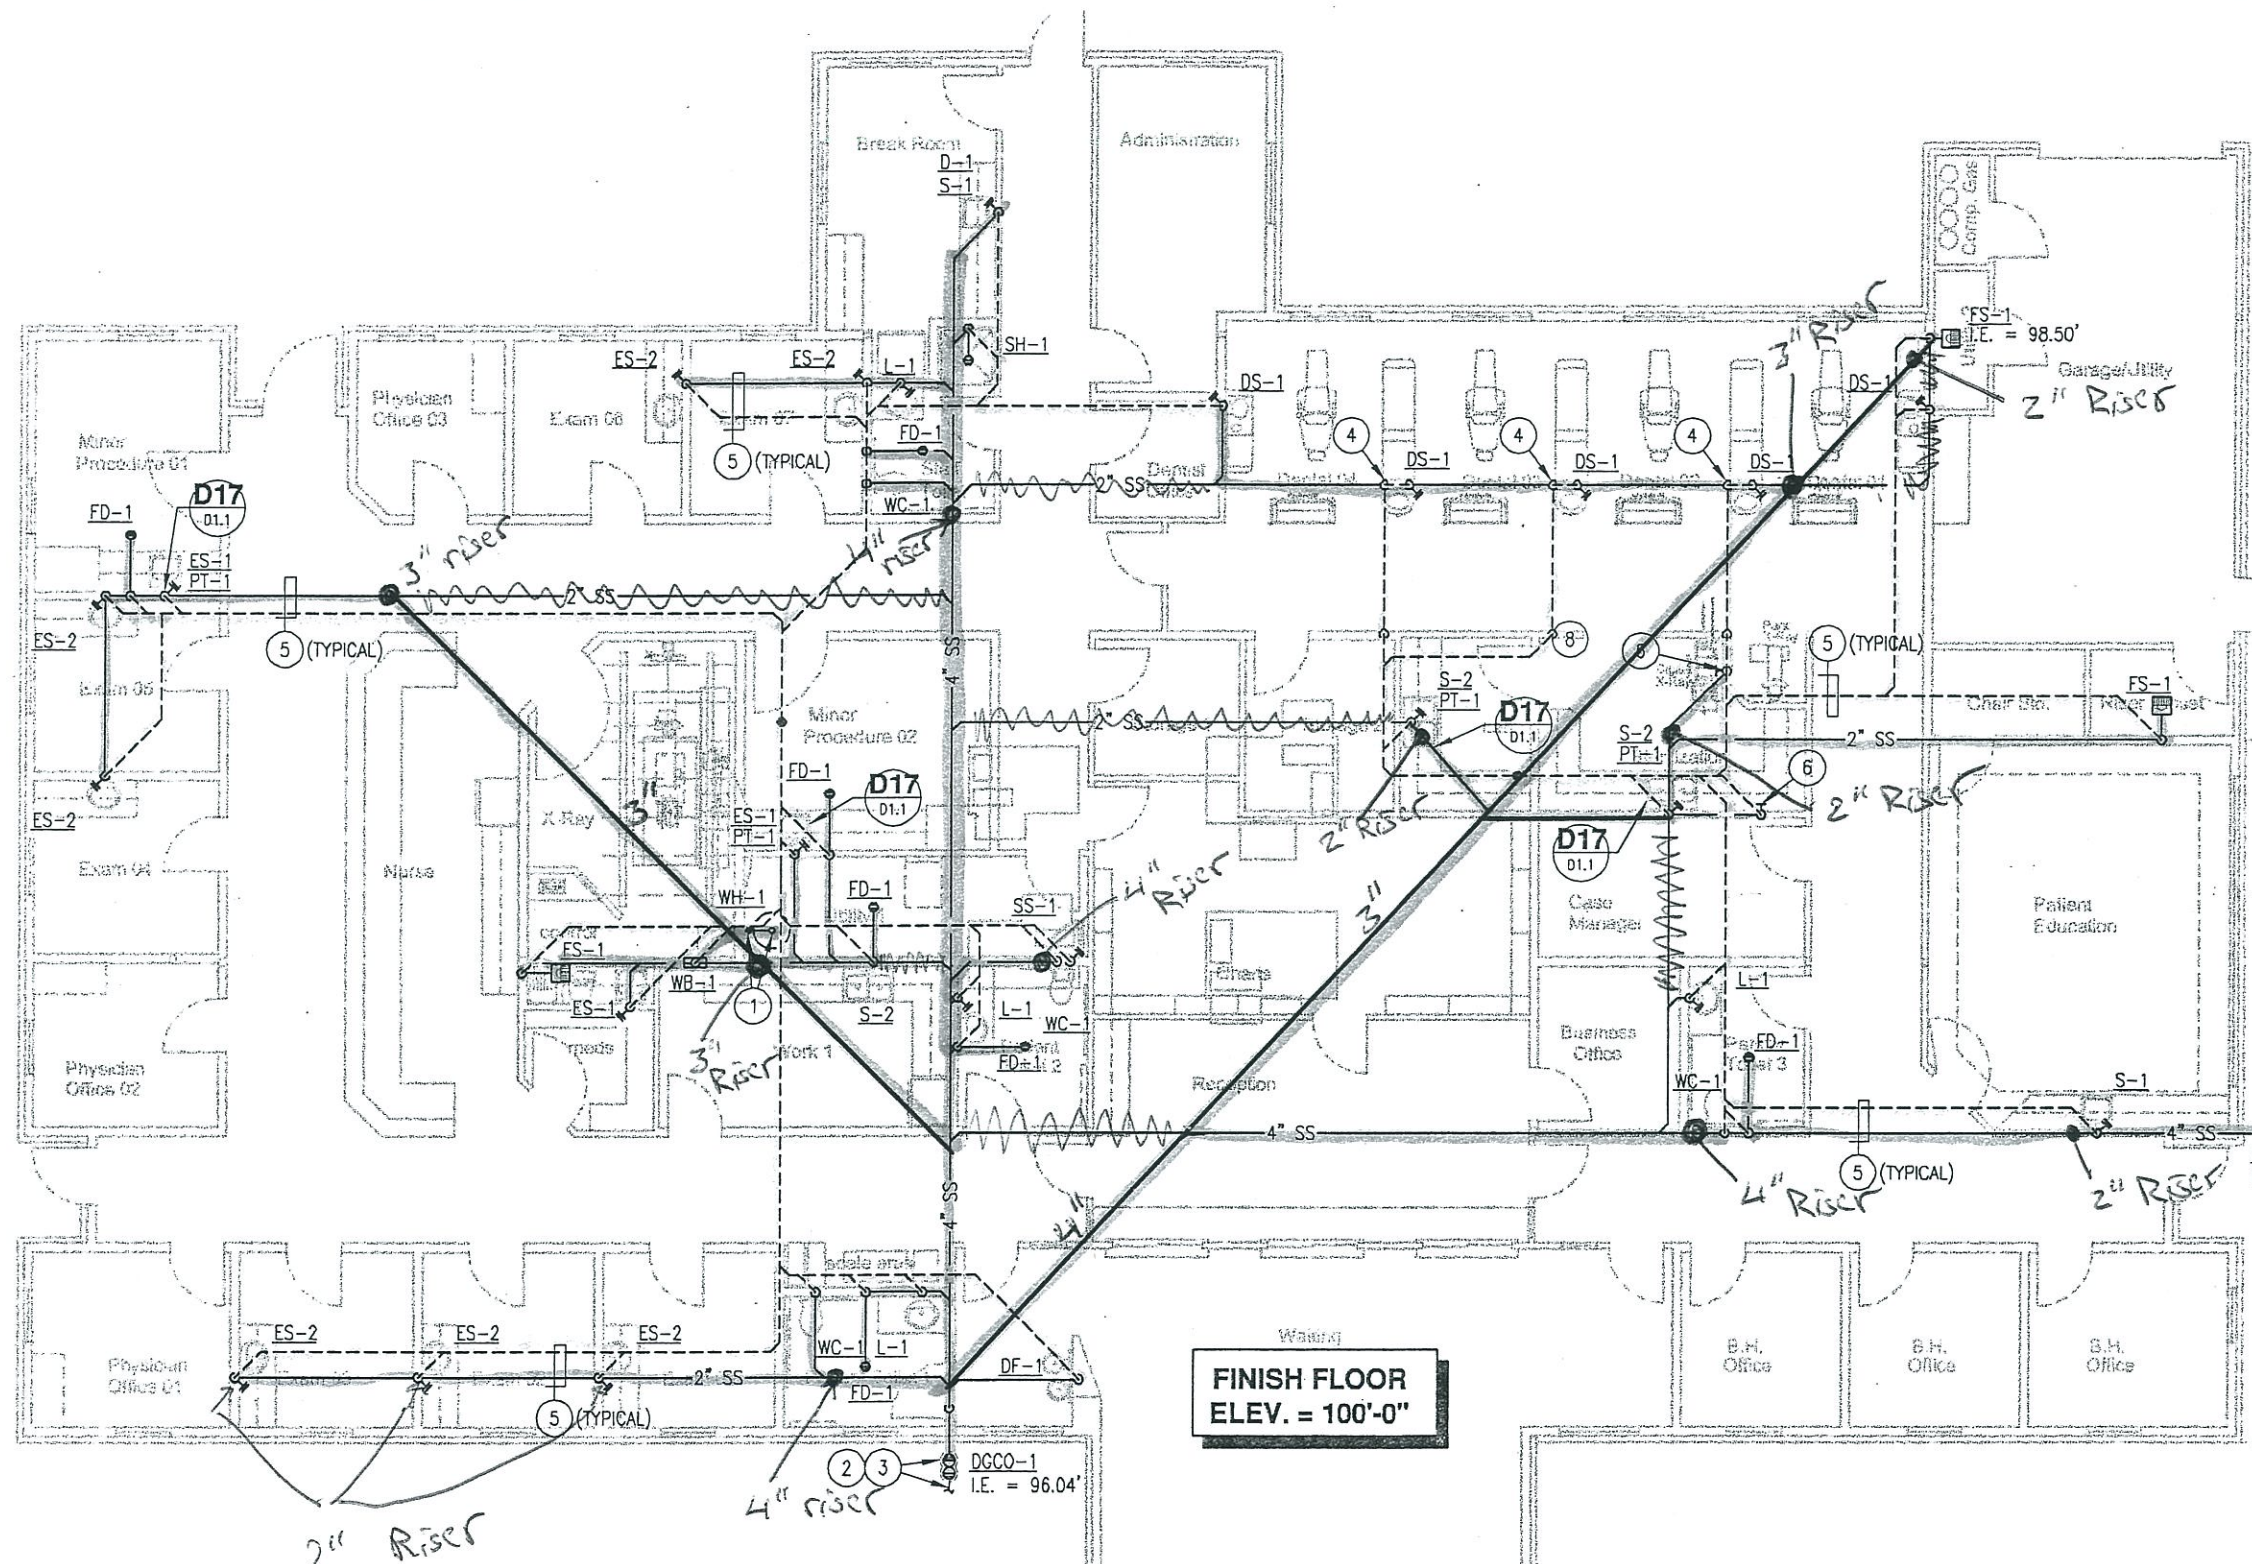

— Sewer  
 ● Riser from under rat slab!  
 - - - Venting

**FINISH FLOOR ELEV. = 100'-0"**



**KEY NOTES:**

- ① PLUMBING CONTRACTOR TO PROVIDE AND INSTALL 3"Ø INTAKE/EXHAUST UP TO CONCENTRIC VENT KIT AND THRU ROOF. SEAL PENETRATION WATER TIGHT. COORDINATE WITH ROOF CONTRACTOR.
- ② 4" DGCO-1 SET IN 12"x3-1/2" CONCRETE RING.
- ③ EXTEND 4" SS TO 5'-0" OUTSIDE OF BUILDING & CONNECT TO SITE CIVIL. COORDINATE ACTUAL INVERT ELEVATIONS PRIOR TO INSTALLATION.
- ④ ISLAND VENT, SEE DETAIL 6, SHEET P3.1.
- ⑤ FOR SIZING SEE RISER DIAGRAM 2, SHEET P3.2.
- ⑥ INSTALL 1-1/4" P-TRAP IN WALL FOR DENTAL EQUIPMENT.



**Medical Design Group**  
 Architecture for Health Care  
 2716 WESTLAND PLACE  
 BOISE, IDAHO 83704-5863  
 BOISEARCHITECT@AOL.COM  
 Fax (208) 378-1405  
 Phone (208) 378-0817

© COPYRIGHT: MEDICAL DESIGN GROUP

**PLUMBING FLOOR PLAN**


Desert Sage Health Care 2280 American Legion Blvd. Mountain Home, Idaho	SHEET P1.1
---	---------------

March 2004

3-15-04

S:\Projects\03MDG002\DesertSageHealth\Drawings\03MDG002P11.dwg, 3/15/2004 11:55:06 AM, thompson, ANSI B (11.00 x 17.00 inches), 1/1

*But As  
Shown*

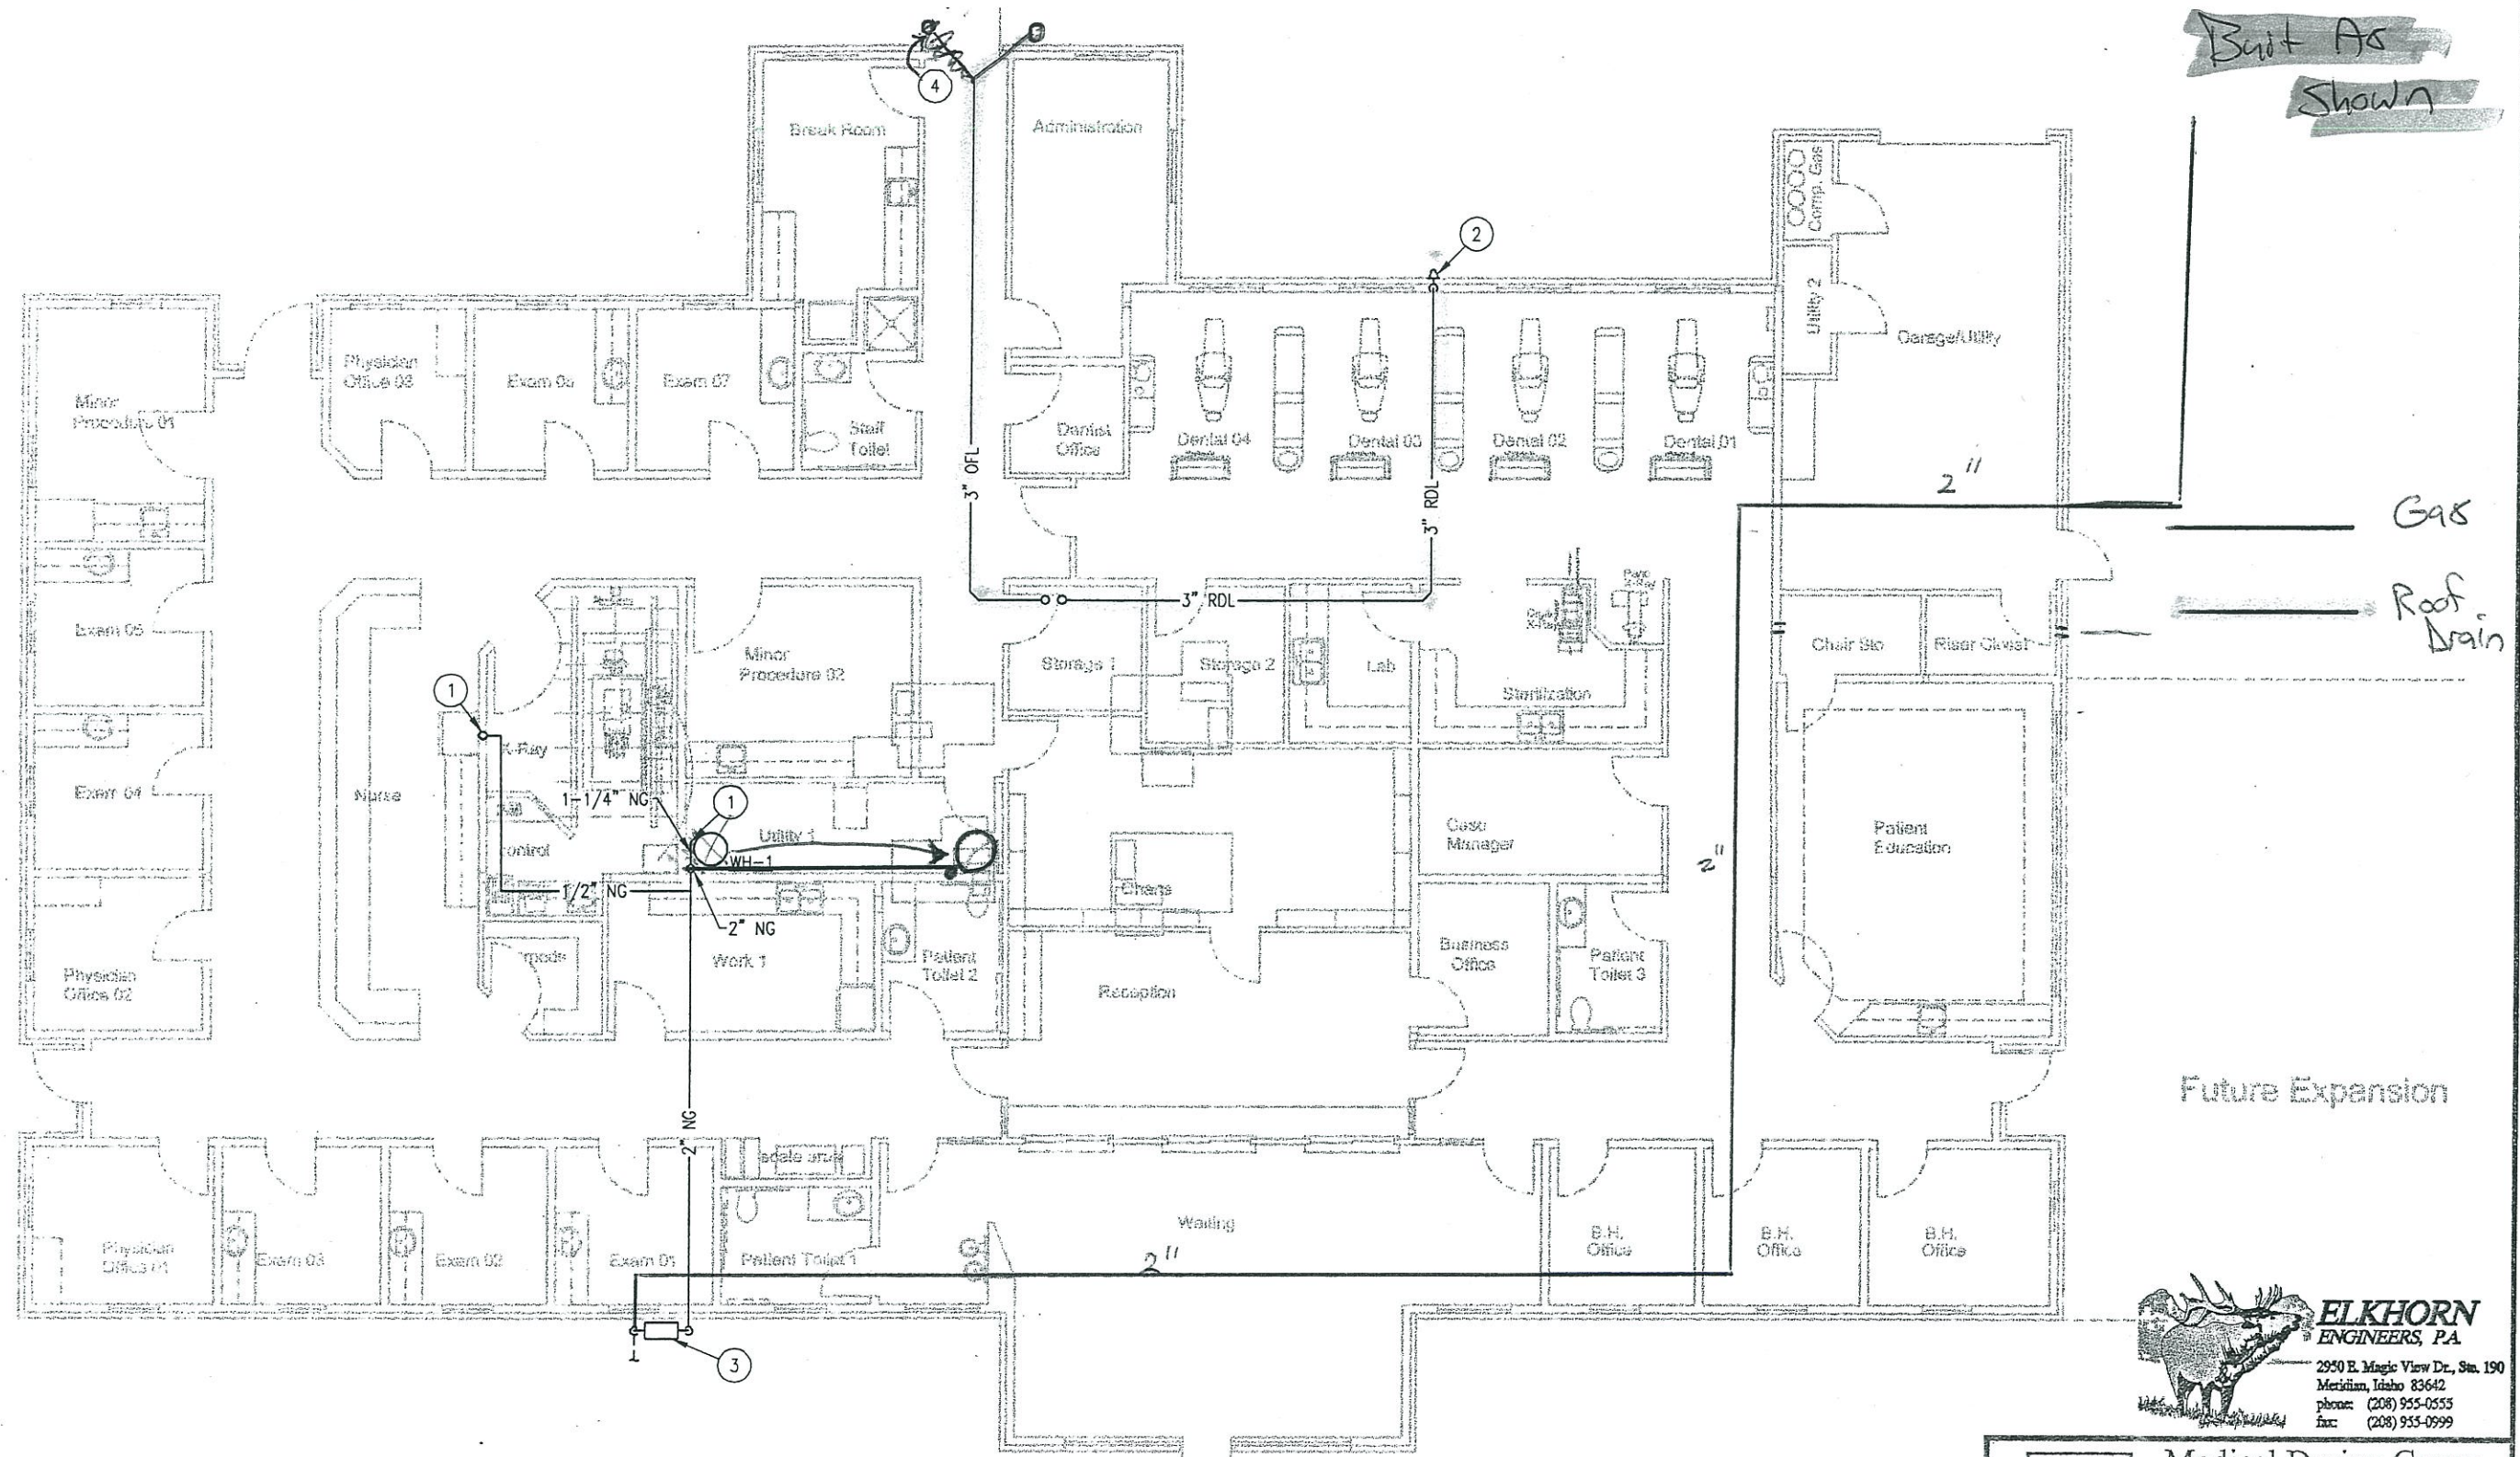

Gas  
Roof  
Drain

Future Expansion

**ELKHORN ENGINEERS, PA**  
 2950 E. Magic View Dr., Ste. 190  
 Meridian, Idaho 83642  
 phone: (208) 955-0555  
 fax: (208) 955-0999

**KEY NOTES:**

- ① SEE DETAIL 2, SHEET P3.1 FOR GAS CONNECTION DETAIL.
- ② DROP 3" RDL IN WALL TO 12" A.F.F. AND TERMINATE WITH BRASS TONGUE.
- ③ GAS METER BY INTERMOUNTAIN GAS CO. SIZED FOR 676 MBH @ 125'-0" (ALL GAS LINES TO BE 7" W.C.)
- ④ TERMINATE 3" OFL 2" BELOW FINISHED SOFFIT FACE, SEAL PENETRATION WATER TIGHT. PROVIDE W/ ESCUTCHEON, PRIMED AND PAINTED TO MATCH.

REGISTERED PROFESSIONAL ENGINEER  
 STATE OF IDAHO  
 STEVEN T. BASTIAN  
 5112  
 3-15-04

**Medical Design Group**  
 Architecture for Health Care  
 2716 WESTLAND PLACE  
 BOISE, IDAHO 83704-5863  
 BOISEARCHITECT@AOL.COM  
 Fax (208) 378-1405  
 Phone (208) 378-0817


© COPYRIGHT: MEDICAL DESIGN GROUP

**PLUMBING FLOOR PLAN**

Desert Sage Health Care 2280 American Legion Blvd. Mountain Home, Idaho	SHEET <b>P1.2</b>
March 2004	

S:\Projects\03MDC002(DesertSageHealth)\Drawings\03MDC002P12.dwg, 3/15/2004 11:54:59 AM, thompson, ANSJ\_B (11.00 x 17.00 inches), 1:1

Built As Shown

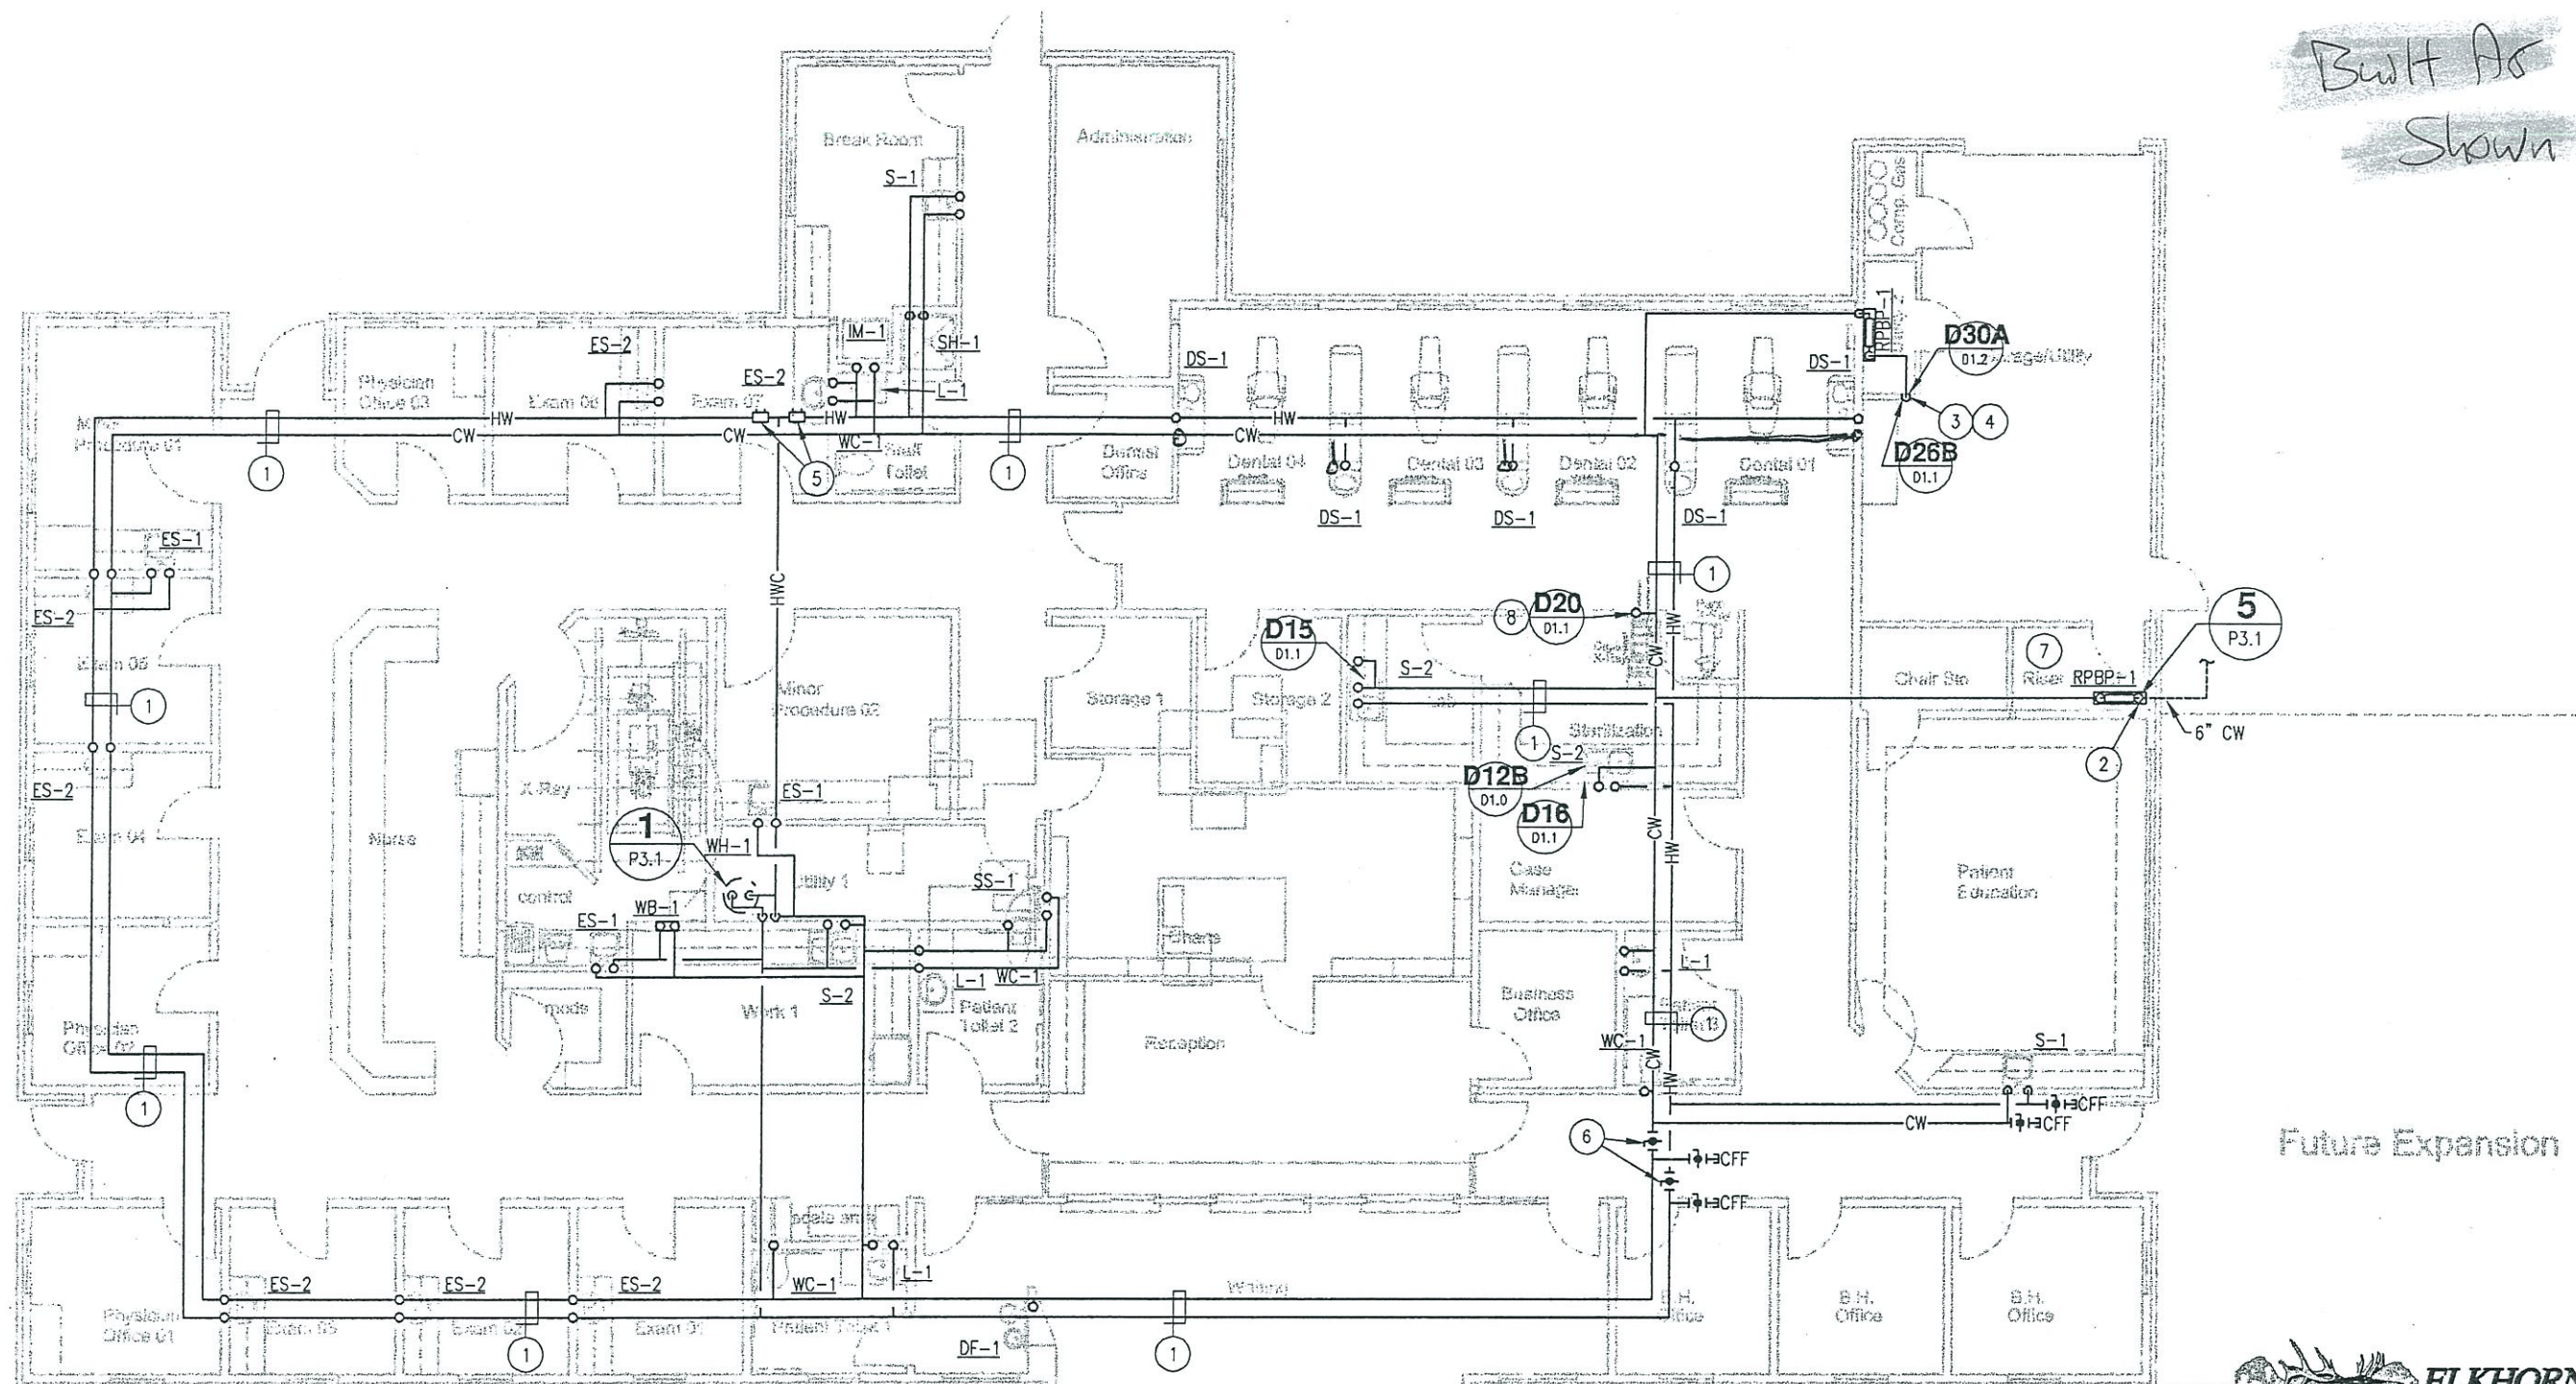

**KEY NOTES:**

- ① FOR WATER SIZING SEE RISER DIAGRAM 1, SHEET P3.3.
- ② 6" CW UP TO RPPB-1.
- ③ DROP 1/2" CW DOWN WALL TO OWNER PROVIDED VACUUM SYSTEM.
- ④ DROP 1" CW DOWN WALL TO OWNER PROVIDED WATER SOLENOID/FILTER.
- ⑤ SET CIRCUIT SETTER TO .5 GPM.
- ⑥ BALL VALVE TO REMAIN OPEN UNTIL FUTURE EXPANSION PIPING IS CONNECTED.
- ⑦ FIRE RISER ENTRANCE. LOCATE RISERS AND VALVES ACCESSORIES IN THIS ROOM PER SPECIFICATION SECTION 15300.
- ⑧ RPPB-1 FOR FILM PROCESSOR

**ELKHORN ENGINEERS, P.A.**  
 2950 E. Magic View Dr., Ste. 190  
 Meridian, Idaho 83642  
 phone: (208) 955-0555  
 fax: (208) 955-0999

**Medical Design Group**  
 Architecture for Health Care  
 2716 WESTLAND PLACE  
 BOISE, IDAHO 83704-5863  
 BOISEARCHITECT@AOL.COM  
 Fax (208) 378-1405  
 Phone (208) 378-0817

© COPYRIGHT: MEDICAL DESIGN GROUP

**PLUMBING FLOOR PLAN**

Desert Sage Health Care 2280 American Legion Blvd. Mountain Home, Idaho	SHEET <b>P1.3</b>
---	----------------------


March 2004

REGISTERED PROFESSIONAL ENGINEER  
 STATE OF IDAHO  
 STEVEN T. BASTIAN  
 5112  
 3-15-04

S:\Projects\03MDCG002\Drawings\03MDCG002P13.dwg, 3/15/2004 11:54:52 AM, thompson, ANSI\_B (11.00 x 17.00 inches), 1:1



Built As  
Shown

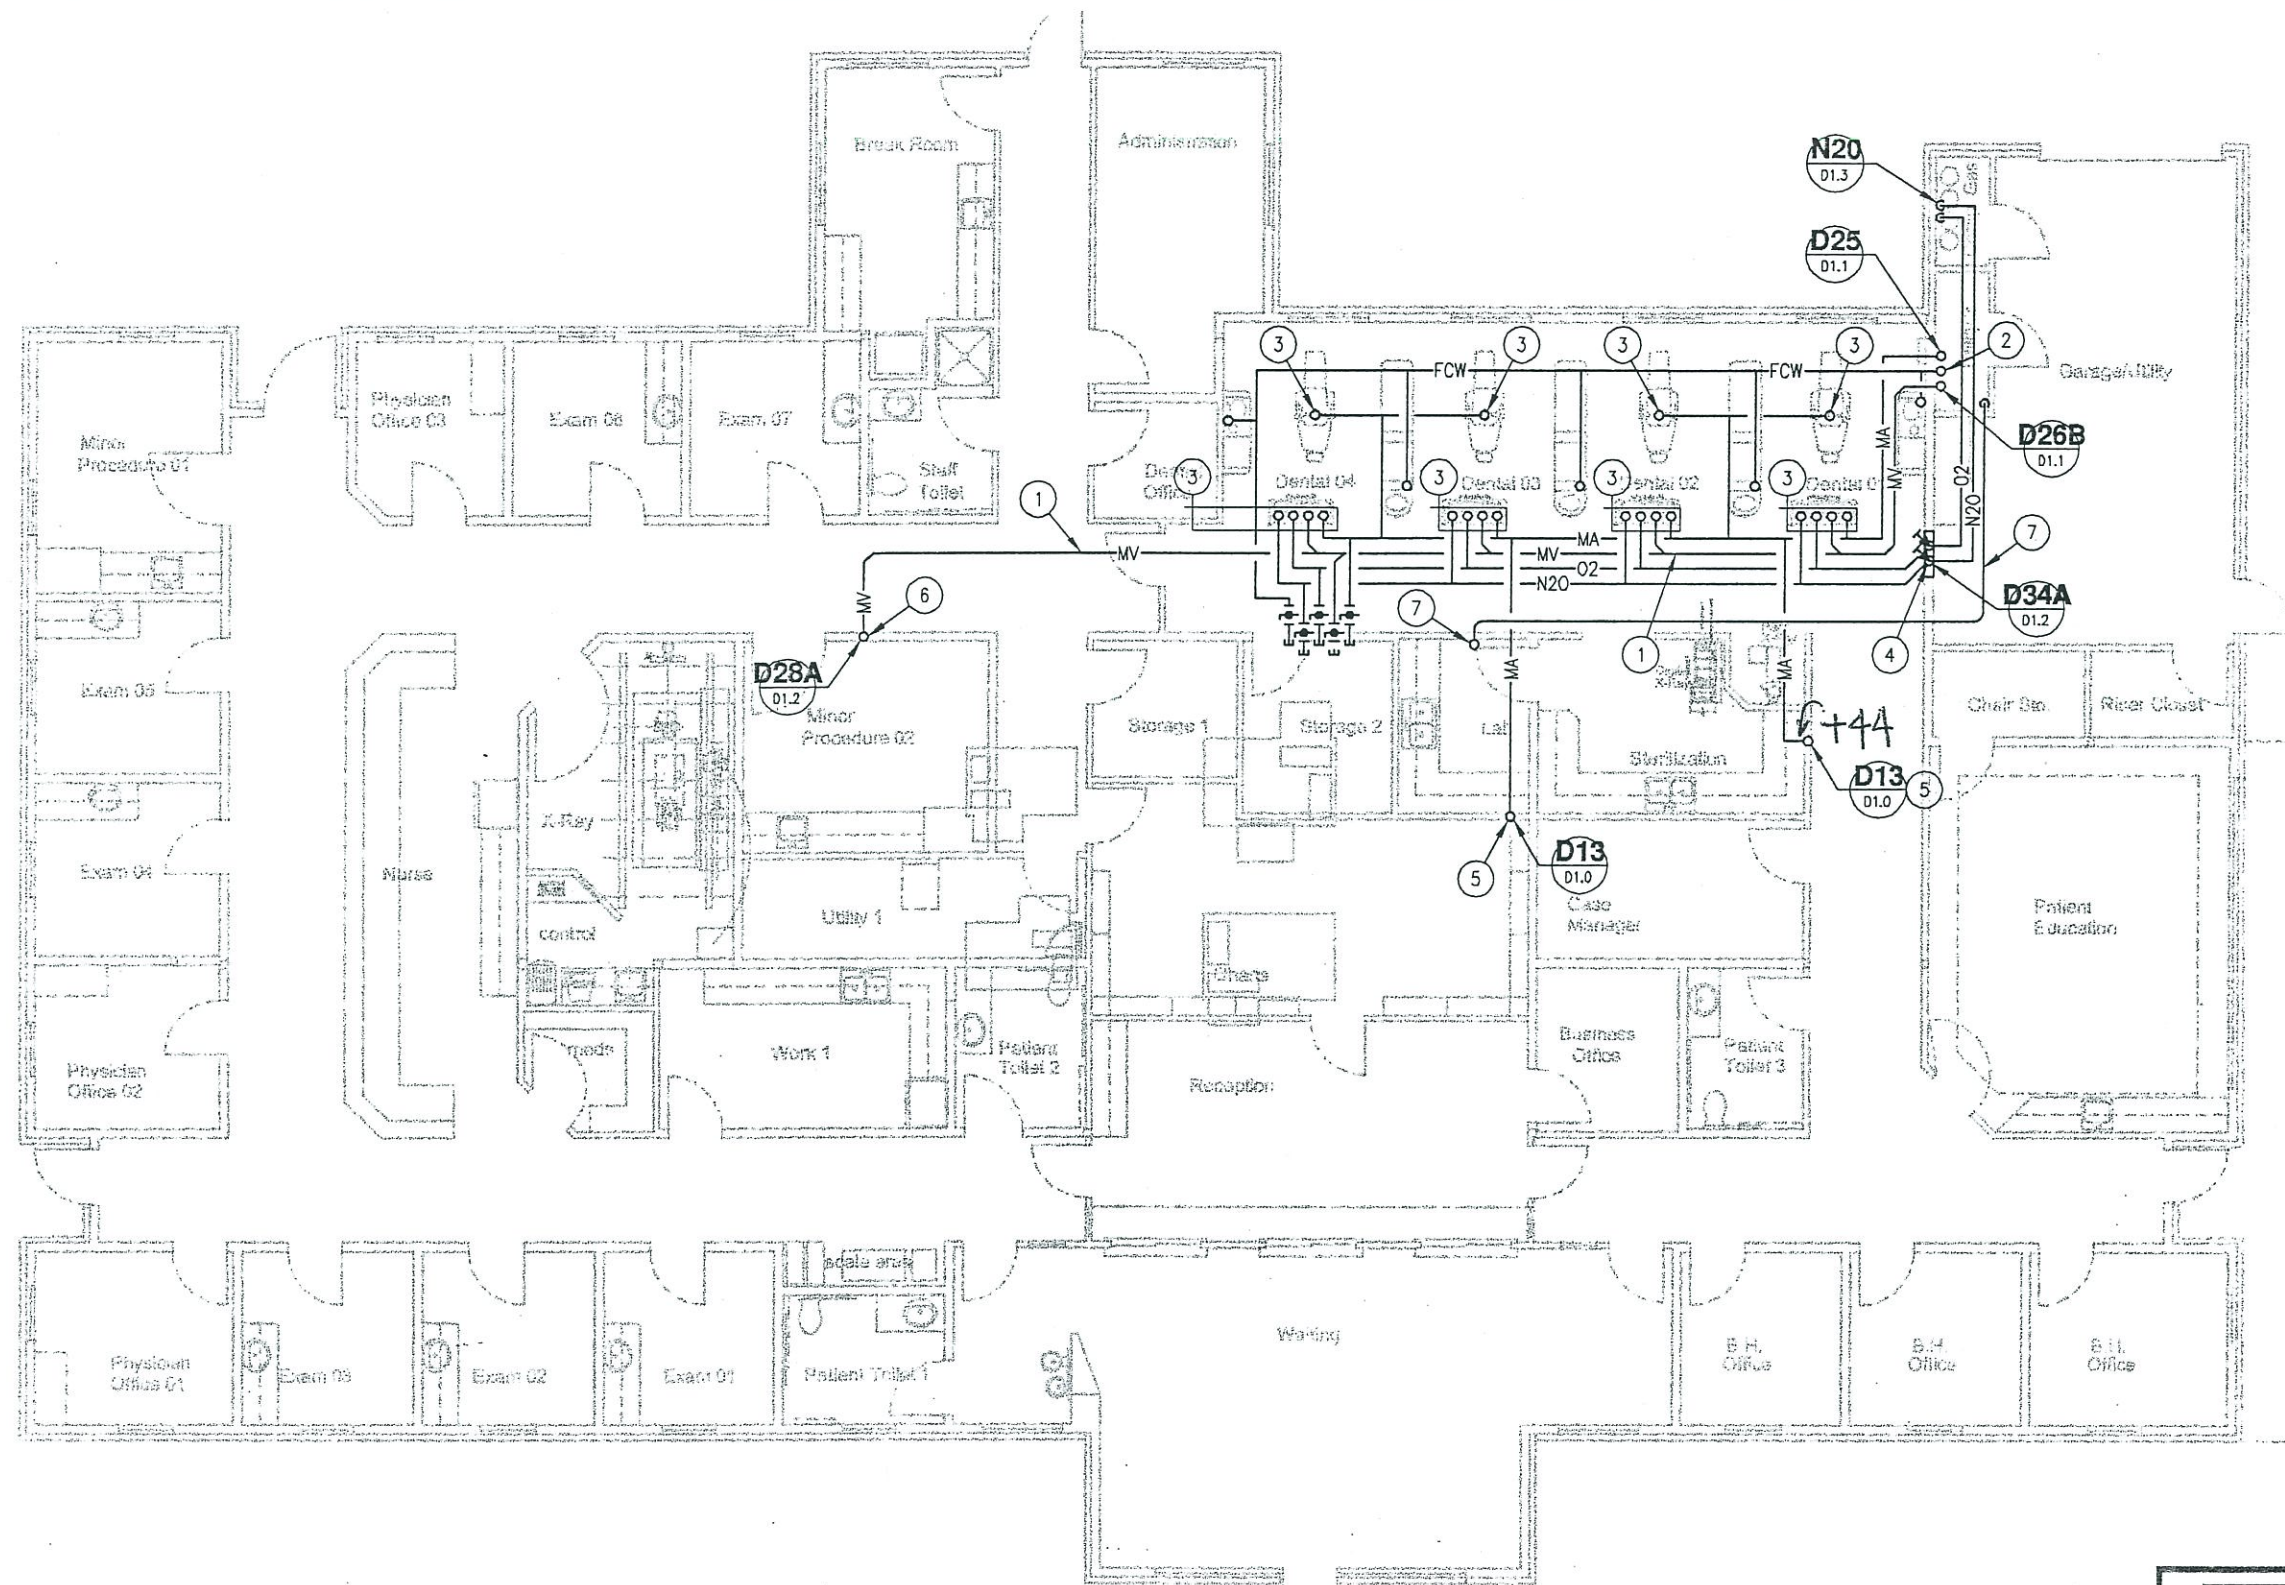


Future Expansion

**KEY NOTES:**

- ① SLOPE ALL MV LINES 1/4" PER FOOT BACK TO VACUUM PUMP. PROVIDE DW FITTINGS FOR VACUUM LINES.
- ② 1" FCW FROM WATER FILTER.
- ③ COORDINATE EXACT LOCATION OF PENETRATIONS WITH D.E.S. IN FIELD.
- ④ 3/4" O2, 3/4" N20 UP TO S.O.V. ON WALL, VALVE TO BE PROVIDED AND INSTALLED BY D.E.S. CLEARLY MARK ALL VALVES WITH TWO COLOR ENGRAVED LAMINATED MARKERS PER NFPA 99.
- ⑤ 1/2" MA UP TO 44" A.F.F., AIR VALVE IN WALL, VALVE TO BE PROVIDED AND INSTALLED BY D.E.S.
- ⑥ 1/2" MV UP TO 44" A.F.F. IN WALL TO WB-1, STUB PIPE 6" INTO BOX AND CAP PER SPECIFICATIONS.
- ⑦ 2" VACUUM EXHAUST, ROUTE AS SHOWN, SEE SHEET P2.1 FOR CONTINUATION.



3-15-04

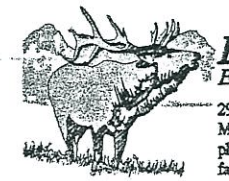


**ELKHORN ENGINEERS, PA**

2950 E. Magic View Dr., Ste. 190  
Meridian, Idaho 83642  
phone: (208) 955-0555  
fax: (208) 955-0999

<p><b>Medical Design Group</b> Architecture for Health Care</p> <p>2716 WESTLAND PLACE BOISE, IDAHO 83704-5863</p> <p>BOISEARCHITECT@AOL.COM Fax (208) 378-1405 Phone (208) 378-0817</p>		<p>© COPYRIGHT: MEDICAL DESIGN GROUP</p>
<p>Desert Sage Health Care 2280 American Legion Blvd. Mountain Home, Idaho</p>		<p>SHEET <b>P1.4</b></p>
<p>March 2004</p>		

S:\Projects\03MDG002\Drawings\03MDG002P14.dwg, 3/15/2004 11:54:45 AM, thompson, ANSI B (11.00 x 17.00 inches), 1:1

S:\Projects\03MDG002\Drawings\03MDG002P21.dwg, 3/15/2004 11:54:39 AM, thompson, ANSI B (11.00 x 17.00 inches), 1:1

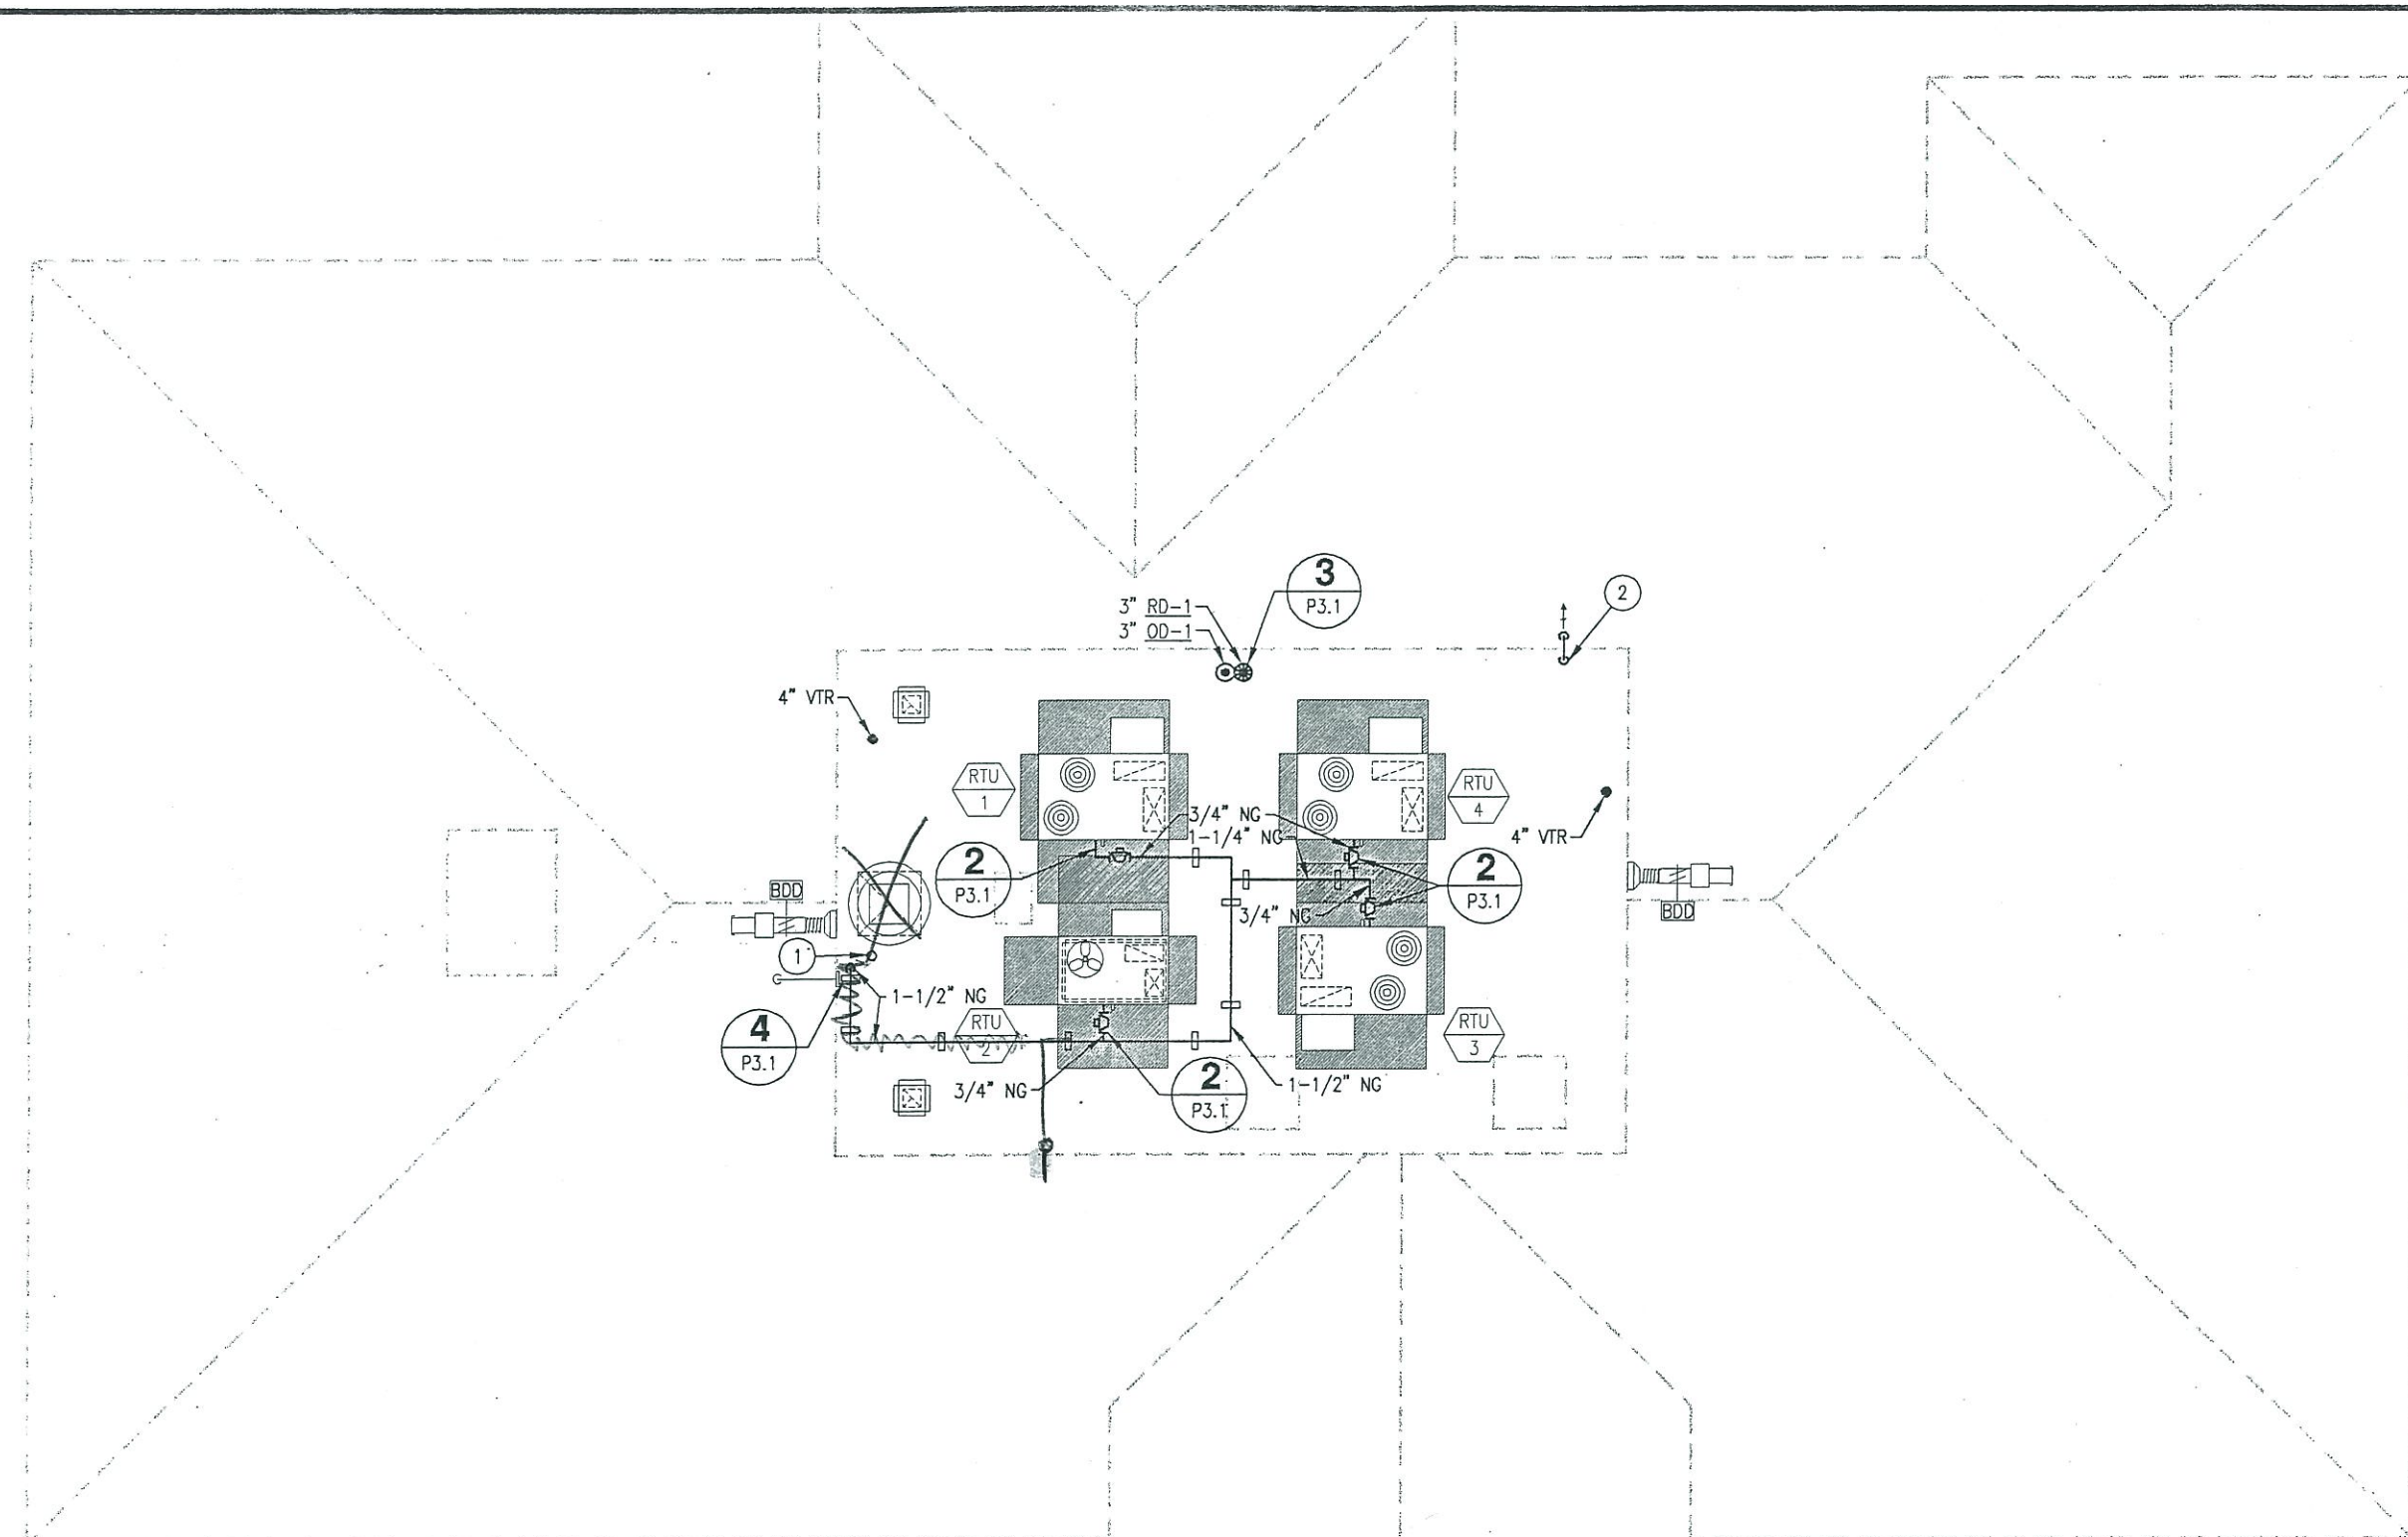


Gas

**ELKHORN ENGINEERS, P.A.**  
 2950 E. Magic View Dr., Ste. 190  
 Meridian, Idaho 83642  
 phone: (208) 955-0555  
 fax: (208) 955-0999

**KEY NOTES:**


- ① CONCENTRIC VENT FROM BELOW, TERMINATE PER MANUFACTURERS WRITTEN INSTRUCTION.
- ② 2" VACUUM EXHAUST UP INTO EQUIPMENT WELL FROM BELOW, ROUTE THRU PARAPET WALL TO TERMINATE ABOVE ROOF WITH TURNED DOWN 90° ELL FITTING AND NON CORROSIVE INSECT SCREEN.

REGISTERED PROFESSIONAL ENGINEER  
 STATE OF IDAHO  
 STEVEN T. BASTIAN  
 5112  
 3-15-04

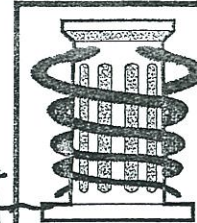


**Medical Design Group**  
 Architecture for Health Care  
 2716 WESTLAND PLACE  
 BOISE, IDAHO 83704-5863  
 BOISEARCHITECT@AOL.COM  
 Fax (208) 378-1405  
 Phone (208) 378-0817


© COPYRIGHT: MEDICAL DESIGN GROUP

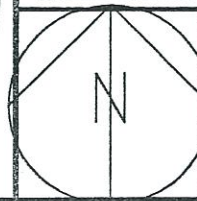


<b>PLUMBING ROOF PLAN</b>	
Desert Sage Health Care 2280 American Legion Blvd. Mountain Home, Idaho	SHEET P2.1
March 2004	

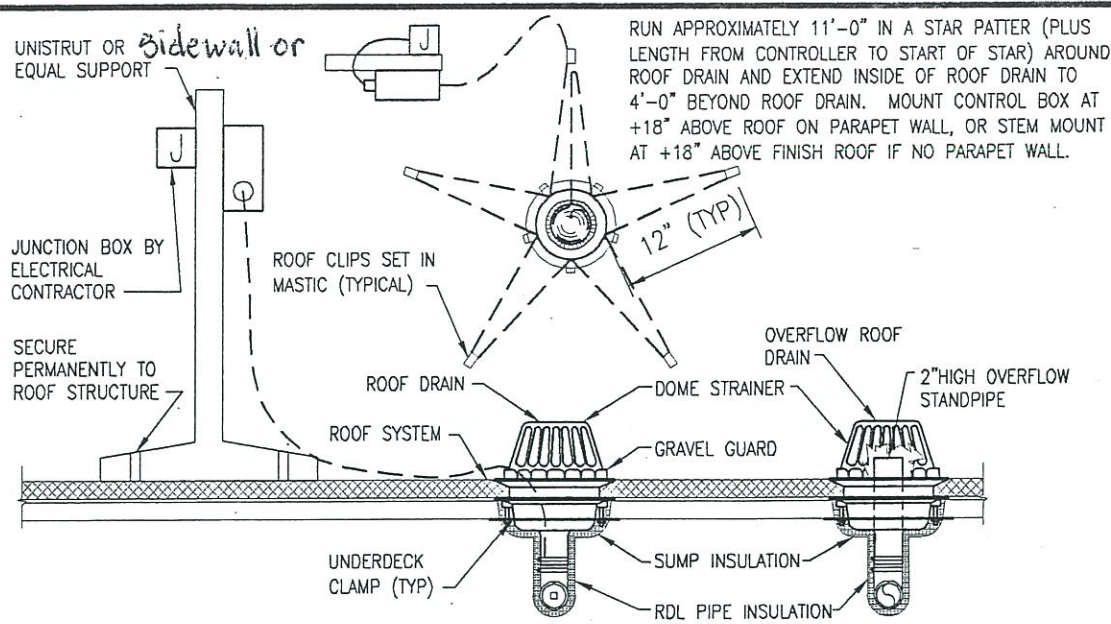

**ROOF/OVERFLOW DRAIN DETAIL** 3  
SCALE: NTS

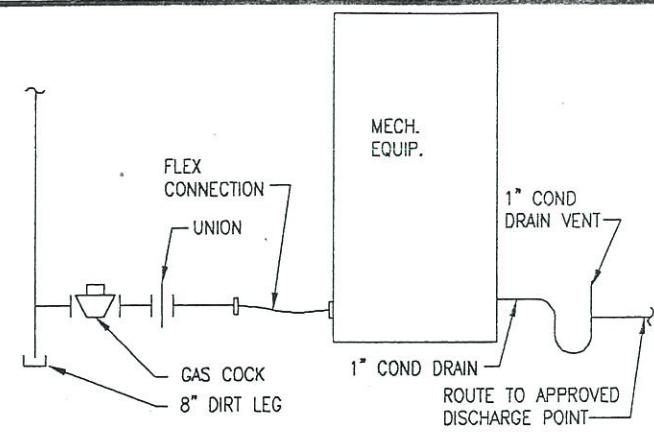


**GAS/CONDENSATE CONNECTION DETAIL** 2  
SCALE: NTS

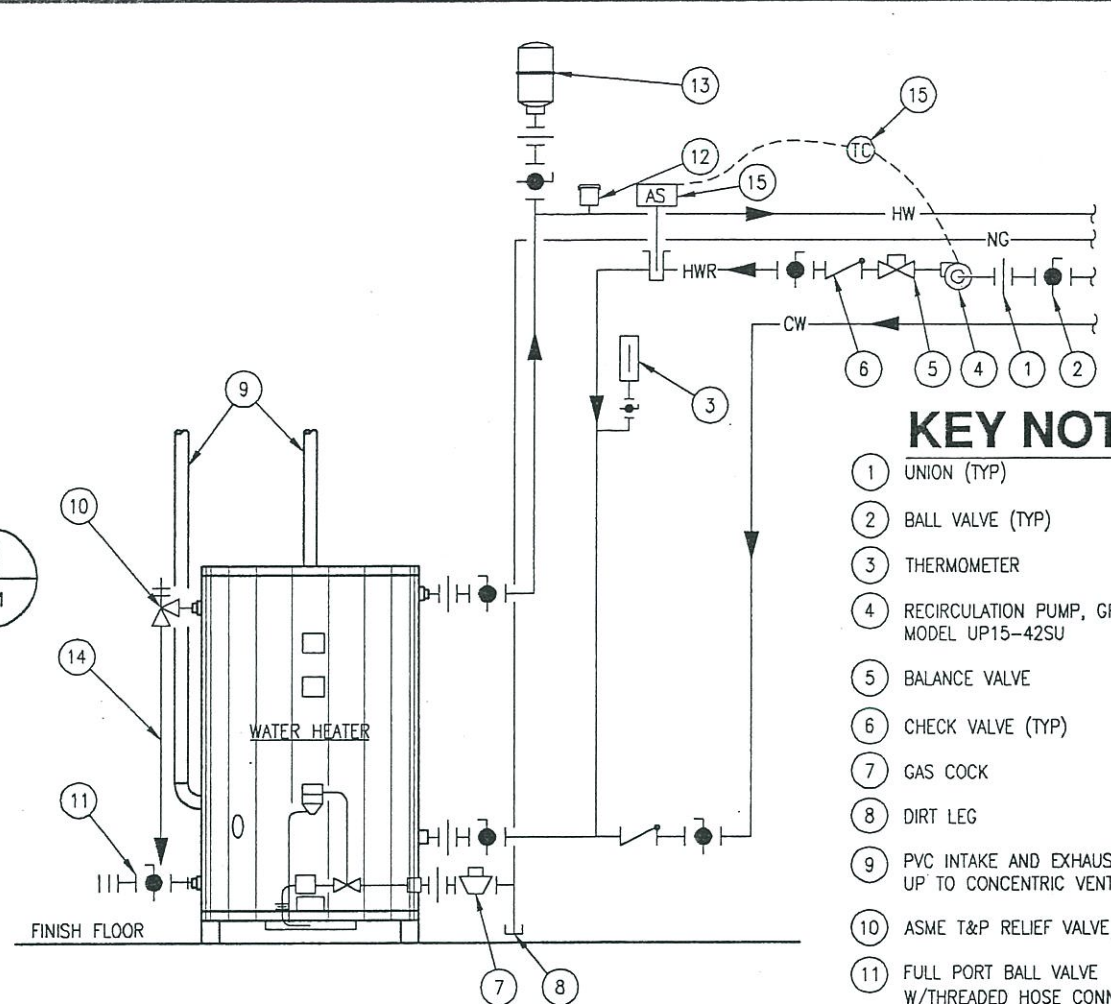


**GAS FIRE WATER HEATER DETAIL** 1  
SCALE: NTS

- KEY NOTES:**
- 1 UNION (TYP)
  - 2 BALL VALVE (TYP)
  - 3 THERMOMETER
  - 4 RECIRCULATION PUMP, GRUNDFOS MODEL UP15-42SU
  - 5 BALANCE VALVE
  - 6 CHECK VALVE (TYP)
  - 7 GAS COCK
  - 8 DIRT LEG
  - 9 PVC INTAKE AND EXHAUST PIPES UP TO CONCENTRIC VENT
  - 10 ASME T&P RELIEF VALVE
  - 11 FULL PORT BALL VALVE W/THREADED HOSE CONNECTION
  - 12 VACUUM RELIEF VALVE
  - 13 EXPANSION TANK (2.5 ACCEPTANCE GALLONS)
  - 14 PIPE TO FLOOR DRAIN
  - 15 AQUASTAT AND TIME CLOCK.

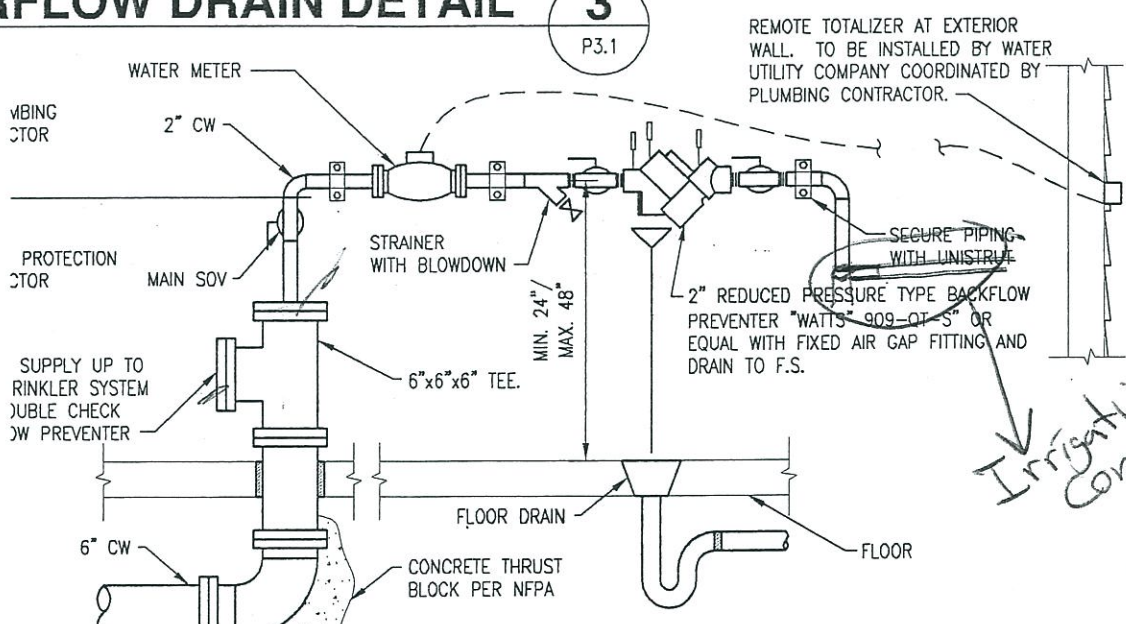

**WATER RISER DETAIL** 5  
SCALE: NTS

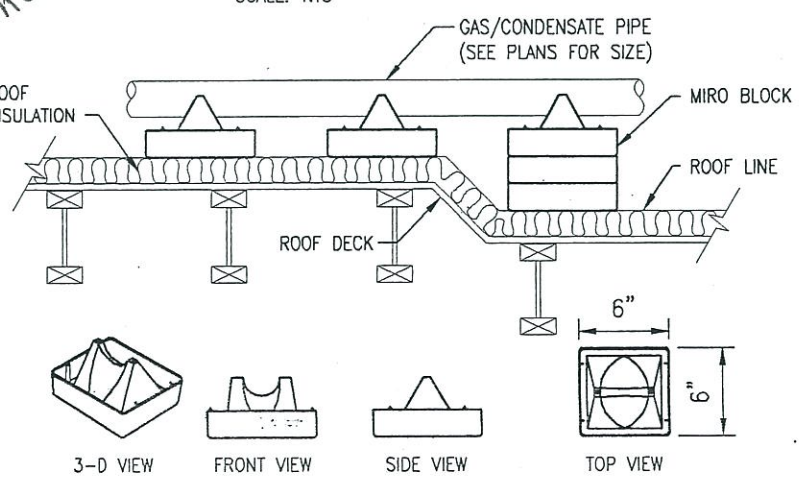


**HORIZONTAL PIPING SUPPORT**

PIPE SIZE "INCHES"	SUPPORT DISTANCE "FEET"
1/2"	6'
3/4"	8'
1"	8'
1-1/4"	10'
1-1/2"	10'


NOTE: MIRO MODEL 1.5

**MIRO BLOCK DETAIL** 4  
SCALE: NTS

- DETAIL NOTE REQUIREMENTS:**
- 1) EXTEND VENT AS HIGH AS POSSIBLE, BUT NOT LESS THAN THE DRAINBOARD HEIGHT AND THEN RETURNING IT DOWNWARD AND CONNECTING IT TO THE HORIZONTAL SINK DRAIN IMMEDIATELY DOWNSTREAM FROM THE VERTICAL FIXTURE DRAIN.
  - 2) THE RETURNED VENT SHALL BE CONNECTED TO THE HORIZONTAL DRAIN THROUGH A Y-BRANCH FITTING AND SHALL, IN ADDITION, BE PROVIDED WITH A FOOT VENT TAKEN OFF THE VERTICAL FIXTURE VENT BY MEANS OF A Y-BRANCH IMMEDIATELY BELOW THE FLOOR AND EXTENDING TO THE NEAREST PARTITION AND THENCE THROUGH THE ROOF OR CONNECTED TO OTHER VENTS, IN AN APPROVED MANNER.
  - 3) DRAINAGE FITTINGS SHALL BE USED ON ALL PARTS OF THE VENT BELOW THE FLOOR AND A MINIMUM SLOPE OF 1/4 INCH PER FOOT BACK TO THE DRAIN SHALL BE MAINTAINED.
  - 4) THE RETURN BEND UNDER THE DRAINBOARD SHALL BE A ONE-PIECE FITTING OR AN ASSEMBLY OF A 45°, A 90°, AND A 45° IN THE ORDER NAMED.
  - 5) THE ISLAND SINK DRAIN, UPSTREAM OF THE RETURNED VENT, SHALL SERVE NO OTHER FIXTURES.

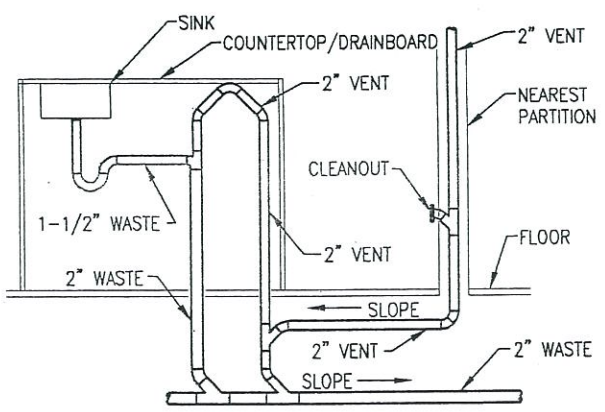

**ISLAND SINK VENTING DETAIL** 6  
SCALE: NTS

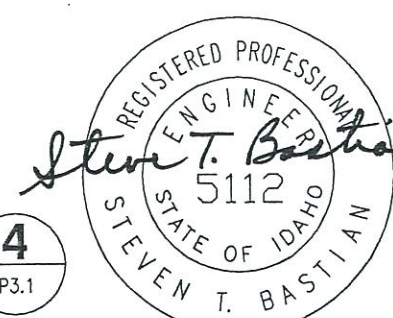

3-15-07



**Medical Design Group**  
Architecture for Health Care

2716 WESTLAND PLACE  
BOISE, IDAHO 83704-5863  
BOISEARCHITECT@AOL.COM  
Fax (208) 378-1405  
Phone (208) 378-0817

© COPYRIGHT: MEDICAL DESIGN GROUP

**PLUMBING DETAILS**


Desert Sage Health Care  
2280 American Legion Blvd.  
Mountain Home, Idaho

SHEET  
P3.1

March 2004

S:\Projects\03MDC002\Drawings\03MDC002P3.1.dwg, 3/15/2004 11:54:32 AM, thompson, ANSI B (11.00 x 17.00 inches), 1:1


S:\projects\desert\desert\drawings\plumbing\dwg\_3713/4004\_11:04:20 AM, timpison, ANSI B (11.00 x 17.00 inches), 1:1

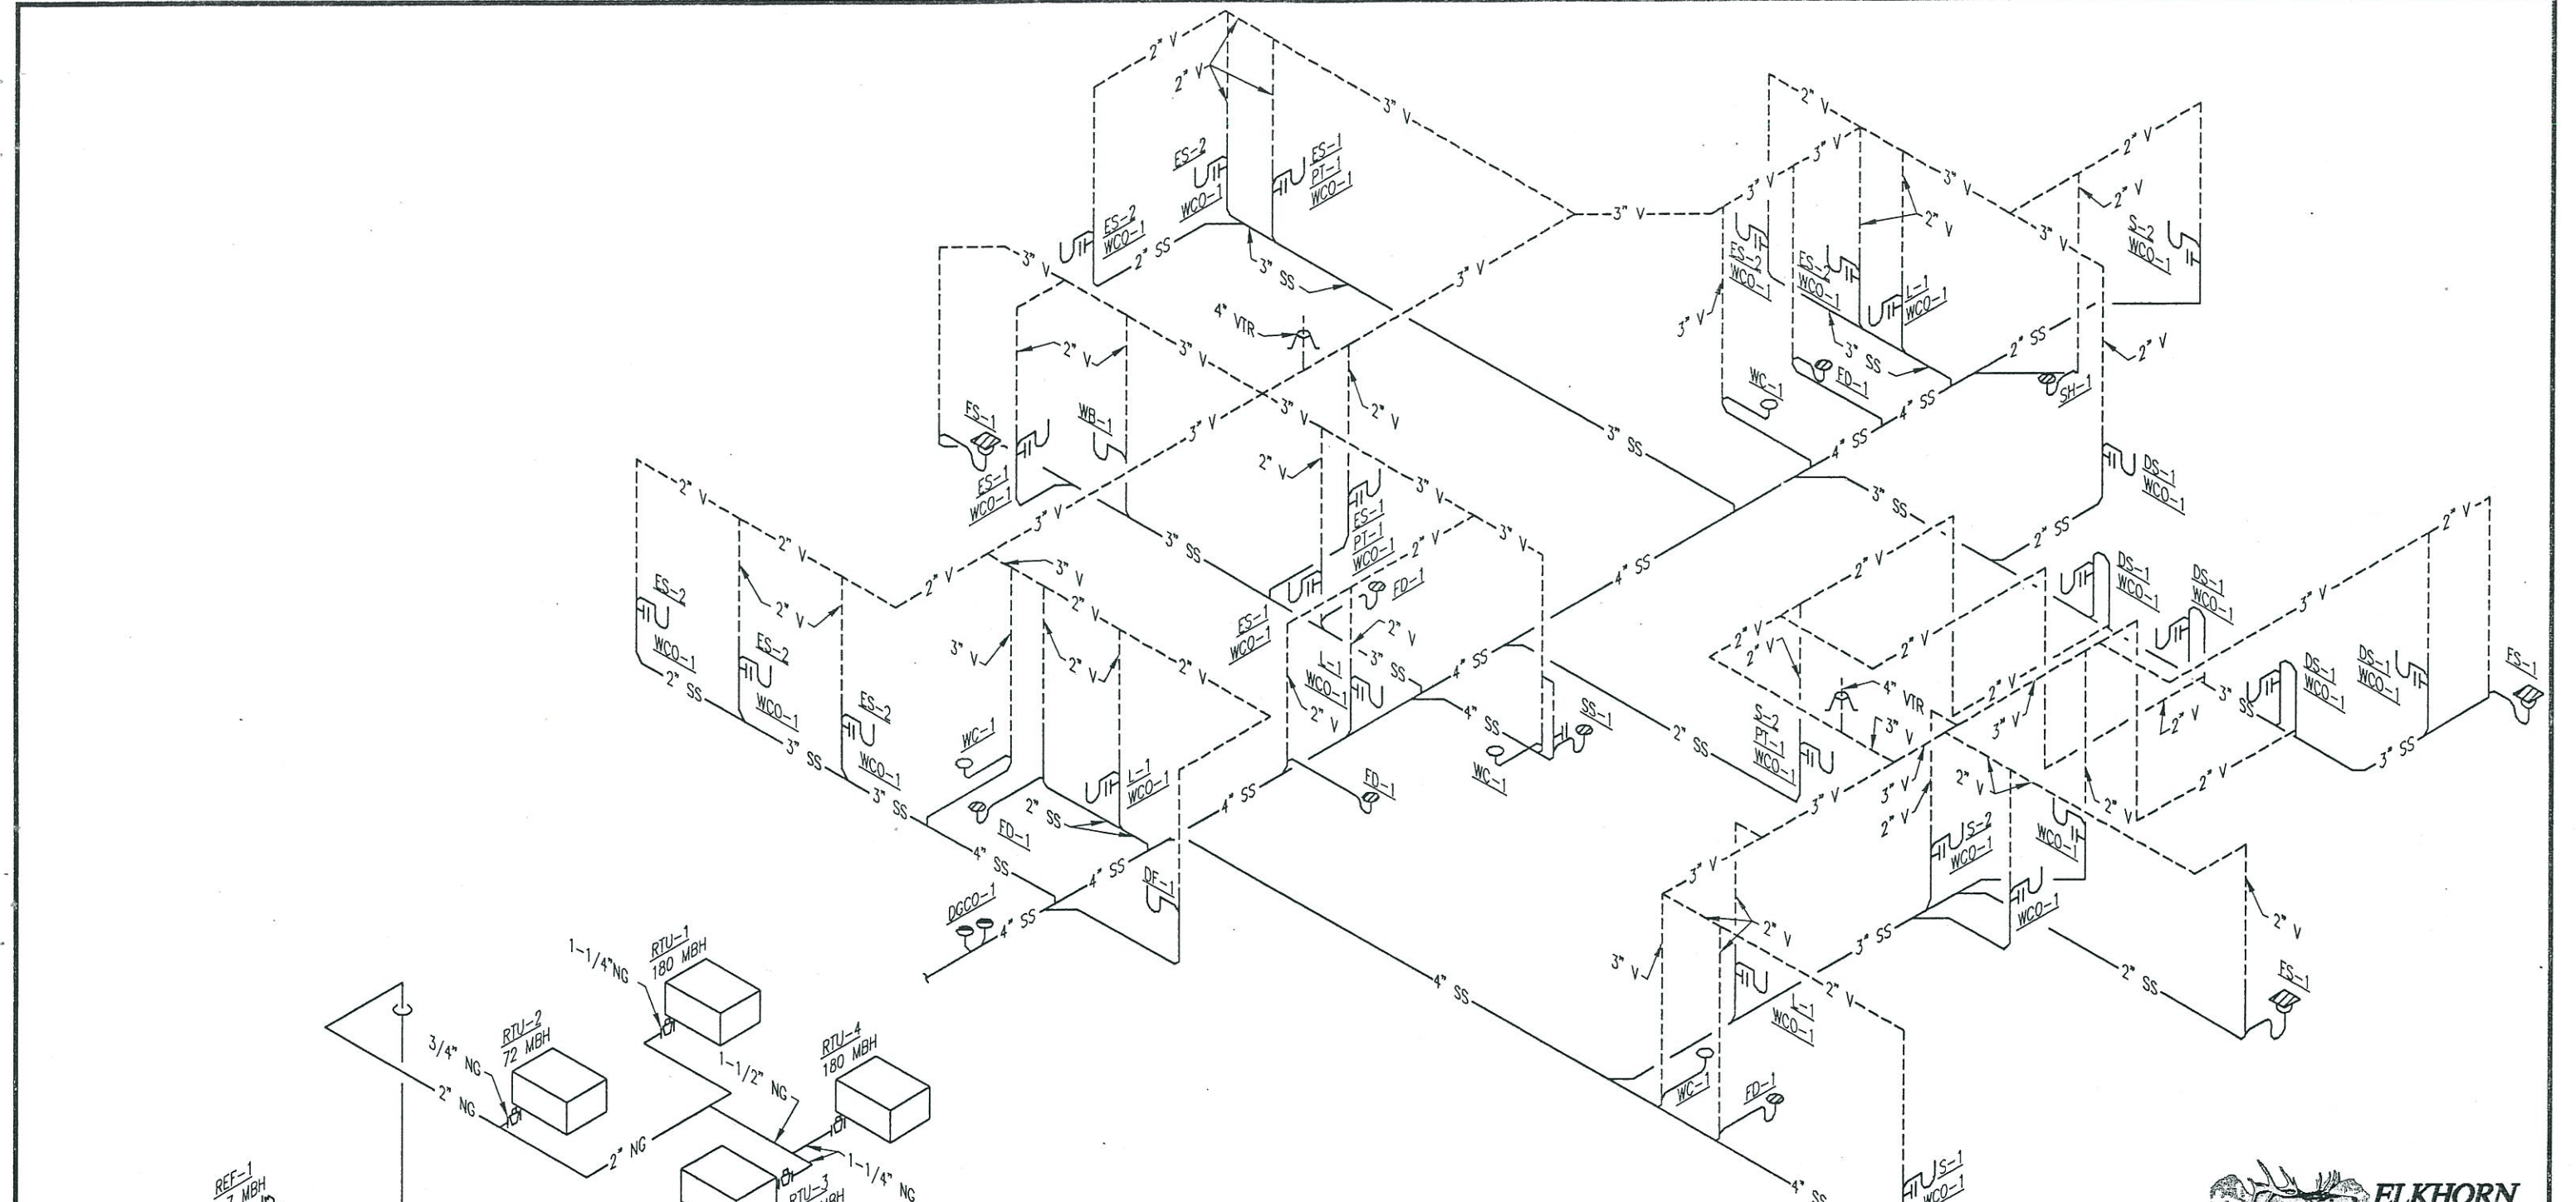

### WASTE & VENT RISER DIAGRAM

SCALE: NTS

2  
P.3.2

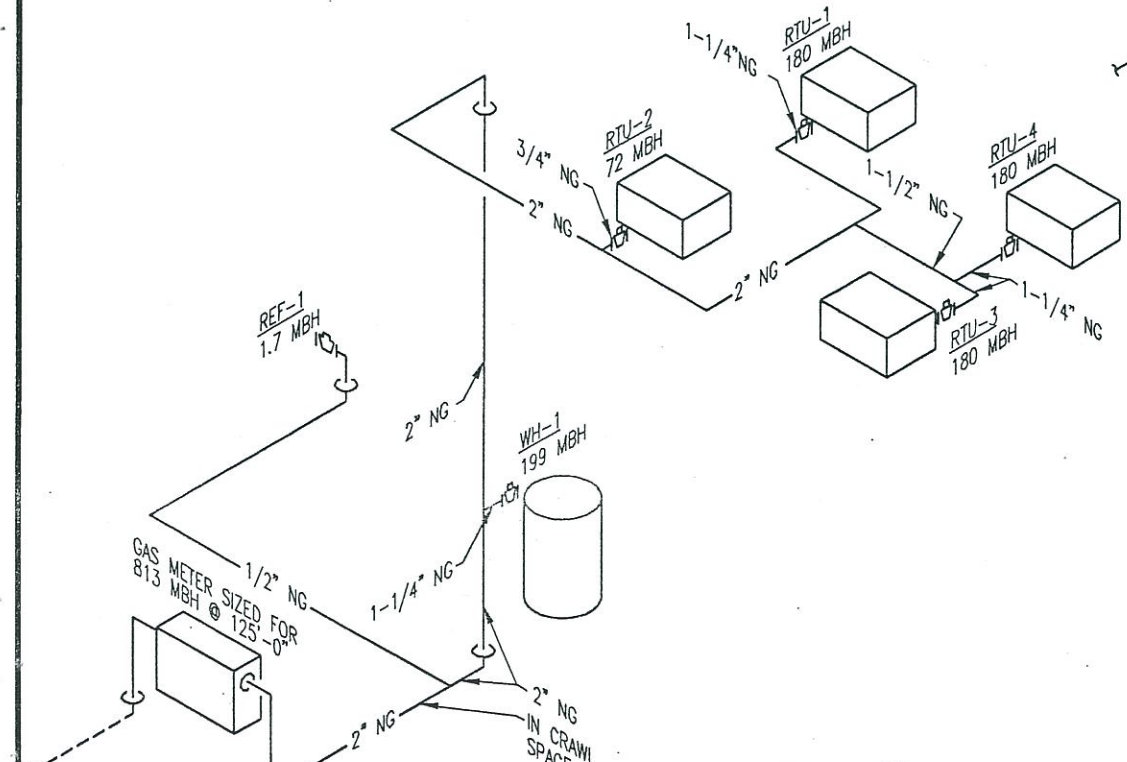

### GAS RISER DIAGRAM

SCALE: NTS

1  
P.3.2

**ELKHORN ENGINEERS, PA.**  
 2950 E. Magic View Dr., Ste. 190  
 Meridian, Idaho 83642  
 phone: (208) 955-0555  
 fax: (208) 955-0999

REGISTERED PROFESSIONAL ENGINEER  
 STEVEN T. BASTIAN  
 5112  
 STATE OF IDAHO  
 3-15-04

Medical Design Group  
 Architecture for Health Care  
 2716 WESTLAND PLACE  
 BOISE, IDAHO 83704-5863  
 BOISEARCHITECT@AOL.COM  
 Fax (208) 378-1405  
 Phone (208) 378-0817


© COPYRIGHT: MEDICAL DESIGN GROUP

PLUMBING DETAILS

Desert Sage Health Care  
 2280 American Legion Blvd.  
 Mountain Home, Idaho

SHEET  
 P.3.2

March 2004

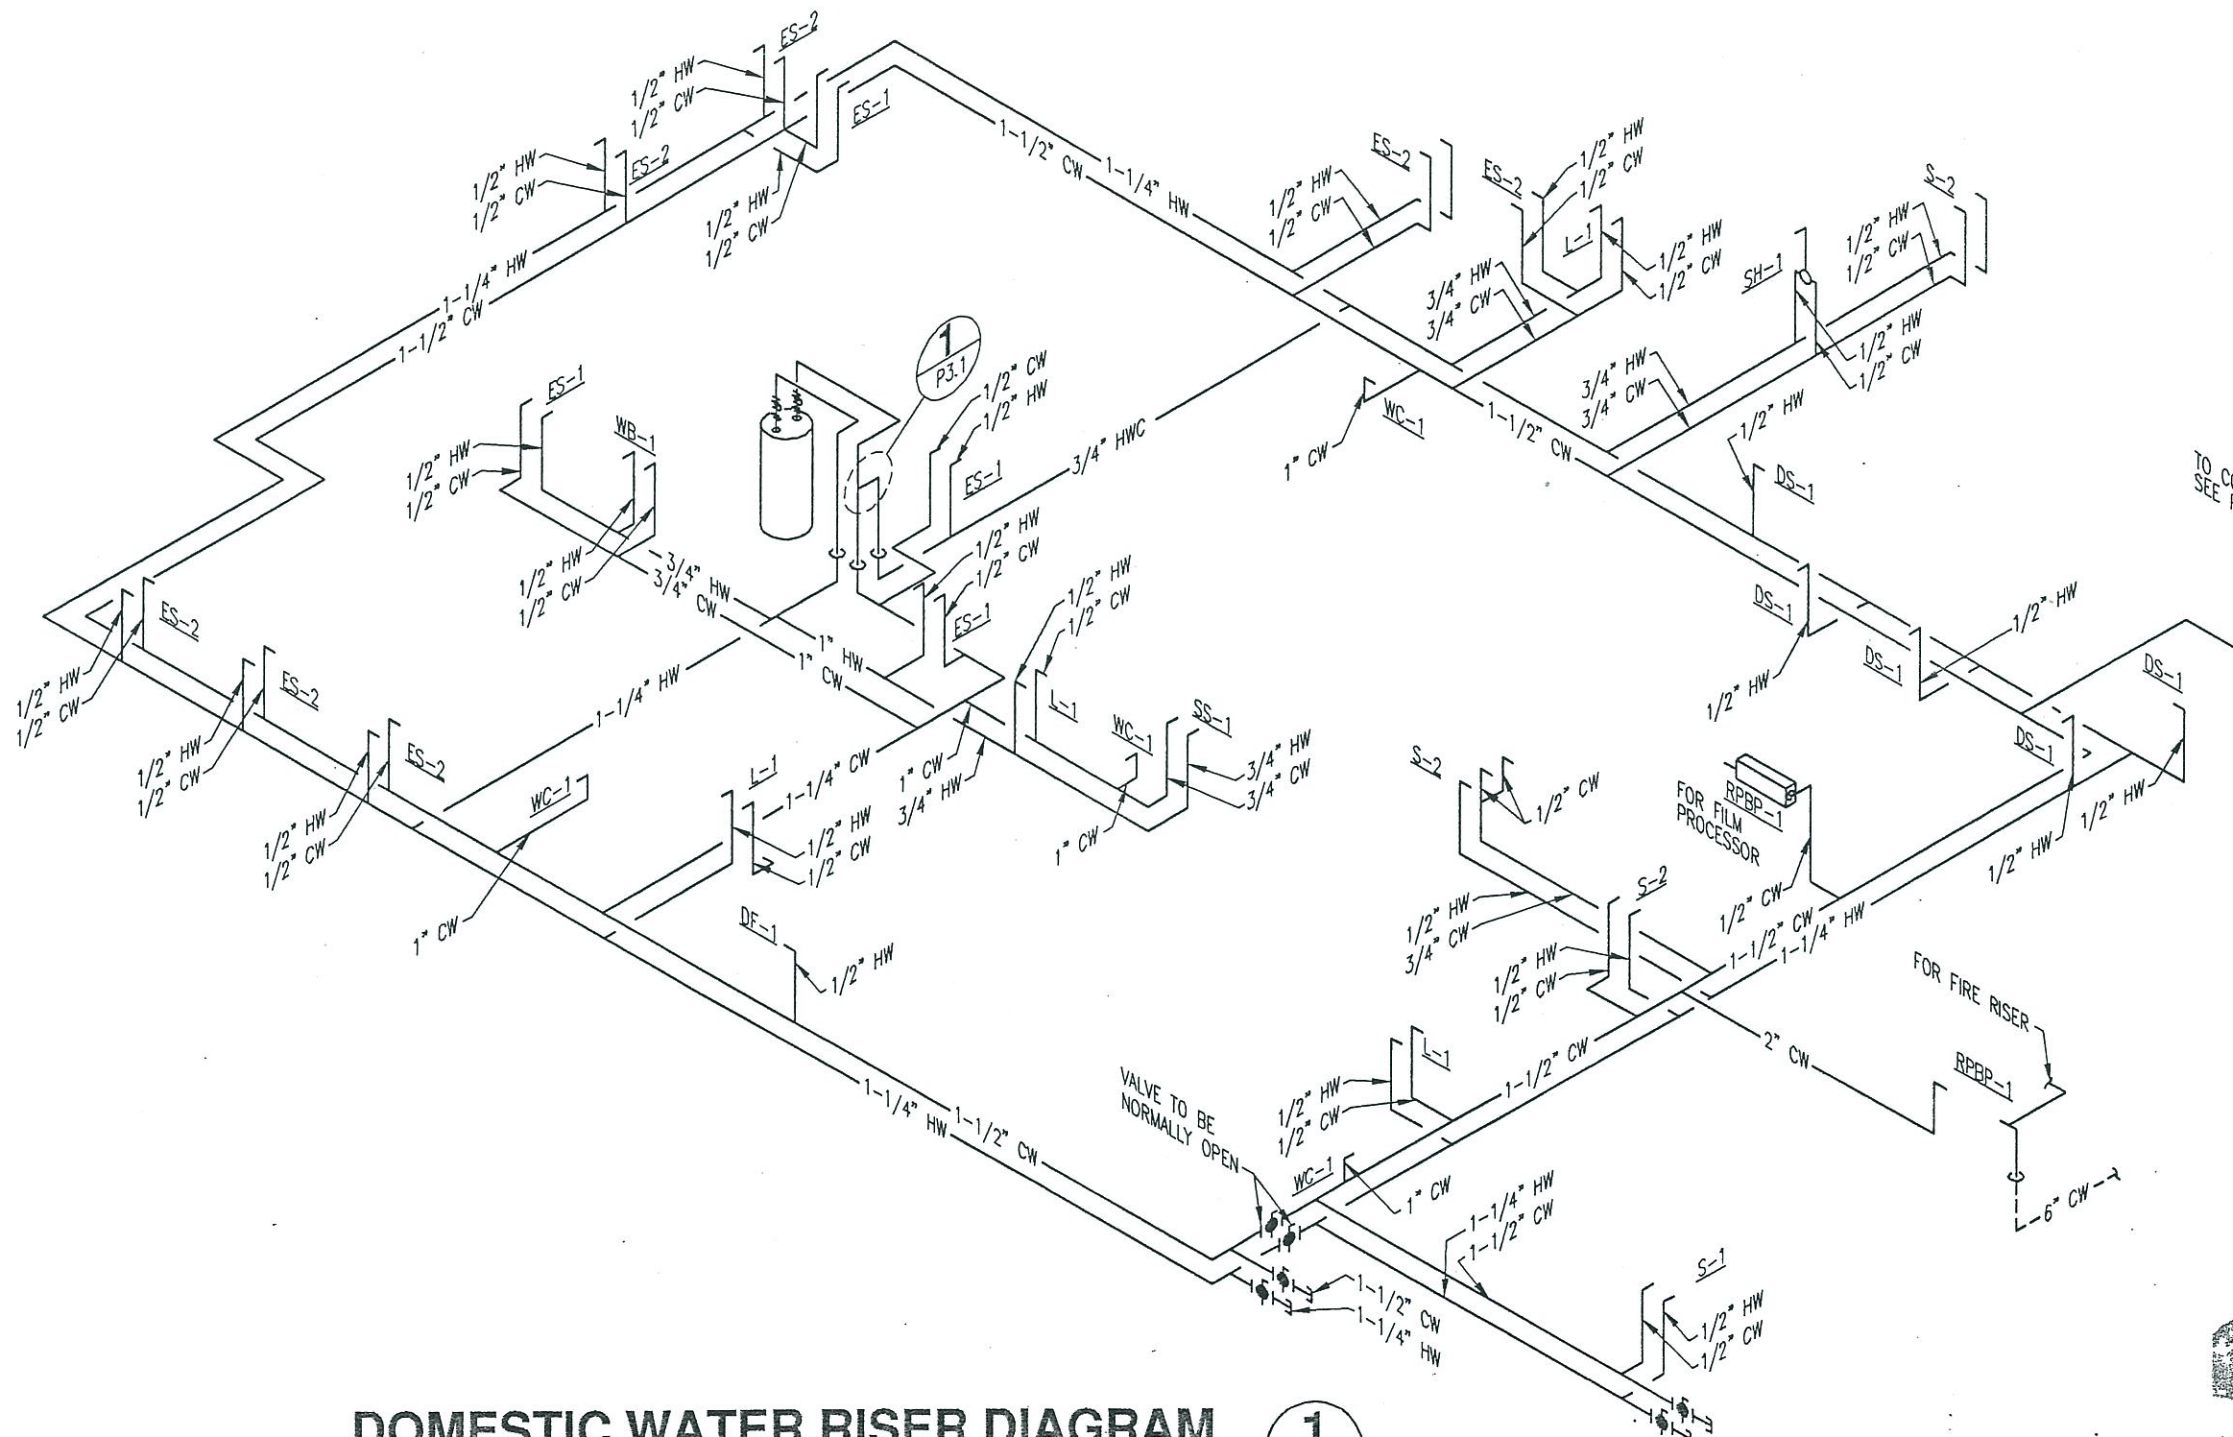

**DOMESTIC WATER RISER DIAGRAM**  
SCALE: NTS

**1**  
P3.3

**ELKHORN ENGINEERS, PA**  
2950 E. Magic View Dr., Ste. 190  
Meridian, Idaho 83642  
phone: (208) 955-0555  
fax: (208) 955-0999

REGISTERED PROFESSIONAL ENGINEER  
STATE OF IDAHO  
5112  
STEVEN T. BASTIAN  
3-15-04

**Medical Design Group**  
Architecture for Health Care  
2716 WESTLAND PLACE  
BOISE, IDAHO 83704-5863  
BOISEARCHITECT@AOL.COM  
Fax (208) 378-1405  
Phone (208) 378-0817

© COPYRIGHT: MEDICAL DESIGN GROUP

**PLUMBING DETAILS**


Desert Sage Health Care 2280 American Legion Blvd. Mountain Home, Idaho	SHEET <b>P3.3</b>
March 2004	

TO CO  
SEE P.

FOR FIRE RISER


FOR FILM PROCESSOR

VALVE TO BE  
NORMALLY OPEN

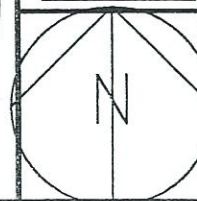

S:\Projects\333MDX3002\DesertSageHealthCare\Drawings\333MDX3002.P3.3.dwg, 3/17/2004 11:27:19 AM, 11.00 INCHES, 1:1


S:\Projects\03MJD002\Drawings\03MJD002P34.dwg, 3/15/2004 11:54:13 AM, thompson, ANSI B (11.00 x 17.00 inches), 1:1

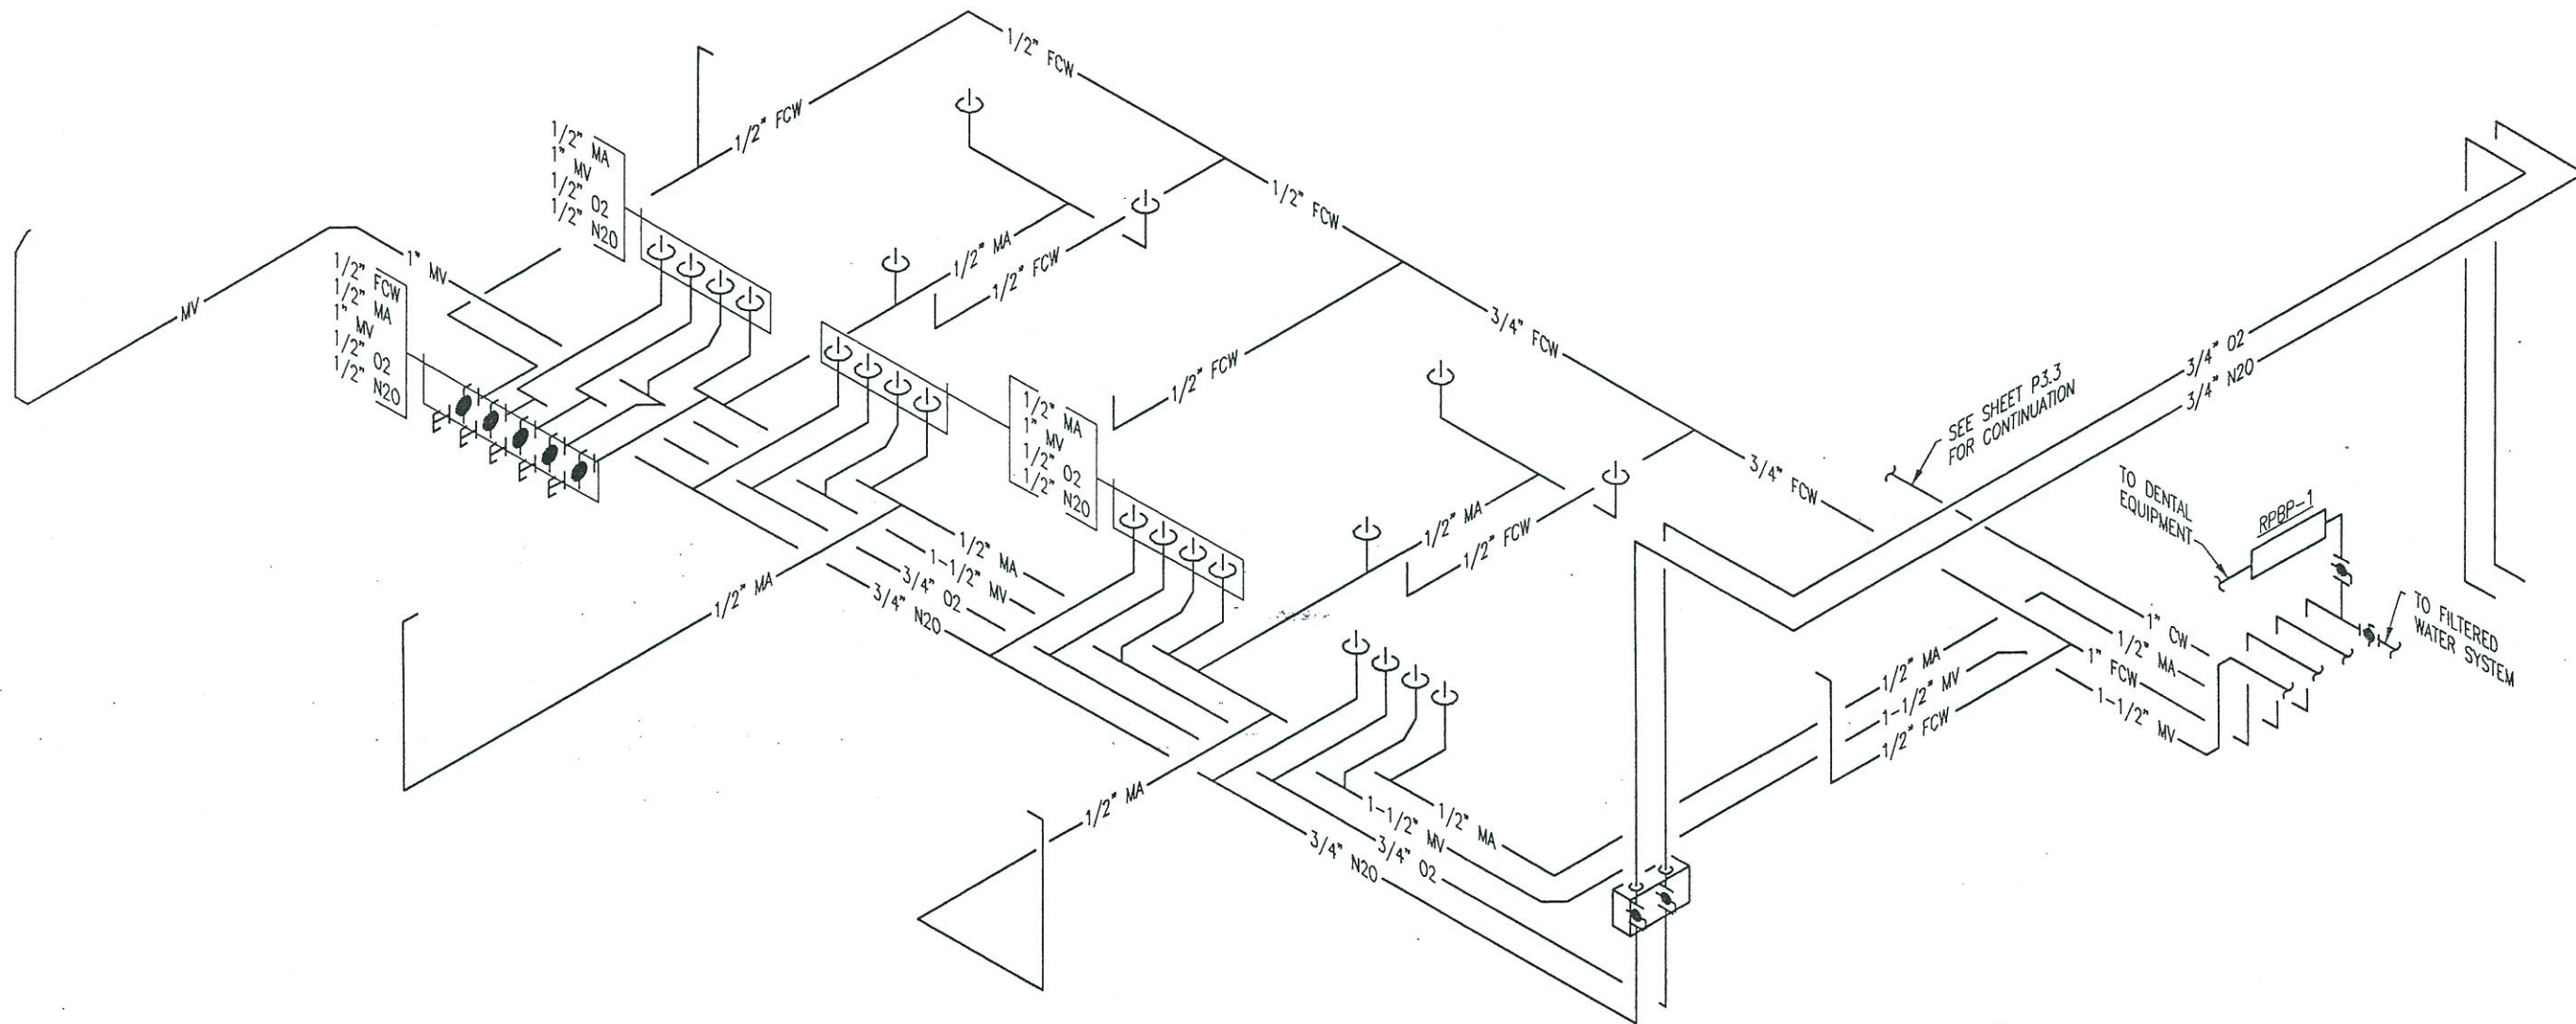


# MEDICAL GAS & WATER RISER DIAGRAM

SCALE: NTS

2  
P3.3

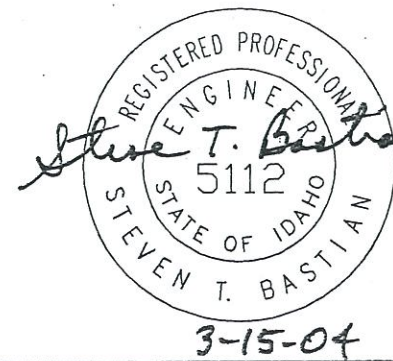

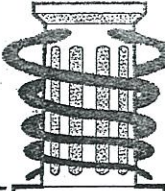 <b>Medical Design Group</b> Architecture for Health Care 2716 WESTLAND PLACE BOISE, IDAHO 83704-5863 BOISEARCHITECT@AOL.COM Fax (208) 378-1405 Phone (208) 378-0817		© COPYRIGHT: MEDICAL DESIGN GROUP	
		<b>PLUMBING DETAILS</b>	
Desert Sage Health Care 2280 American Legion Blvd. Mountain Home, Idaho		SHEET <b>P3.4</b>	
March 2004			

Mechanical Compliance Certificate

2000 IECC

COMcheck-EZ Software Version 2.4 Release 2
Data filename: S:\Projects\03MDG002\DesertSageHealth\Documents\Calculations\01-15-04-COM.cck

Section 1: Project Information

Project Name: Desert Sage Health Care
Designer/Contractor:
Telephone:
Document Author: Tyler Thompson

Section 2: General Information

Building Location (for weather data): Mountain Home, Idaho
Climate Zone: 13b
Heating Degree Days (base 65 degrees F): 6176
Cooling Degree Days (base 65 degrees F): 741
Project Description (check one):
[ ] New Construction [ ] Addition [ ] Alteration [ ] Unconditioned Shell (File Affidavit)

Section 3: Mechanical Systems List

Table with columns: Quantity, System Type & Description. Lists EWH-1, RTU-1, RTU-1.4, RTU-2, and WH-1.

Section 4: Requirements Checklist

Table with columns: Bldg. Dept. Use, Requirements Specific To: EWH-1, RTU-3, RTU-1.4, RTU-2, WH-1, and Generic Requirements. Lists various efficiency and control requirements.

Section 5: Compliance Statement

The proposed mechanical design represented in this document is consistent with the building plans, specifications and other calculations submitted with this permit application. The proposed mechanical systems have been designed to meet the 2000 IECC requirements in COMcheck-EZ Version 2.4 Release 2.

Steve Bastian Principal Mechanical Designer-Name
Steve T. Bastian Signature
3-15-04 Date

Mechanical Requirements Description

2000 IECC
COMcheck-EZ Software Version 2.4 Release 2
Data filename: S:\Projects\03MDG002\DesertSageHealth\Documents\Calculations\01-15-04-COM.cck

The following list provides more detailed description of the requirements in Section 4 of the Mechanical Compliance Certificate.

- Requirements Specific To: EWH-1
Requirements Specific To: RTU-3
1. The specified heating equipment is covered by Federal minimum efficiency requirements. New equipment of this type can be assumed to meet or exceed ASHRAE 90.1 Code requirements for equipment efficiency.
2. The specified cooling equipment is covered by Federal minimum efficiency requirements. New equipment of this type can be assumed to meet or exceed ASHRAE 90.1 Code requirements for equipment efficiency.
3. An integrated air economizer is required for individual cooling systems over 90 kBtu/h or 3,000 cfm in the selected climate. An integrated economizer allows simultaneous operation of outdoor-air and mechanical cooling.
Requirements Specific To: RTU-1,4
1. The specified heating equipment is covered by Federal minimum efficiency requirements. New equipment of this type can be assumed to meet or exceed ASHRAE 90.1 Code requirements for equipment efficiency.
2. The specified cooling equipment is covered by Federal minimum efficiency requirements. New equipment of this type can be assumed to meet or exceed ASHRAE 90.1 Code requirements for equipment efficiency.
Requirements Specific To: RTU-2
1. The specified heating equipment is covered by Federal minimum efficiency requirements. New equipment of this type can be assumed to meet or exceed ASHRAE 90.1 Code requirements for equipment efficiency.
2. The specified cooling equipment is covered by Federal minimum efficiency requirements. New equipment of this type can be assumed to meet or exceed ASHRAE 90.1 Code requirements for equipment efficiency.
Requirements Specific To: WH-1
1. Piping for the specified circulating service hot water system must be insulated with a minimum of 1-in. insulation having a conductivity no >0.28 Btu-in/(ft^2-F).
2. Circulating service hot water systems must have a time switch control that can automatically turn off the system during unoccupied hours.
Generic Requirements: Must be met by all systems to which the requirement is applicable
1. Design heating and cooling loads for the building must be determined using procedures equivalent to those in Chapters 27 and 28 of the ASHRAE Handbook of Fundamentals or an approved equivalent calculation procedure.
2. All equipment and systems must be sized to be no greater than needed to meet calculated loads. A single piece of equipment providing both heating and cooling must satisfy this provision for one function with the capacity for the other function as small as possible, within available equipment options.
- Exception: The equipment and/or system capacity may be greater than calculated loads for standby purposes. Standby equipment must be automatically controlled to be off when the primary equipment and/or system is operating.
- Exception: Multiple units of the same equipment type whose combined capacities exceed the calculated load are allowed if they are provided with controls to sequence operation of the units as the load increases or decreases.
3. Each heating or cooling system serving a single zone must have its own temperature control device.
4. Each humidification system must have its own humidity control device.
5. Thermostats controlling both heating and cooling must be capable of maintaining a 5 degree F deadband (a range of temperature where no heating or cooling is provided).
- Exception: Deadband capability is not required if the thermostat does not have automatic changeover capability between heating and cooling.
6. The system or zone control must be a programmable thermostat or other automatic control meeting the following criteria: a) capable of setting back temperature to 55 degree F during heating and setting up to 85 degree F during cooling b) capable of automatically setting back or shutting down systems during unoccupied hours using 7 different day schedules c) have an accessible 2-hour occupant override d) have a battery back-up capable of maintaining programmed settings for at least 10 hours without power.
- Exception: A setback or shutoff control is not required on thermostats that control systems serving areas that operate continuously.
- Exception: The system must supply outside ventilation air as required by Chapter 4 of the International Mechanical Code. If the ventilation system is designed to supply outdoor-air quantities exceeding minimum required levels, the system must be capable of reducing outdoor-air flow to the minimum required levels.
7. Outdoor-air supply systems with design airflow rates >3,000 cfm of outdoor air and all exhaust systems must have dampers that are automatically closed while the equipment is not operating.
8. The system must supply outside ventilation air as required by Chapter 4 of the International Mechanical Code. If the ventilation system is designed to supply outdoor-air quantities exceeding minimum required levels, the system must be capable of reducing outdoor-air flow to the minimum required levels.
9. Air ducts must be insulated to the following levels: a) Supply and return air ducts for conditioned air located in unconditioned spaces (spaces neither heated nor cooled) must be insulated with a minimum of R-5. Unconditioned spaces include attics, crawl spaces, unheated basements, and unheated garages. b) Supply and return air ducts and plenums must be insulated to a minimum of R-8 when located outside the building. c) When ducts are located within exterior components (e.g., floors or roofs), minimum R-8 insulation is required only between the duct and the building exterior.
- Exception: Duct insulation is not required on ducts located within equipment.
- Exception: Duct insulation is not required when the design temperature difference between the interior and exterior of the duct or plenum does not exceed 15 degree F.
10. All joints, longitudinal and transverse seams, and connections in ductwork must be securely sealed using weldments, mechanical fasteners with seals, gaskets, or mastics, mesh and mastic sealing systems, or tapes. Tapes and mastics must be listed and labeled in accordance with UL 181A or UL 181B.
11. Mechanical fasteners and seals, mastics, or gaskets must be used when connecting ducts to fans and other air distribution equipment, including multiple-zone terminal units.
12. All pipes serving space-conditioning systems must be insulated as follows:
Hot water piping for heating systems:
1 in. for pipes <= 1/2-in. nominal diameter
2 in. for pipes > 1/2-in. nominal diameter.
Chilled water, refrigerant, and brine piping systems:
1 in. insulation for pipes <= 1/2-in. nominal diameter
1 1/2 in. insulation for pipes > 1/2-in. nominal diameter.
Steam piping:
1 1/2 in. insulation for pipes <= 1/2-in. nominal diameter
3 in. insulation for pipes > 1/2-in. nominal diameter.
- Exception: Pipe insulation is not required for factory-installed piping within HVAC equipment.
- Exception: Pipe insulation is not required for piping that conveys fluids having a design operating temperature range between 55 degrees F and 105 degrees F.
- Exception: Pipe insulation is not required for piping that conveys fluids that have not been heated or cooled through the use of fossil fuels or electric power.
- Exception: Pipe insulation is not required for runout piping not exceeding 4 ft in length and 1 in. in diameter between the control valve and HVAC coil.
13. Operation and maintenance documentation must be provided to the owner that includes at least the following information: a) equipment capacity (input and output) and required maintenance actions b) equipment operation and maintenance manual c) HVAC system control maintenance and calibration information, including wiring diagrams, schematics, and control sequence descriptions; desired or field-determined set points must be permanently recorded on control drawings, at control devices, or, for digital control systems, in programming comments d) complete narrative of how each system is intended to operate.
14. Each supply air outlet or diffuser and each zone terminal device (such as VAV or mixing box) must have its own balancing device. Acceptable balancing devices include adjustable dampers located within the ductwork, terminal devices, and supply air diffusers.
15. Service water heating equipment must meet minimum Federal efficiency requirements included in the National Appliance Energy Conservation Act and the Energy Policy Act of 1992, which meet or exceed ASHRAE 90.1 Code. New service water heating equipment can be assumed to meet these requirements.
16. Water-heating equipment must be provided with controls that allow the user to set the water temperature to 110 °F for dwelling units and 90 °F for other occupancies. Controls must limit output temperatures of lavatories in public facility restrooms to 110 °F.

2000 IECC MECH. NOTES:

- 1) DUCTWORK TO BE SEALED WITH UNITED DUCT SEALER OR EQUAL. DUCT TAPE IS NOT ACCEPTABLE.
2) EXTERIOR DUCTS TO BE INSULATED WITH R-8 MINIMUM INSULATION.
3) DUCTS IN UN TEMPERED SPACES WITH A TEMPERATURE DIFFERENCE GREATER THAN 40° F SHALL BE INSULATED WITH R-5 MINIMUM INSULATION.
4) INTERIOR DUCTS IN TEMPERED SPACES WITH A TEMPERATURE DIFFERENCE GREATER THAN 15° F BUT LESS THAN 40° F SHALL BE INSULATED WITH R-3.3 MINIMUM INSULATION.
5) DUCTS IN TEMPERED SPACES THAT SERVE THAT AREA OR DUCTS WITH A TEMPERATURE DIFFERENCE LESS THAN 15° F DO NOT REQUIRE INSULATION.
6) ALL THERMOSTATS TO BE ELECTRONIC SEVEN-DAY FULLY PROGRAMMABLE WITH ONE HOUR OVERRIDE SWITCH/BUTTON, AND SEVEN-DAY FULLY PROGRAMMABLE FAN SUB-BASE.

2000 IECC PLUMB. NOTES:

- 1) DOMESTIC WATER TO BE INSULATED AS NOTED:
DOMESTIC HOT AND COLD WATER- 1-1/2" AND SMALLER-1/2" THICK
2" THRU 4"-1" THICK

2000 IECC MECH. PIPING NOTES:

1) MINIMUM PIPE INSULATION

Table with columns: FLUID, NOMINAL PIPE DIA. < 1.5", > 1.5". Rows include STEAM, HOT WATER, CHILLED WATER, BRINE OR REFRIGERANT.

BASED ON INSULATION HAVING A CONDUCTIVITY NOT EXCEEDING 0.27 BTU PER INCH/H \* FT^2 \* °F.

ELKHORN ENGINEERS, P.A.
2950 E. Magic View Dr., Ste. 190
Meridian, Idaho 83642
phone: (208) 955-0555
fax: (208) 953-0999

REGISTERED PROFESSIONAL ENGINEER
STEVEN T. BASTIAN
5112
STATE OF IDAHO
3-15-04

Medical Design Group
Architecture for Health Care
2716 WESTLAND PLACE
BOISE, IDAHO 83704-5863
BOISEARCHITECT@AOL.COM
Fax (208) 378-1405
Phone (208) 378-0817
COPYRIGHT: MEDICAL DESIGN GROUP
MECHANICAL ENERGY ANALYSIS
Desert Sage Health Care SHEET
2280 American Legion Blvd. EN1.0
Mountain Home, Idaho
March 2004

S:\Projects\03MDG002\DesertSageHealth\Drawings\03MDG002EN10.dwg, 3/15/2004 11:56:48 AM, thompson, ANSI B (11.00 x 17.00 inches), 1:1

# HVAC DRAWINGS GENERAL NOTES:

HVAC LEGEND					
SYMBOL	DESCRIPTION	SYMBOL	DESCRIPTION	SYMBOL	DESCRIPTION
[Symbol]	DUCT CAP	[Symbol]	VOLUME DAMPER	[Symbol]	GRILLES, REGISTERS, DIFFUSERS - CALLOUT
[Symbol]	DUCT SIZES - FIRST DIMENSION LISTED IS VIEW DIMENSION	[Symbol]	AUTOMATIC MOTOR OPERATED DAMPER PARALLEL AND OPPOSED BLADE	[Symbol]	SECTION/DETAIL HEADING
[Symbol]	INTERIALLY LINED DUCT - SEE NOTES OR SPECIFICATION FOR TYPE OF LINING TO BE USED. DIMENSIONS DENOTE INTERNAL FREE AREA.	[Symbol]	BACKDRAFT DAMPER	[Symbol]	SECTION CUT
[Symbol]	DIRECTION OF AIRFLOW	[Symbol]	CONTROL AIR OR ZONE DAMPER	[Symbol]	
[Symbol]	DUCTWORK OR EQUIPMENT TO BE DEMOLISHED	[Symbol]	DUCT MOUNTED SMOKE DETECTOR	[Symbol]	
[Symbol]	ECCENTRIC TRANSITION - (FOT = FLAT ON TOP, FOB = FLAT ON BOTTOM)	[Symbol]	ACCESS DOOR (AD) ACCESS PANEL (AP)	[Symbol]	HUMIDISTAT, THERMOSTAT - CALLOUT DEVICES PER ARCHITECTURAL GUIDELINES.
[Symbol]	CONCENTRIC TRANSITION	[Symbol]	F = FIRE DAMPER S = SMOKE DAMPER F AND S = FIRE AND SMOKE DAMPER SEE NOTES AND/OR SPECIFICATION FOR EXACT RATING AND MODEL NUMBERS	[Symbol]	POWER OR GRAVITY ROOF INTAKE/EXHAUST
[Symbol]	RISE OR DROP ARROW IN THE DIRECTION OF AIRFLOW	[Symbol]	TURNING VANES IN DUCTWORK	[Symbol]	EQUIPMENT TAG SYMBOL: SEE EQUIPMENT SCHEDULES FOR THE CAPACITY, TYPE, AND QUANTITY.
[Symbol]	SUPPLY DUCT (RISE)	[Symbol]	TURN DOWN/UP FOR VARIOUS STYLES OF DUCTWORK	[Symbol]	CEILING SUPPLY DIFFUSERS, SOLID FILL REPRESENTS BLANKED OFF AREAS.
[Symbol]	RETURN DUCT (RISE)	[Symbol]		[Symbol]	CEILING RETURN GRILLE
[Symbol]	EXHAUST DUCT (RISE)	[Symbol]		[Symbol]	CEILING EXHAUST GRILLE
[Symbol]	FLEX DUCT	[Symbol]		[Symbol]	SIDEWALL SUPPLY/RETURN REGISTER, DIFFUSER, GRILLE.
[Symbol]	SPIN-IN FITTING SUPPLY	[Symbol]		[Symbol]	LINEAR SUPPLY / RETURN
[Symbol]	SPIN-IN FITTING RETURN	[Symbol]		[Symbol]	PRESSURE SENSOR
[Symbol]		[Symbol]		[Symbol]	INDICATOR LIGHT

NOTE: ALL SYMBOLS LISTED ABOVE MAY NOT APPEAR ON THESE DOCUMENTS.

- THESE GENERAL NOTES APPLY TO ALL HVAC DRAWINGS IN THIS SET AND SHOULD BE TREATED AS IF THEY ARE REFERENCED TO THE ENTIRE SET.
- THE CONTRACTOR IS TO PROVIDE A FULLY OPERATIONAL HVAC HEATING AND COOLING SYSTEM. THE CONTRACTOR IS TO INSTALL ALL OF THE PIPING, DUCTWORK, ACCESSORIES, AND EQUIPMENT PER THE 2000 IPC, IMC, IBC, NFPA 99 (FOR MED. GAS), AND THE AHJ (AUTHORITY HAVING JURISDICTION). NOTHING IN THESE PLANS IS TO BE INTERPRETED AS TO ALLOW THE CONTRACTOR TO PROVIDE INSTALLATIONS THAT ARE NOT PER CODE OR THE AHJ.
- NO ACTUAL WOOD TRUSS SHAPES ARE KNOWN AT THIS TIME. THE TRUSSES ARE TO BE BID AND DESIGNED WITH THE PROJECT. THE CONTRACTOR IS WARNED THAT THE LAYOUTS HERE ARE INTENDED TO BE DIAGRAMMATIC ONLY. THE CONTRACTOR WILL PROVIDE ALL FITTINGS AND EXTRA DUCTING REQUIRED TO COORDINATE WITH ALL OTHER TRADES AND THE STRUCTURE.
- ALL DESIGN PRODUCT DATA IS FOR THE ITEM LISTED ONLY. SUBMITTAL DEVIATIONS WILL BE THE SOLE RESPONSIBILITY OF THE CONTRACTOR. REVIEW BY THE ARCHITECT OR ENGINEER DOES NOT RELIEVE THE CONTRACTOR FROM HIS RESPONSIBILITIES FOR THE PRODUCT TO PERFORM OR PHYSICALLY FIT FOR THE APPLICATION AS INDICATED IN THESE DRAWINGS. ALL COORDINATION FOR THE NEW PRODUCT WITH THE OTHER TRADES IS THE SOLE RESPONSIBILITY OF THE CONTRACTOR. THIS INCLUDES, BUT IS NOT LIMITED TO, PHYSICAL DIMENSIONS, WEIGHTS, ELECTRICAL CHARACTERISTICS, ETC. NO ADDITIONAL COSTS TO THE OWNER WILL BE ALLOWED DUE TO SUBSTITUTIONS.
- LAYOUTS, ROUTING AND COORDINATION MUST BE DONE PRIOR TO FABRICATION OR INSTALLATION OF ANY DUCTWORK. THE CONTRACTOR SHALL BE ADVISED THAT THE OWNER WILL NOT PAY TO REMOVE DUCTWORK THAT WAS INSTALLED AND FOUND TO BE IN CONFLICT WITH THE STRUCTURE OR ANOTHER TRADE.
- CONTRACTOR TO VERIFY ALL GRILLES, REGISTERS AND DIFFUSER FRAMES PRIOR TO ORDERING. CONTRACTOR SHALL VERIFY DIFFUSER LOCATIONS PRIOR TO INSTALLATION OF THE DIFFUSERS. ALL LIGHTING AND STRUCTURE NEEDS TO BE TAKEN INTO ACCOUNT FOR EXACT DIFFUSER LOCATION SEE ARCHITECTS REFLECTED CEILING PLAN. COORDINATE WITH ELECTRICAL AND STRUCTURAL FOR FINAL DIFFUSER LOCATION.
- PROVIDE ACCESS DOORS FOR ALL EQUIPMENT LOCATED IN CEILINGS, WALLS, OR FLOORS, IF HIDDEN OR INACCESSIBLE. ALL FIRE DAMPERS SHALL BE SUPPLIED WITH ACCESS DOORS IN THE DUCT IN ORDER TO RESET DAMPER. ACCESS DOORS TO BE LOCATED IN MOST THE MOST ACCESSIBLE LOCATION, AND PRIOR APPROVED BY THE ARCHITECT BEFORE INSTALLATION. ACCESS DOORS TO BE LARGEST SIZE POSSIBLE FOR THE GIVEN DUCT SIZE. MAXIMUM ACCESS DOOR SIZE TO BE 12"x12".
- CONTRACTOR MAY SUBSTITUTE EQUIVALENT ROUND OR RECTANGULAR SIZES FOR ALL LOW PRESSURE DUCTWORK. CONSULT S.M.A.C.N.A. CHARTS FOR EQUIVALENT SIZING CRITERIA.
- INSTALL ALL COMPONENTS TO MEET MANUFACTURERS INSTALLATION MANUALS, LOCAL STATE AND AHJ CODES, OR-AS DEPICTED IN THESE DOCUMENTS. WHICH EVER IS MOST STRINGENT.
- CONTRACTOR SHALL SUPPLY DRAWING FOR APPROVAL TO OWNER/ARCHITECT SHOWING ALL PROPOSED THERMOSTAT LOCATIONS. ARCHITECT/OWNER SIGNATURE MUST BE OBTAINED PRIOR TO ANY THERMOSTAT WIRING, CONDUIT, OR INSTALLATION OF THERMOSTATS. FAILURE TO DO SO MAY RESULT IN MOVING THERMOSTATS AT CONTRACTORS LOSS.
- PRINTS MUST BE REVIEWED FOR ACCURACY BEFORE STARTING THE JOB. ABSOLUTE ACCURACY OF THE DRAWINGS AND SPECIFICATIONS CANNOT BE GUARANTEED. WHILE EVERY EFFORT HAS BEEN MADE TO COORDINATE THE LOCATIONS OF EQUIPMENT & DUCTWORK, IT IS THE RESPONSIBILITY OF THE CONTRACTOR TO COORDINATE EXACT REQUIREMENTS GOVERNED BY ACTUAL JOB CONDITIONS. CHECK ALL INFORMATION AND REPORT ANY DISCREPANCIES BEFORE SUBMITTING BID OR FABRICATING AND INSTALLING WORK.
- INSTALL ALL SHEET METAL IN ACCORDANCE WITH LATEST ASHRAE AND SMACNA RECOMMENDATIONS. PROVIDE VARIATIONS IN DUCT SIZE AND ADDITIONAL DUCT FITTINGS AS REQUIRED TO CLEAR OBSTRUCTIONS AND MAINTAIN CLEARANCES.

HVAC ABBREVIATIONS											
(E) EXISTING	BRD BOARD	EXP EXPANSION	KWH KILOWATT HOUR	P PRESSURE	TA TRANSFER AIR						
(F) FUTURE	BRG BEARING	EXT EXTERIOR	KWH KILOWATT HOUR	RD PRESSURE DROP OR DIFFERENCE	TD TEMPERATURE DIFFERENCE						
(N) NEW	BTU BRITISH THERMAL UNIT	FA FIRE ALARM	L LINED	PH PLUMBING	TEMPERATURE/TEMPERED/TEMPORARY						
(D) DEPTH	CA COMBUSTION AIR	FAU FURNACE AIR UNIT	LAT LEAVING AIR TEMPERATURE	PCC POINT OF CONNECTION	TOD TOP OF DUCT						
(L) LENGTH	CD CAPACITY	FC FORWARD CURVED FLOOR CLEANOUT	LAV LAUNDRY	PSF POUNDS PER SQUARE FOOT	TOS TOP OF STEEL						
(W) WIDTH	CB CATCH BASIN	FD FLOOR DRAIN	LBS POUNDS	PSI POUNDS PER SQUARE INCH	TSP TOTAL STATIC PRESSURE						
@ AT	CD CONDENSATE DRAIN	FH FIRE HYDRANT	LF LINEAL FEET/FOOT	PVC POLYVINYL CHLORIDE	TV TURNING VANE(S)						
∠ ANGLE	CF CUBIC FEET	FIM FINISH	LPG LIQUIDIFIED PETROLEUM GAS	RA RETURN AIR	TYP TYPICAL						
∅ DIAMETER/PHASE	CFM CONTRACTOR FURNISHED	FIM FINISH	LRA LOCKED ROTOR AIR	RD ROOF DRAIN	USC UNIFORM BUILDING CODE						
< DEGREE	CFM CONTRACTOR INSTALLED	FINS/FIN PER INCH	L/S LITERS PER SECOND	RD ROOF DRAIN LEADER	UPC UNIFORM FIRE CODE						
ABV ABOVE	CFM CUBIC FEET PER MINUTE	FLA FULL LOAD AMPS	LWT LEAVING WATER TEMPERATURE	ROL ROOF DRAIN LEADER	UL UNDERWRITERS LABORATORY						
AC AIR CONDITIONING	CI CAST IRON	FLASH FLASHING	M METER	REF REFERENCE	UNC UNIFORM MECHANICAL CODE						
ACCU AIR COOLED	CL CENTER LINE	FLR FLOORING	MAT MATERIAL	REFL REFLECTED	UNFM UNFINISHED						
ACCU CONDENSING UNIT	CLG CONDENSING UNIT	FLR FLAT ON BOTTOM	MECH MECHANICAL	REL RELOCATE	UNO UNLESS NOTED OTHERWISE						
ACU ACQUISITION	CLR CLEAR	FLR FLAT ON TOP	MEZZ MEZZANINE	REM REMOVE	UPC UNIFORM PLUMBING CODE						
ACP ACQUISITION PANEL	CNT CENTER	FLR FLAT PER MINUTE	MFG MANUFACTURER	REIN REINFORCE	URNAL URINAL						
ACT ACQUISITION TILE	CO CLEAN OUT	FRP FIREPROOF	MIN MINIMUM	REQ REQUIRED	V VOLT						
AD AIR DROP	COL COLUMN	FT FEET/FOOT	MISC MISCELLANEOUS	RET RETURN	VAC VACUUM						
ADJ ADJUSTABLE	CONC CONCRETE	FUR FURRING	MM MILLIMETER	RF RECIRCULATION FAN	VAV VARIABLE AIR VOLUME						
AF AIR FOIL	COND CONDENSATE	GA GAUGE OR GAGE	MO MOTOR OPERATED	RG RETURN GRILLE	VD VOLUME DAMPER						
APC ABOVE FINISHED CEILING	CONN CONNECTION	GALV GALVANIZED	MOOP MAX OVERLOAD PROTECTION	RH RELATIVE HUMIDITY	VEL VELOCITY						
AFF ABOVE FINISH FLOOR	CONSTR CONSTRUCTION	GEN GENERAL CONTRACTOR	MTD MOUNTED	RTU ROOFTOP UNIT	VENT VENTILATION						
AFC ABOVE FINISH GRADE	CONT CONTINUOUS/CONTINUATION	GE GENERAL EXHAUST	MTG MOUNTING	S SOUTH	VERT VERTICAL						
AFS ABOVE FINISH SLAB	CONTR CONTRACTOR	GSM GALVANIZED SHEET METAL	MTL METAL	SA SUPPLY AIR	VFD VARIABLE FREQUENCY DRIVE						
AFUE AMERICAN FUEL UTILIZATION EFFICIENCY	CONTR CENTER TO CENTER	HCP HANDICAP	MTL MAKE-UP AIR UNIT	SD SUPPLY DIFFUSER	VOL VOLUME						
AHV AIR HANDLING UNIT	CV VALVE COEFFICIENT	HD HEAD	N/A NOT APPLICABLE	SEER SEASONAL ENERGY EFFICIENCY RATING	VTR VENT THRU ROOF						
ALT ALTERNATE	DB DECIBEL	HWHR HARDWARE	N/NORTH	SEN SENSIBLE	VVT VARIABLE VOLUME TERMINAL						
ALUM ALUMINUM	DBL DOUBLE	HORIZ HORIZONTAL	N/A NOT APPLICABLE	SENS SENSIBLE	W WEST						
AMB AMBIENT	DBL DRY BULB TEMPERATURE	HP HORSEPOWER	N/NORTH	SECT SECTION	W/ WITH						
AMP AMPERES	DEPT DEPARTMENT	HR HOUR	N/A NOT APPLICABLE	SEN SENSIBLE	W/O WITHOUT						
ANOD ANODIZED	DET DETAIL	HT HEIGHT	N/C NORMALLY CLOSED	SEN SENSIBLE	WB WET BULB TEMPERATURE						
ANSI AMERICAN NATIONAL STANDARDS INSTITUTE	DIM DIMENSION	HTD HEATING	NEC NATIONAL ELECTRIC CODE	SP SQUARE FOOT	WC WATER CLOSET						
AP AIR PRESSURE	DISH DISCHARGE	H2O WATER	NFPA NATIONAL FIRE PROTECTION ASSOCIATION	SH SENSIBLE HEAT	WP WATERPROOF						
APD AIR PRESSURE DROP	DS DOWNSPOUT	HVAC HEATING, VENTILATING, AND AIR CONDITIONING	N/C NOT IN CONTRACT	SH SHOWER	WPD WATER PRESSURE DROP						
APPROX APPROXIMATE	DSP DRY STANDPIPE	IBC INTERNATIONAL BUILDING CODE	NO NORMALLY OPEN	SH SHOWER	WT WEIGHT						
ARCH ARCHITECTURAL	DWG DRAWING	IDW INSIDE DIAMETER	NOM NOMINAL	SH SHOWER	ZO ZONE DAMPER						
ASHRAE AMERICAN SOCIETY OF HEATING, REFRIGERATION, AND AIR CONDITIONING ENGINEERS	E EAST	IDW INSIDE DIAMETER	NTS NOT TO SCALE	SH SHOWER							
	EAT ENTERING AIR TEMPERATURE	INT INTERIOR	NUM NUMBER	SH SHOWER							
	EFF EFFICIENCY	INT INVERT ELEVATION		SH SHOWER							
	EFF EFFICIENCY	INLET INLET GUIDE VANE(S)		SH SHOWER							
	EFG EXHAUST GRILLE	INT INTERNATIONAL MECHANICAL CODE		SH SHOWER							
	ELECT ELECTRIC	INCH INCH		SH SHOWER							
	ELEV ELEVATION	INS INSULATION		SH SHOWER							
	EMERG EMERGENCY	INT INTERIOR		SH SHOWER							
	ENCL ENCLOSED/ENCLOSURE	INT INTERNATIONAL PLUMBING CODE		SH SHOWER							
	ENT ENTERING	J-BOX JUNCTION BOX		SH SHOWER							
	EQ EQUAL	JUST JUST		SH SHOWER							
	EQU EQUIPMENT			SH SHOWER							
	ESP EXTERNAL STATIC PRESSURE			SH SHOWER							
	EXT EXTERIOR WATER TEMPERATURE			SH SHOWER							
	EXH EXHAUST			SH SHOWER							
	EXIST EXISTING			SH SHOWER							

NOTE: ALL ABBREVIATIONS LISTED ABOVE MAY NOT APPEAR ON THESE DOCUMENTS.



**Medical Design Group**  
 Architecture for Health Care  
 2716 WESTLAND PLACE  
 BOISE, IDAHO 83704-5863  
 BOISEARCHITECT@AOL.COM  
 Fax (208) 378-1405  
 Phone (208) 378-0817

HVAC LEGENDS & ABBREV.  
 Desert Sage Health Care  
 2280 American Legion Blvd.  
 Mountain Home, Idaho  
 SHEET MO.0  
 March 2004



# PART 1 - GENERAL

## 1.1 INDUSTRY STANDARD

- A. ALL EQUIPMENT AND MATERIALS FURNISHED & INSTALLED UNDER THIS SECTION SHALL BE IN ACCORDANCE WITH THE FOLLOWING STANDARDS:
1. SHEET METAL DUCTWORK: ALL SHEET METAL DUCTWORK SHALL BE FABRICATED IN ACCORDANCE WITH THE STANDARDS ESTABLISHED BY THE AMERICAN SOCIETY OF HEATING, REFRIGERATION, AND AIR CONDITIONING ENGINEERS (ASHRAE) AND THE SHEET METAL AND AIR CONDITIONING NATIONAL ASSOCIATION (SMACNA) AND MEET THE MINIMUM REQUIREMENTS OF NFPA 90 AND NFPA 91.
  2. FIRE DAMPERS AND EXPLOSION PROOF EQUIPMENT: ALL FIRE DAMPERS AND EXPLOSION PROOF EQUIPMENT SHALL HAVE AN UNDERWRITERS' LABORATORIES, INC. (UL) APPROVED LABEL.
  3. FILTER MEDIA: FILTER MEDIA SHALL AS A MINIMUM REQUIREMENT BE RATED CLASS 2 BY UNDERWRITERS' LABORATORIES, INC.
  4. DUCT INSULATION: DUCT INSULATION SHALL COMPLY WITH REQUIREMENTS OF NFPA-90A.
  5. FLEXIBLE DUCTWORK: FLEXIBLE DUCTWORK SHALL COMPLY WITH REQUIREMENTS OF NFPA-90A.

## 1.2 SCOPE OF WORK

- A. FURNISH AND INSTALL ALL AIR DISTRIBUTION EQUIPMENT AND ASSOCIATED ACCESSORIES AS INDICATED ON THE DRAWINGS AND SPECIFIED HEREIN. ALSO PROVIDE ANY INCIDENTAL WORK NOT SHOWN OR SPECIFIED THAT IS NECESSARY TO PROVIDE A COMPLETE SYSTEM.
- B. PLACE ALL SLEEVES, HANGERS, SUPPORTS AND OPENINGS FOR WORK UNDER THIS SECTION. FLASH ALL WALL PENETRATIONS FOR WORK PERFORMED IN THIS SECTION. COORDINATE ALL ROOF PENETRATIONS WITH ROOFING CONTRACTOR.
- C. PROVIDE CARPENTRY, MASONRY, CONCRETE AND METAL WORK REQUIRED FOR WORK OF THIS SECTION, EXCEPT WHERE SPECIFICALLY CALLED FOR UNDER OTHER DIVISIONS.
- D. COORDINATE WITH WORK PERFORMED UNDER OTHER DIVISIONS. COORDINATE WORK DONE TO ACCOMMODATE REQUIREMENTS OF THIS DIVISION TO ENSURE ADEQUACY OF SPACE AND PROPER LOCATION.
- E. PROVIDE CUTTING AND PATCHING AS REQUIRED FOR EXECUTION OF WORK PERFORMED UNDER THIS SECTION. NORMAL FRAMING AND BLOCKING SHALL BE COORDINATED WITH THE GENERAL CONTRACTOR FOR WORK TO BE COMPLETED UNDER THIS DIVISION.
- F. DAMAGE THAT OCCURS DUE TO WORK OF THIS DIVISION CAUSED BY LEAKS, BREAKS, DISCHARGE OF NORMAL WORK OF CONTRACT, INADVERTENT ACTS, ETC., ARE THE RESPONSIBILITY OF THIS CONTRACTOR. DAMAGED MATERIAL OR EQUIPMENT SHALL BE REPAIRED OR REPLACED WITH LIKE MATERIAL TO THE SATISFACTION OF THE OWNER AND/OR OWNER'S REPRESENTATIVE. REPAIRS OR REPLACEMENT WORK SHALL BE DONE BY CRAFTSMEN SKILLED IN THE TRADE OF THE WORK INVOLVED AND SHALL BE APPROVED BY THE OWNER AND/OR OWNER'S REPRESENTATIVE.

## 1.3 PROTECTION, STORAGE, AND DELIVERY

- A. PROVIDE NECESSARY STORAGE AREAS AT THE SITE FOR SAFE STORAGE OF MATERIALS. PROVIDE SHOP AREA ELSEWHERE ON SITE THAT DOES NOT INTERFERE WITH WORK, FOR SAFE OPERATION OF TOOLS. REMOVE THESE FACILITIES AND RESTORE AREA(S) TO ORIGINAL CONDITION AT COMPLETION OF PROJECT.
- B. PROTECT EQUIPMENT AND MATERIALS FROM PHYSICAL DAMAGE, CONSTRUCTION DIRT AND THE ELEMENTS FROM THE TIME THEY ARE SHIPPED BY THE MANUFACTURER TO THE TIME THE BUILDING IS ACCEPTED BY THE OWNER.
- C. ARRANGE DELIVERY OF PRODUCTS IN TIMELY FASHION TO COORDINATE WITH WORK PROGRESS.
- D. DELIVER PRODUCTS IN THE MANUFACTURER'S ORIGINAL PACKAGING WITH IDENTIFYING LABELS INTACT AND LEGIBLE. LEGIBLY IDENTIFY UNITS OR ITEMS AS TO INSTALLATION LOCATION AND/OR DRAWING DESIGNATIONS TO PERMIT CHECK BY OWNER'S REPRESENTATIVE AGAINST APPROVED MATERIAL LIST AND SHOP DRAWINGS.

- E. IMMEDIATELY UPON DELIVERY INSPECT SHIPMENT(S), INCLUDING OWNER FURNISHED ITEMS, TO ASSURE THAT PRODUCTS ARE UNDAMAGED AND IN ACCORDANCE WITH SPECIFICATION REQUIREMENTS. SHOULD THE PRODUCT BE DAMAGED OR NOT IN COMPLIANCE WITH REQUIREMENTS, IMMEDIATELY REPAIR AS DIRECTED OR APPROVED OR ORDER REPLACEMENT AT NO INCREASE IN CONTRACT SUM.
- F. REPLACE LOST OR DAMAGED MATERIALS AND EQUIPMENT AT NO INCREASE IN CONTRACT SUM.
- G. PROTECT NEW AND EXISTING BUILDING STRUCTURES AND ADJACENT FINISHED SURFACES DURING CONSTRUCTION. PATCH, REPAIR AND REFINISH EXISTING FINISHED SURFACES DAMAGED BY WORK UNDER THIS DIVISION TO MATCH ADJACENT UNDISTURBED AREAS. PATCHING, REPAIR AND REFINISHING SHALL BE PERFORMED BY CRAFTSMEN SKILLED IN THE SECTIONS INVOLVED.

## 1.4 FEES

- A. SECURE AND PAY FEES FOR PERMITS, LICENSES, INSPECTIONS AND ROYALTIES REQUIRED FOR WORK OF THIS DIVISION.

## 1.5 REGULATIONS AND STANDARDS

- A. WORK AND MATERIALS SHALL BE IN FULL ACCORDANCE WITH THE RULES AND REGULATIONS OF THE LATEST ADOPTED EDITION AND ALL AMENDMENTS OF THE FOLLOWING:
1. 2000 INTERNATIONAL BUILDING CODE (IBC)
  2. 2000 INTERNATIONAL MECHANICAL CODE (IMC)
  3. 2000 INTERNATIONAL PLUMBING CODE (UPC)
  4. 2000 INTERNATIONAL FIRE CODE (IFC)
  5. ANY OTHER APPLICABLE FEDERAL, STATE, AND LOCAL LAWS, AND REGULATIONS.
  6. SMACNA - SHEET METAL AND AIR CONDITIONING NATIONAL ASSOCIATION
  7. AMERICAN SOCIETY OF HEATING, REFRIGERATION, & AIR CONDITIONING ENGINEERS (ASHRAE)
  8. NATIONAL FIRE PROTECTION ASSOCIATION (NFPA)
  9. ASSOCIATED AIR BALANCE COUNCIL (AABC)
- B. DO NOT CONSTRUCE ANYTHING IN THESE DRAWINGS AND SPECIFICATIONS TO PERMIT WORK NOT CONFORMING TO THESE REQUIREMENTS. THE REGULATIONS SHALL GOVERN WHERE THEY REQUIRE HIGHER STANDARDS OR ARE IN CONFLICT WITH THE DRAWINGS AND SPECIFICATIONS. CONSIDER RULINGS AND INTERPRETATIONS OF THE ENFORCING AGENCIES AS PART OF THESE SPECIFICATIONS. COMPLY WITH THE DRAWINGS AND SPECIFICATIONS SHOWING WORK EXCEEDING MINIMUM CODE REQUIREMENTS.
- C. PROVIDE ALL WORK REQUIRED BY THE GOVERNING AUTHORITY, EVEN IF IT IS NOT INDICATED ON DRAWINGS OR IN THE SPECIFICATIONS. IF REQUIRED WORK IS NOT SHOWN, SUBMIT A CONSTRUCTION PRICE FOR PROVIDING THIS WORK FOR APPROVAL PRIOR TO PERFORMING ANY WORK.

## 1.6 DRAWINGS AND SPECIFICATIONS

- A. CONSIDER ALL DRAWINGS AND ALL DIVISIONS OF THESE SPECIFICATIONS AS A WHOLE AND PROVIDE WORK OF THIS SECTION AS SHOWN ANYWHERE THEREIN. PRINTS MUST BE REVIEWED FOR ACCURACY BEFORE STARTING THE JOB. ABSOLUTE ACCURACY OF THE DRAWINGS AND SPECIFICATIONS CANNOT BE GUARANTEED. WHILE EVERY EFFORT HAS BEEN MADE TO COORDINATE THE LOCATIONS OF EQUIPMENT COVERED UNDER OTHER SECTIONS OR DIVISIONS OF THESE SPECIFICATIONS, IT IS THE RESPONSIBILITY OF THE CONTRACTOR TO COORDINATE EXACT REQUIREMENTS GOVERNED BY ACTUAL JOB CONDITIONS. CHECK ALL INFORMATION AND REPORT ANY DISCREPANCIES BEFORE SUBMITTING BID OR FABRICATING AND INSTALLING WORK.

## 1.7 INSPECTION BY OWNER

- A. WORK MAY BE INSPECTED AT ANY TIME BY THE OWNER OR HIS REPRESENTATIVE. WORK COVERED OR CONCEALED BEFORE BEING INSPECTED AND APPROVED SHALL BE OPENED AND UNCOVERED UPON REQUEST.

## 1.8 SUBMITTAL DATA

- A. SUBMIT FOR APPROVAL ALL ATTACHMENTS TO STRUCTURE, ARCHITECTURAL ACCESS PANELS, ALL FIXTURES AND PIECES OF EQUIPMENT TO BE INSTALLED ON THE JOB. SUBMITTALS SHALL INCLUDE DUCTWORK AND ACCESSORIES, INSULATION, FANS, AND MOTORS. PROVIDE FAN CURVES, OPERATING CHARACTERISTICS, CAPACITIES, ETC., FOR ALL EQUIPMENT. PROVIDE ALL REQUIRED SUBMITTAL DATA IN ONE COMPLETE SET, BOUND AND INDEXED BY CATEGORY, USE, ETC. CLEARLY IDENTIFY IN THE SUBMITTAL ALL CAPACITIES, OPTIONS, AND CRITERIA REQUIRED TO DETERMINE THE PERFORMANCE OF THE EQUIPMENT.
- B. PREPARE THREE (3 PLUS THE NUMBER REQUIRED FOR THE GENERAL CONTRACTORS USE) COPIES FOR ALL EQUIPMENT AND MATERIALS. SUBMIT TO ARCHITECT FOR REVIEW AND DISTRIBUTION.

## 1.9 WORKMANSHIP AND MATERIALS

- A. EMPLOY ONLY EXPERIENCED, COMPETENT AND PROPERLY EQUIPPED PERSONNEL ON THE JOB. PROVIDE HIGH QUALITY WORKMANSHIP IN THE INSTALLATION OF EQUIPMENT AND MATERIALS. USE ONLY NEW MATERIALS IN PERFECT CONDITION EXCEPT THOSE SPECIFICALLY INDICATED TO BE RE-USED.

## 1.10 CLEANING


- A. FLUSH PIPES AND DUCTS FREE FROM FOREIGN SUBSTANCES BEFORE INSTALLING VALVES, STOPS, OR MAKING FINAL CONNECTIONS. CLEAN ALL PIPING AND EQUIPMENT BEFORE INSTALLATION IS ACCEPTED BY THE OWNER. FURNISH AND INSTALL VALVED CONNECTIONS TO PIPING SYSTEMS TO FACILITATE CLEANING OTHER THAN FOR EQUIPMENT CONNECTIONS. SEE SPECIFIC CLEANING SPECIFICATIONS IN EACH SECTION.

## 1.11 OPERATING AND MAINTENANCE INSTRUCTIONS

- A. PREPARE AND SUBMIT COMPLETE OPERATING MAINTENANCE MANUAL FOR EACH PIECE OF EQUIPMENT INSTALLED. PROVIDE WITH COMPLETE AND REVIEWED AND APPROVED BALANCE REPORT. PROVIDE MANUFACTURERS EQUIPMENT WARRANTIES IN THE O&M MANUAL. PROVIDE CONTRACTORS WARRANTY LETTER WITH THE NAMES AND PHONE NUMBERS IN THE O&M MANUAL.

## 1.12 SITE CLEAN-UP

- A. AFTER ALL OTHER WORK HAS BEEN ACCOMPLISHED, CLEAN ALL EXPOSED, PIPING, DUCTWORK, FIXTURES, EQUIPMENT AND SUPPORTS OF CONSTRUCTION DUST, DIRT, AND DEBRIS.
- B. LEAVE ALL AREAS INVOLVING MECHANICAL WORK IN A CLEAN CONDITION SATISFACTORY TO THE OWNER.

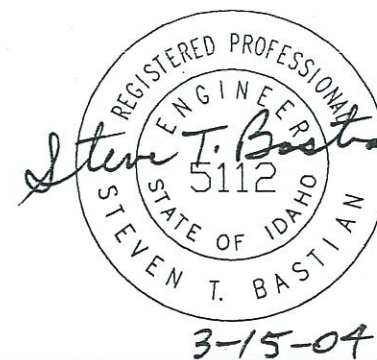

**Medical Design Group**  
Architecture for Health Care

2716 WESTLAND PLACE  
BOISE, IDAHO 83704-5863

BOISEARCHITECT@AOL.COM  
Fax (208) 378-1405  
Phone (208) 378-0817

© COPYRIGHT: MEDICAL DESIGN GROUP

**HVAC SPECIFICATIONS**

Desert Sage Health Care  
2280 American Legion Blvd.  
Mountain Home, Idaho

**SHEET**  
**MO.1**

March 2004

## PART 2 - PRODUCTS

### 2.1 SPECIFIC MANUFACTURER AND MODEL

- A. TRADE NAMES ARE USED TO ESTABLISH STANDARDS. EQUIVALENT PRODUCTS FROM OTHER MANUFACTURERS MAY BE SUBSTITUTED AFTER SUBMITTAL IS REVIEWED AND APPROVED BY THE ENGINEER.
- B. CONTRACTOR IS RESPONSIBLE FOR ANY AND ALL CHANGES DUE TO SUBSTITUTIONS OR ALTERNATES TO THE DESIGN DRAWINGS. AREAS OF COORDINATION CONCERN INCLUDE BUT NOT LIMITED TO; DIMENSIONS, STRUCTURAL IMPACTS, ELECTRICAL CHARACTERISTICS, ETC... THIS CONTRACTOR WILL BE RESPONSIBLE FOR ANY INCREASE IN PROJECT COST OR IMPACT TO SCHEDULE DUE TO THESE SUBSTITUTIONS.

### 2.2 UL LABEL

- A. FURNISH 'UL' LABELED AND LISTED MATERIALS AND EQUIPMENT EXCEPT WHEN EQUIPMENT IS OF A TYPE FOR WHICH LABELING OR LISTING SERVICES ARE NOT AVAILABLE FROM 'UL'.

### 2.3 FINISHES AND PAINTING

- A. PROVIDE ALL EQUIPMENT WITH A FACTORY FINISH. TOUCH UP ANY CHIPS OR SCRAPES THAT MAY OCCUR DURING HANDLING AND INSTALLING.
- B. UNLESS ITEMS ARE FACTORY FINISHED, PROVIDE ONE PRIME COAT ON ALL PIPE, HANGER ASSEMBLIES, SUPPORTS, EQUIPMENT AND ACCESSORIES FURNISHED UNDER THIS DIVISION.

### 2.4 SHEET METAL DUCTWORK

- A. GENERAL: CONSTRUCT AND INSTALL ALL SHEET METAL DUCTWORK IN ACCORDANCE WITH THE LATEST UMC, ASHRAE AND SMACNA RECOMMENDATIONS, USING GALVANIZED SHEET METAL HAVING A ZINC COATING OF 0.90 OZ. PER SQ. FT. EACH SIDE PER ASTM-A525, G-90, UNLESS STATED OTHERWISE. ALL DUCT SHALL BE 24 GAUGE OR GREATER (1.0 LB / SQ. FT., 0.0239" NOMINAL THICKNESS).
  1. DUCT SIZE SHOWN ON LINED DUCT IS THE INSIDE DIMENSION.
  2. THE THROAT RADIUS OF ALL BENDS SHALL BE 1-1/2 TIMES THE WIDTH OF THE DUCT WHEREVER POSSIBLE AND IN NO CASE SHALL THE THROAT RADIUS BE LESS THAN ONE WIDTH OF THE BRANCH DUCT. PROVIDE SQUARE ELBOWS WITH DOUBLE THICKNESS AIR FOIL TYPE TURNING VANES WHERE SPACE DOES NOT PERMIT THE ABOVE RADIUS, OR WHERE SQUARE ELBOWS ARE SHOWN. SPIN-IN FITTINGS SHALL HAVE DAMPERS OF 26-GAUGE THICKNESS WITH LOCKING QUADRANTS.
  3. THE SLOPES OF TRANSITIONS SHALL BE NO GREATER THAN 30 DEGREES FOR ALL DUCT SYSTEMS.
  4. PROVIDE SLIP DRIVE OR EQUIVALENT FLAT SEAMS FOR DUCTS EXPOSED IN THE CONDITIONED SPACE OR WHERE NECESSARY DUE TO SPACE LIMITATIONS. RUNOUTS TO GRILLES, REGISTERS OR DIFFUSERS ON EXPOSED DUCTWORK SHALL BE THE SAME SIZE AS THE OUTER PERIMETER OF THE CONNECTION FLANGE ON THE GRILLE, REGISTER OR DIFFUSER.
  5. ALL ROUND DUCT WORK IN EXPOSED AREAS SHALL BE SPIRAL ROUND AND PAINTED PER ARCHITECTS DIRECTION AND COLOR REQUIREMENTS. PAINT ALL EXPOSED HANGERS AND SEISMIC RESTRAINTS.
  6. INSTALL ADDITIONAL DUCT REINFORCEMENTS AND SEISMIC BRACING AS PER SMACNA.
  7. PROVIDE A 3/4" DUCT TEST OPENING WITH CORK - TO BE LOCATED WHERE AIR MEASUREMENTS ARE REQUIRED FOR BALANCING THE SYSTEM.

### 2.5 GRILLES AND DIFFUSERS

- A. FURNISH ALL DIFFUSERS, REGISTERS AND GRILLES WITH A BAKED ON, NON-GLOSSY PRIME COAT.
- B. GRILLES AND DIFFUSERS SHALL MATCH ALL QUALITIES OF THOSE SPECIFIED ON THE DRAWINGS INCLUDING APPEARANCE, THROW, NOISE LEVEL, ADJUSTABILITY, ETC. REFER TO GRILLE, REGISTER, AND DIFFUSER SCHEDULE FOR PROPER COLOR. COORDINATE AND APPROVE COLOR WITH ARCHITECT BEFORE INSTALLATION. MATCH FRAME TYPE WITH ACTUAL SURFACE. VERIFY SURFACE BEFORE PURCHASING DEVICES.

### 2.6 FLEXIBLE CONNECTIONS

- A. FLEXIBLE CONNECTIONS SHALL BE PROVIDED ON ALL ROTATING OR VIBRATING EQUIPMENT AND AT THE INLET AND OUTLET OF EACH FAN AND WHERE SHOWN ON THE DRAWINGS. PROVIDE FLEXIBLE CONNECTIONS LISTED FOR EXTERIOR LOCATIONS IF EXPOSED TO WEATHER.

### 2.7 FILTERS

- A. FILTERS AND FRAMES IN THE AIR HANDLING UNITS ARE TO BE FURNISHED WITH THE UNIT. THE CONTRACTOR SHALL BE RESPONSIBLE FOR PROVIDING THE FILTER MEDIA CARTRIDGES SPECIFIED HEREIN AND INSTALL THE FILTER MEDIA FURNISHED WITH THE EQUIPMENT. PROVIDED CHANGE OF FILTERS IF UNITS ARE RUN DURING CONSTRUCTION.
- B. ALL REFERENCES TO EFFICIENCIES AND PERFORMANCE ARE BASED ON ASHRAE STANDARD 52-76. ALL FILTERS SHALL BE UL LISTED CLASS 2. ALL METAL SURFACES SHALL HAVE CORROSION RESISTANT COATINGS.

### 2.8 DUCT SEALERS

- A. DUCTS SHALL BE SEALED WITH UNITED DUCT SEALER. DUCT TAPE WILL NOT BE ACCEPTED.

### 2.9 ACCESSORIES

- A. FIRE DAMPERS SHALL BE FURNISHED WITH FUSIBLE LINKS AND CHAINS AND SHALL MEET ALL REQUIREMENTS OF LOCAL CODES AND U.L.; THIS SHALL INCLUDE THE STEEL SLEEVE, WHERE REQUIRED, AT FIRE WALLS. PROVIDE ONE FUSIBLE LINK FOR EACH 6 SQUARE FEET OF DAMPER OR FRACTION THEREOF. DAMPERS SHALL BE RATED AND APPROVED BY UNDERWRITERS' LABORATORIES, RUSKIN IBD2 OR AIR BALANCE #119 STYLE B OR C, FOR WALL AND FLOOR INSTALLATION; RUSKIN CFD OR TERRI MODEL FD30-AS-R FOR CEILING INSTALLATION. INSTALLATION SHALL CONFORM WITH UBC SECTION 713 REQUIREMENTS.
- B. COMBINATION FIRE/SMOKE DAMPERS: "RUSKIN", FSD SERIES MINIMUM LEAKAGE CLASSIFICATION OF II, CONFORMING TO UL 555S CLASSIFICATION (OR PREFCO EQUAL). PROVIDE WITH FACTORY MOUNTED 120V ACTUATOR. INSTALLATION SHALL CONFORM TO UBC ARTICLE 713.10 REQUIREMENTS.
- C. ALL DAMPER SHAFTS SHALL BE EXTERNALLY MARKED (GROOVED PARALLEL TO DAMPER POSITION) INDICATING DAMPER BLADE POSITION.
- D. PROVIDE ACCESS DOORS (12"x12" MINIMUM; WITH VENTLOCK #202, #310 LATCHES AND #260 HINGES) FOR ALL DAMPERS OTHERWISE INACCESSIBLE, FIRE DAMPERS AND OTHER COMPONENTS OF THE SYSTEM, INSULATED TYPE IN INSULATED DUCTS.
- E. MANUAL DAMPERS SHALL BE SINGLE OR OPPOSED BLADE TYPE AS INDICATED ON THE DRAWINGS AND SHALL BE COMPLETE WITH EXTERNAL LOCKING QUADRANTS.
- F. FLEXIBLE DUCT SHALL BE "THERMA FLEX" TYPE GKM OR APPROVED EQUAL. DUCT SHALL BE FACTORY MADE USING COATED STEEL HELIX SPRING WIRE PERMANENTLY BONDED TO A COATED WOVEN FIBERGLASS COVER. MAXIMUM INSTALLED LENGTH OF FLEX DUCT SHALL BE 6 FEET. DUCTS SHALL MEET THE REQUIREMENTS OF NFPA 90A, AND UL181, CLASS 1.

### 2.10 ARCHITECTURAL ACCESS PANELS AND DOORS

- A. WHERE REQUIRED: WHEREVER A PIECE OF EQUIPMENT IS INACCESSIBLE AND REQUIRES ACCESS FOR MAINTENANCE, REPAIR OR ADJUSTMENT. INSTALL AS REQUIRED FOR ACCESS TO FIRE AND SMOKE DAMPERS.
- B. PHYSICAL PERFORMANCE: SIZE IS DEPENDENT UPON THE RELATIONSHIP OF THE DOOR TO THE PRODUCT BEING SERVICED. THEREFORE, WHERE NOT NOTED ON THE DRAWINGS, THE SIZE OF THE DOOR SHALL BE SELECTED TO PROVIDE CONVENIENT ACCESS TO ITS CONTENTS. THE FRAME SHALL BE FLUSH MOUNTED AND SHALL BE SUITABLE FOR THE BUILDING SURFACE IN WHICH IT IS BEING MOUNTED. PROVIDE FURRING AROUND THE DOOR FRAME AS DIRECTED WHERE THERE IS INSUFFICIENT DEPTH TO ALLOW A FLUSH MOUNTED FRAME AND DOOR. THE DOOR SHALL BE STEEL, OR STAINLESS STEEL AS INDICATED, AND OF SUFFICIENT GAUGE TO PREVENT PERMANENT DEFLECTION FROM NORMAL USE. PROVIDE FIRE RATED DOORS WHEN LOCATED IN FIRE RATED SURFACES.
- C. FURNISH DOORS TO SUBCONTRACTORS FOR INSTALLATION AND COORDINATE LOCATIONS. PROVIDE WITH PRIME COAT AND FIELD PAINT AS DIRECTED BY ARCHITECT.

### 2.11 DUCT INSULATION

- A. INTERIOR CONCEALED SUPPLY & RETURN DUCT SHALL BE INSULATED WITH 1.5 INCHES OF 1.0 LB/CUBIC FOOT DENSITY DUCT WRAP WITH FOIL BACKED SCRIM FACE. SEAL JOINTS VAPOR TIGHT. INSTALL PER MANUFACTURER'S INSTRUCTIONS.
- B. INTERIOR EXPOSED SUPPLY DUCTS SHALL BE INSULATED WITH 1.0 INCHES OF 1.5 LB/CUBIC FOOT DENSITY DUCT LINER. LINER SHALL HAVE EROSION RESISTANT AIR SIDE FACE. LINE DUCTS WHERE SHOWN ON PLAN.
- C. EXTERIOR EXPOSED SUPPLY & RETURN DUCTS SHALL BE DOUBLE-WALLED, INSULATED DUCTS. BOTH INNER AND OUTER SKINS WILL BE GALVANIZED 26 GA. (MINIMUM) INSULATION SHALL BE 1.5 INCHES OF 1.5 LB/CUBIC FOOT OF DUCT LINER. INSTALL PER MANUFACTURER'S INSTRUCTIONS AND SMACNA STANDARDS.

## PART 3 - EXECUTION

### 3.1 COORDINATION

- A. CUTTING AND REPAIRING: INCLUDE IN THE WORK ALL CUTTING AND REPAIRING NECESSARY AND REQUIRED FOR THE INSTALLATION. REPAIRING SHALL BE PERFORMED BY CRAFTSMEN SKILLED IN THE TRADE INVOLVED, IN A MANNER SATISFACTORY TO THE OWNER.
- B. CONGESTED AREAS:
  1. ALL CONDITIONS INVOLVING WORK UNDER THIS DIVISION AND OTHER SECTIONS SHALL BE COORDINATED IN ADVANCE OF INSTALLATION.
  2. DIFFERENCES OR DISPUTES CONCERNING COORDINATION, INTERFERENCE OR EXTENT OF WORK BETWEEN SECTIONS SHALL BE DECIDED BY OWNER/GENERAL CONTRACTOR/CONSTRUCTION MANAGER.



		<b>Medical Design Group</b> Architecture for Health Care 2716 WESTLAND PLACE BOISE, IDAHO 83704-5863 BOISEARCHITECT@AOL.COM Fax (208) 378-1405 Phone (208) 378-0817	
		© COPYRIGHT: MEDICAL DESIGN GROUP	
HVAC SPECIFICATIONS		SHEET <b>M0.2</b>	
Desert Sage Health Care 2280 American Legion Blvd. Mountain Home, Idaho		March 2004	

- C. COORDINATION WITH OTHER DIVISIONS: COORDINATE ELECTRICAL INTERLOCKS OF MECHANICAL EQUIPMENT WITH THE ELECTRICAL DIVISION.
- D. PROVIDE, CAUSING NO DELAY, ALL REQUIRED SLEEVES, CHASES, CONCRETE INSERTS, ANCHOR BOLTS, ETC., BEFORE CONCRETE IS POURED. BE RESPONSIBLE FOR CORRECT LOCATION AND INSTALLATION OF SAME.
- E. INFORMATION TO OTHER DIVISIONS: PROVIDE TEMPLATES, INFORMATION AND INSTRUCTIONS TO OTHER DIVISIONS TO PROPERLY LOCATED HOLES AND OPENINGS TO BE CUT OR PROVIDED FOR MECHANICAL WORK.

**3.2 SEISMIC RESTRAINT**

- A. PROVIDE SEISMIC RESTRAINTS PER SMACNA AND IBC, OR PER LOCAL AUTHORITY HAVING JURISDICTION, WHICHEVER IS MORE STRINGENT.

**3.3 DUCTWORK**

**A. GENERAL**

1. ALL DUCTWORK SHALL BE DELIVERED AND STORED IN SUCH A MANNER AS TO KEEP THE INTERIOR OF THE DUCT CLEAN. DUCTWORK SHALL NOT BE INSTALLED WHEN DUST OR DIRT IS BEING BLOWN THROUGH THE AREA DURING INSTALLATION. HUNG SECTIONS OF DUCT SHALL BE SEALED AT THE END OF EACH WORK DAY SO THAT NO INTRUSION OF DUST AND DIRT OCCURS.
2. ALL DUCTWORK SHALL BE STORED ON SITE WITH ALL OPENINGS COVERED AND TAPED TO PREVENT THE INTRUSION OF DUST AND DIRT.
3. ANY DUCTWORK UNCOVERED DURING A WORKING DAY SHALL BE RE-COVERED BEFORE THE END OF THAT WORKING DAY.
4. THE SIMPLE COVERING OF QUANTITIES OF DUCTWORK WITH PLASTIC SHEETS SHALL NOT BE AN ACCEPTABLE MEANS OF PROTECTION. THE OPENINGS IN EACH PIECE SHALL BE COVERED AND TAPED.
5. ALL DUCTWORK SHALL BE INSTALLED AS DIMENSIONED ON THE DRAWINGS WITH FIELD ROUTING VERIFICATIONS, AND IN ACCORDANCE WITH THE SPECIFICATIONS.
6. CLEAN ALL INTERIOR & EXTERIOR DUCTWORK OF DUST AND DIRT AS IT IS INSTALLED. IT IS THE CONTRACTOR'S RESPONSIBILITY TO IMPLEMENT AND EMPLOY ANY AND ALL MEANS NECESSARY TO INSURE THAT ALL DUCT SYSTEMS ARE INSTALLED AND MAINTAINED CLEAN AT ALL TIMES.
7. TEST LOW VELOCITY DUCTWORK TO THE DESIGN OPERATING PRESSURE PER SMACNA. ALLOW LEAKAGE RATES AS PER THE ASSOCIATED AIR BALANCE COUNCIL (AABC).

**B. SHEET METAL DUCTWORK:**

1. INSTALL ALL SHEET METAL IN ACCORDANCE WITH LATEST ASHRAE AND SMACNA RECOMMENDATIONS. PROVIDE VARIATIONS IN DUCT SIZE (WITHOUT DIMINISHING SYSTEM PERFORMANCE) AND ADDITIONAL DUCT FITTINGS AS REQUIRED TO CLEAR OBSTRUCTIONS AND MAINTAIN CLEARANCES.
2. INSTALL DUCTS WITH ZINC DICHROMATE IRON HANGERS FASTENED TO OVERHEAD CONSTRUCTION. HANGERS SHALL BE IN CONFORMANCE WITH SMACNA, ASHRAE AND IMC REQUIREMENTS.

**C. ACCESSORIES:**

1. FIRE DAMPERS: INSTALL TYPE B FUSIBLE LINK FIRE DAMPERS FULL SIZE OF DUCT AT POINTS WHERE SHOWN OR REQUIRED.
2. MANUAL VOLUME DAMPERS: PROVIDE VOLUME DAMPERS WHERE INDICATED ON THE DRAWINGS. INSTALL SINGLE BLADE VOLUME DAMPERS OF 16 GAUGE GALVANIZED STEEL WITH CONTINUOUS 3/8" ROD SECURED TO SUITABLE SUPPORT BEARINGS. SCORE ENDS OF DAMPER SHAFT TO INDICATE POSITION OF DAMPER BLADE. INSTALL DAMPER WITH SUFFICIENT CLEARANCE FROM DUCT TRANSITION AND/OR OTHER EQUIPMENT TO AVOID BINDING.
3. ACCESS DOORS: PROVIDE INSULATED ACCESS DOORS IN DUCTWORK AND FURRING FOR EACH FIRE DAMPER OR INSULATED ACCESS DOORS IN INSULATED DUCTS. PROVIDE PER SMACNA, 'UL' LISTING AND ALL RELATED CODES.

**3.4 FILTERS**

- A. PRIOR TO INSTALLING FILTER MEDIA IN AIR HANDLING UNITS, CHECK AND SEAL ALL GAPS OR CRACKS PRESENT IN THE FILTER FRAMES.
- B. INSTALL ALL FILTER MEDIA PRIOR TO STARTING SYSTEMS. VACUUM CLEAN ALL AIR HANDLERS PRIOR TO RUNNING UNITS AND INSTALLING FILTERS.

**3.5 MAINTENANCE SCHEDULE**

- A. THE CONTRACTOR SHALL SUBMIT INFORMATION FROM THE EQUIPMENT MANUFACTURERS PERTAINING TO A LUBRICATION MAINTENANCE SCHEDULE, ALONG WITH ANTICIPATED BEARING LIFE. RELIABILITY AND LOW MAINTENANCE WILL BE A STRONG CONSIDERATION IN FAN SELECTION. INCLUDE THIS INFORMATION IN THE O&M MANUAL.

**3.6 EQUIPMENT INSTALLATION**

- A. SET ALL EQUIPMENT IN PLACE ALLOWING FOR EASY ACCESS TO ALL PARTS OF THE EQUIPMENT. DO NOT BLOCK ACCESS TO ANY ACCESS DOORS, PULL SPACES OR PARTS REQUIRING ACCESS FOR MAINTENANCE (48" MINIMUM OR REFER TO MANUFACTURERS RECOMMENDATIONS).
- B. PROVIDE ALL ANCHORS AND SUPPORTS FOR PROPER INSTALLATION ON EQUIPMENT. UNLESS NOTED OTHERWISE, ALL MATERIALS USED FOR ANCHORING AND SUPPORTS SHALL BE GALVANIZED.

**3.7 EQUIPMENT IDENTIFICATION**

- A. IDENTIFY EACH FAN, PUMP, HEAT EXCHANGER, AIR HANDLER, MOTOR, MOTOR STARTER, AND SIMILAR EQUIPMENT. ALL EQUIPMENT SHALL HAVE ENGRAVED 2 COLOR (BLUE ON WHITE) PLATES THAT REFERENCE THE MAINTENANCE MANUALS.

**3.8 GENERAL EQUIPMENT INSTALLATION REQUIREMENTS:**

- A. POSITION EQUIPMENT TO RESULT IN GOOD APPEARANCE AND PROVIDE EASY ACCESS TO ALL COMPONENTS FOR MAINTENANCE AND FOR TUBE REMOVAL OR OTHER REPAIRS. INSTALL THE PIPING AND PIPE LINE ACCESSORIES SO THEY DO NOT INTERFERE WITH EQUIPMENT ACCESS. INSTALL EQUIPMENT ISOLATION VALVES IN SUCH A MANNER TO ALLOW COMPLETE MAINTENANCE AND DISASSEMBLY OF EQUIPMENT WITHOUT HAVING TO REMOVE EQUIPMENT ISOLATION VALVES.
- B. INSTALL EQUIPMENT IN A LOCATION THAT IS LEVEL, SECURE, AND FREE OF MOISTURE. PROVIDE SHIMS, ANCHORS, SUPPORT STRAPS, ANGLES, AND GROUTED BASES AS REQUIRED TO ACCOMPLISH THIS.
- C. ONLY USE GALVANIZED OR CADMIUM PLATED SCREWS, NUTS, BOLTS, RODS, AND WASHERS. AFTER FABRICATION, HOT DIP GALVANIZE UNFINISHED FERROUS ITEMS FOR OUTDOORS USE, BELOW GRADE INSTALLATIONS OR OTHER AREAS SUBJECT TO MOISTURE.
- D. INSTALL ALL EQUIPMENT PER MANUFACTURERS' RECOMMENDATIONS.

**3.9 CONTROLS**

- A. PROVIDE CONTROLS AS DESCRIBED IN THESE DRAWINGS. CONTRACTOR SHALL BE RESPONSIBLE FOR PROVIDING THE ACTUAL WIRING DIAGRAMS. CONTRACTOR SHALL PROVIDE ALL NECESSARY COMPONENTS AND ACCESSORIES REQUIRED FOR A COMPLETE INSTALLATION THAT SHALL OPERATE PER THE "SEQUENCE OF OPERATION".
- B. THE MECHANICAL CONTRACTOR IS RESPONSIBLE FOR ALL ELECTRICAL WORK ASSOCIATED WITH THE CONTROLS, INCLUDING CONDUIT, WIRING, AND FINAL CONNECTIONS. ELECTRICAL CONTRACTOR IS RESPONSIBLE FOR ALL POWER WIRING. COORDINATE WITH ELECTRICAL CONTRACTOR FOR POWER WIRING. CONTROL WIRING MAY BE SUB-CONTRACTED TO THE ELECTRICAL CONTRACTOR, IF DESIRED.

**3.10 TESTS:**

- A. PROVIDE ALL LABOR, EQUIPMENT AND MATERIALS REQUIRED TO PERFORM TESTS.
- B. PROTECT VALVES AND EQUIPMENT FROM DAMAGE DURING TESTS. INCLUDE CONNECTION TO PREVIOUSLY TESTED SECTIONS, IF THE SYSTEMS ARE TESTED IN SECTIONS.
- C. SUBMIT TO THE ENGINEER, FOR APPROVAL, A LOG (BALANCE REPORT) OF ALL TESTS MADE WHICH SHALL INCLUDE DATE, TIME, TEMPERATURE, PRESSURE AND OTHER READINGS NECESSARY TO INDICATE THE SYSTEMS HAVE BEEN OPERATED AND TESTED IN THE MANNER OUTLINED IN THE CONSTRUCTION DOCUMENTS. TESTS SHALL BE OBSERVED AND SIGNED-OFF BY OWNER OR OWNER'S REPRESENTATIVE.

**3.11 ADJUSTING AND BALANCING:**


- A. ADJUST ALL EQUIPMENT AND SYSTEM COMPONENTS AS SCHEDULED ON DRAWINGS, OR AS REQUIRED, TO RESULT IN THE INTENDED SYSTEM OPERATION. SYSTEMS SHALL BE INSTALLED, TESTED, AND ADJUSTED TO PERFORM AS DESIGNED BY THE ENGINEER.
- B. TESTING ADJUSTMENT AND BALANCING REPORT (TAB) TO PERFORMED AS PART OF THE GENERAL CONTRACT. ACTUAL WORK TO BE PROVIDED BY INDEPENDENT QUALIFIED TAB SUB CONSULTANT.

**3.12 STARTUP SERVICES:**

- A. PRIOR TO STARTUP, ENSURE THAT THE SYSTEMS ARE CLEAN AND READY, INCLUDING BUT NOT LIMITED TO THE FOLLOWING: PROPER EQUIPMENT ROTATION, PROPER WIRING, AUXILIARY CONNECTIONS, LUBRICATION, VENTING, CONTROLS, ALL FILTERS AND PROPERLY SET RELIEF AND SAFETY VALVES.
- B. START AND OPERATE ALL SYSTEMS AS REQUIRED. ENSURE CONTROLS ARE FUNCTIONING PROPERLY. INSTRUCT OWNER OR OWNERS REPRESENTATIVE ON PROPER OPERATION AND MAINTENANCE. PROVIDE COMPLETED AND ENGINEER REVIEWED O & M MANUALS.

**3.13 WARRANTY**

- A. THE CONTRACTOR SHALL WARRANTY HIS WORK FOR A PERIOD OF ONE YEAR FROM THE DATE OF COMPLETION. THIS INCLUDES WORKMANSHIP, MATERIALS, AND EQUIPMENT. CONTRACTOR SHALL PROVIDE LABOR, MATERIALS AND EQUIPMENT TO CORRECT ANY FAULTY INSTALLATIONS AND WORKMANSHIP.
- B. THE OWNER IS RESPONSIBLE FOR ROUTINE MAINTENANCE AND CARE.

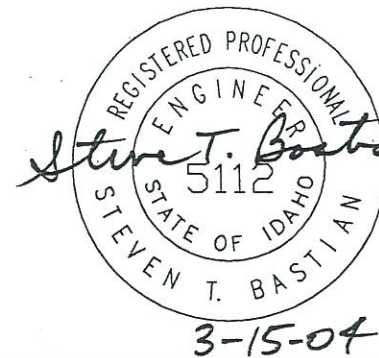

<p><b>Medical Design Group</b> Architecture for Health Care</p>	
<p>2716 WESTLAND PLACE BOISE, IDAHO 83704-5863</p> <p>BOISEARCHITECT@AOL.COM Fax (208) 378-1405 Phone (208) 378-0817</p>	
<p>© COPYRIGHT: MEDICAL DESIGN GROUP</p>	
<p><b>HVAC SPECIFICATIONS</b></p>	
<p>Desert Sage Health Care 2280 American Legion Blvd. Mountain Home, Idaho</p>	
<p>SHEET <b>M0.3</b></p>	<p>March 2004</p>

## ROOFTOP UNIT SCHEDULE

EQUIP TAG	TOTAL CFM	NOMINAL TONS	OSA	ESP	FAN BHP	DRIVE	COOLING <sup>[1]</sup>					HEATING(NATURAL GAS)			ELECTRICAL				APPROX OPER WEIGHT	MANUFACTURER	MODEL #	REMARKS
							EDB	EWB	EER	TOTAL MBH [5]	SEN MBH [5]	MBH-IN	MBH-OUT	EFFICIENCY	CHAR	FLA	MCA	MOCF				
RTU-1	3000	7-1/2	525	.60	1.63	BELT	80	62	9.0	83.6	81.3	120.0/180.0	96.0/144.0	80%	208/3/60	42	40.1	45	1200 Lbs.	CARRIER	481FE008	[2],[3],[4],[6],[7],[8],[9],[11]
RTU-2	1600	4	155	.80	.93	BELT	80	62	9.0	45.7	42.2	72.0	56.0	80%	208/3/60	25	25.6	30	700 Lbs.	CARRIER	481FE005	[2],[3],[4],[6],[7],[8],[9],[10],[11]
RTU-3	3400	8-1/2	725	.60	2.10	BELT	80	62	9.0	93.7	90.3	120.0/180.0	96.0/144.0	80%	208/3/60	47	44.8	50	1200 Lbs.	CARRIER	481FE009	[2],[3],[4],[6],[7],[8],[9],[11]
RTU-4	3000	7-1/2	685	.60	1.63	BELT	80	62	9.0	83.6	81.3	120.0/180.0	96.0/144.0	80%	208/3/60	42	40.1	45	1200 Lbs.	CARRIER	481FE008	[2],[3],[4],[6],[7],[8],[9],[11]

- (ALTERNATE #9) [1] DESIGN CONDITIONS: 95° F AMBIENT.  
 [2] PROVIDE WITH ROOF CURB PER MANUFACTURERS RECOMMENDATIONS, COORDINATE WITH ARCHITECTURAL DRAWINGS FOR DEPTH OF INSULATION.  
 [3] PROVIDE ENTHALPY CONTROLLED 100% ECONOMIZER W/100% FULLY MODULATING POWERED EXHAUST.  
 [4] PROVIDE UNITS W/ ELECTRONIC AUTO CHANGE-OVER HEATING/COOLING T-STAT W/ FAN CONTROL. T-STAT TO BE 365 CALENDAR DAY FULLY PROGRAMMABLE WITH 1-HOUR UNOCCUPIED OVERRIDE.  
 [5] THESE VALUES ARE BASED UPON MANUFACTURER'S DATA, ASSUMING 80° F DB/62° F WB.  
 (ALTERNATE #10) [6] PROVIDE WITH ECONOMIZER CAPABLE OF 100% OSA. PROVIDE MECHANICAL OR CONTROLS STOP CAPABLE OF STOPPING @ 50% OSA.  
 (ALTERNATE #10) [7] PROVIDE UNITS WITH BAROMETRIC RELIEF CAPABLE OF 20% RELIEF AIR. PROVIDE ENTHALPY CONTROLLED 100% ECONOMIZER.  
 [8] PROVIDE DUCT MOUNTED SMOKE DETECTORS. PROVIDED AND INSTALLED BY MECHANICAL, FINAL CONNECTION BY ELECTRICAL.  
 [9] PROVIDE UNITS WITH LOOSE SHIPPED, FIELD WIRING CONVENIENCE OUTLETS SEPARATE CIRCUIT.  
 [10] PROVIDE ALTERNATE HIGH STATIC MOTOR.  
 [11] ROOF TOP UNITS TO OPERATE AT 70° F HEATING/72° F COOLING DURING OCCUPIED HOURS. FAN TO REMAIN ON DURING OCCUPIED HOURS. UNOCCUPIED TO OPERATE AT 65° F HEATING/85° F COOLING. FAN ON AUTO DURING UNOCCUPIED HOURS.

MANUFACTURER'S APPROVED FOR SUBMITTAL OF COMPARABLE PRODUCTS  
 CARRIER, YORK, LENNIX, TRANE, BRYANT

### DESCRIPTION OF ALTERNATES:

THESE DESCRIPTIONS ARE TO PROVIDE AN UNDERSTANDING FOR THE MECHANICAL CONTRACTOR ONLY, AND DO NOT REFLECT THE FULL SCOPE OF ITEMS THAT MAY BE REQUIRED FOR ALL DISCIPLINES. ALTHOUGH SOME DIRECTION ON WHERE TO FIND INFORMATION CONCERNING EACH ALTERNATE IS NOTED BELOW, IT IS NOT INTENDED TO BE COMPLETE. TREAT THE ENTIRE DRAWING AND SPECIFICATIONS SET (ALL CONTRACT DOCUMENTS) AS APPLYING TO ALL ALTERNATES LISTED IN THE BID FORM AND ON THESE DRAWINGS.

#### ALTERNATE #3 - ROOFING

THE INTENT OF THIS ALTERNATE IS TO PROVIDE A BASE BID DESIGN FOR ASPHALT SHINGLES, THAT INCLUDES EXHAUST FANS TO PROVIDE VENTILATION AIR UNDER THE SHINGLES TO MAINTAIN A LOWER TEMPERATURE AND PROLONG THE LIFE OF THE SHINGLES. FOR THE MECHANICAL THIS IS A DEDUCTIVE ALTERNATE, AS THE GENERAL CONTRACTOR IS TO PROVIDE CONCRETE TILED ROOF FOR THE ALTERNATE. THIS WOULD ALLOW THE MECHANICAL CONTRACTOR TO ELIMINATE THE EXHAUST FANS (EF-8).

THIS BASE BID IS TO INCLUDE TWO EXHAUST FANS (EF-8), ONE LOCATED ON THE EAST SIDE OF THE ROOF WELL AND ONE ON THE WEST SIDE OF THE ROOF WELL. THESE ARE TO BE TIED TO SEPARATE HIGH TEMPERATURE THERMOSTATS TO BE LOCATED IN THE ATTIC ON THE TOP CHORD OF THE TRUSSES WITHIN 5'-0" OF FAN INLET. THESE ARE TO ACTIVATE THE FANS UPON THE TEMPERATURE RISING ABOVE 95°. ALL DUCTWORK AND ACCESSORIES AS DEPICTED IN THESE DRAWINGS REQUIRED FOR THE OPERATION OF THESE FANS SHALL BE PART OF THIS BASE BID.

THE ALTERNATE BID IS TO ELIMINATE THESE FANS AND THEIR ASSOCIATED DUCTWORK, CONTROLS AND ACCESSORIES.

#### ALTERNATE #9 - POWERED EXHAUST

THE INTENT OF THIS ALTERNATE IS TO PROVIDE 100% FULLY MODULATING POWERED EXHAUST MOUNTED DIRECTLY ON EACH ROOF TOP UNIT.

NO BASE BID.

#### ALTERNATE #10 - CENTRALIZED POWERED EXHAUST

THE INTENT OF THIS ALTERNATE IS TO PROVIDE 100% FULLY MODULATING POWERED EXHAUST CENTRALLY LOCATED AND CONTROLLED BY AVERAGING PRESSURE SENSORS IN EACH OF THE MAJOR COMPARTMENTS OF THE BUILDING.

PROVIDE AS LISTED IN THE EXHAUST SCHEDULE EF-6, INCLUDE THE VFD FOR THIS FAN, THE CONTROLS, DUCT CONNECTIONS, LOW VOLTAGE WIRING ETC., SEE DRAWINGS M1.2, AND DETAIL 2 ON M3.1.

NO BASE BID.

## EXHAUST FAN SCHEDULE

EQUIP TAG	AREA SERVED	QTY [6]	TYPE	DRIVE	CFM	ESP	RPM	SONES	HP OR (WATTS)	ELECT	OPER WEIGHT	MANUFACTURER	MODEL #	REMARKS
EF-1	RESTROOM	4	CEILING	DIRECT	75	.25	1200	1.5	(65)	115/1/60	22 Lbs.	COOK	GC-240	[1]
EF-2	--	1	CEILING	DIRECT	100	.25	1200	1.5	(65)	115/1/60	22 Lbs.	COOK	GC-240	[3]
EF-3	--	2	CEILING	DIRECT	150	.25	1365	3.5	(77)	115/1/60	25 Lbs.	COOK	GC-320	[3]
EF-4	--	3	CEILING	DIRECT	200	.25	1610	4.3	(135)	115/1/60	25 Lbs.	COOK	GC-340	[3]
EF-5	CRAWL SPACE	1	INLINE	DIRECT	155	.25	1360	2.1	(61)	115/1/60	25 Lbs.	COOK	GN-320	[2],[4]
EF-6	RELIEF AIR	1	UPBLAST	BELT	6000	.50	1725	7.9	1 HP	115/1/60	400 Lbs.	COOK	330R7B	[7],[8],[9],[10]
EF-7	UTILITY 2	1	CEILING	DIRECT	75	.25	1200	1.5	(65)	115/1/60	22 Lbs.	COOK	GC-240	[5]
EF-8	ATTIC	2	INLINE	DIRECT	230	.125	1500	3.4	153	115/1/60	22 Lbs.	COOK	GN-180	[5]
EF-9	ISOLATION ROOM	1	INLINE	DIRECT	230	.125	1500	3.4	153	115/1/60	22 Lbs.	COOK	GN-180	[5]

(ALTERNATE #10)  
 (ALT. #3)

- [1] INTERLOCK WITH MOTION SENSOR, COORDINATE W/ ELECTRICAL.  
 [2] FAN TO RUN CONTINUOUSLY.  
 [3] PROVIDE WITH INDEPENDENT WALL SWITCH.  
 [4] TIE FAN TO INDICATOR LIGHT W/ PERMANENT SIGN, IN NURSE AREA, WHICH SIGNALS IF FAN FAILS TO ENERGIZE.  
 [5] INTERLOCK FAN WITH HEAT RISE T-STAT.  
 [6] VERIFY ALL COUNTS WITH THE FLOOR PLANS.  
 [7] PROVIDE EXHAUST FAN WITH MANUFACTURERS ROOF CURB WITH 1/2" NEOPRENE RUBBER VIBRATION ISOLATING PAD ALL AROUND BASE CURB.  
 [8] PROVIDE WITH BACKDRAFT DAMPER, DAMPER TO BE LOW LEAKAGE WITH RUBBER END SEALS.  
 [9] PROVIDE WITH VFD TO ACCEPT SIGNAL FROM PRESSURE CONTROL PANEL. SEE 2/M3.1.  
 [10] PROVIDE WITH INVERTOR RATED DUTY MOTOR.

MANUFACTURER'S APPROVED FOR SUBMITTAL OF COMPARABLE PRODUCTS  
 COOK, GREENHECK, PENN, CARNES

## GRILLES, REGISTERS AND DIFFUSERS SCHEDULE

EQUIP TAG	AREA SERVED	NOMINAL FACE SIZE	NECK SIZE	MATERIAL	FINISH	MOUNTING TYPE [2]	MANUFACTURER	MODEL #	DESCRIPTION
SD-1	--	[4]	[1]	STEEL	#26 WHITE	LAY-IN	TITUS	TMS	SUPPLY DIFFUSER
SD-2	--	[3]	[1]	STEEL	#26 WHITE	HARD	TITUS	TMS	SUPPLY DIFFUSER
RG-1	--	[4]	[1]	STEEL	#26 WHITE	LAY-IN	TITUS	25RL	RETURN GRILLE - 1/2" SPACING, 30° DEFLECTION
RG-2	--	[3]	[1]	STEEL	#26 WHITE	HARD/SIDEWALL	TITUS	25RL	RETURN GRILLE - 1/2" SPACING, 30° DEFLECTION
EG-1	--	[4]	[1]	STEEL	#26 WHITE	LAY-IN	TITUS	25RL	EXHAUST GRILLE - 1/2" SPACING, 30° DEFLECTION
EG-2	--	[3]	[1]	STEEL	#26 WHITE	HARD/SIDEWALL	TITUS	25RL	EXHAUST GRILLE - 1/2" SPACING, 30° DEFLECTION

- [1] SEE PLANS FOR NECK SIZE. LEAD IN DUCT SIZE SHALL BE THE SAME AS NECK SIZE. PROVIDE SQUARE TO ROUND TRANSITION AS REQUIRED.  
 [2] CONTRACTOR SHALL VERIFY ALL CEILING TYPES BEFORE ORDERING GRILLES, REGISTERS, AND DIFFUSERS.  
 [3] NOMINAL FACE SIZE SHALL BE SIZED WITH NC RATING OF 25 OR LESS.  
 [4] NOMINAL FACE SIZE SHALL BE SIZED WITH NC RATING OF 25 OR LESS. PROVIDE WITH 24"x24" LAY-IN CEILING PANEL TO MATCH CEILING TYPE.

MANUFACTURER'S APPROVED FOR SUBMITTAL OF COMPARABLE PRODUCTS  
 ANEMOSTAT, KRUGER, PRICE, NAILOR, TITUS

## WALL MOUNTED ELECTRIC HEATER SCHEDULE

EQUIP TAG	AREA SERVED	QTY [2]	TYPE	CFM	ELECT	WATTS	OPER WEIGHT	MANUFACTURER	MODEL #	REMARKS
EW-1	ENTRANCE	6	ELECTRIC	50	120/1/60	500	--	QMARK	CRA-0512-T2	[1]

- [1] PROVIDE UNIT WITH INTEGRAL THERMOSTAT CONTROLS.  
 [2] VERIFY COUNT WITH FLOOR PLAN

MANUFACTURER'S APPROVED FOR SUBMITTAL OF COMPARABLE PRODUCTS  
 QMARK, MARKEL



**Medical Design Group**  
 Architecture for Health Care

2716 WESTLAND PLACE  
 BOISE, IDAHO 83704-5863

BOISEARCHITECT@AOL.COM  
 Fax (208) 378-1405  
 Phone (208) 378-0817

© COPYRIGHT: MEDICAL DESIGN GROUP



---

HVAC SCHEDULES


Desert Sage Health Care  
 2280 American Legion Blvd.  
 Mountain Home, Idaho

SHEET  
**MO.4**

March 2004

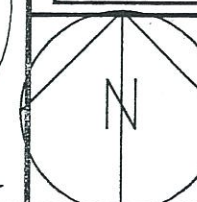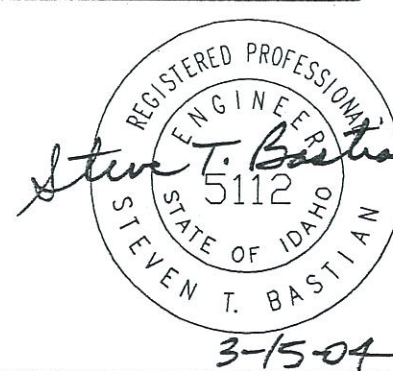

Manual Access to Dampers

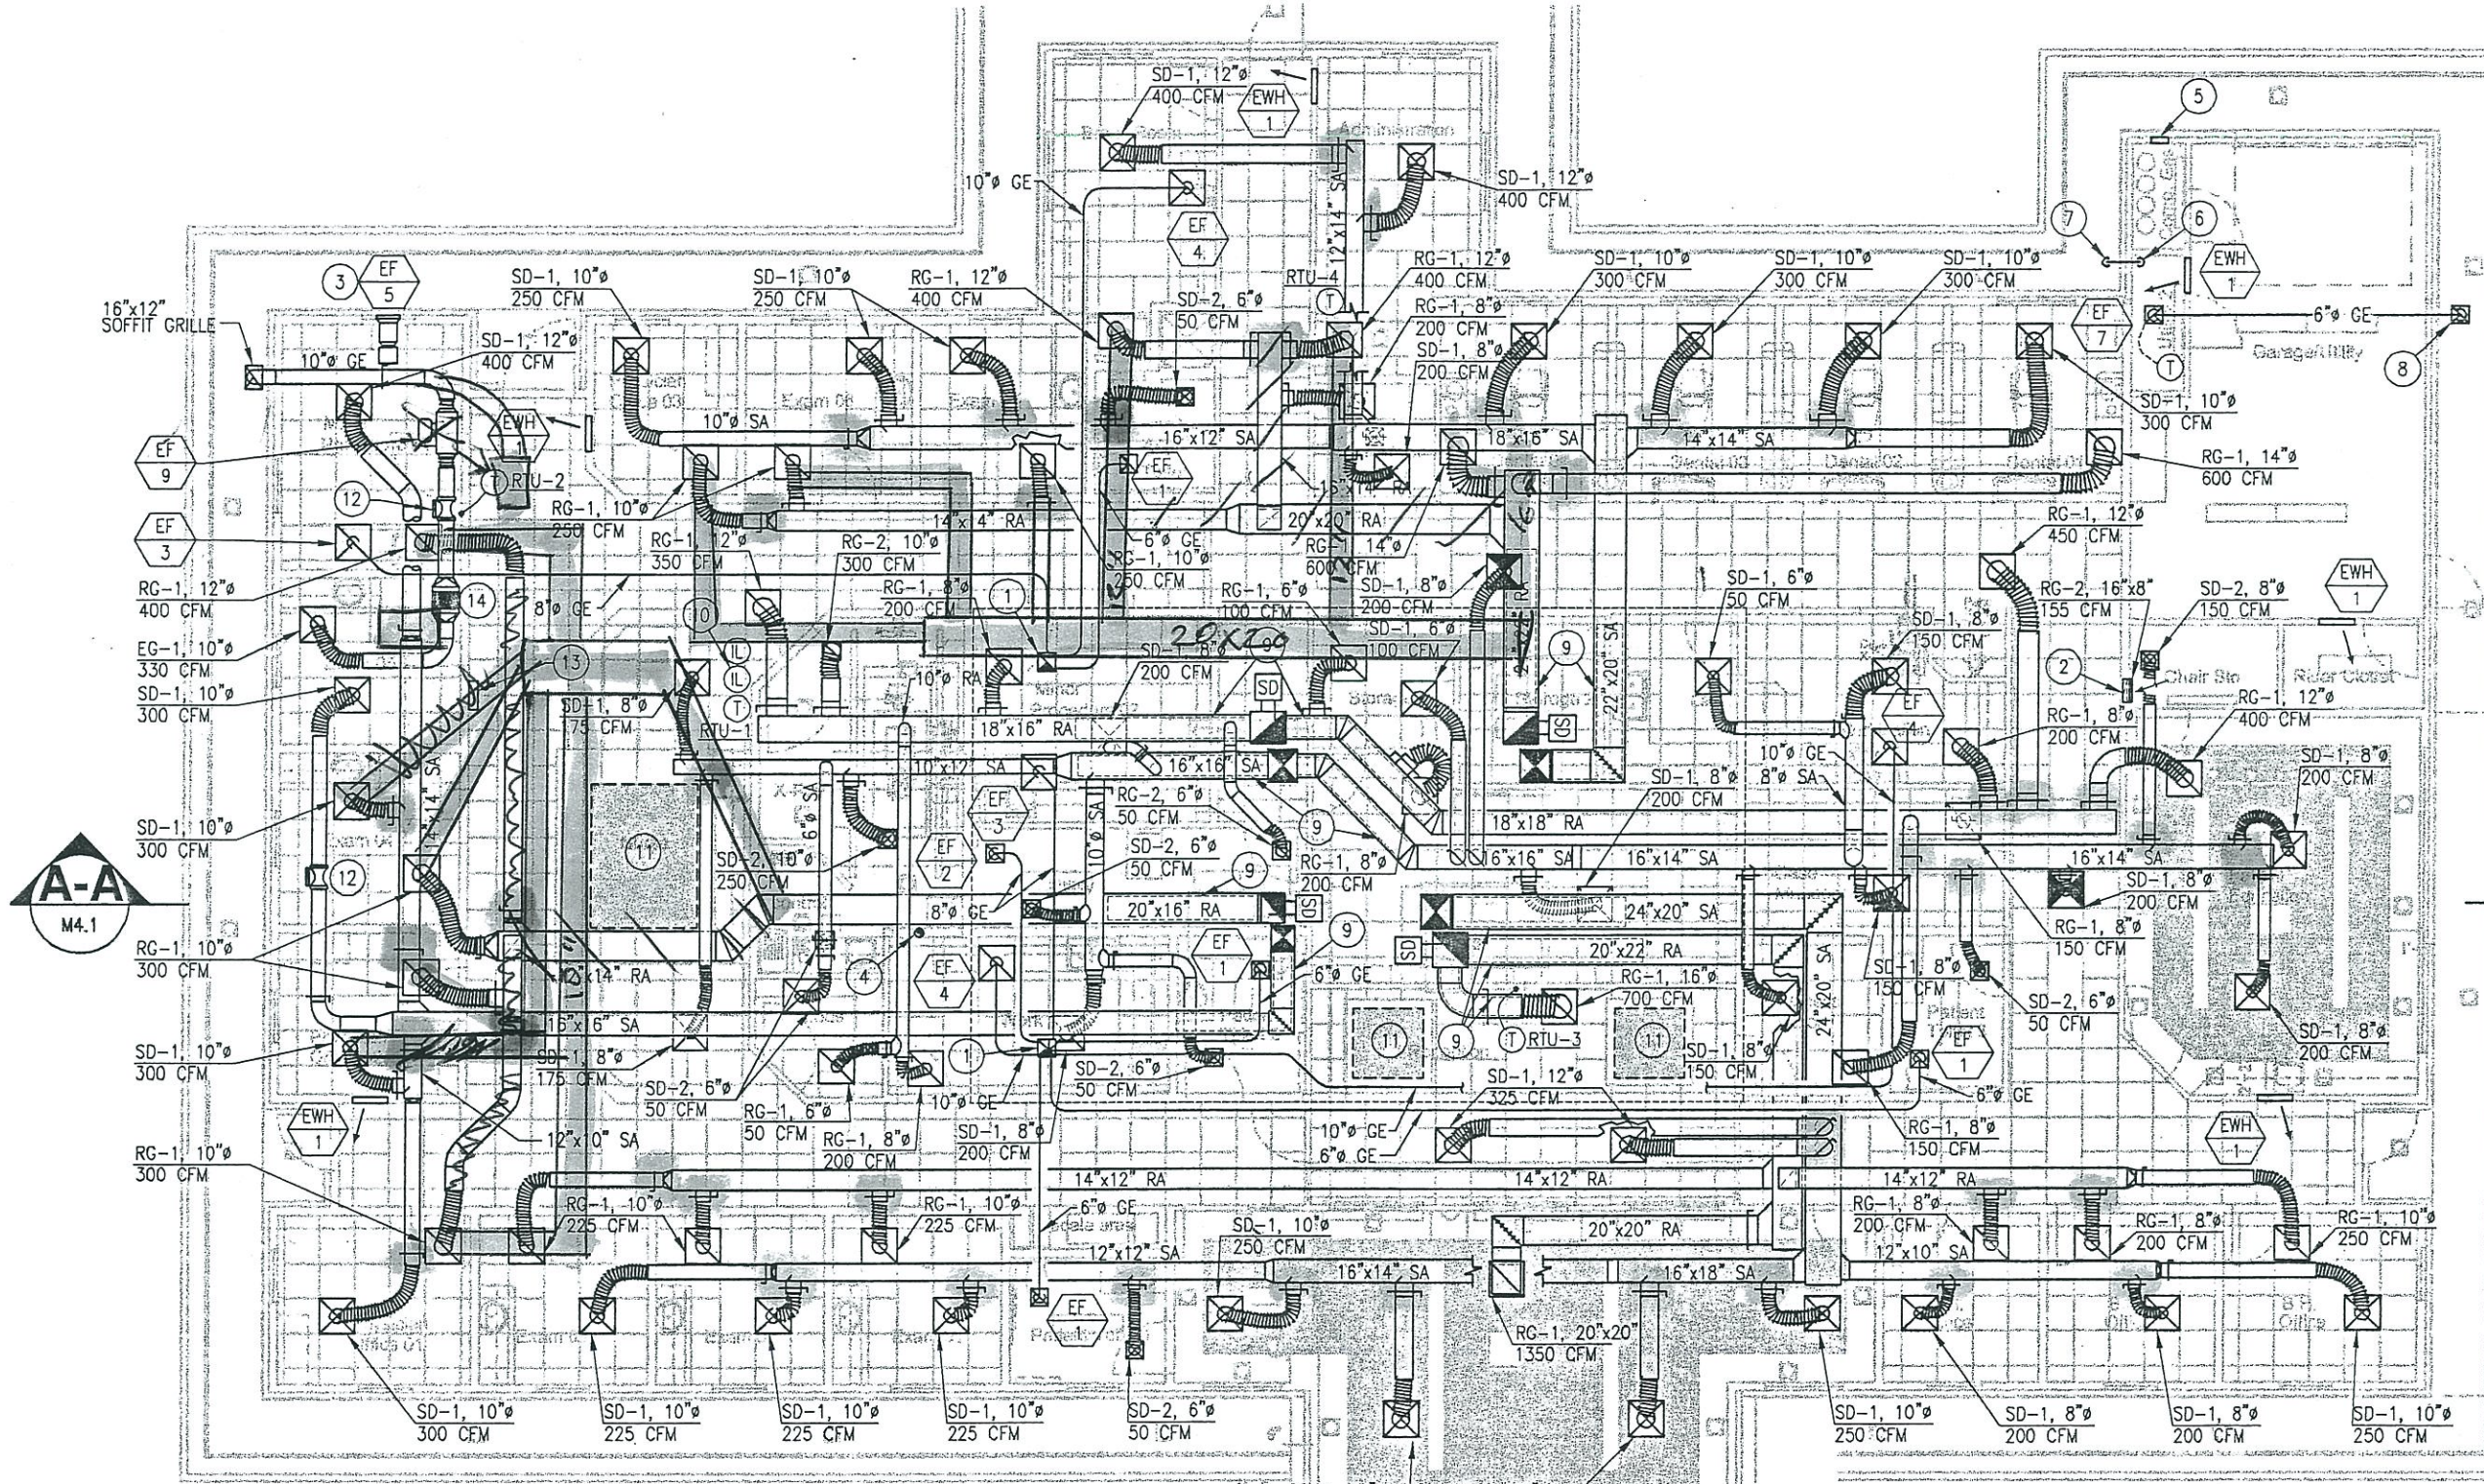


Future Expansion

**KEY NOTES:**

- ① 14"x14" EXHAUST UP THRU ROOF, SEE SHEET M2.1 FOR CONTINUATION.
- ② 14"x3" RELIEF DUCT DOWN IN WALL TO CRAWL SPACE, TERMINATE WITH BAROMETRIC DAMPER AND INSECT SCREEN, SEE DETAIL 4, SHEET M3.1.
- ③ CONNECT 12"x6" GE DUCT TO 16"x8" VENT (VENT TO BE PROVIDED BY OTHERS).
- ④ 6" DRYER EXHAUST UP TO ATTIC SPACE, SEE SHEET M2.1 FOR CONTINUATION. INSTALL DUCT CLEANOUT IN BOTTOM OF VERTICAL RUN PER DETAIL 3, SHEET M3.1.
- ⑤ (2) 12"x24" LOUVERS (LDI MODEL # TE-12 WITH BIRD/INSECT SCREEN), MINIMUM OF 72 SQ. IN. FREE AREA, FOR GAS CABINET VENTING. MOUNT (1) WITHIN 6" OF FINISHED CEILING, AND (1) WITHIN 6" OF FINISHED FLOOR.
- ⑥ ROUTE 4" OSA DUCT FROM SOFFIT TO COMPRESSOR ROOM, CONNECT TO OFCI REMOTE AIR MANIFOLD.
- ⑦ EXTEND 4" OSA THRU SOFFIT 2" AND TERMINATE WITH ESCUTCHEON PRIMED AND PAINTED TO MATCH. COVER END WITH INSECT SCREEN.
- ⑧ EXTEND 6" GE TO EG-1 IN SOFFIT.
- ⑨ LINE DROP AND THE FIRST 10'-0" OF ALL SA & RA WITH 1" ACOUSTICAL LINING.
- ⑩ INDICATOR LIGHT FOR EF-5/EF-8 LOCATED IN THIS AREA, COORDINATE FINAL LOCATION WITH ARCHITECT/OWNER.

- ⑪ AREA FOR SKYLIGHT, KEEP CLEAR.
- ⑫ PROVIDE PHOENIX CONTROL SUPPLY AND EXHAUST CONTROL VALVES, CONSTANT VOLUME MODEL # CVA-108M NO SUBSTITUTIONS ALLOWED.
- ⑬ PROVIDE PHOENIX ACTIVE PRESSURE MONITOR MODEL # APM100. NO SUBSTITUTIONS ALLOWED. MECHANICAL CONTRACTOR IS RESPONSIBLE FOR ALL LOW VOLTAGE WIRING FROM TRANSFORMER TO ALL COMPONENTS. SUPPLY WITH PRESSURE SENSORS AND MOUNT PER MANUFACTURERS WRITTEN INSTRUCTIONS. PROVIDE ALL REQUIRED COMPONENTS FOR A COMPLETE OPERATIONAL SYSTEM.
- ⑭ PROVIDE 12"x12"x4" THICK HEPA (99.9% EFF) FILTER IN FRAME. MAKE ACCESSIBLE TO BOTTOM OR TO SIDE AS ALLOWED BY STRUCTURE AND CEILING. PROVIDE WITH WALL MOUNTED DIFFERENTIAL PRESSURE GAGE TO MEASURE PRESSURE ACROSS HEPA. MOUNT BESIDE ACTIVE PRESSURE MONITOR.

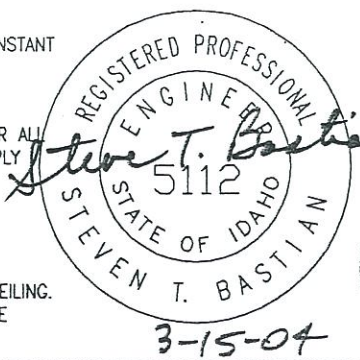

**ELKHORN ENGINEERS, PA**  
 2950 E. Magic View Dr., Ste. 190  
 Meridian, Idaho 83642  
 phone: (208) 955-0555  
 fax: (208) 955-0999

**Medical Design Group**  
 Architecture for Health Care  
 2716 WESTLAND PLACE  
 BOISE, IDAHO 83704-5863  
 BOISEARCHITECT@AOL.COM  
 Fax (208) 378-1405  
 Phone (208) 378-0817


© COPYRIGHT: MEDICAL DESIGN GROUP

**HVAC FLOOR PLAN**

Desert Sage Health Care  
 2280 American Legion Blvd.  
 Mountain Home, Idaho

**SHEET M1.1**

March 2004

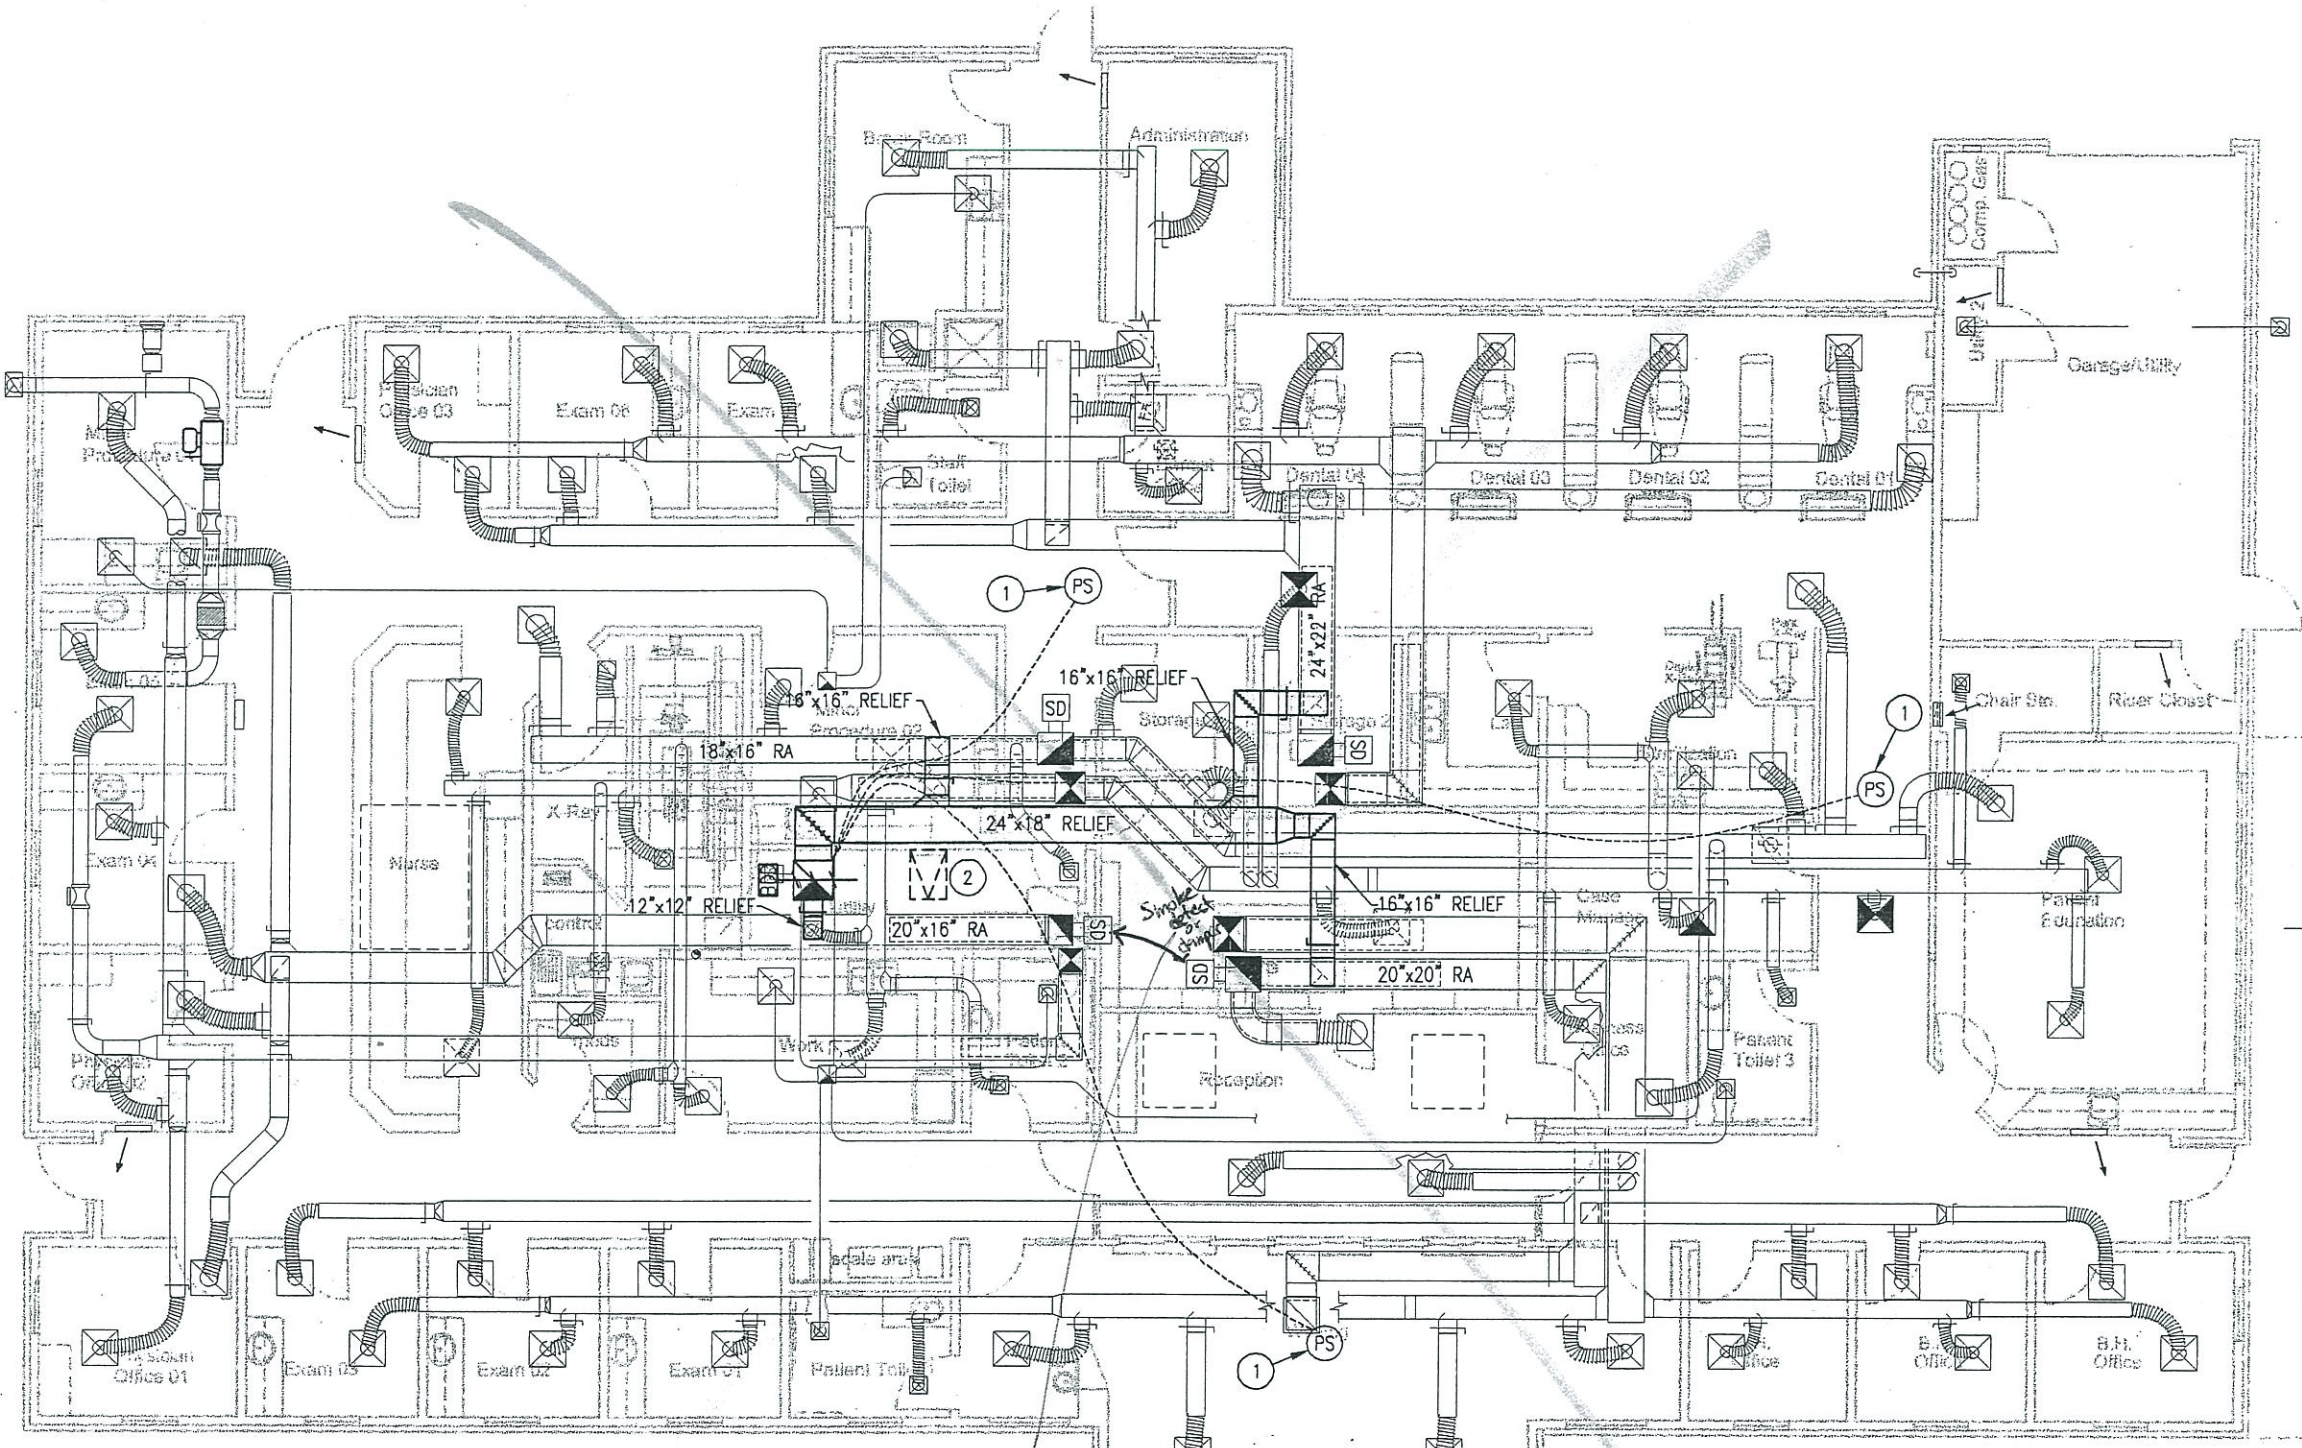


**ALTERNATE # 10 - RELIEF AIR**

*110v low voltage*

**KEY NOTES:**

- ① PROVIDE PRESSURE SENSOR TO SENSE ROOM PRESSURE & SEND SIGNAL BACK TO AVERAGING CONTROLLER. CONTROLLER TO OPERATE VFD ON EF-6 TO MAINTAIN AVERAGE BUILDING PRESSURE OF 0.05 W.C., SEE DETAIL 2, SHEET M3.1 FOR MORE INFORMATION.
- ② ROOF HATCH, KEEP CLEAR.

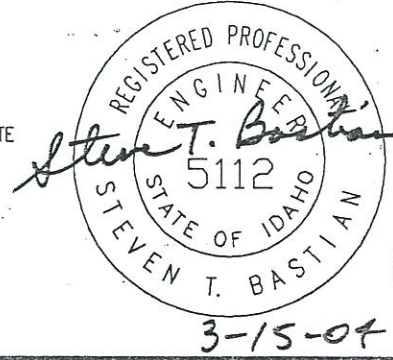

**Medical Design Group**  
 Architecture for Health Care  
 2716 WESTLAND PLACE  
 BOISE, IDAHO 83704-5863  
 BOISEARCHITECT@AOL.COM  
 Fax (208) 378-1405  
 Phone (208) 378-0817  
 © COPYRIGHT: MEDICAL DESIGN GROUP


**RELIEF AIR PLAN - ALT. # 10**

Desert Sage Health Care  
 2280 American Legion Blvd.  
 Mountain Home, Idaho

**SHEET M1.2**

March 2004

S:\Projects\03MDG002\Drawings\03MDG002M21.dwg, 3/15/2004 11:55:57 AM, thompson, ANSI B (11.00 x 17.00 inches), 1:1.

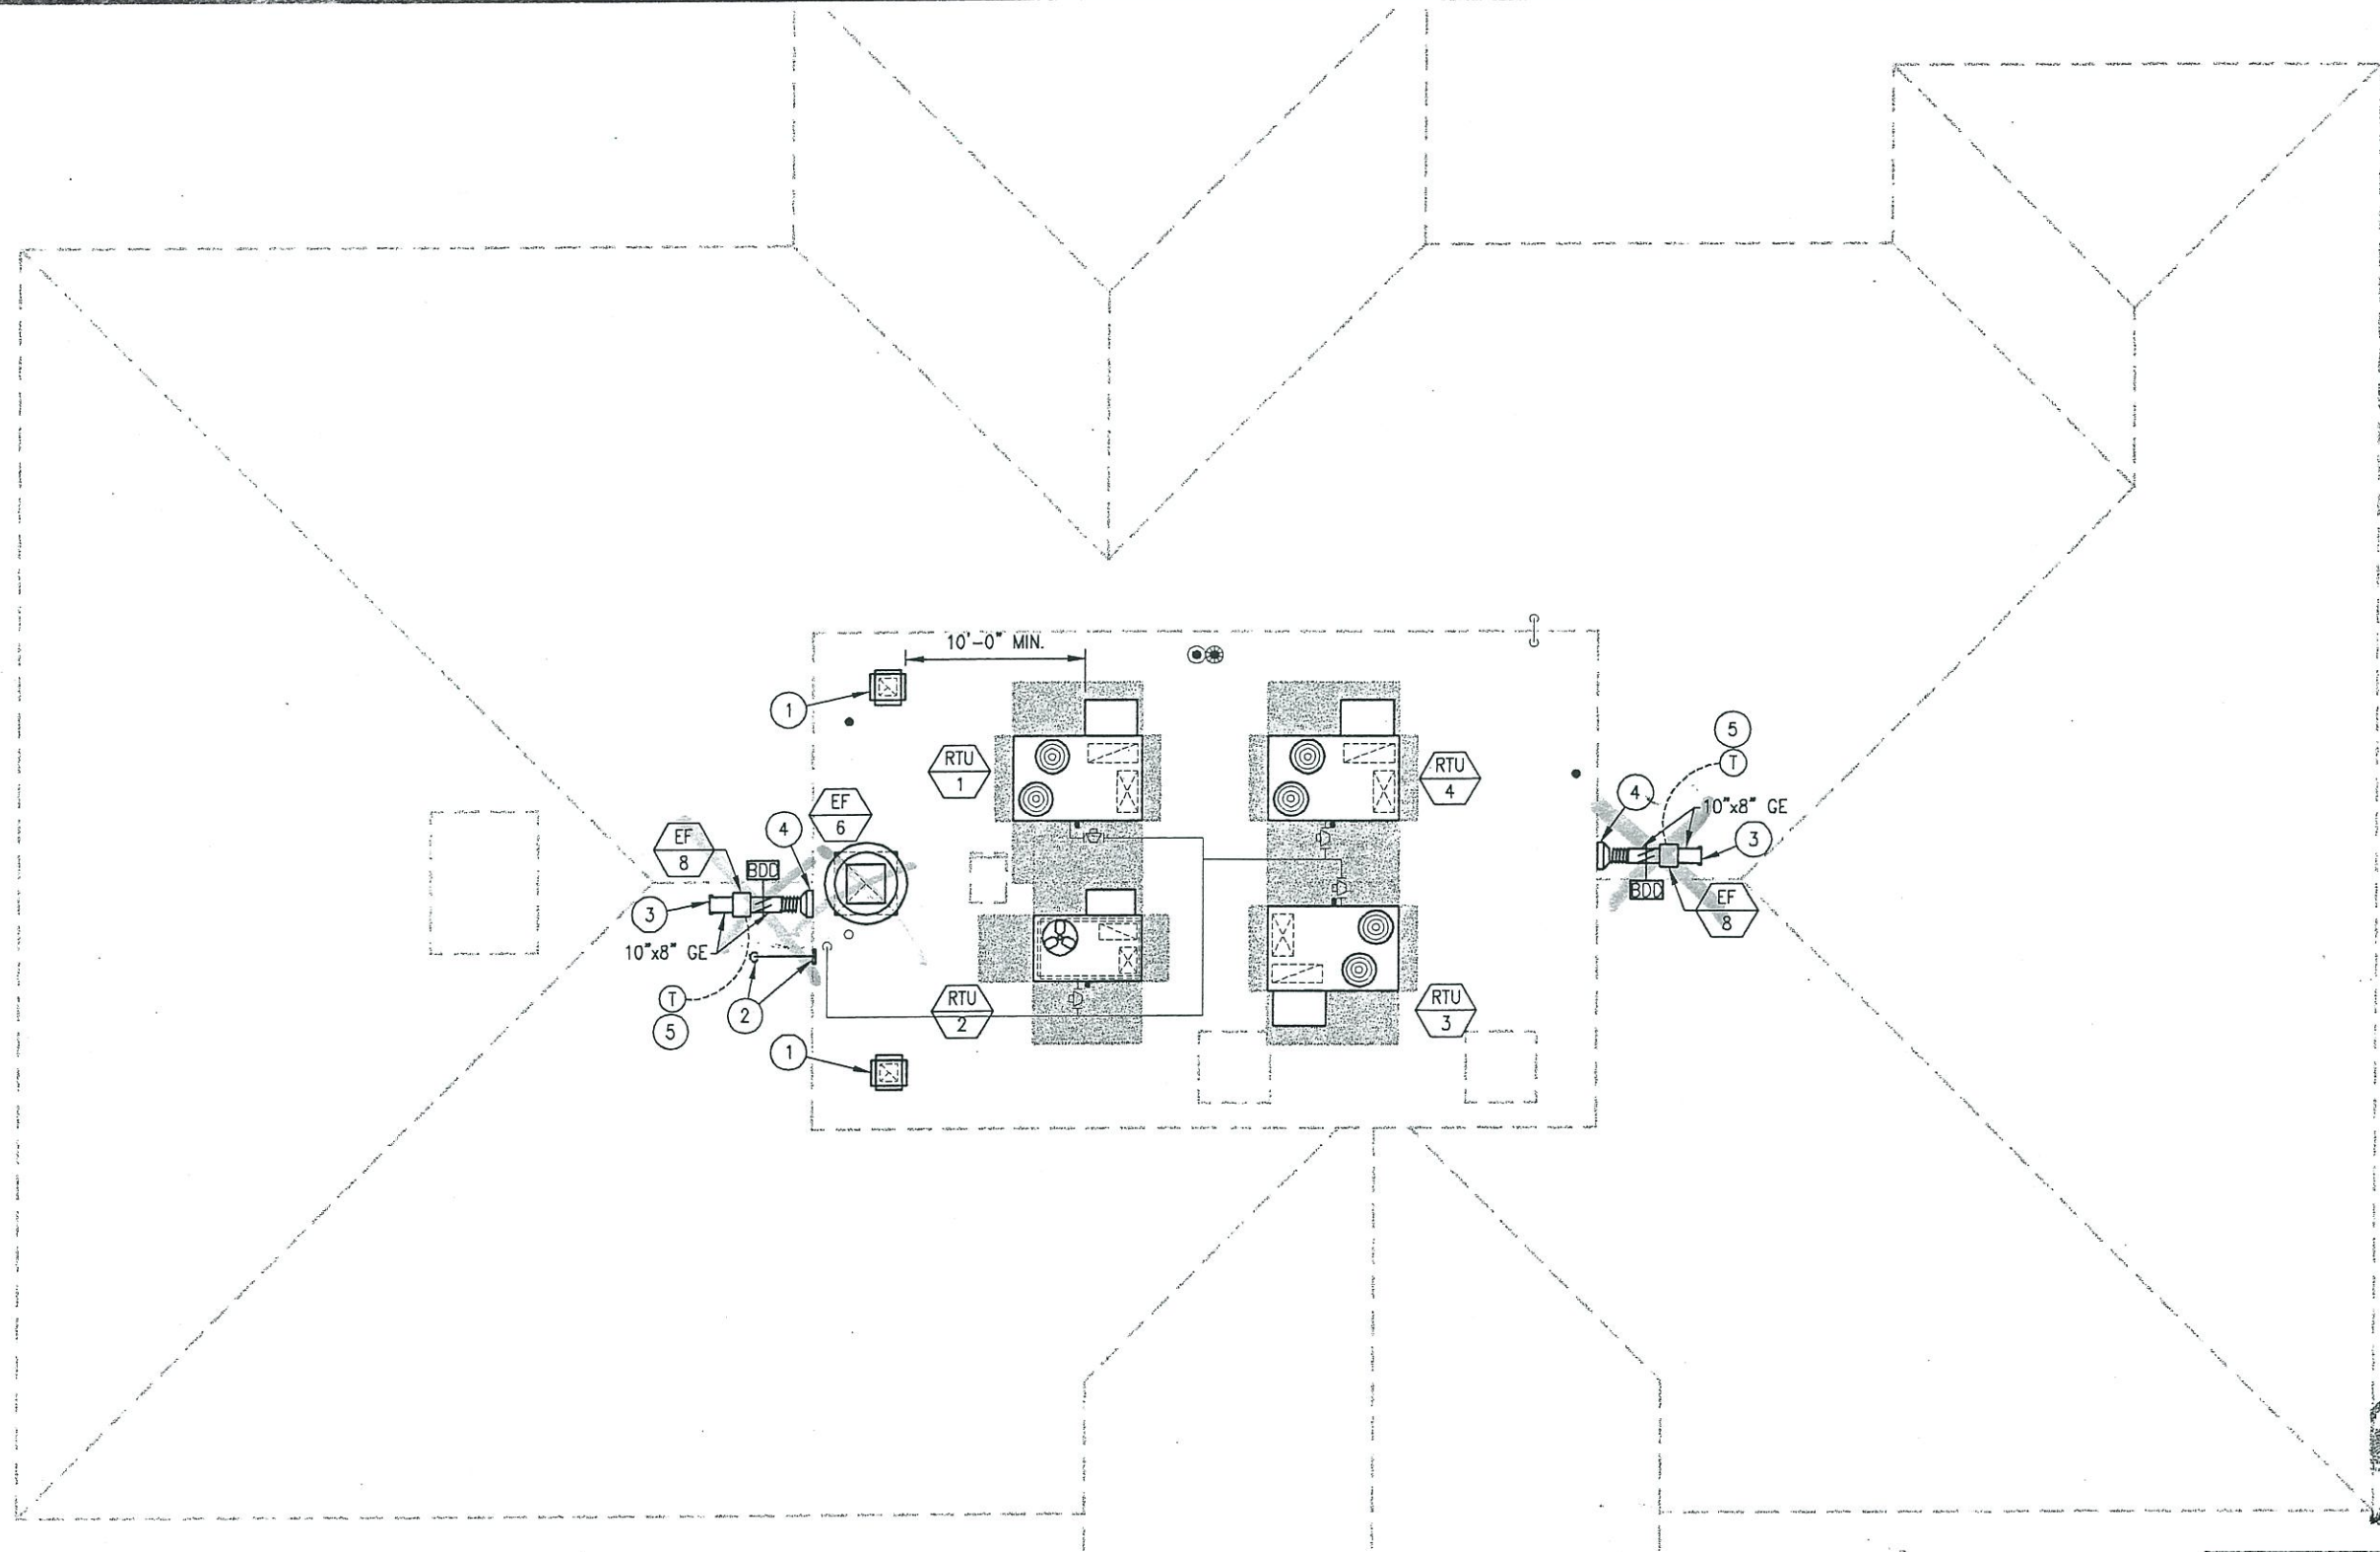



**KEY NOTES:**

- ① RELIEF VENTILATOR, SEE DETAIL 1, SHEET M3.1 FOR MORE INFORMATION.
- ② 6"Ø DRYER EXHAUST FROM BELOW, ROUTE IN ATTIC SPACE TO PARAPET WALL AND TERMINATE WITH MANUFACTURERS RECOMMENDED WALL CAP.
- ③ 1/2"x1/2" WELDED WIRE MESH.
- ④ SIDEWALL GRILLE WITH INSECT SCREEN.
- ⑤ MOUNT HIGH TEMPERATURE T'STAT (RANGE 80F-110F ADJ.) AT TOP CHORD OF TRUSS, WITHIN 5'-0" OF INLET TO ATTIC EXHAUST FAN. T'STAT TO ACTIVATE EXHAUST FAN UPON TEMP RISING TO 95F. PROVIDE DIFFERENTIAL PRESSURE SWITCH TO PROVE AIR FLOW. PROVIDE INDICATOR LIGHT TO SHOW FAN FAILURE. MOUNT INDICATOR LIGHT AT UTILITY RM. LOCATE PER ARCHITECT/OWNER. MARK WITH LAMINATED, TWO COLOR, ENGRAVED TAG. PROVIDE WIRING DIAGRAM FOR REVIEW.

REGISTERED PROFESSIONAL ENGINEER  
 STATE OF IDAHO  
 5112  
 STEVEN T. BASTIAN  
 3-15-04

**ELKHORN ENGINEERS, PA**  
 2950 E. Magic View Dr., Ste. 190  
 Meridian, Idaho 83642  
 phone: (208) 955-0555  
 fax: (208) 955-0999

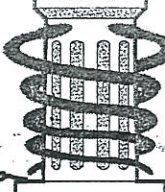 <p><b>Medical Design Group</b>          Architecture for Health Care</p>	
2716 WESTLAND PLACE BOISE, IDAHO 83704-5863 BOISEARCHITECT@AOL.COM Fax (208) 378-1405 Phone (208) 378-0817	
© COPYRIGHT: MEDICAL DESIGN GROUP	
<p align="center"><b>HVAC ROOF PLAN</b></p>	
Desert Sage Health Care 2280 American Legion Blvd. Mountain Home, Idaho	SHEET <b>M2.1</b>
March 2004	

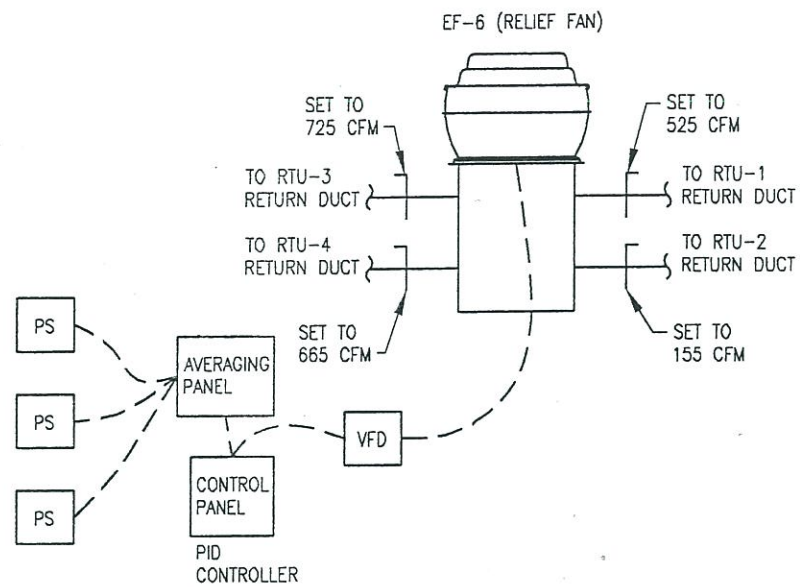


**SEQUENCE OF OPERATIONS**

EF-6 TO START UPON AVERAGE PRESSURE TO RISE TO +0.1" W.G. UPON START, OPERATE FAN AT 50% SPEED FOR 30 SECONDS (ADJUSTABLE). THEN MODULATE TO CONTROL PRESSURE TO SET POINT.

STOP FAN UPON PRESSURE FALLING TO + .05" W.G.

ALL SET POINTS TO BE ADJUSTABLE CONTRACTOR TO SUBMIT ALL PROPOSED COMPONENTS FOR REVIEW.


**RELIEF FAN SEQUENCE** **2**  
SCALE: NTS **ADD ALTERNATE #10** M3.1

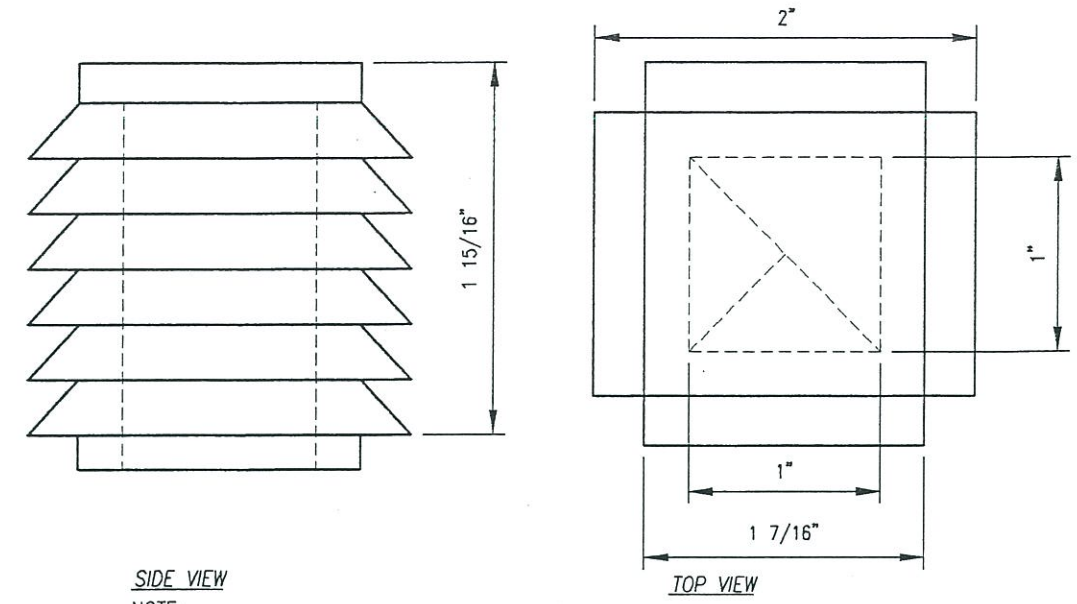


SIDE VIEW

NOTE:  
RELIEF VENTILATOR TO BE COOK MODEL 12X12X6TRE, WITH MANUFACTURERS RECOMMENDED ROOF CURB.

**RELIEF VENTILATOR DETAIL** **1**  
SCALE: NTS M3.1

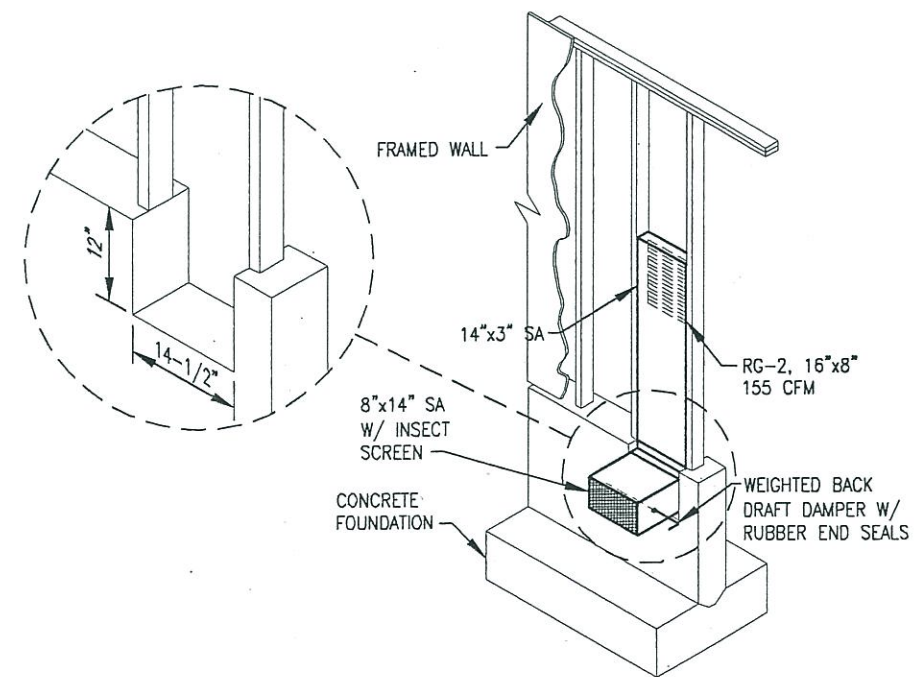

**CRAWL SPACE RELIEF DUCT** **4**  
SCALE: NTS M3.1

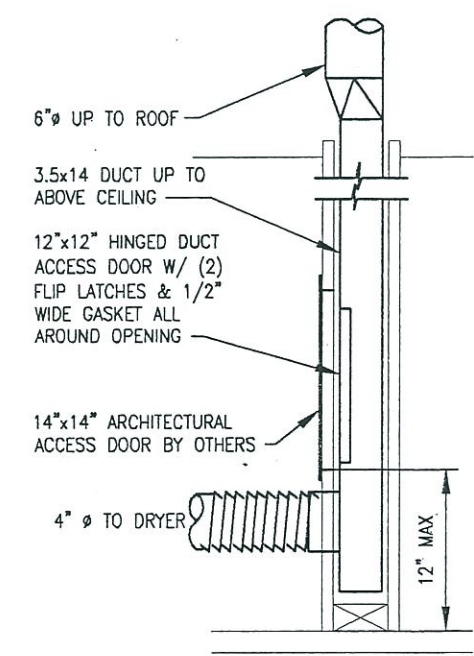

**DRYER CONNECTION** **3**  
SCALE: NTS M3.1



Medical Design Group  
Architecture for Health Care

2716 WESTLAND PLACE  
BOISE, IDAHO 83704-5863  
BOISEARCHITECT@AOL.COM  
Fax (208) 378-1405  
Phone (208) 378-0817

© COPYRIGHT: MEDICAL DESIGN GROUP

HVAC DETAILS

Desert Sage Health Care  
2280 American Legion Blvd.  
Mountain Home, Idaho


SHEET  
M3.1

March 2004

S:\Projects\03MDG002\Drawings\03MDG002M31.dwg, 3/15/2004 4:11:55:51 AM, thompson, ANSI B (11.00 x 17.00 inches), 1:1



S:\Projects\03MDG002\DesertSageHealth\Drawings\03MDG002M41.dwg, 3/15/2004, 11:55:44 AM, thompson, ANS, B (11.00 x 17.00 inches), 141

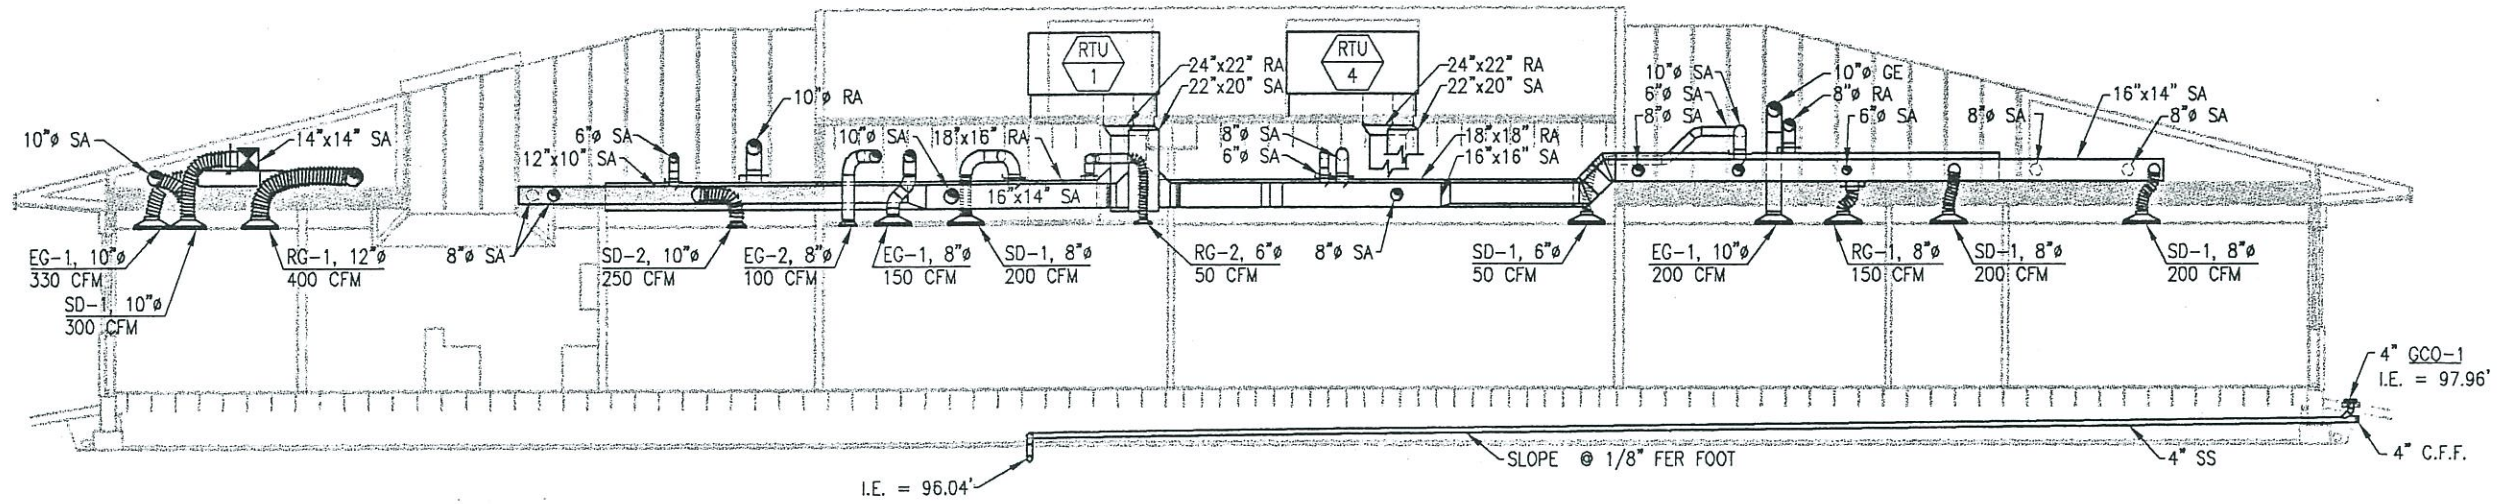


# MECHANICAL BUILDING SECTION A-A

SCALE: 3/16" = 1'-0" (HALF SIZE: 3/32" = 1'-0")

M4.1




	<b>Medical Design Group</b> Architecture for Health Care 2716 WESTLAND PLACE BOISE, IDAHO 83704-5863 BOISEARCHITECT@AOL.COM Fax (208) 378-1405 Phone (208) 378-0817	
	© COPYRIGHT: MEDICAL DESIGN GROUP	
	<b>MECH. BUILDING SECTIONS</b>	
	Desert Sage Health Care 2280 American Legion Blvd. Mountain Home, Idaho	SHEET <b>M4.1</b>
March 2004		

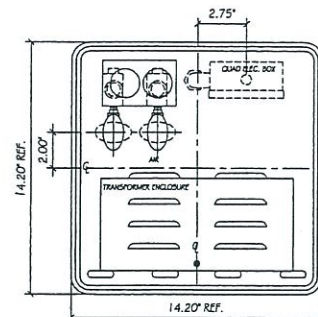


**GENERAL NOTES**  
 This drawing is for informational purposes only. Consult actual Pelton 4 Crane template before installing equipment. Local regulations provide the licensed plumbers and electricians shall install devices. Make sure all plumbing conforms to providing local codes.  
 AIR: 1/2" pipe N.P.T. protruding 1" from floor or wall. Supplied by contractor. Manual shut-off valve supplied and installed by contractor. Air pressure 60-100 P.S.I. Air plumbing should be tested clean before making final connections to dental equipment.  
 ELECTRICAL: 1/2" conduit and box with equal or equal receptacle supplied by contractor. Wire box as per code with top of the box no higher than 4 1/2" above finished floor. Voltage: 110 volts 3 wire.  
 NOTE: Place trap in line and use vented fitting to conform with local codes. Supplied by contractor. Floor mounting only.

**D-2A PELTON UTILITY J-BOX**  
 NOT TO SCALE

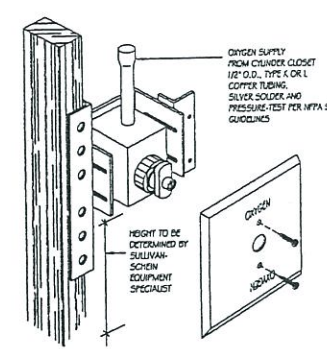


OXYGEN SUPPLY FROM CLOSET 1/2" O.D. TYPE 6 OR L COPPER TUBING, SILVER SOLDER AND PRESSURE TEST PER NFPA 99 GUIDELINES  
 HEIGHT TO BE DETERMINED BY SULLIVAN-SCHEN EQUIPMENT SPECIALIST  
 THIS IS A TYPICAL OUTLET. REFER TO MANUFACTURER'S INSTALLATION LITERATURE FOR EXACT REQUIREMENTS.  
 REVIEW NFPA 99, CHAPTER 4 FOR OXYGEN PIPING GUIDELINES. CONSULT LOCAL FIRE CODES BEFORE INSTALLATION.

**D-7A OXYGEN OUTLET**  
 NOT TO SCALE

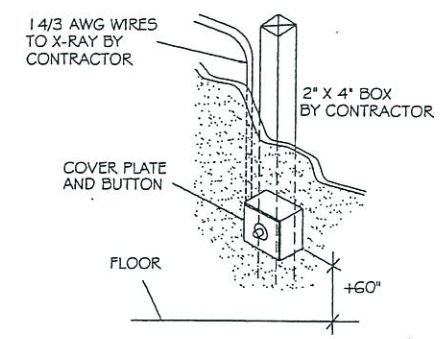


PROVIDED BY SULLIVAN-SCHEN; INSTALLED BY ELECTRICIAN

**D-9D X-RAY REMOTE SWITCH**  
 NOT TO SCALE

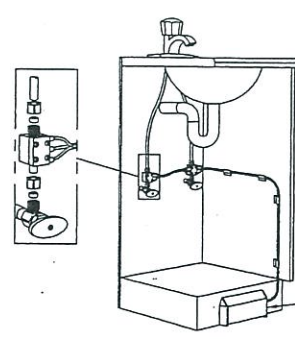


**TYPICAL INSTALLATION (MODEL 1750)**  
 VALVE BLOCKS CONNECT IN-LINE ON HOT AND COLD WATER SUPPLIES WITH 3/8" COMPRESSION FITTINGS. KICK PEDAL MOUNTS ON CABINET TOE KICK WITH CONTROL TUBING ROUTED IN BETWEEN.  
 VALVE BLOCKS MAY BE CONNECTED ALONG MIDPOINT OF 3/8" SUPPLY TUBING. IF THIS OPTION IS CHOSEN, USE A 3/8" X 3/8" COMPRESSION CONNECTOR TO CONNECT THE INLET FITTING TO THE WATER LINES.  
 SEE MANUFACTURER'S INSTALLATION TEMPLATE FOR MOUNTING PEDAL.

**D-12B TAPMASTER FAUCET CONTROL**  
 NOT TO SCALE

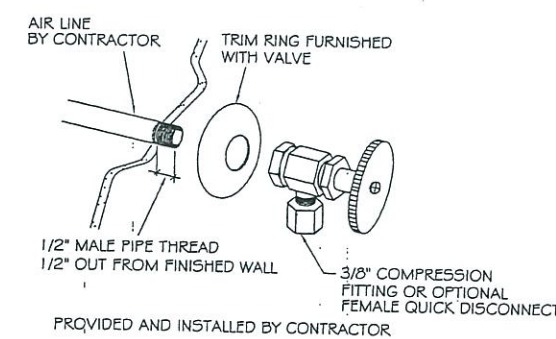


PROVIDED AND INSTALLED BY CONTRACTOR.

**D-13 AIR VALVE**  
 NOT TO SCALE

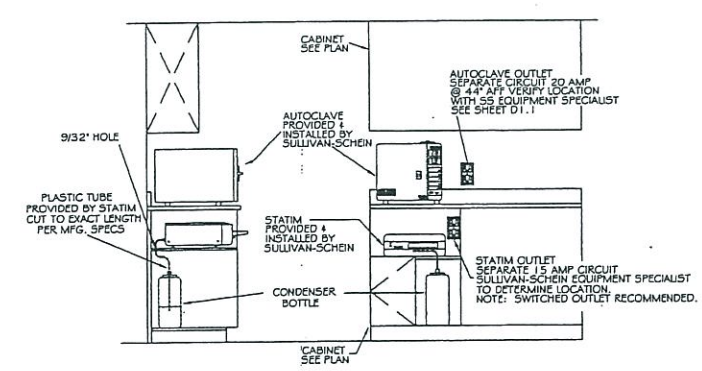


**D-14A AUTOCLAVE & STATIM OUTLETS**  
 NOT TO SCALE

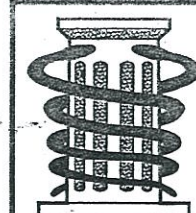

**Medical Design Group**  
 Architecture for Health Care  
 2716 WESTLAND PLACE  
 BOISE, IDAHO 83704-5863  
 BOISEARCHITECT@AOL.COM  
 Fax (208) 378-1405  
 Phone (208) 378-0817


© COPYRIGHT: MEDICAL DESIGN GROUP

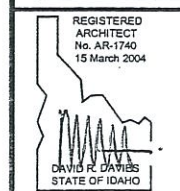


**DENTAL DETAILS**

Desert Sage Health Center SHEET  
 2280 American Legion Blvd.  
 Mountain Home, Idaho D 1.0


Feb 2004 D 1.0.dwg 03/15/04 13:24

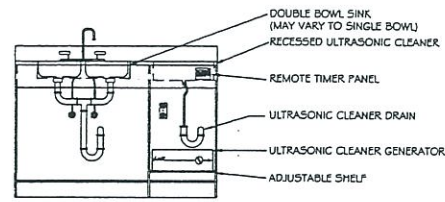


D-15 ULTRASONIC CLEANER  
NOT TO SCALE

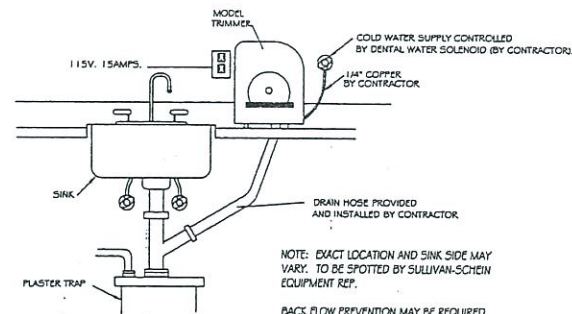


D-16 MODEL TRIMMER  
NOT TO SCALE

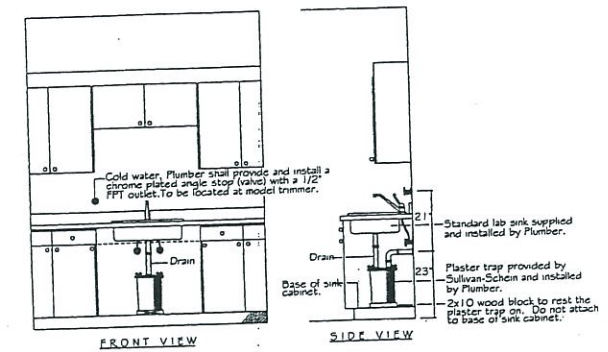


D-17 PLASTER TRAP  
NOT TO SCALE

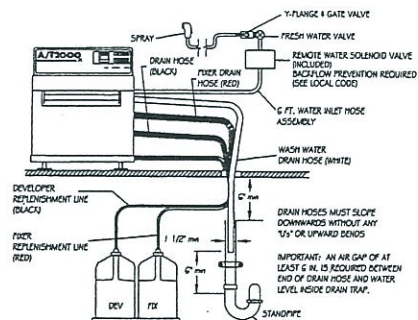


D-20 AUTOMATIC FILM PROCESSOR  
NOT TO SCALE

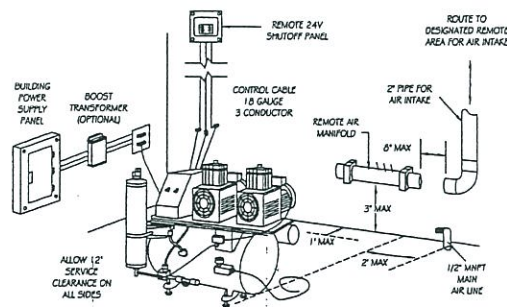

D-25 AIRSTAR COMPRESSOR  
NOT TO SCALE

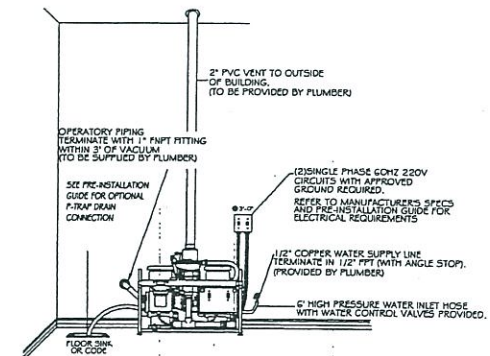

D-26B VACSTAR - DUAL 220V  
NOT TO SCALE

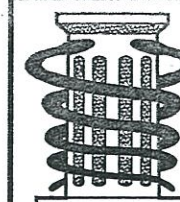

Medical Design Group  
Architecture for Health Care

2716 WESTLAND PLACE  
BOISE, IDAHO 83704-5863

BOISEARCHITECT@AOL.COM  
Fax (208) 378-1405  
Phone (208) 378-0817

© COPYRIGHT: MEDICAL DESIGN GROUP

REGISTERED  
ARCHITECT  
No. AR-1740  
15 March 2004  
DAVID R. DAVIES  
STATE OF IDAHO


DENTAL DETAILS

Desert Sage Health Center  
2280 American Legion Blvd.  
Mountain Home, Idaho

SHEET


D 1.1

Feb 2004 D 1.1.dwg 03/15/04 13:25

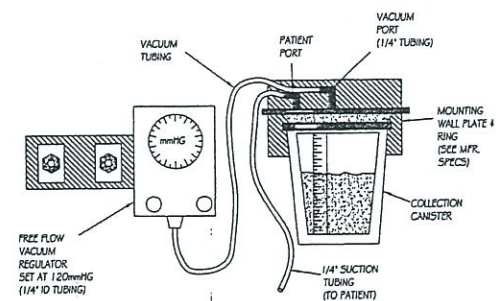


TYPICAL COLLECTION UNIT - REFER TO MANUFACTURER'S INSTALLATION DATA FOR EXACT MECHANICAL REQUIREMENTS


D-28A SURGICAL VACUUM INLET  
NOT TO SCALE

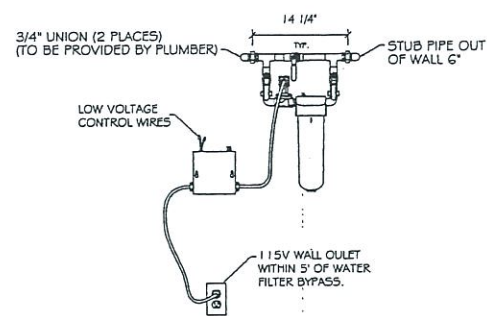


D-30A MASTER WATER SHUT OFF VALVE WITH FILTER  
NOT TO SCALE

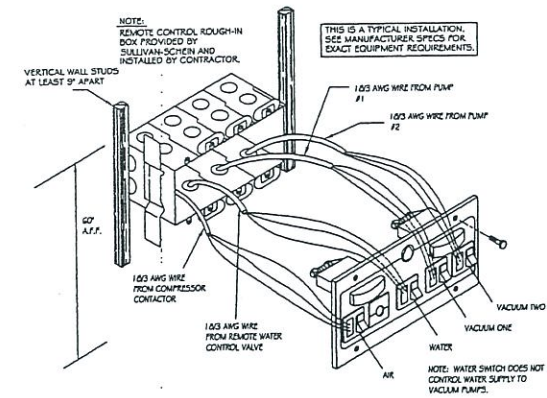

D-32A REMOTE CONTROL PANEL  
NOT TO SCALE

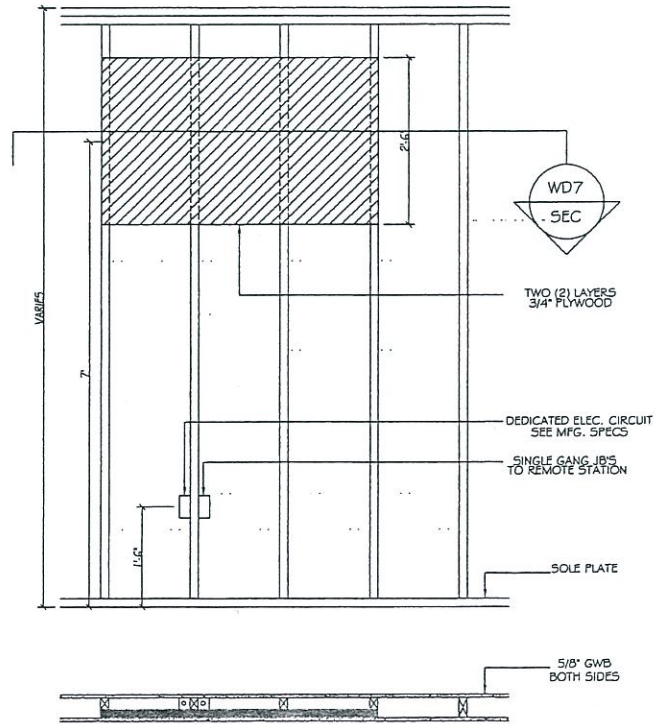


WD7 TYP PANORAMIC BLOCKING  
SCALE: 3/4" = 1'-0"

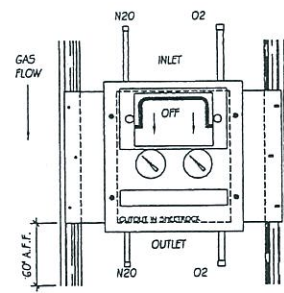

THIS IS A TYPICAL UNIT. REFER TO MANUFACTURER'S INSTALLATION LITERATURE FOR EXACT REQUIREMENTS.


ZONE CUT-OFF VALVE IS SPECIFIED IN THIS OFFICE PER NFPA 99 (4-5.1.2.11(b)). CONSULT LOCAL FIRE CODES BEFORE INSTALLATION.

D-34A ZONE CUT-OFF VALVE  
NOT TO SCALE

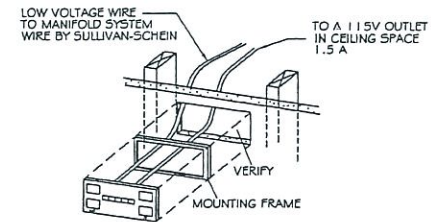

PROVIDED BY SULLIVAN-SCHIEIN AND INSTALLED BY CONTRACTOR

D-34 N2O-O2 ALARM PANEL  
NOT TO SCALE

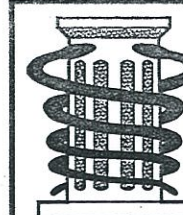

Medical Design Group  
Architecture for Health Care

2716 WESTLAND PLACE  
BOISE, IDAHO 83704-5863

BOISEARCHITECT@AOL.COM  
Fax (208) 378-1405  
Phone (208) 378-0817

© COPYRIGHT: MEDICAL DESIGN GROUP




DENTAL DETAILS

Desert Sage Health Center  
2280 American Legion Blvd.  
Mountain Home, Idaho

SHEET

D 1.2

Feb 2004 D 1.2.dwg 03/15/04 13:25

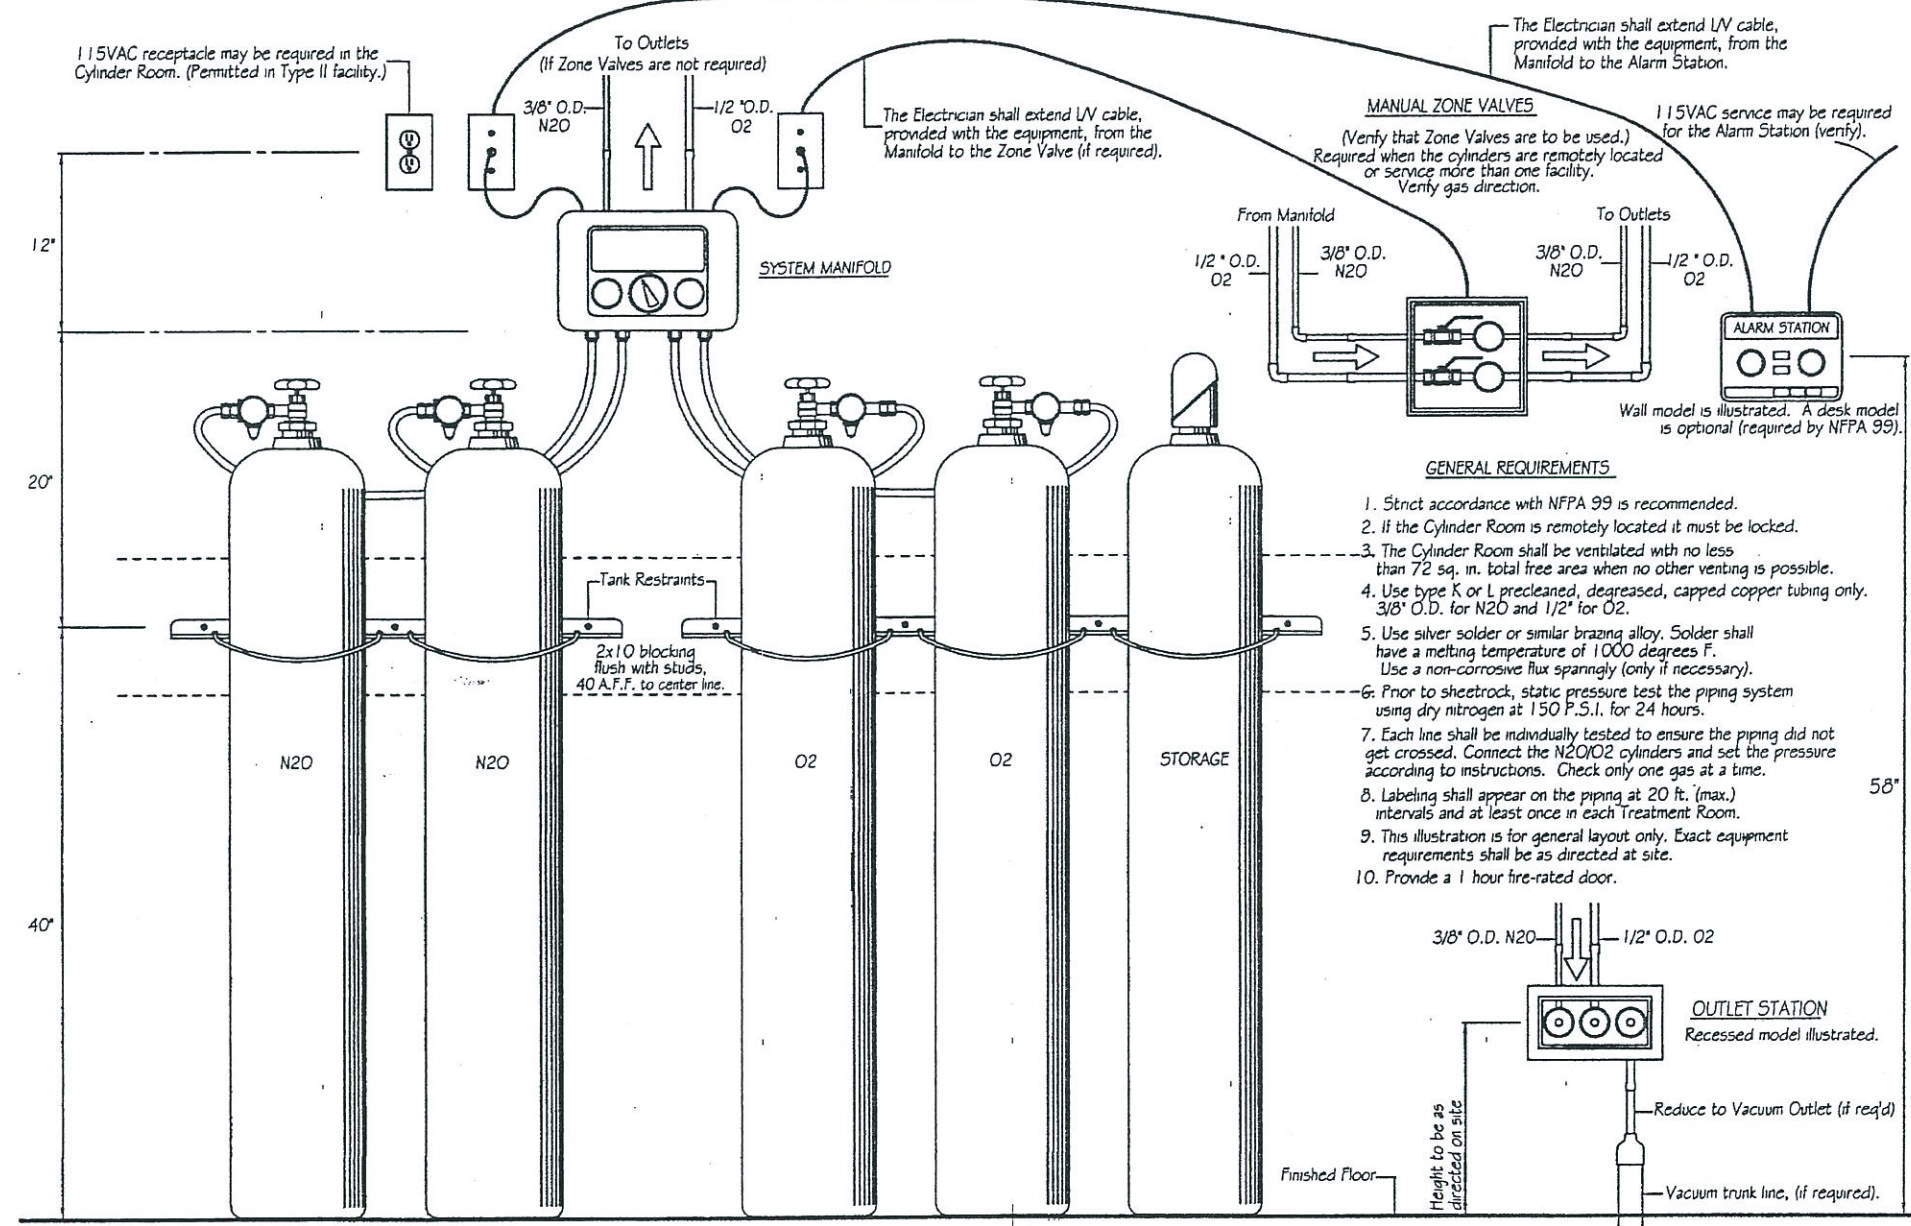

- GENERAL REQUIREMENTS**
1. Strict accordance with NFPA 99 is recommended.
  2. If the Cylinder Room is remotely located it must be locked.
  3. The Cylinder Room shall be ventilated with no less than 72 sq. in. total free area when no other venting is possible.
  4. Use type K or L precleaned, degreased, capped copper tubing only. 3/8" O.D. for N2O and 1/2" for O2.
  5. Use silver solder or similar brazing alloy. Solder shall have a melting temperature of 1000 degrees F. Use a non-corrosive flux sparingly (only if necessary).
  6. Prior to sheetrock, static pressure test the piping system using dry nitrogen at 150 P.S.I. for 24 hours.
  7. Each line shall be individually tested to ensure the piping did not get crossed. Connect the N2O/O2 cylinders and set the pressure according to instructions. Check only one gas at a time.
  8. Labeling shall appear on the piping at 20 ft. (max.) intervals and at least once in each Treatment Room.
  9. This illustration is for general layout only. Exact equipment requirements shall be as directed at site.
  10. Provide a 1 hour fire-rated door.

**CYLINDER ROOM**  
 Type II Facility  
 with less than 2000 cu. ft. gas (including storage, excluding nitrogen).

**NITROUS OXIDE AND OXYGEN TANK ROOM DETAIL**



**Medical Design Group**  
 Architecture for Health Care  
 2716 WESTLAND PLACE  
 BOISE, IDAHO 83704-5863  
 BOISEARCHITECT@AOL.COM  
 Fax (208) 378-1405  
 Phone (208) 378-0817  
 © COPYRIGHT: MEDICAL DESIGN GROUP

REGISTERED ARCHITECT  
 No. AR-1740  
 15 March 2004

**DENTAL DETAILS**

Desert Sage Health Center  
 2280 American Legion Blvd.  
 Mountain Home, Idaho

SHEET  
**D 1.3**

Feb 2004 D 1.3.dwg 03/15/04 13:26

c:\Program Files\Autocad Architectural 2\TEMPLATE\mldg.dwt March 2003

## ELECT. SYMBOL SCHEDULE

	FLUORESCENT FIXTURE (TYPICAL)
	FLUOR. FIXTURE EQUIPPED WITH AN EMERGENCY BATTERY BALLAST TO POWER ONE LAMP UPON POWER FAILURE.
	UNSWITCHED NIGHT LIGHT
	EXIT LIGHT (DIRECTIONAL ARROWS ON DRAWINGS)
	CEILING MOUNTED FIXTURE
	WALL MOUNTED FIXTURE
	RECESSED CAN TYPE FIXTURE
	EMERGENCY LIGHT WALL OR CLG. MT.
	SINGLE POLE SWITCH
	3-WAY SWITCH
	4-WAY SWITCH
	EXHAUST FAN TIMER SWITCH (0 - 30 MIN)
	THERMAL OVERLOAD SWITCH W/PILOT LIGHT
	FLUOR. DIMMER SWITCH. SEE FIXT. NOTE 2
	PHOTOELECTRIC CELL/SWITCH
	JUNCTION BOX
	DUPLEX RECEPTACLE (WP=WTHRPRF, GFI=GRND FLT)
	DUPLEX RECEPTACLE (S = SAFETY TYPE OUTLET) SUCH AS P&S "TR" SERIES TAMPER RESISTANT
	DOUBLE DUPLEX OUTLET
	DOOR PUSHBUTTON OR CONTROLLER
	SAME AS  EXCEPT RED W/RED COVER DISCONNECT SWITCH (F=FUSED DISCONNECT)
	MAIN OR BRANCH PANELBOARD
	TELEPHONE / DATA BOARD
	BRANCH CIRCUIT - CONCEALED
	BRANCH CIRCUIT - IN FLOOR OR UNDERGROUND
	BRANCH CIRCUIT - HOME-RUN TO PANEL
	DRAWING NOTE (ON THE SHEET WHERE SHOWN)
	MECHANICAL EQUIPMENT OR DETAIL SYMBOL
	TIME CLOCK SWITCH
	THERMOSTAT W/ 3/4" C. TO MECH. UNIT.*
	CROSS LINES SHOW # OF COND'S. IF MORE THAN 2 GREEN GROUND CONDUCTOR AND ISOLATED GROUND CONDUCTOR NOT SHOWN.
	FAN MOTOR CONNECTION POINT
	MOTOR CONNECTION POINT
	VOICE & OR DATA OUTLET 4" SQ. DEEP BOX WITH 1" CONDUIT BACK TO MAIN TELEPHONE BACKBD. UNLESS INDIC. OTHERWISE SEE DETAIL, SHT. E4.1
	SMOKE DAMPER BY MECH. 120 VOLT

\* SEE MECHANICAL DRAWINGS FOR CONDUIT DESTINATION.

### FIXTURE NOTES:

- 1 PROVIDE WITH ALL NECESSARY TRAC SYSTEM ACCESSORIES, SUCH AS LIVE FEED ENDS, DEAD ENDS, CANOPIES, MOUNTING CLIPS, ETC., TO MAKE A COMPLETE SYSTEM. COMPONENT COLORS TO BE SELECTED BY ARCHITECT.
- 2 ALL F2A FIXTURES TO BE SUPPLIED WITH A LUTRON DIMMING BALLAST #FDB-4821-120-3. PROVIDE WITH CORRESPONDING DIMMER SWITCH LUTRON #NTF-10 (COLOR BY ARCH.)
- 3 STANDARD FINISH / COLOR TO BE SELECTED BY ARCHITECT.
- 4 FIXTURE TO BE SET BACK FROM BASE OF POLE APPROX. 4'-0. OR AS PER MFG'S. RECOMMENDATIONS.

## GENERAL NOTES: (ALL SHEETS)


- 1 ELECTRICAL CONTRACTOR SHALL COORDINATE ALL LAMP TYPES WITH FIXTURE TYPE BEFORE ORDERING.  
ELECTRICAL CONTRACTOR SHALL REFER TO THE MECHANICAL DRAWINGS FOR EXACT LOCATION OF ALL MECHANICAL EQUIPMENT AND ELECTRICAL CONNECTIONS.
- 2 ELECTRICAL CONTRACTOR SHALL PROVIDE MINIMUM WORKING CLEARANCE AS PER NEC BEFORE INSTALLING ANY ELECTRIC PANELS OR CABINETS.
- 3 INSTALL ALL LIGHT FIXTURES IN MECHANICAL ROOM AFTER THE MECHANICAL EQUIPMENT IS IN PLACE.
- 4 REFER TO ARCHITECTURAL REFLECTED CEILING PLAN FOR EXACT FIXTURE LOCATION.
- 5 ALL FLUORESCENT FIXTURES SHALL BE SUPPLIED WITH T8 (35K) LAMPS AND ELECTRONIC BALLASTS WITH -20% THD.
- 6 ELECTRICAL CONTRACTOR SHALL PROVIDE ALL CONCRETE PADS AS REQUIRED ON ALL ELECTRICAL EQUIPMENT.
- 7 CONFIRM EXACT LOCATIONS OF ALL TELEPHONE OUTLETS WITH OWNER PRIOR TO ROUGH-IN.
- 8 ELECTRICAL CONTRACTOR SHALL MOUNT SWITCHES AT 48" AND MOUNT CONVENIENCE OUTLETS AT 18" OR AS SHOWN ON PLANS TO MEET HANDICAPPED REQUIREMENTS.
- 9 ALL ACRYLIC LENSES USED ON THIS PROJECT, TO BE A MINIMUM OF .125" THICK.
- 10 LOCATE SWITCHES, OUTLETS, ETC., SHOWN AT ROOM ENTRY DOORWAYS, AS CLOSE TO DOOR FRAME AS POSSIBLE, SO AS NOT TO INTERFERE WITH ROOM CABINETS, ETC.
- 11 SUPPORT ALL LIGHT FIXTURES INDEPENDENT OF CEILING.
- 12 E.C. SHALL OBTAIN ALL APPLICABLE PERMITS FOR THIS WORK AND PAY ASSOCIATED FEES.
- 13 MAINTAIN 24" MIN. CLEARANCE FROM ALL COMM. CABLES AND ELECTRONIC BALLASTS.
- 14 INSTALL A GREEN GROUND CONDUCTOR IN ALL RACEWAYS. CONDUIT GROUND IS NOT ACCEPTABLE.

## LIGHT FIXTURE SCHEDULE

TYPE	DESCRIPTION	MOUNT	VOLT	LAMPS	MFGR.	CATALOG #	NOTES
F1	2x4 2-LAMP LAY-IN GRID TROFFER - PRISMATIC LENS	RECESSED	120	2-F32T8/SPX35	LITHONIA METALUX	25P8 6232 RW A12125 120 GEB 26PXR-232A125-120-EB81-WDF	
F2 F2A	2x4 3-LAMP LAY-IN GRID TROFFER - PRISMATIC LENS SAME AS F2 - W DIMMING BALLAST	RECESSED	120	3-F32T8/SPX35	LITHONIA METALUX	25P8 6332 RW A12125 120 GEB 26PXR-332A125-120-EB81-WDF	2
F3	2x4 4-LAMP LAY-IN GRID TROFFER - PRISMATIC LENS	RECESSED	120	4-F32T8/SPX35	LITHONIA METALUX	25P8 6432 RW A12125 120 GEB 26PXR-432A125-120-EB81-WDF	
F4	1x4 2-LAMP SURFACE WRAP LENS	SURFACE	120	2-F32T8/SPX35	LITHONIA METALUX	LB 232 120 GEB W5-232A-120-EB81	
F5	4' 2-LAMP OPEN STRIP LIGHT	SURFACE OR COVE	120	2-F32T8/SPX35	LITHONIA METALUX	C232 120 GEB S5-232-120-EB81	
F6	INTERIOR DECORATIVE WALL SCENCE	WALL @ 7'-6 UNLESS NOTED	120	1-26 DTT OR 2-13 DTT	LITHONIA SHAPER	AVSP 1 26DTT MDR 120 ALB M662-CF2/13-120-SC-PMR/MW	
F7	EXTERIOR DECORATIVE COMP FLUOR. WALL MOUNT	WALL @ 8'-0	120	2-F26 CF	ADVENT	AEW1030 2F26 120	3
F8	EMERG. W/BATTERY LED EXIT LT. (SINGLE FACE)	WALL @ 7'-6 OR CLG.	120	INCLUDED	LITHONIA SURELITES	LES WIG 120/271 ELN CX-7170-6W	
F9	EXTERIOR RECESS SOFFIT CAN LT. MH HID (NO LENS)	RECESSED	120	1-MXR100/MED/O (OPEN RATED LAMP)	LITHONIA PORTFOLIO	AH-100M TWRLD-120 MDT-740-T750 WH	
F10	4' 1-LAMP UNDER COUNTER	UNDER OVER-HEAD CABINET	120	1-F32T8/SPX35	ALKCO FAILSAFE	SF332/WLAMP MTS-32-120V 1K12-EB81	
F11	INTERIOR RECESS CAN (COMP. FLUOR.) W/LOW IRR. REFLECTOR (HORIZ. LAMP)	RECESSED	120	1-F26DBXT4/SPX35	LITHONIA PORTFOLIO	AF 126DTT 8AR LD 120 C7132 E7151STRM7-P	
F12	INTERIOR RECESS INCAND. CAN LIGHT ON DIMMER SW.	RECESSED	120	1-75 WATT A19	LITHONIA PORTFOLIO	A6AR WR LD	
F13 F13A	LINEAR FLUOR. DIRECT/INDIRECT CABLE SUSPENSION SYSTEM (2-LAMPS IN CROSS SECTION) SAME AS F13 EXCEPT 3-LAMPS IN CROSS SECTION	PENDANT 18" FROM CLG.	120	2-F32T8/SPX35 (IN CROSS SECTION) 3-F32T8/SPX35 (IN CROSS SECTION)	NEORAY	IT1P 2T8 185C 16' 120	
F14	LOW VOLT TRAC SYSTEM (QUANT. OF HEADS SHOWN)	CEILING	120/ 24	PAR 38 50W (FOR EACH HEAD)	LITHONIA	L.V TRAC - LT* (CBA) HEAD(S) - LPHR (BLWS) (CBA)	1
F15	2x4 2-LAMP RECESS LAY-IN INDIRECT W/ SIDE PURF BASKETS	RECESSED	120	2-F32T8/SPX35	LITHONIA	2AV 6232 MDR SMD 120 GEB	
F16	PORCELAIN SOCKET	CEILING	120	1-75 WATT A19	GEN. ELECT.	GE 5740-7	
F17	FLUSH IN GROUND FLAG POLE LIGHT	FLUSH IN GROUND	120	1-175 MH	GREENLEE	RDS-100MH-120-SPV	4

## ELECTRICAL SHEET SCHEDULE


- 16.00 NOTES AND SCHEDULES
- 16.01 ELECTRICAL SITE PLAN
- 16.10 FLOOR PLAN - LIGHTING
- 16.20 FLOOR PLAN - POWER
- 16.21 POWER RISER, SCHED'S.
- 16.22 ELECTRICAL PANEL SCHED'S.
- 16.23 DENTAL EQUIP. CONN. PLAN
- 16.30 ELECTRICAL DETAILS
- 16.40 ELECTRICAL SPECIFICATIONS
- 16.41 LIGHTING COM-CHECK REPORT

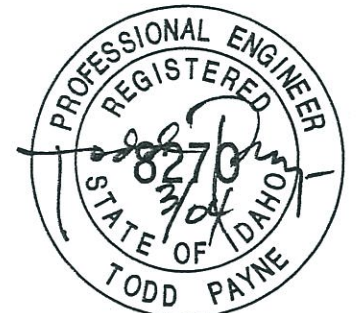

PROJ. NO. 0353

**PAYNE**  
Engineering Inc.  
Consulting Engineers

1823 E. Center  
Pocatello, Idaho 83201  
tel (208) 232-4439 fax (208) 232-1435

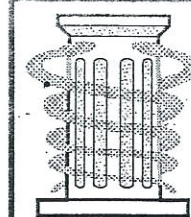

Medical Design Group  
Architecture for Health Care  
2716 WESTLAND PLACE  
BOISE, IDAHO 83704-5863  
BOISEARCHITECT@AOL.COM  
Fax (208) 378-1405  
Phone (208) 378-0817

© COPYRIGHT: MEDICAL DESIGN GROUP

### NOTES & SCHEDULES

Desert Sage Health Center  
2280 American Legion Blvd.  
Mountain Home, Idaho

SHEET  
16.00

March 2004


*Parking Lot Lights*

### KEY NOTES

- ① APPROXIMATE LOCATION OF NEW MAIN TELEPHONE BOARD. 4'x8'x3/4" PLYWOOD PROVIDE BLDG. GROUND AS PER TELEPHONE CO.
- ② APPROXIMATE LOCATION OF MAIN PANEL-"M". SEE SHEET 16.20 FOR ACTUAL LOCATION.
- ③ PROVIDE AND INSTALL A 4" PVC SCH. 40 CONDUIT WITH NYLON FULL CORD FROM GUEST TELEPHONE ENCLOSURE TO MAIN TELEPHONE BOARD. FIELD VERIFY EXACT ROUTING WITH GENERAL CONTRACTOR AND GUEST. LIMIT THE NUMBER OF BENDS, AND ALL BENDS TO BE SWEEP TYPE BENDS.
- ④ UNDERGROUND SECONDARY ELECTRICAL FEEDER BY ELECT. CONTR. SEE POWER RISER, SHEET 16.21 FOR SIZE, ETC. EXACT ROUTING, TO BE FIELD DETERMINED.
- ⑤ PRIMARY UNDERGROUND ELECTRICAL SERVICE, BY POWER CO. COORDINATE WITH POWER CO. THE EXACT ROUTING, ETC. ELECTRICAL CONTR. SHALL INCLUDE A \$5000.00 CASH ALLOWANCE IN HIS BID FOR UTILITY CO. CHARGES / FEES. ANY AMOUNT NOT USED, SHALL BE REFUNDED TO THE OWNER. THIS CASH ALLOWANCE IS FOR UTILITY CHARGES ONLY. ALL OTHER SERVICE RELATED EQUIPMENT & INSTALLATION IS SEPARATE.
- Alt # ⑥ IN GROUND FLAG POLE LIGHT. LOCATE AT BASE OF POLE AS PER MANUFACTURERS RECOMMENDATIONS. CONNECT INTO OUTSIDE BUILDING LIGHT CIRCUIT B-3. SEE SHT. 16.10.
- ⑦ 1" conduit w/ pull chord for future monument sign. Cap and mark.

### SPECIAL NOTE:

These plans have been prepared without utility company comments. The contractor shall verify the exact requirements for the electric and telephone services with the utility company representatives and provide all work and pay all costs for complete and operating systems, as directed by the governing utilities.

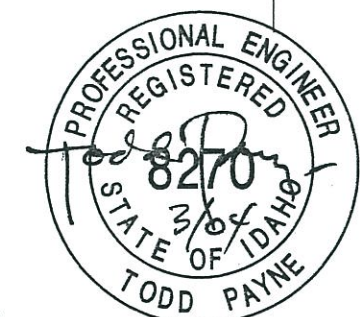

PROJ. NO. 0353

UTILITY CONTACTS	
<b>POWER CO.</b>	
IDAHO POWER CO. 2430 AMERICAL LEGION BLVD. MOUNTAIN HOME, ID 83647 PH. NO. 208-388-2408 ATTN: MARK SCHOOLER	
<b>TELEPHONE CO.</b>	
GUEST COMM. 1315 WEST AMITY RD. BOISE, ID 83705 PH. NO. 208-385-2144 ATTN: GEORGE CRAWFORD	

**PAYNE**  
Engineering Inc. Consulting Engineers

1823 E. Center  
Pocatello, Idaho 83201  
tel (208) 232-4439 fax (208) 232-1435

**Medical Design Group**  
Architecture for Health Care

2716 WESTLAND PLACE  
BOISE, IDAHO 83704-5863

BOISEARCHITECT@AOL.COM  
Fax (208) 378-1405  
Phone (208) 378-0817


© COPYRIGHT: MEDICAL DESIGN GROUP

**ELECT. SITE PLAN**

Desert Sage Health Center  
2280 American Legion Blvd.  
Mountain Home, Idaho

SHEET 16.01

March 2004

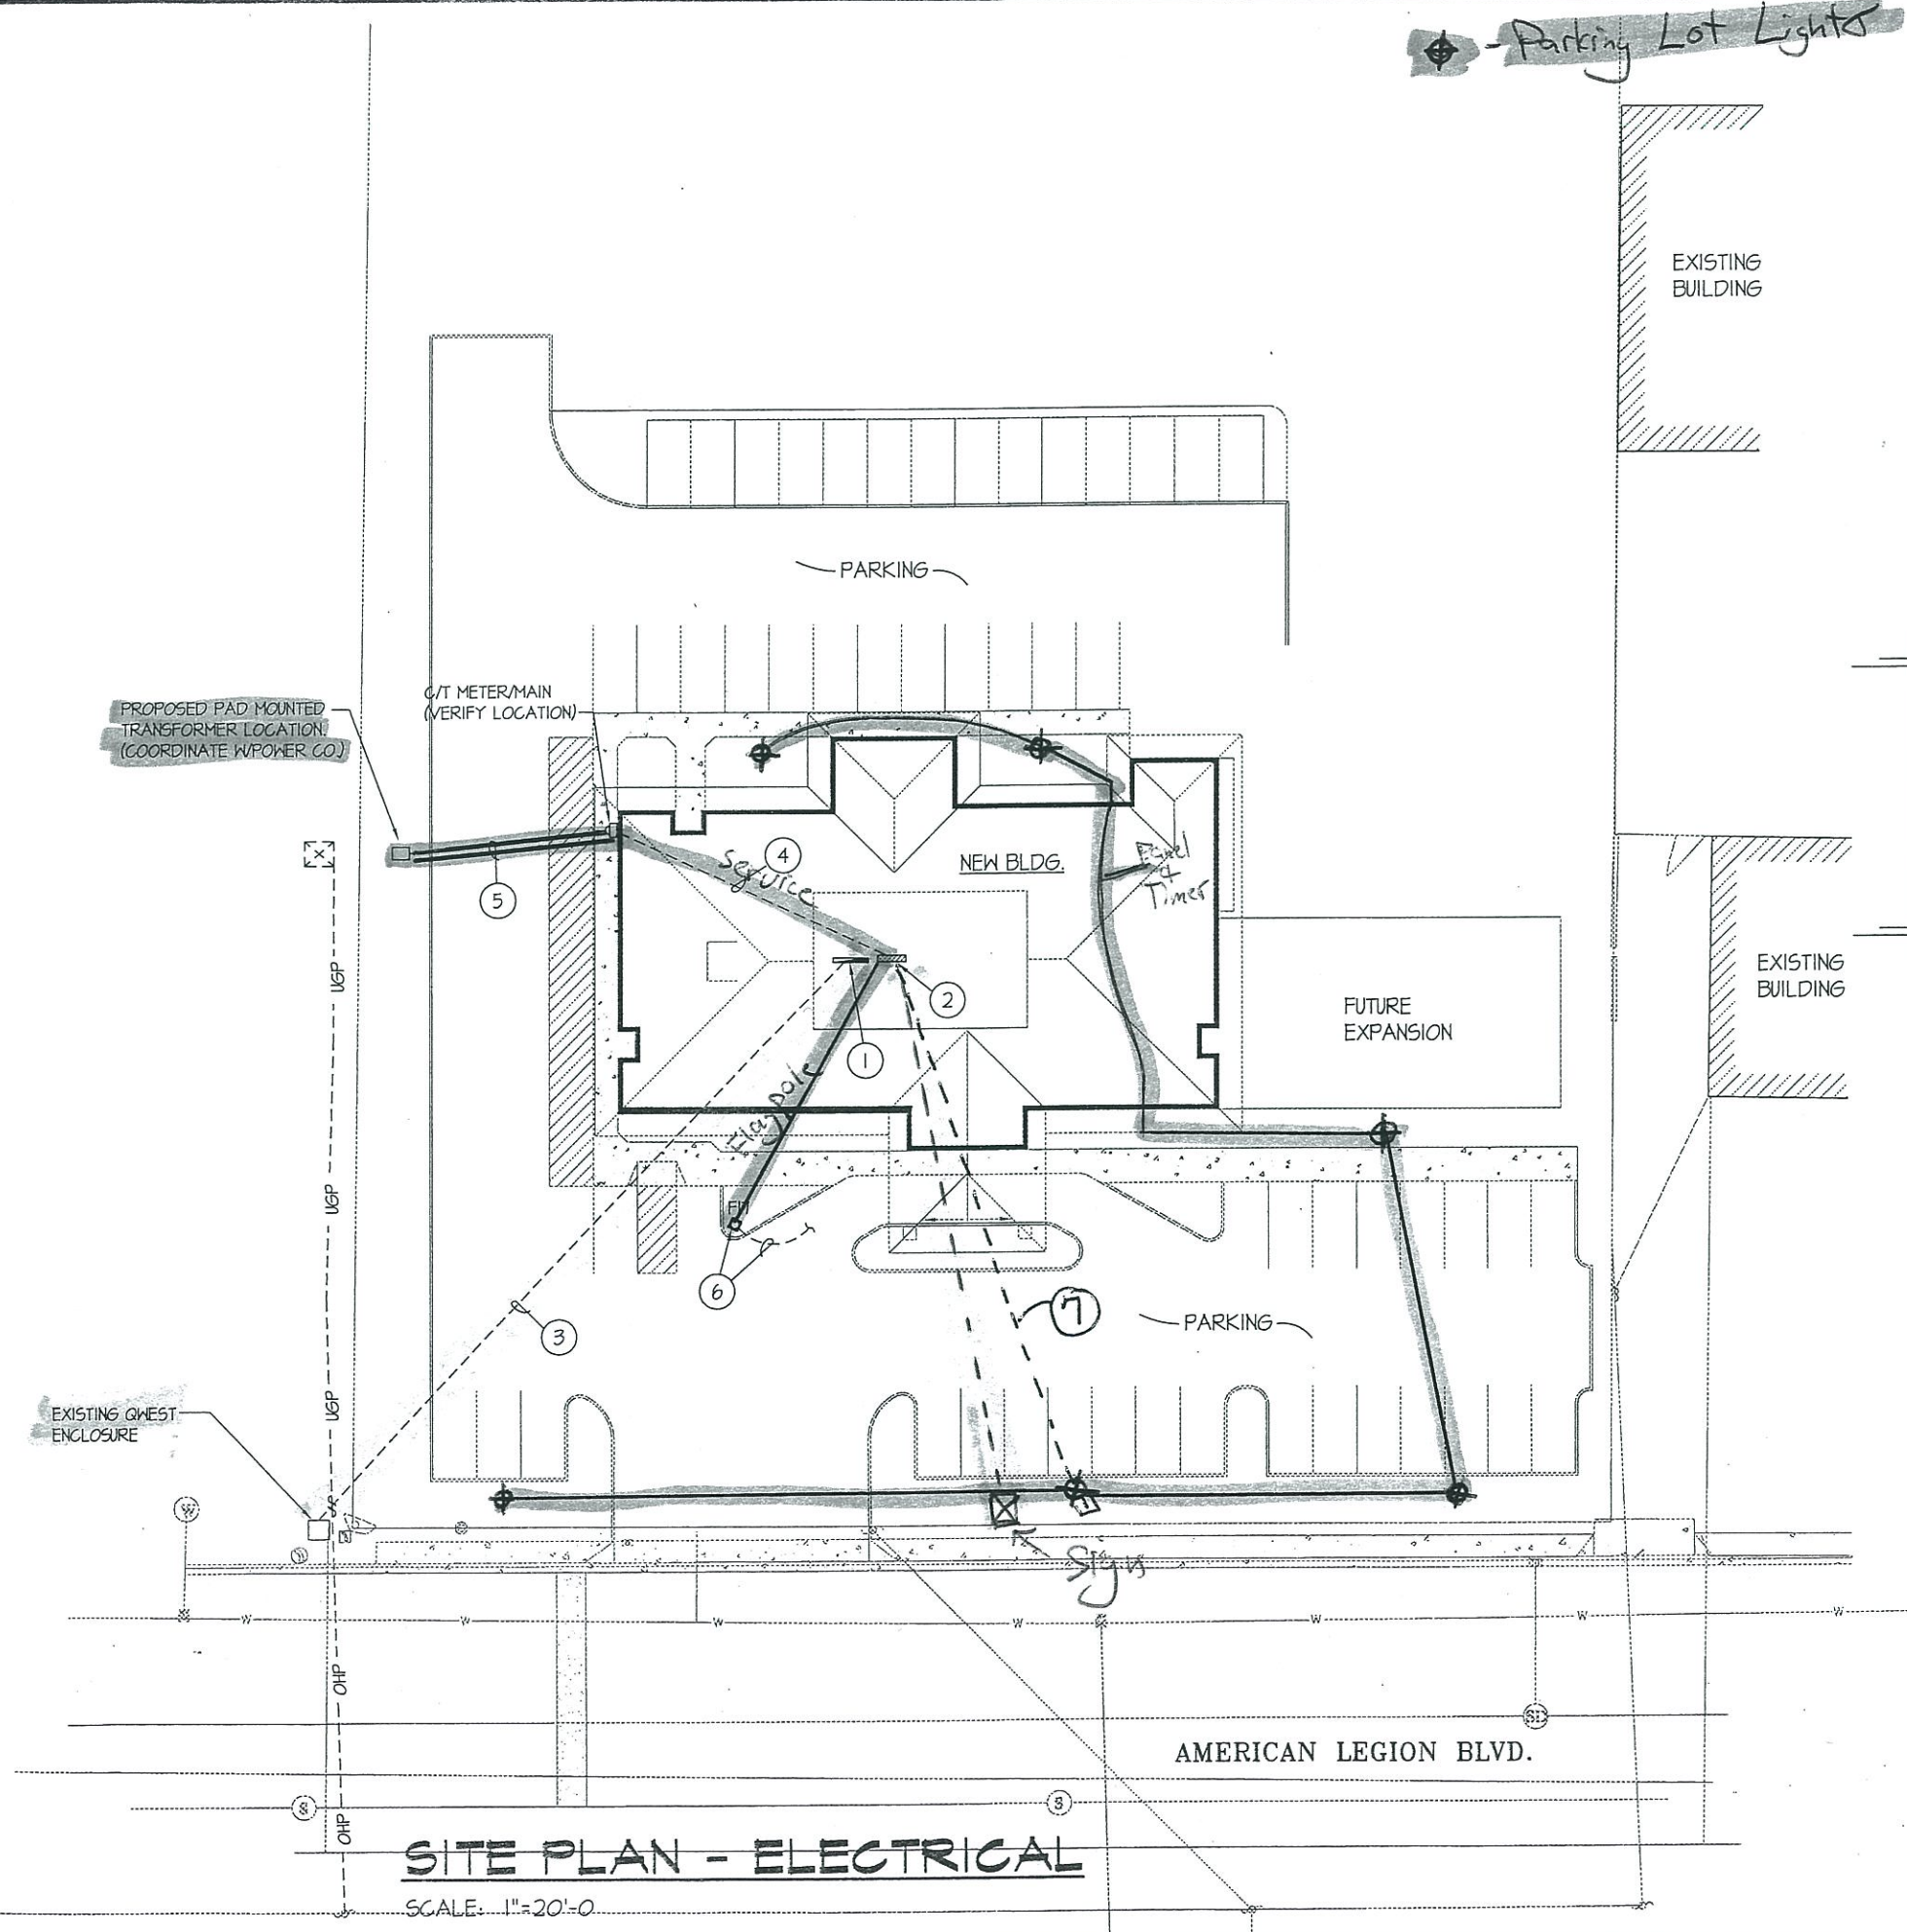


## SITE PLAN - ELECTRICAL

SCALE: 1"=20'-0"

# KEY NOTES


- 1 CONTROL THE LIGHTING IN THIS AREA SO THAT ONE SWITCH CONTROLS THE CENTER LAMP IN EACH FIXTURE AND THE OTHER SWITCH, CONTROLS THE TWO OUTBOARD LAMPS IN EACH FIXTURE. ALL ROOM LIGHTING CONTROL TO COMPLY WITH IECC LIGHTING COMPLIANCE CODE
- 2 MOUNT ON WALL ABOVE DOOR HEADER.
- 3 CIRCUIT OUTSIDE LIGHTING VIA TIME CLOCK / PHOTO-CELL CONTROL. LOCATE PHOTO-CELL OUTSIDE ON BUILDING SO AS NOT TO BE AFFECTED BY ARTIFICIAL LIGHT. LOCATE TIME CLOCK ADJACENT TO PANEL WHERE CIRCUITED. CONNECT SO THAT PHOTO-CELL TURNS LIGHTS ON AND TIME CLOCK TURNS LIGHTS OFF. CONTROL COMPONENTS, TO BE SUCH AS INTERMATIC #ET116-CK. PROVIDE WITH A 30 AMP 6-POLE CONTACTOR, COMPLETE WITH PHOTO-CELL.
- 4 COORDINATE LIGHT FIXTURES IN X-RAY RM. WITH OFOI X-RAY CEILING BRACKETS.

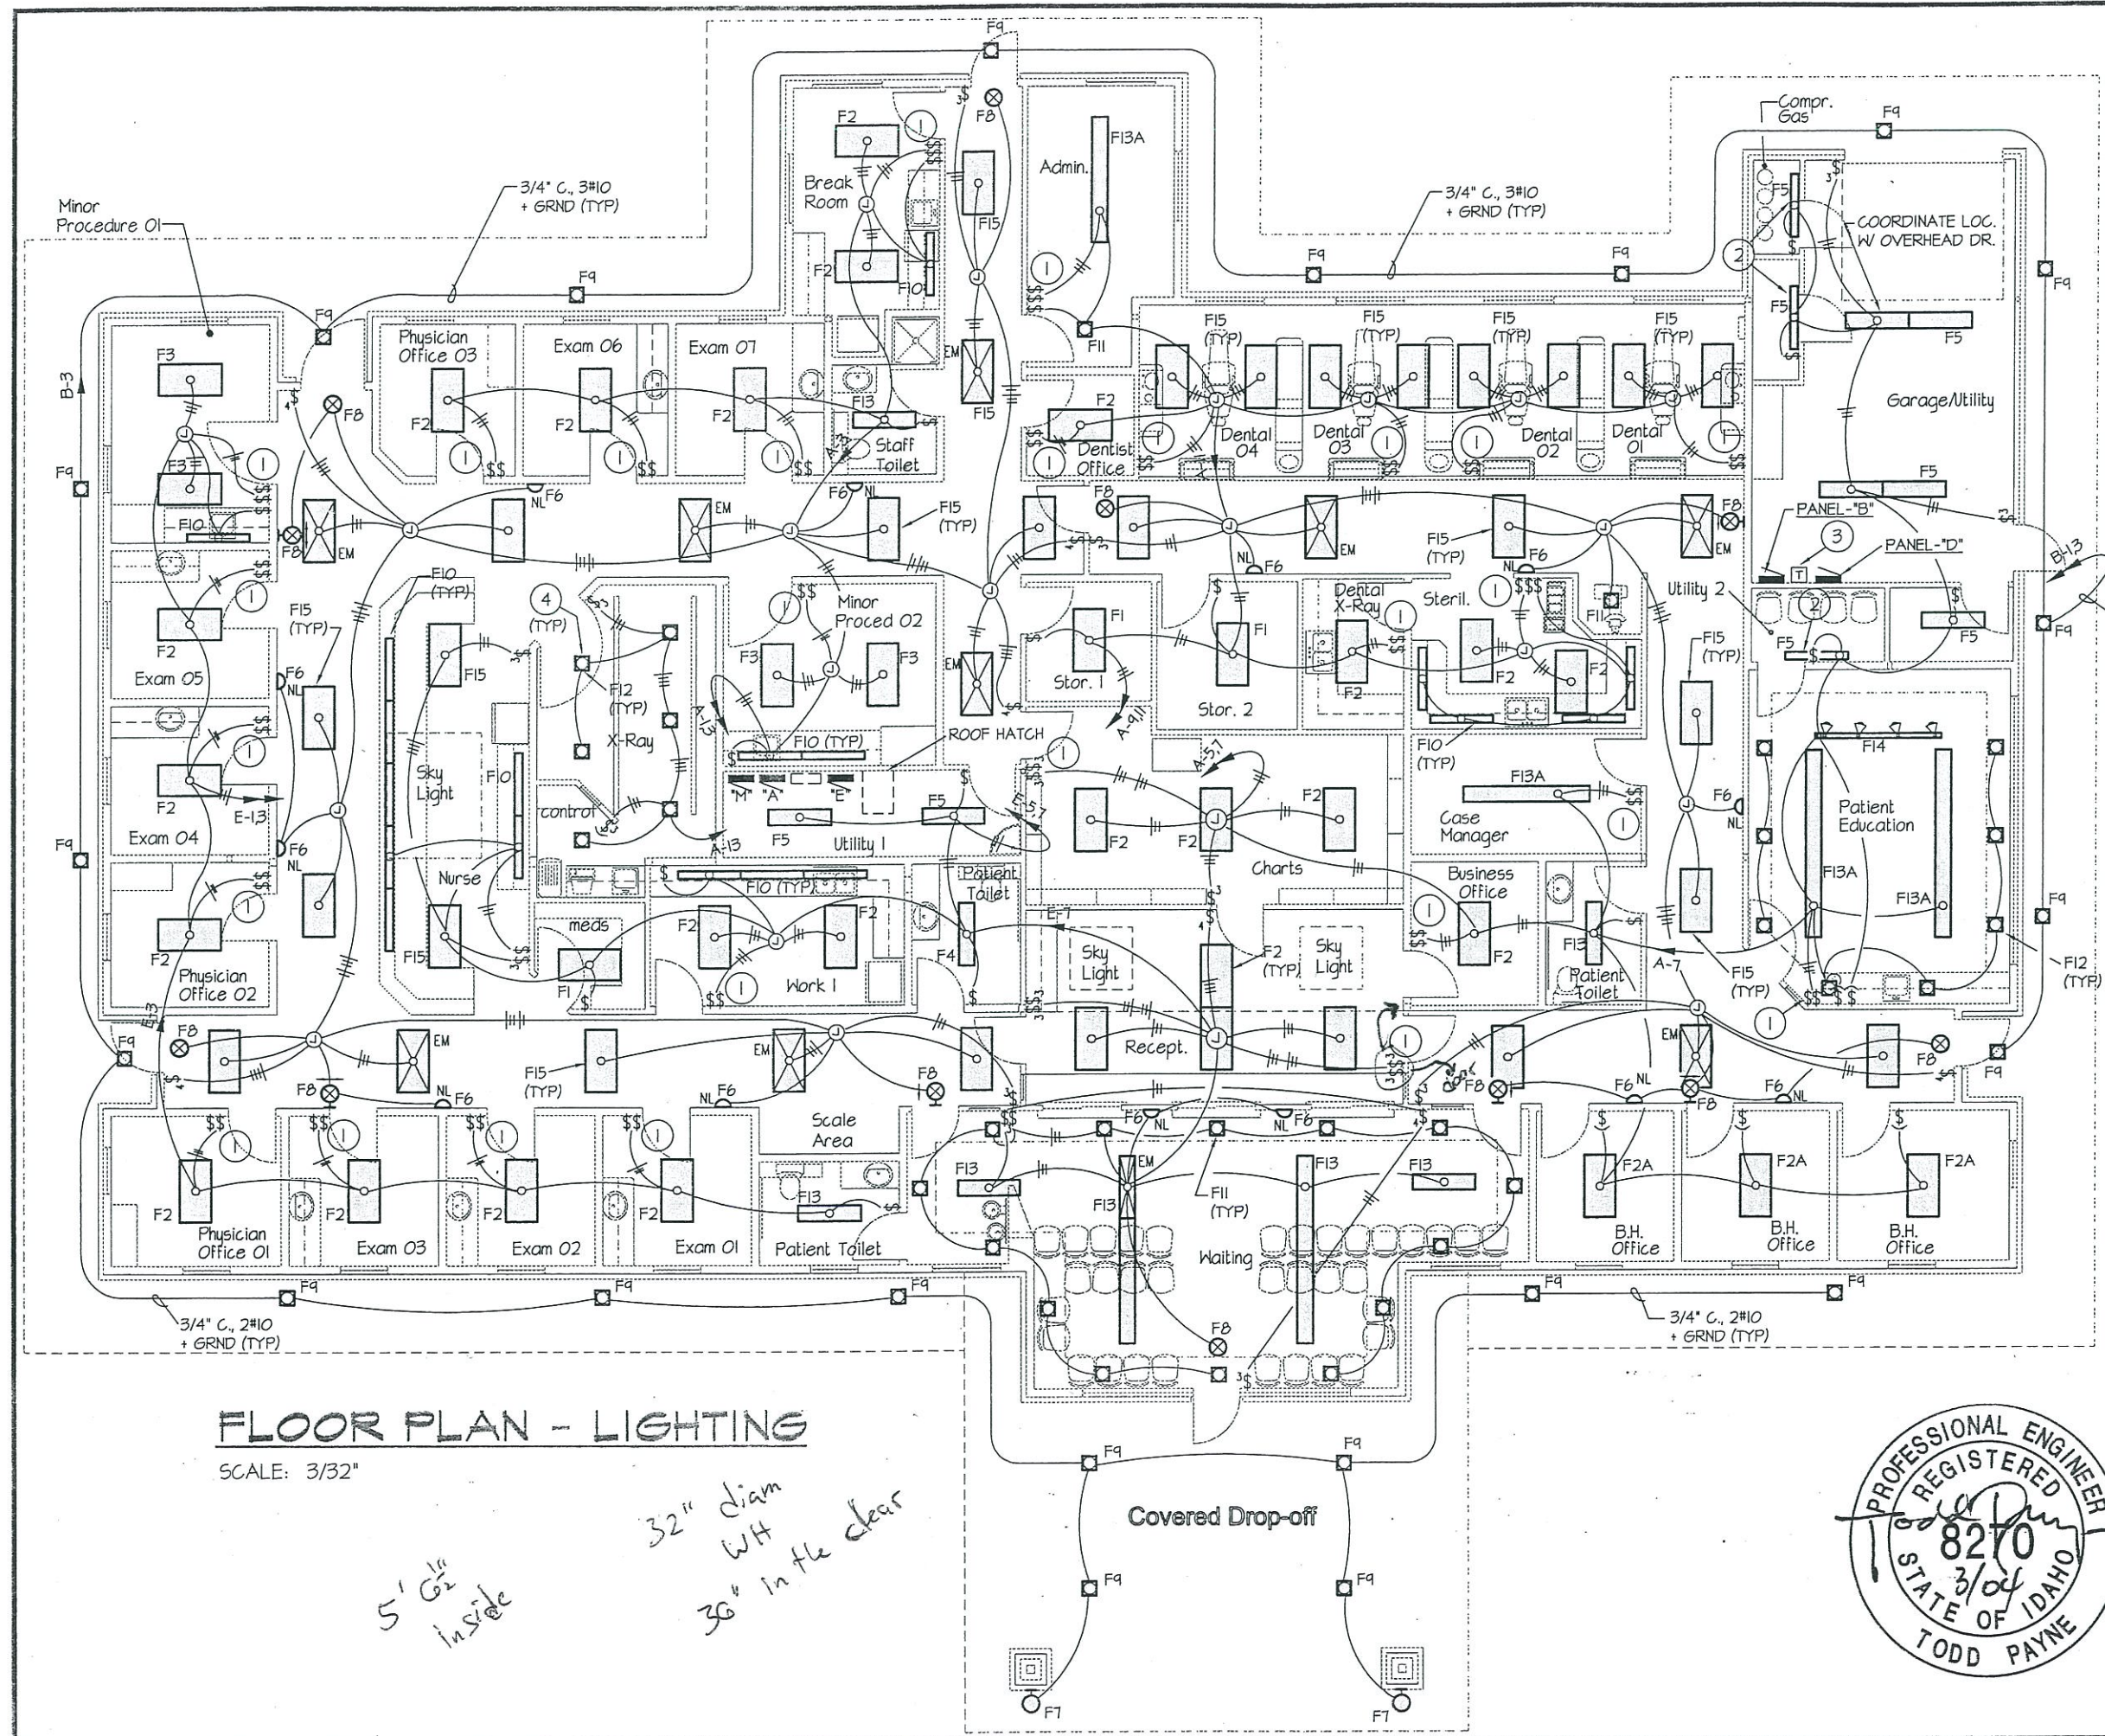

## FLOOR PLAN - LIGHTING

SCALE: 3/32"


5' 6 1/2" inside  
 32" diam WH  
 36" in the clear

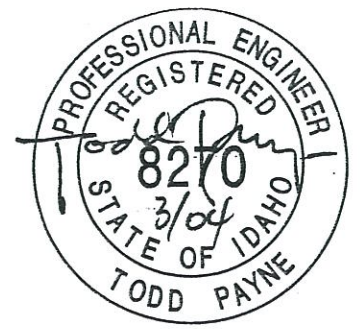

PROJ. NO. 0353

**PAYNE**  
 Engineering Inc. Consulting Engineers


1823 E. Center  
 Pocatello, Idaho 83201  
 tel (208) 232-4439 fax (208) 232-1435

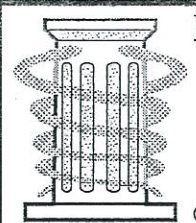

### Medical Design Group Architecture for Health Care

2716 WESTLAND PLACE  
 BOISE, IDAHO 83704-5863  
 BOISEARCHITECT@AOL.COM  
 Fax (208) 378-1405  
 Phone (208) 378-0817

© COPYRIGHT: MEDICAL DESIGN GROUP

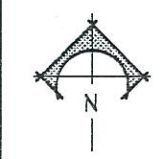


### FLOOR PLAN - LIGHTING

Desert Sage Health Center  
 2280 American Legion Blvd.  
 Mountain Home, Idaho

March 2004 SHEET 16.10



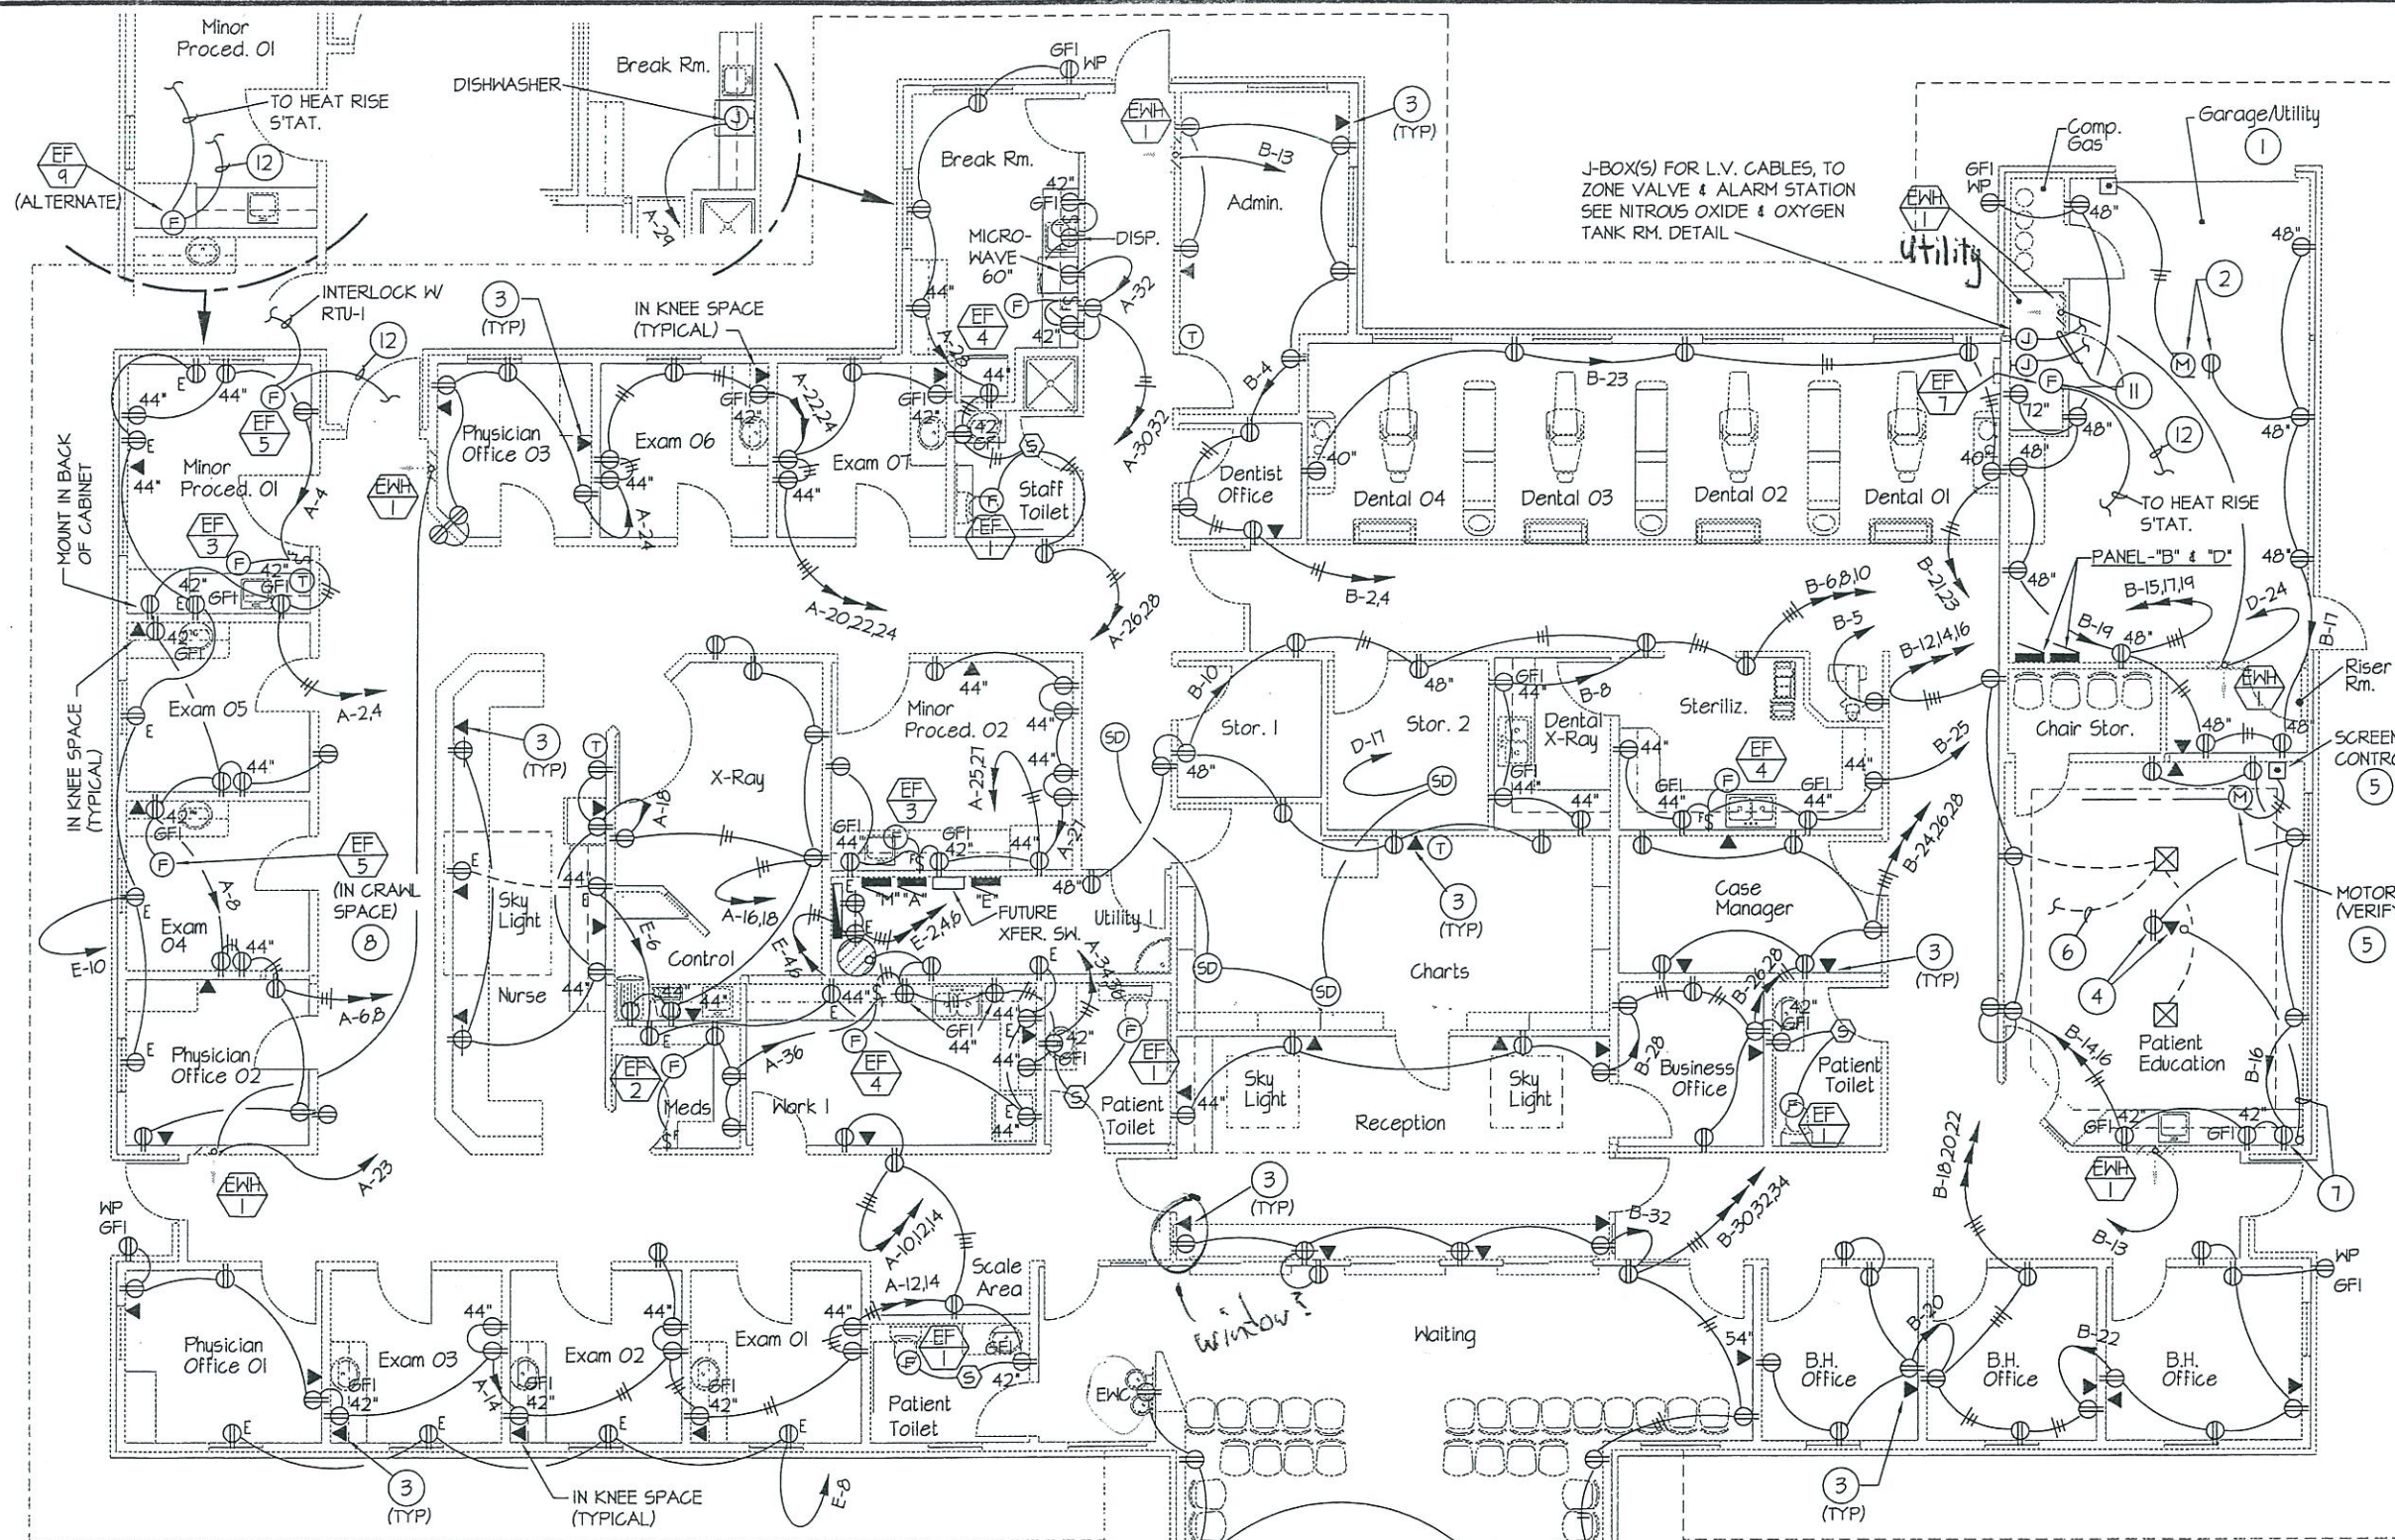

**FLOOR PLAN - POWER**


SCALE: 3/32"

**SPECIAL NOTE:**

ELECT. CONTR. TO COORDINATE WITH THE SECURITY SYSTEM VENDOR, WHO WILL BE INSTALLING KEYLESS ENTRY & INTRUSION ALARM DEVICES IN THIS PROJECT, DURING THE ROUGH-IN PHASES OF THIS PROJECT. ELECTRICAL CONTR. TO MAKE ALLOWANCES AND PROVIDE SUPPORT TO THIS VENDOR DURING CONSTRUCTION.

**KEY NOTES**


- 1 ALL OUTLETS IN GARAGE AREA TO BE AT 48" AFF.
- 2 POWER AND CONTROL AT MOTORIZED OVERHEAD DOOR. FIELD VERIFY ROUGH-IN LOCATION.
- 3 PROVIDE A 3/4" CONDUIT WITH FULL CORD FROM EACH TEL/DATA OUTLET UP INTO ACCESSIBLE CEILING SPACE OR DOWN INTO ACCESSIBLE CRAWL SPACE BELOW FOR OWNER FURNISHED AND INSTALLED TEL/DATA CABLES. VERIFY EXACT OUTLET PLACEMENT W/OWNER.
- 4 MOUNT IN CEILING FOR A CEILING MOUNTED PROJECTOR.
- 5 COORDINATE WITH MOTORIZED SCREEN SHOP DWGS. PRIOR TO ANY ROUGH-IN, TO INSURE PROPER PLACEMENT OF ROUGH-IN BOXES, ETC. CONTROLLER TO BE SUPPLIED WITH EQUIPMENT, INSTALLED BY ELECT. CONTR.
- 6 PROVIDE A 1" CONDUIT FROM FLOOR BOXES BACK TO MAIN TELEPHONE BOARD. PROVIDE WITH NYLON FULL CORD. VERIFY EXACT FLOOR BOX PLACEMENT.
- 7 OUTLET IN BASE CAB. FOR GPU. VERIFY EXACT PLACEMENT. PROVIDE A 1 1/2" CONDUIT AS INDICATED FROM GPU LOCATION UP INTO CEILING SPACE ADJACENT TO CEILING POWER / DATA OUTLETS.
- 8 SEE MECH. FOR EXACT FAN PLACEMENT IN CRAWL SPACE.
- 9 ELECTRICALLY OPERATED POWER ASSIST ENTRY UNIT AND RELATED EQUIPMENT, BY GEN. CONTR., WIRED BY ELECT. CONTR. ELECT. CONTR. TO BE RESPONSIBLE TO REVIEW EQUIP. SHOP DWGS AND PROVIDE ALL NECESSARY ROUGH-IN, ETC. FOR A COMPLETE INSTALLATION. PUSHBUTTON UNITS (2) SHOWN, ARE WIRELESS UNITS.
- 10 VERIFY ROUGH-IN REQUIREMENTS FOR THE STACKED WASHER/DRYER UNIT. FIELD VERIFY NEMA CONFIG. OF OUTLET WITH APPLIANCE PLUG TYPE.
- 11 L.V. CABLES TO ZONE VALVE & ALARM STATION, INSTALLED BY E.C. VERIFY VALVE & ALARM LOC.
- 12 CONNECT TO UNSWITCHED LEG OF LIGHTING CIRCUIT, THIS AREA.

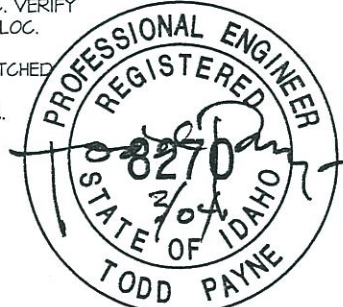

PROJ. NO. 0353

**PAYNE**  
Engineering Inc.  
Consulting Engineers

1823 E. Center  
Pocatello, Idaho 83201  
tel (208) 232-4439 fax (208) 232-1435

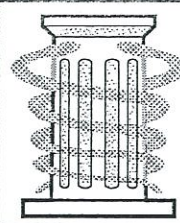

**Medical Design Group**  
Architecture for Health Care

2716 WESTLAND PLACE  
BOISE, IDAHO 83704-5863  
BOISEARCHITECT@AOL.COM  
Fax (208) 378-1405  
Phone (208) 378-0817

© COPYRIGHT: MEDICAL DESIGN GROUP

**FLOOR PLAN - POWER**

Desert Sage Health Center  
2280 American Legion Blvd.  
Mountain Home, Idaho

SHEET  
16.20



March 2004

PANEL "M"		<input type="checkbox"/> MAIN BRKR. _____ AMPS <input checked="" type="checkbox"/> MAIN LUGS ONLY 800 <input type="checkbox"/> MAIN SW. _____ AMPS		<input checked="" type="checkbox"/> FEED BOTTOM <input type="checkbox"/> FEED TOP DIMENSIONS 26" x 6 1/2" x 65"		<input checked="" type="checkbox"/> SURFACE <input type="checkbox"/> FLUSH					
CLASS	120/208V 3 $\phi$ 4W										
LOCATION	UTILITY 1										
MAKE/MODEL	SO D I-LINE (HCN)										
LOAD NAME	CIR NO.	LOAD WATTS	BRK AMP	LOAD/POLE			BRK AMP	LOAD WATTS	CIR NO.	LOAD NAME	
				A	B	C					
PANEL-"A"	1	9550	150	3	24950		3	225	19400	2	PANEL-"RTU"
-		12450	-	-		33350	-	-	19100	-	-
-		12300	-	-		27900	-	-	15600	-	-
PANEL-"B"	3	9000	150	3	18000		3	100	9000	4	PANEL-"D"
-		8700	-	-		16400	-	-	7700	-	-
-		5650	-	-		13250	-	-	7600	-	-
PANEL-"E"	5	2600	100	3	2600		3	125		6	SPARE
-		2650	-	-		2650	-	-		-	-
-		1150	-	-		1150	-	-		-	-
X-RAY EQUIP.	7	11600	150	3	11600		3	100		8	SPARE
-		11600	-	-		11600	-	-		-	-
-		11600	-	-		11600	-	-		-	-
BLANK	9									10	BLANK
-											-
-											-


TOTAL LOAD/PHASE    WATTS    57150    64000    53900  
                                   AMPS    476        533        449        S.C. INT CAP/BKR. 22K AMPS.  
 FEEDER CONDUCTOR SIZE: TWO PARALLEL SETS - 4#500 KCMIL + GRND    CONDUIT SIZE (TWO PARALLEL) 4"  
 REMARKS:

MECH. EQUIPMENT NOTES


\* INTERLOCK WITH RTU-1. ALSO CONNECT FAN TO INDICATOR LIGHT WITH A PERMANENT SIGN, IN NURSE AREA. INDICATOR LIGHT TO SIGNAL IF FAN FAILS TO ENERGIZE. SEE MECH. SHT. MO.4.

\*\* INTERLOCK FAN WITH HEAT RISE STAT. SEE MECH. FOR STAT. LOCATION.


SYMBOL	DESCRIPTION	AMPS	VOLTS	$\phi$	H.P.	K.W.	BREAKER OR DISCONNECT	EQUIPMENT CONTROL	REMARKS
RTU 1	ROOFTOP UNIT	42.0 (FLA)	208	3	2	-	60 AMP 3P DISC FUSED 60 AMPS	WALL STAT	SEE MECH DISC. TO BE NEMA 3R
RTU 2	ROOFTOP UNIT	25.0 (FLA)	208	3	3/4		60 AMP 3P DISC FUSED 40 AMPS		
RTU 3	ROOFTOP UNIT	47.0 (FLA)	208	3	2		60 AMP 3P DISC FUSED 60 AMPS		
RTU 4	ROOFTOP UNIT	42.0 (FLA)	208	3	2		60 AMP 3P DISC FUSED 60 AMPS		
EF 1	EXHAUST FAN		115	1		65 WATTS	CIRCUIT WITH LIGHTS	SEE PLAN	
EF 2	EXHAUST FAN		115	1		65 WATTS		\$F	
EF 3	EXHAUST FAN		115	1		77 WATTS		\$F	
EF 4	EXHAUST FAN		115	1		135 WATTS		\$F	
EF 5	EXHAUST FAN		115	1		61 WATTS		*	
EF 6	RELIEF AIR FAN	16.0 (FLA)	115	1	1		SEE PLAN	SEE DIAG. SHT. M3.1	
EF 7	EXHAUST FAN		115	1		65 WATTS	CIRCUIT WITH LIGHTS	**	
EF 8	EXHAUST FAN		115	1		153 WATTS		**	
EF 9	EXHAUST FAN		115	1		153 WATTS		**	
EW 1	WALL MTD. ELECT. HTR.		115	1		500 WATTS	SEE PLAN	INTEGRAL STAT.	

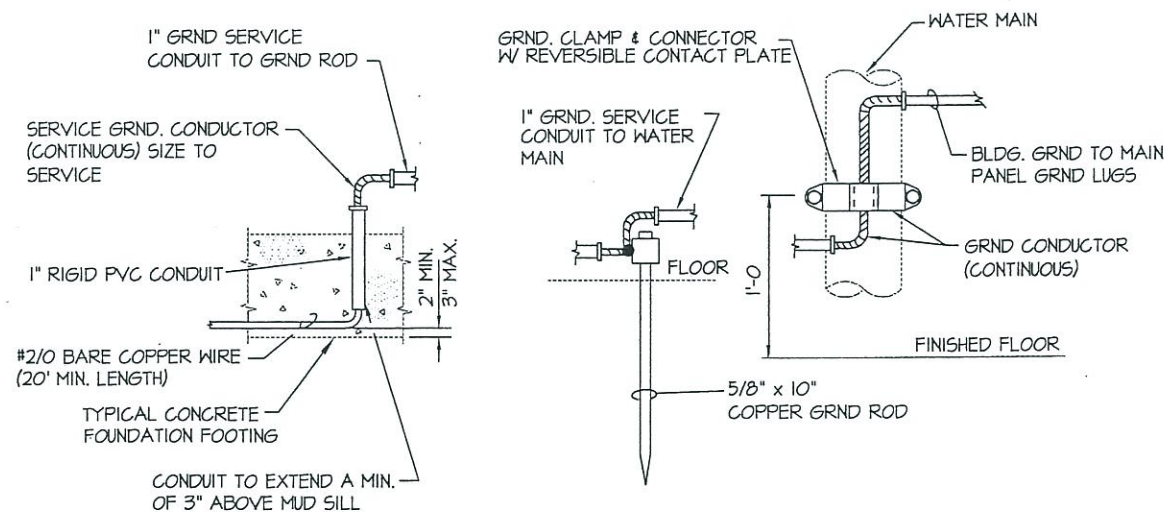

### SERVICE GROUNDING DETAIL

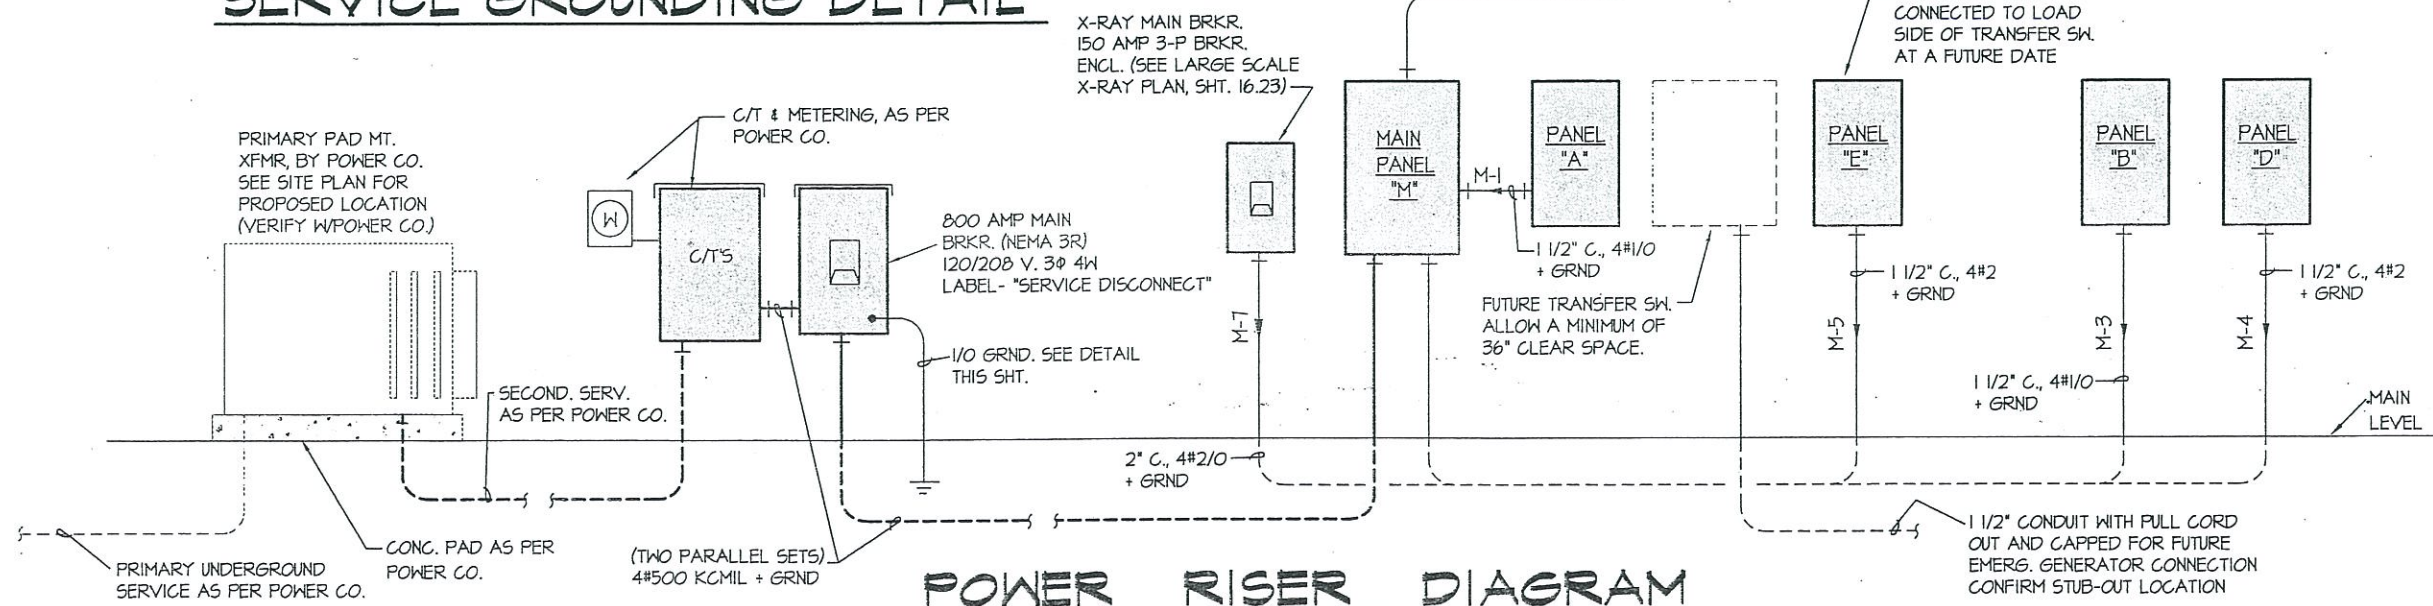

### POWER RISER DIAGRAM

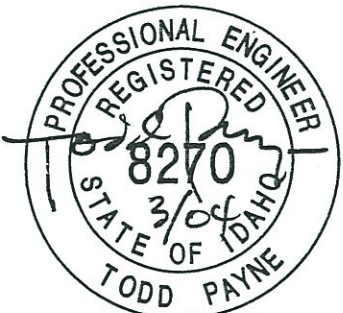

PROJ. NO. 0353

**PAYNE**  
Engineering Inc.  
Consulting Engineers

1823 E. Center  
Pocatello, Idaho 83201  
tel (208) 232-4439 fax (208) 232-1435

**Medical Design Group**  
Architecture for Health Care  
2716 WESTLAND PLACE  
BOISE, IDAHO 83704-5863  
BOISEARCHITECT@AOL.COM  
Fax (208) 378-1405  
Phone (208) 378-0817

© COPYRIGHT: MEDICAL DESIGN GROUP

**POWER RISER & SCHED'S.**  
Desert Sage Health Center  
2280 American Legion Blvd.  
Mountain Home, Idaho

March 2004

SHEET  
16.21

**PANEL "RTU"**  MAIN BRKR. \_\_\_\_\_ AMPS  FEED BOTTOM  SURFACE  
 CLASS 120/208V 3Ø 4W  MAIN LUGS ONLY 225  FEED TOP  FLUSH  
 LOCATION ROOF  MAIN SW. \_\_\_\_\_ AMPS DIMENSIONS 20"x23"x5 3/4"  
 MAKE/MODEL SQ D NQOD (NEMA 3R)

LOAD NAME	CIR NO.	LOAD WATTS	BRK AMP	LOAD/POLE			BRK AMP	LOAD WATTS	CIR NO.	LOAD NAME	
				A	B	C					
OUTLET ON ROOF	1	200	20	1			3	60	5600	2	RTU-3
EF-6	3	1800	30						5600	4	-
SPARE	5		20						5600	6	-
RTU-1	7	5000	60	3			3	60	5000	8	RTU-4
-	9	5000	-	-			-	-	5000	10	-
-	11	5000	-	-			-	-	5000	12	-
RTU-2	13	2800	40	3			3	50		14	SPARE
-	15	2800	-	-			-	-		16	-
-	17	2800	-	-			-	-		18	-
BLANK	19									20	BLANK

TOTAL LOAD/PHASE WATTS 19400 20900 15600 S.C. INT CAP/BKR. 10K AMPS.  
 FEEDER CONDUCTOR SIZE: 4#4/0 + GRND CONDUIT SIZE 2 1/2"  
 REMARKS: (NEMA 3R)

**PANEL "B"**  MAIN BRKR. \_\_\_\_\_ AMPS  FEED BOTTOM  SURFACE  
 CLASS 120/208V 3Ø 4W  MAIN LUGS ONLY 225  FEED TOP  FLUSH  
 LOCATION UTILITY 1  MAIN SW. \_\_\_\_\_ AMPS DIMENSIONS 20"x39"x5 3/4"  
 MAKE/MODEL SQ D NQOD

LOAD NAME	CIR NO.	LOAD WATTS	BRK AMP	LOAD/POLE			BRK AMP	LOAD WATTS	CIR NO.	LOAD NAME	
				A	B	C					
OUTSIDE BLDG. LTS VIA [T]	1	1200	30	1			1	20	600	2	OUTLETS
	3	1700							1000	4	
PANORAMA MACHINE	5	800	20						800	6	
SPARE	7								600	8	
	9								1200	10	
	11								1200	12	
WALL HTR. (2) EWH-1	13	1000							600	14	
OUTLETS	15	600							800	16	
	17	650							800	18	
	19	1200							1000	20	
DENTAL AREA OUTLETS	21	600							1200	22	
	23	400							1000	24	
STERIL AREA OUTLETS	25	800							1000	26	
SPARE	27								800	28	
	29								800	30	
	31								1000	32	RECEPTION AREA
	33								800	34	ELECT. WTR. COOLER
SPARE	35		20	2						36	SPARE
-	37		-	-						38	
SPARE	39		30	2						40	
-	41		-	-						42	

TOTAL LOAD/PHASE WATTS 9000 8700 6450 S.C. INT CAP/BKR. 10K AMPS.  
 FEEDER CONDUCTOR SIZE: 4#1/0 + GRND CONDUIT SIZE 1 1/2"  
 REMARKS:

**PANEL "A"**  MAIN BRKR. \_\_\_\_\_ AMPS  FEED BOTTOM  SURFACE  
 CLASS 120/208V 3Ø 4W  MAIN LUGS ONLY 225  FEED TOP  FLUSH  
 LOCATION UTILITY 1  MAIN SW. \_\_\_\_\_ AMPS DIMENSIONS 20"x39"x5 3/4"  
 MAKE/MODEL SQ D NQOD


LOAD NAME	CIR NO.	LOAD WATTS	BRK AMP	LOAD/POLE			BRK AMP	LOAD WATTS	CIR NO.	LOAD NAME	
				A	B	C					
LIGHTING	1	1200	20	1			1	20	400	2	OUTLETS
	3	600							600	4	
	5	900							1000	6	
	7	1600							1000	8	
	9	1100							700	10	EX. FAN
	11	750							1200	12	
X-RAY RM. LIGHTS	13	350							1200	14	
CRAWL SPACE LIGHTS	15	1400							1000	16	X-RAY RM.
CRAWL SPACE OUTLETS	17	600							1000	18	
X-RAY EQUIPMENT	19	1000							800	20	
CLOTHS WASHER	21	1200							800	22	
WALL HTRS. (2) EWH-1	23	1000							1000	24	
OUTLETS	25	800							600	26	EX. FAN
	27	1000							800	28	BREAK RM.
DISHWASHER	29	1200							800	30	
SPARE	31								1000	32	MICRO WAVE
	33								1000	34	EX. FAN
	35								600	36	MEDS RM.
	37									38	SPARE
CLOTHS DRYER	39	2250	30	2						40	
-	41	2250	-	-						42	

TOTAL LOAD/PHASE WATTS 9950 12450 12300 S.C. INT CAP/BKR. 10K AMPS.  
 FEEDER CONDUCTOR SIZE: 4#1/0 + GRND CONDUIT SIZE 1 1/2"  
 REMARKS:

**PANEL "E"**  MAIN BRKR. \_\_\_\_\_ AMPS  FEED BOTTOM  SURFACE  
 CLASS 120/208V 3Ø 4W  MAIN LUGS ONLY 100  FEED TOP  FLUSH  
 LOCATION UTILITY 1  MAIN SW. \_\_\_\_\_ AMPS DIMENSIONS 20"x39"x5 3/4"  
 MAKE/MODEL SQ D NQOD

LOAD NAME	CIR NO.	LOAD WATTS	BRK AMP	LOAD/POLE			BRK AMP	LOAD WATTS	CIR NO.	LOAD NAME	
				A	B	C					
LIGHTING	1	500	20	1			1	20	300	2	PHONE BOARD
	3	450							1000	4	GENERAL OUTLETS
	5	750							400	6	NURSES STATION OUTLETS
	7	1000							800	8	EXAM RM. OUTLETS
SPARE	9								1200	10	
	11									12	SPARE
	13									14	
	15									16	
	17									18	
BLANK	19									20	BLANK
	21									22	
	23									24	
	25									26	
	27									28	
	29									30	

TOTAL LOAD/PHASE WATTS 2600 2650 1150 S.C. INT CAP/BKR. 10K AMPS.  
 FEEDER CONDUCTOR SIZE: 4#2 + GRND CONDUIT SIZE 1 1/2"  
 REMARKS: PANEL LABEL TO BE RED

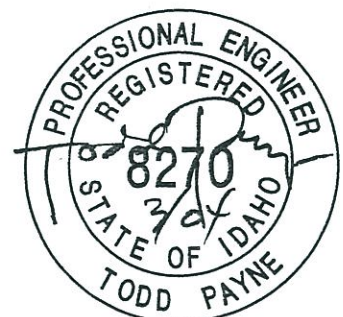

PROJ. NO. 0353

**PAYNE**  
Engineering Inc. Consulting Engineers

1823 E. Center  
Pocatello, Idaho 83201  
tel (208) 232-4439 fax (208) 232-1435

**Medical Design Group**  
Architecture for Health Care  
2716 WESTLAND PLACE  
BOISE, IDAHO 83704-5863  
BOISEARCHITECT@AOL.COM  
Fax (208) 378-1405  
Phone (208) 378-0817

© COPYRIGHT: MEDICAL DESIGN GROUP

ELECT. PANEL SCHED'S.


Desert Sage Health Center  
2280 American Legion Blvd.  
Mountain Home, Idaho

SHEET  
16.22

March 2004


# KEY NOTES

- ① EXACT PLACEMENT OF LIGHT FIXTURES IN CRAWL SPACE TO BE FIELD DETERMINED. ADJUST AS NECESSARY TO BEST FIT THE CONDITIONS, PIPING, DUCTWORK, ETC.
- ② RED INDICATING LIGHT WITH LABEL THAT READS - CRAWL SPACE LIGHTS. RED LIGHT TO ILLUMINATE WHEN CRAWL SPACE LIGHTS ARE ON. LOCATE IN ADMIN. OFFICE ABOVE.
- ③ LIGHT SWITCH WITH PILOT LIGHT TO CONTROL CRAWL SPACE LIGHTS. LOCATE IN UTILITY 1 ABOVE. LABEL SWITCH "CRAWL SPACE LTS."
- ④ PLACE THREE CONVENIENCE OUTLETS IN CRAWL SPACE. EXACT PLACEMENT, TO BE FIELD DETERMINED. LOCATE AT APPROXIMATE LOCATION SHOWN. COORDINATE WITH PIPING, DUCTS, TEC.
- ⑤ OUTLET TO BE MOUNTED IN A W.P. CAST BOX, WITH GFI RECEPTACLE AND W.P. COVER. CIRCUIT TO CKT. RTU-1.
- ⑥ EXACT PLACEMENT OF PANEL-"RTU" ON ROOF, TO BE FIELD DETERMINED. REFER TO POWER RISER FOR MOUNTING INSTR. FLASH AND SEAL PANEL FEEDER ROOF PENETRATION, AS PER ROOFING CONTR.
- ⑦ CONNECT TO UNSWITCHED LEG OF THE LIGHTING CIRCUIT IN RM. BELOW.

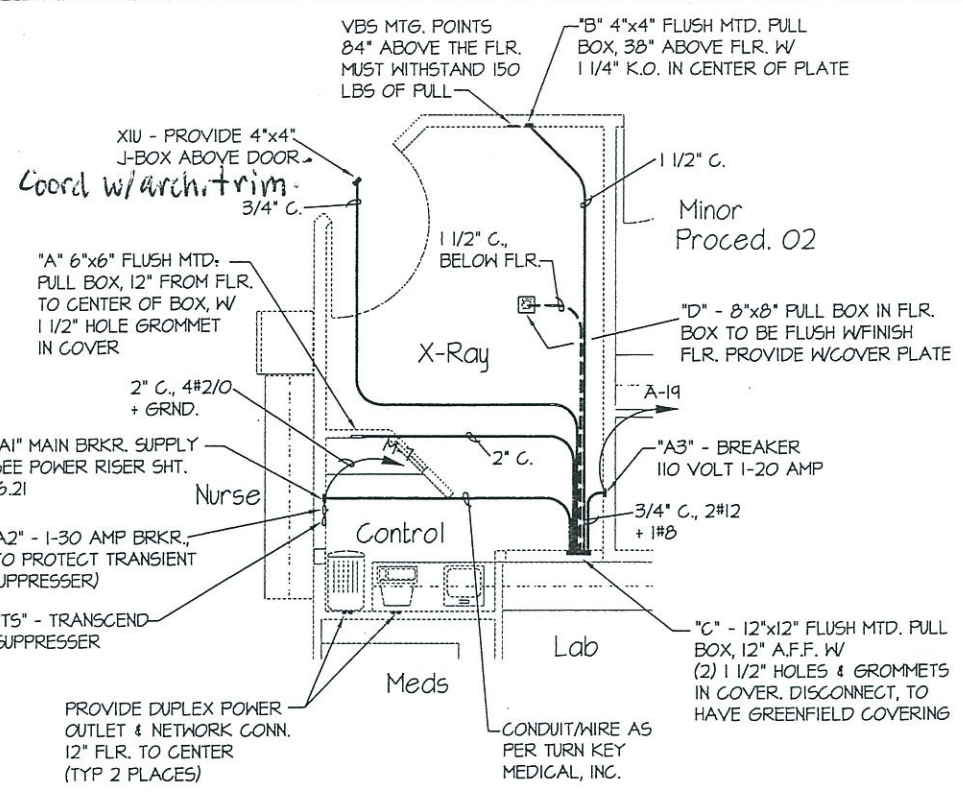


## LARGE SCALE X-RAY RM.

SCALE: 1/8"-1'-0"

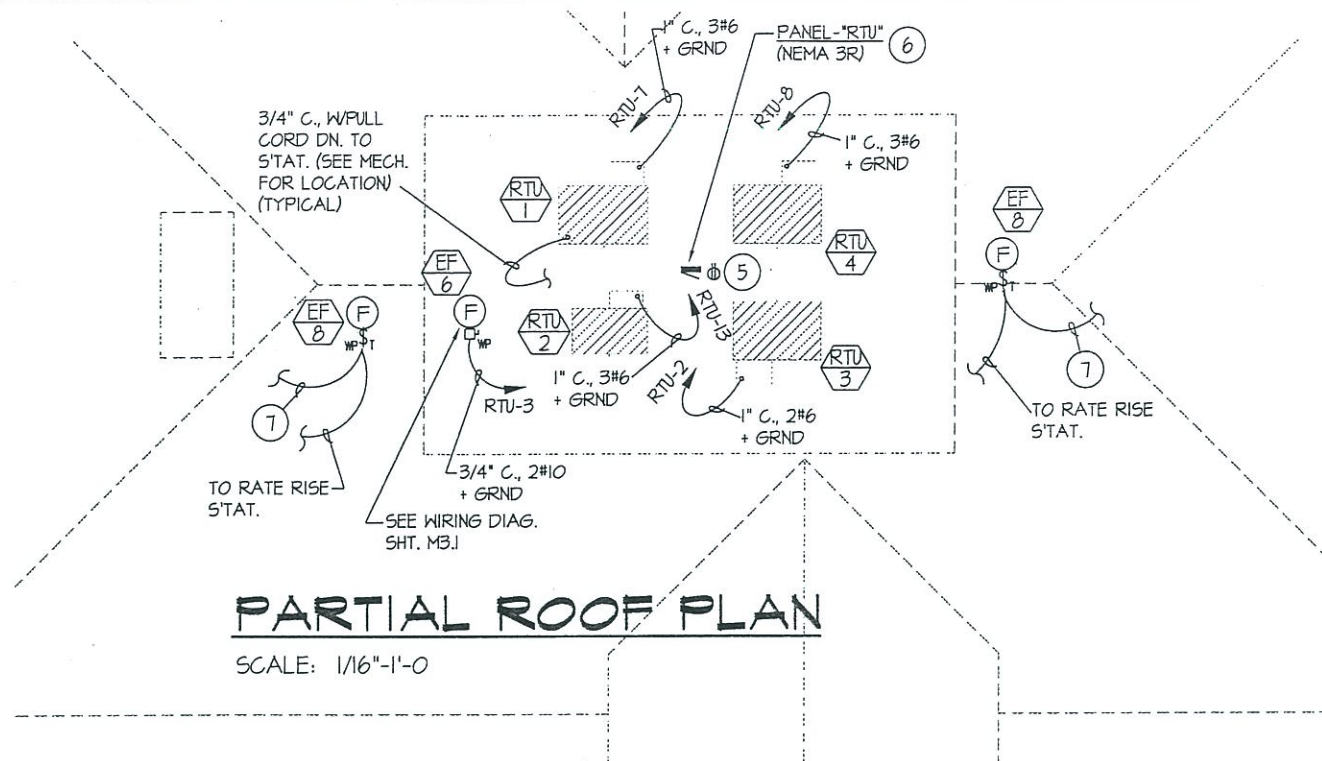


## PARTIAL ROOF PLAN

SCALE: 1/16"-1'-0"

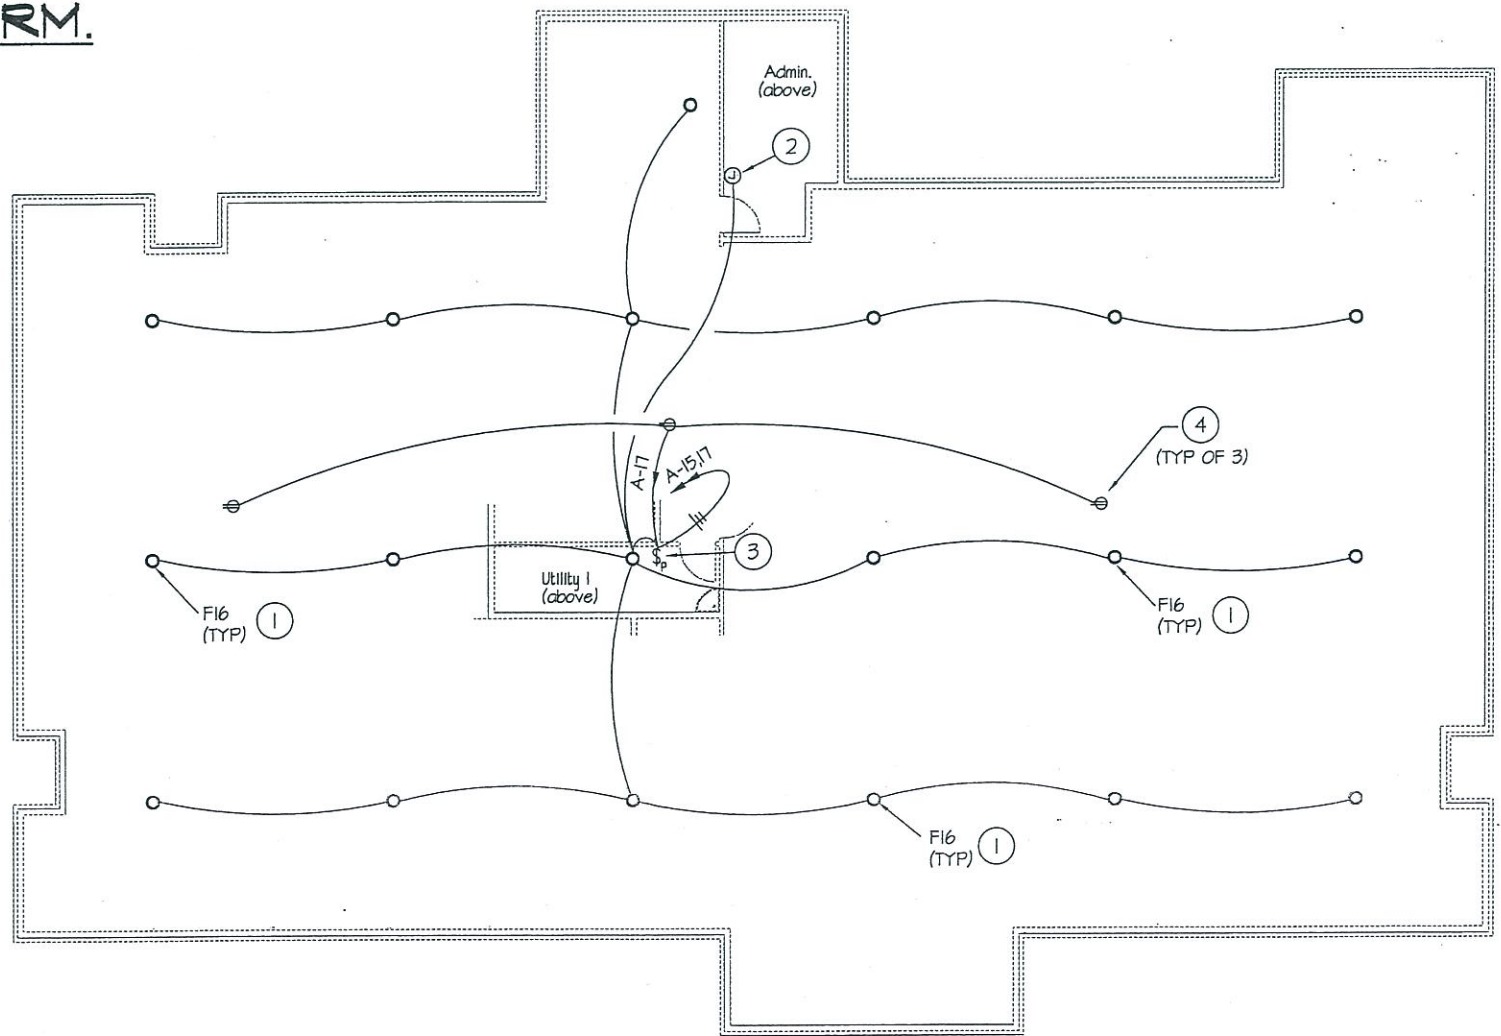

## CRAWL SPACE ELECTRICAL PLAN

SCALE: 1/16"-1'-0"

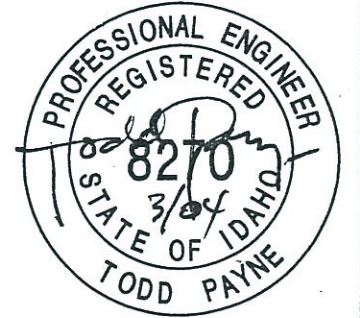

PROJ. NO. 0353

**PAYNE**  
Engineering Inc.  
Consulting Engineers

1823 E. Center  
Pocatello, Idaho 83201  
tel (208) 232-4439 fax (208) 232-1435

**Medical Design Group**  
Architecture for Health Care  
2716 WESTLAND PLACE  
BOISE, IDAHO 83704-5863  
BOISEARCHITECT@AOL.COM  
Fax (208) 378-1405  
Phone (208) 378-0817

© COPYRIGHT: MEDICAL DESIGN GROUP

### ROOF/CRAWL SPACE PLANS

Desert Sage Health Center  
2280 American Legion Blvd.  
Mountain Home, Idaho


SHEET  
16.23



March 2004

# KEY NOTES

- ① PROVIDE A 1/2" CONDUIT WITH NECESSARY SIGNAL WIRING FROM EACH SIGNAL LIGHT, BACK TO DENTAL EQUIPMENT AS DIRECTED BY SULLIVAN SCHEIN DENTAL.
- ② CONNECT INTO LIGHTING CIRCUIT THIS AREA. SEE SHEET 16.10.

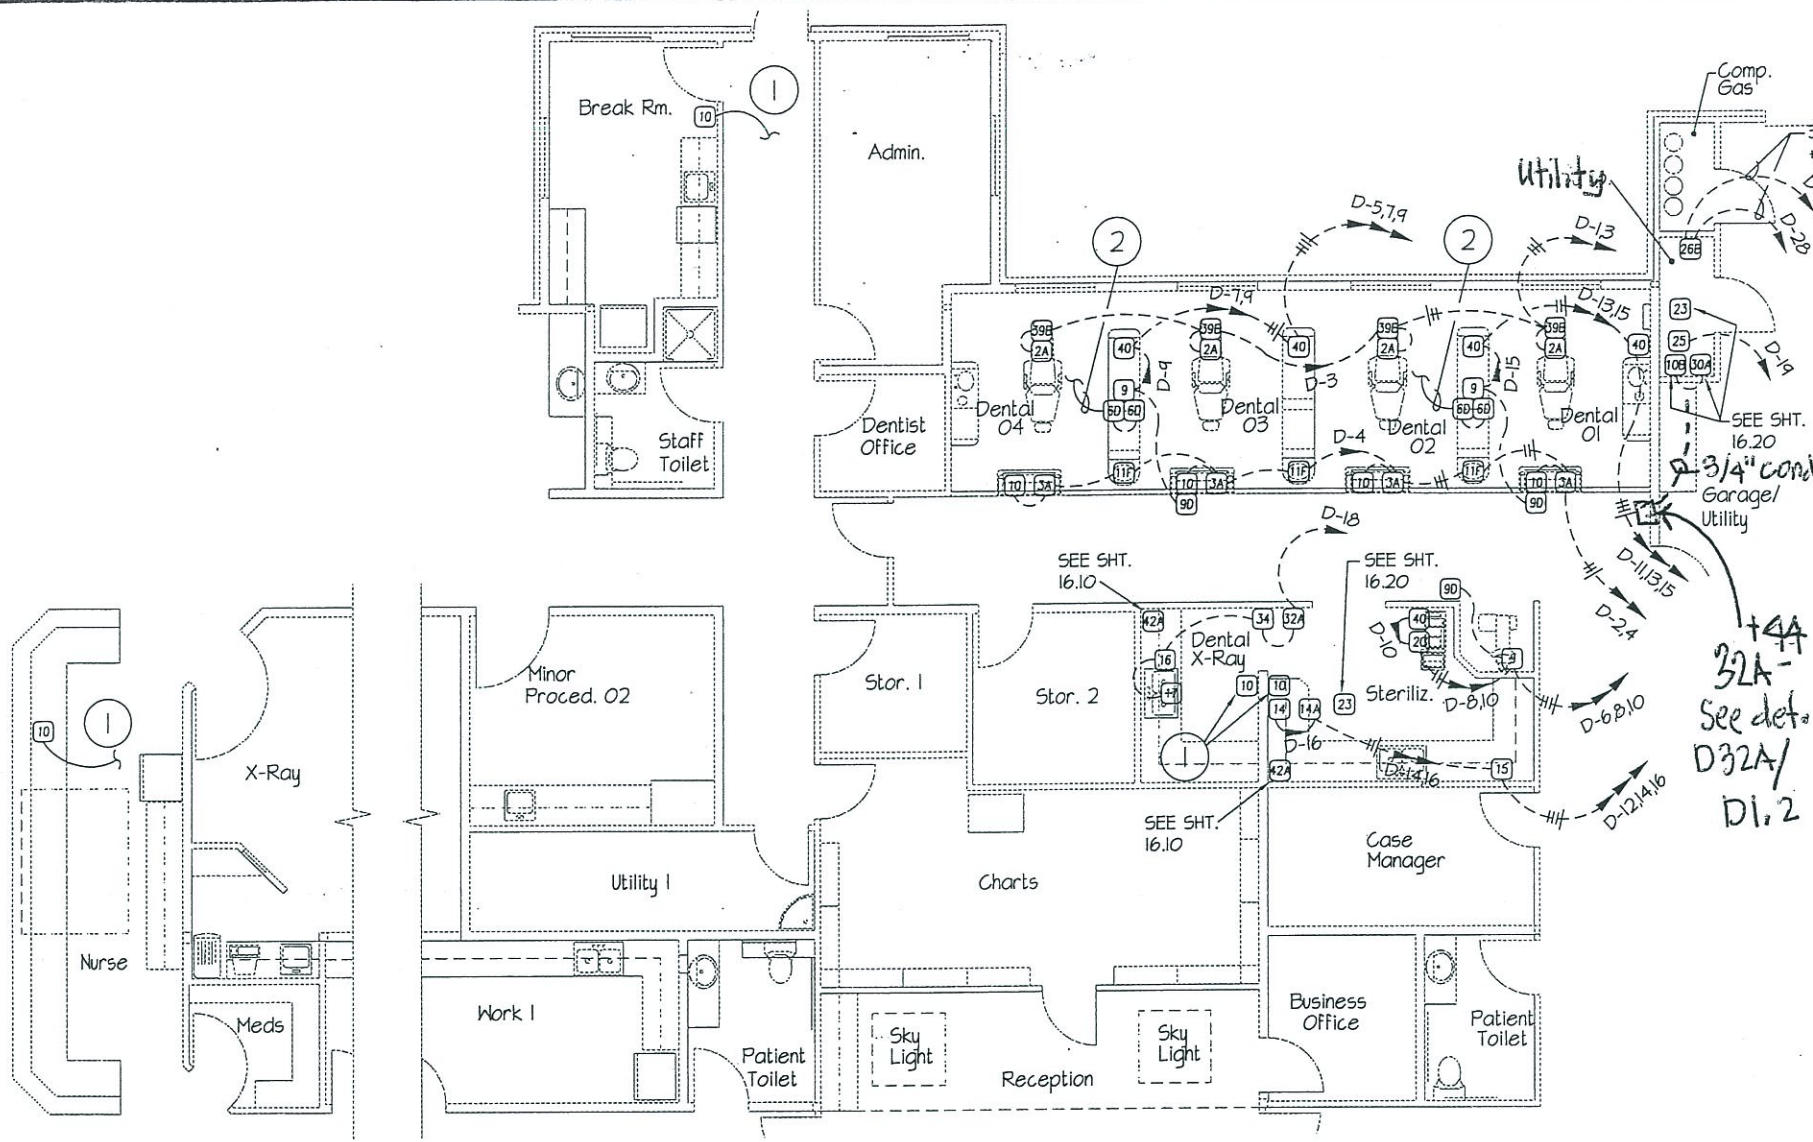

**FLOOR PLAN - DENTAL EQUIP. CONN.**


SCALE: 3/32"

PANEL "D"										
CLASS 120/208V 3Ø 4W		MAIN BRKR. _____ AMPS		FEED BOTTOM		SURFACE				
LOCATION GARAGE/UTILITY		MAIN LUGS ONLY 100		FEED TOP		FLUSH				
MAKE/MODEL SQ D NOOD		MAIN SW. _____ AMPS		DIMENSIONS 20"x39"x5 3/4"						
LOAD NAME	CIR NO.	LOAD WATTS	BRK AMP	LOAD/POLE			BRK AMP	LOAD WATTS	CIR NO.	LOAD NAME
(2A) (99B)	1	1000	20	1	2000		1	20	1000	2 (3A) (11F)
	3	1000				2000			1000	4
(40)	5	1000							1000	6 (9)
	7	1000		2000					1000	8 (20)
(9)	9	1200			2200				1000	10 (40)
(40)	11	1000				1600			600	12 (19)
	13	1000		2000					1000	14 (14A)
(9)	15	1200			2000				1000	16 (14)
SMOKE DAMPERS	17	250				1250			1000	18 (16) (17) (32A) (34)
SPARE	19	1500		1500						20 SPARE
	21									22
	23					1000		1000		24 EWH-1 (2)
BLANK	25									26 SPARE
	27									28 BLANK
SPARE	29									30
	31		20	2						32
	33				1500		2	30	1500	34 (26B)
(26B)	35	1500	30	2		3000			1500	36
	37	1500			1500		3	20		38 SPARE
SPARE	39		30	2						40
	41									42

TOTAL LOAD/PHASE      WATTS      9000      7700      8600  
 FEEDER CONDUCTOR SIZE: 4#2 + GRND      AMPS      75      64      63      S.C. INT CAP/BKR. 10K AMPS.  
 REMARKS:      CONDUIT SIZE 1 1/2"

DENTAL EQUIPMENT LEGEND									
SYMBOL	DESCRIPTION	ELECTRICAL REQUIREMENTS	DEDICATED CIRCUIT	SULLIVAN-SCHEIN DENTAL STANDARD DETAIL NO.	SYMBOL	DESCRIPTION	ELECTRICAL REQUIREMENTS	DEDICATED CIRCUIT	SULLIVAN-SCHEIN DENTAL STANDARD DETAIL NO.
(2A)	UTILITY CENTER	115V 20A		D-2A	(23)	EXHAUST FAN	115V 15A	✓	-
(3A)	UTILITY CENTER	115V 20A		D-3A	(25)	AIR COMPRESSOR	SEE SPECS.	✓	D-25
(6D)	DENTAL LIGHT	115V 3A		-	(26B)	VACUUM SYSTEM	2-230V 30A	✓	D-26B
(9)	X-RAY	115V 20A	✓	-	(30A)	WATER SOLENOID	115V OR 24V		D-30A
(9D)	X-RAY REMOTE BUTTON	-		D-4D	(32A)	REMOTE PANEL	-		D-32A
(10)	SIGNAL LIGHT	115V 15A		D-10	(34)	NITROUS OXIDE ALARM	115V 15A		D-34
(10B)	POWER OUTLET	-	(SEE SHEET 16.20)		(39B)	CHAIR-MOUNTED MONITOR	115V 15A		-
(11F)	CENTER CABINET	115V		-	(40)	COMPUTER CIRCUIT	115V 20A	✓	-
(14)	STERILIZER	115V 15A	✓	D-14	(42A)	TASK LIGHTING	115V	(SEE SHEET 16.10)	-
(14A)	STERILIZER	115V 20A	✓	D-14A					
(15)	ULTRASONIC CLEANER	115V 15A	✓	D-15					
(16)	MODEL TRIMMER	115V		D-16					
(17)									
(20)									

NOTES:  
 1. A SULLIVAN-SCHEIN REPRESENTATIVE WILL SPOT ALL EXACT EQUIPMENT LOCATIONS ON THE JOB.  
 2. ALL LOCATIONS, MOUNTING HEIGHTS, ROUGH-IN BOXES, SIZES, ETC. TO BE COORDINATED AND FIELD VERIFIED WITH SULLIVAN-SCHEIN PRIOR TO ANY ROUGH-IN.  
 3. REFER TO SULLIVAN-SCHEIN STANDARD DETAILS FOR HELPFUL INFORMATION ON EQUIPMENT WHERE DETAILS ARE AVAILABLE.

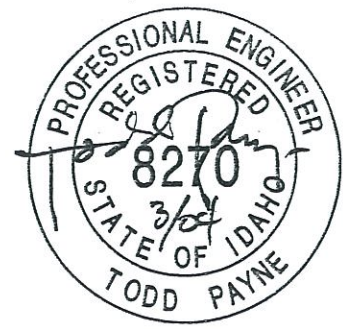

PROJ. NO. 0353


**PAYNE Engineering Inc.**  
 Consulting Engineers  
 1823 E. Center  
 Pocatello, Idaho 83201  
 tel (208) 232-4439 fax (208) 232-1435

**Medical Design Group**  
 Architecture for Health Care  
 2716 WESTLAND PLACE  
 BOISE, IDAHO 83704-5863  
 BOISEARCHITECT@AOL.COM  
 Fax (208) 378-1405  
 Phone (208) 378-0817  
 © COPYRIGHT: MEDICAL DESIGN GROUP

**DENTAL EQUIP. PLAN**

Desert Sage Health Center  
 2280 American Legion Blvd.  
 Mountain Home, Idaho

SHEET 16.24  
 March 2004

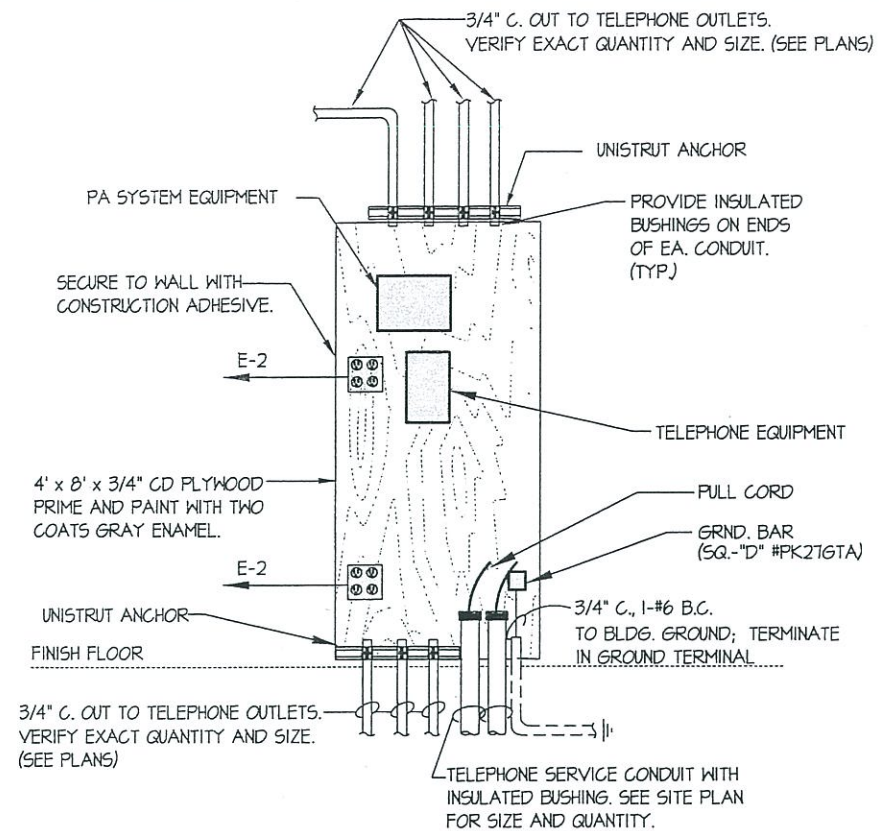


### TELEPHONE / DATA BOARD DETAIL

NO SCALE

#### NOTES:


- \* ALL MOUNTING HEIGHTS TYPICAL UNLESS NOTED OTHERWISE.
- \* COORDINATE OUTLET HEIGHTS WITH ARCHITECTS MILLWORK DWGS. TO INSURE THAT OUTLETS WILL NOT FALL BEHIND CABINETS, BACKSPASHES, OR INTERFERE WITH MAINSCOTING, ETC.
- \* ALL SWITCHES AND THERMOSTATS TO BE MOUNTED AS CLOSE TO DOOR JAMBS AS POSSIBLE. COORDINATE ALL DEVICES WITH ARCHITECTURAL PLANS AND DETAILS.

- Ⓟ THERMOSTAT OR MECHANICAL SWITCH
- Ⓢ LIGHT SWITCH
- Ⓧ CONVENIENCE OUTLET
- ▼ TELEPHONE / DATA OUTLET
- Ⓞ T.V. OUTLET

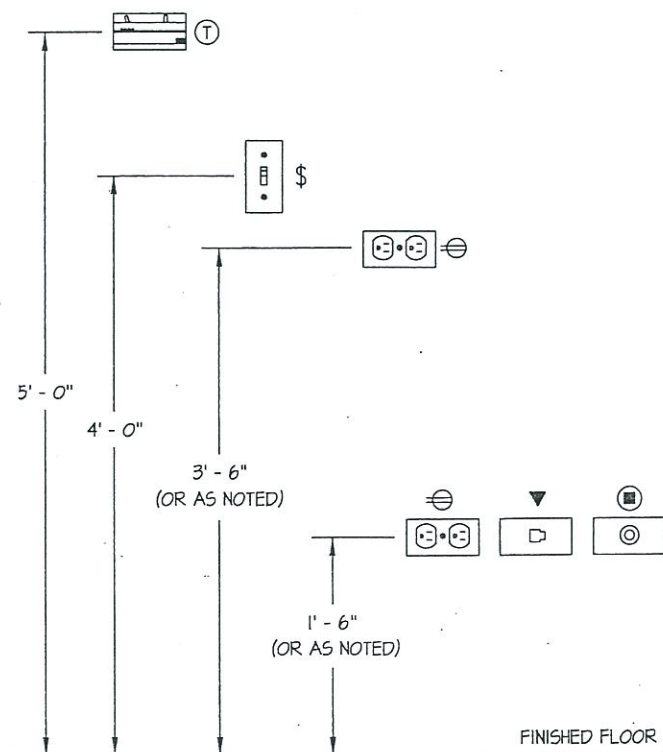

### TYPICAL DEVICE MOUNTING HEIGHTS DIAGRAM



NO SCALE

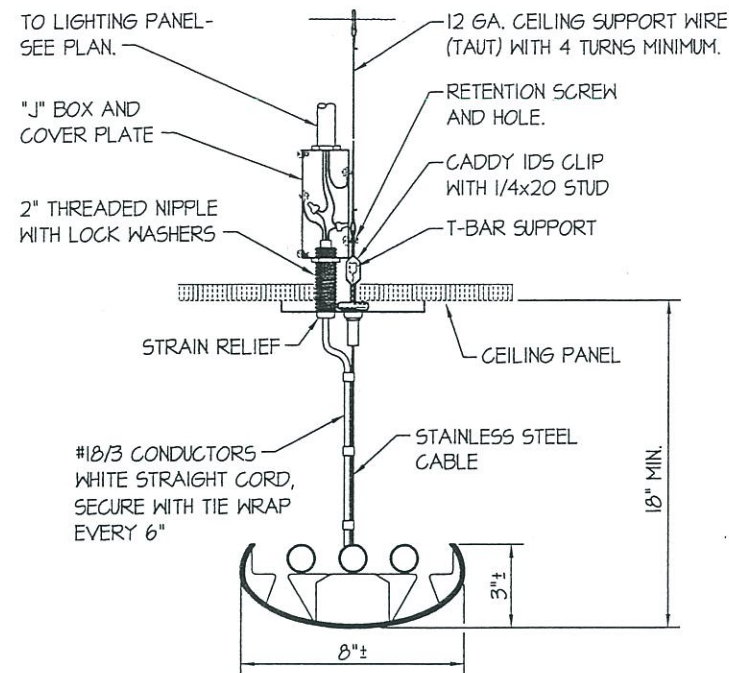

NOTE:  
REFER TO PLANS FOR FIXTURE LENGTHS

### F13 PENDANT LIGHT FIXTURE MOUNTING DETAIL

NO SCALE

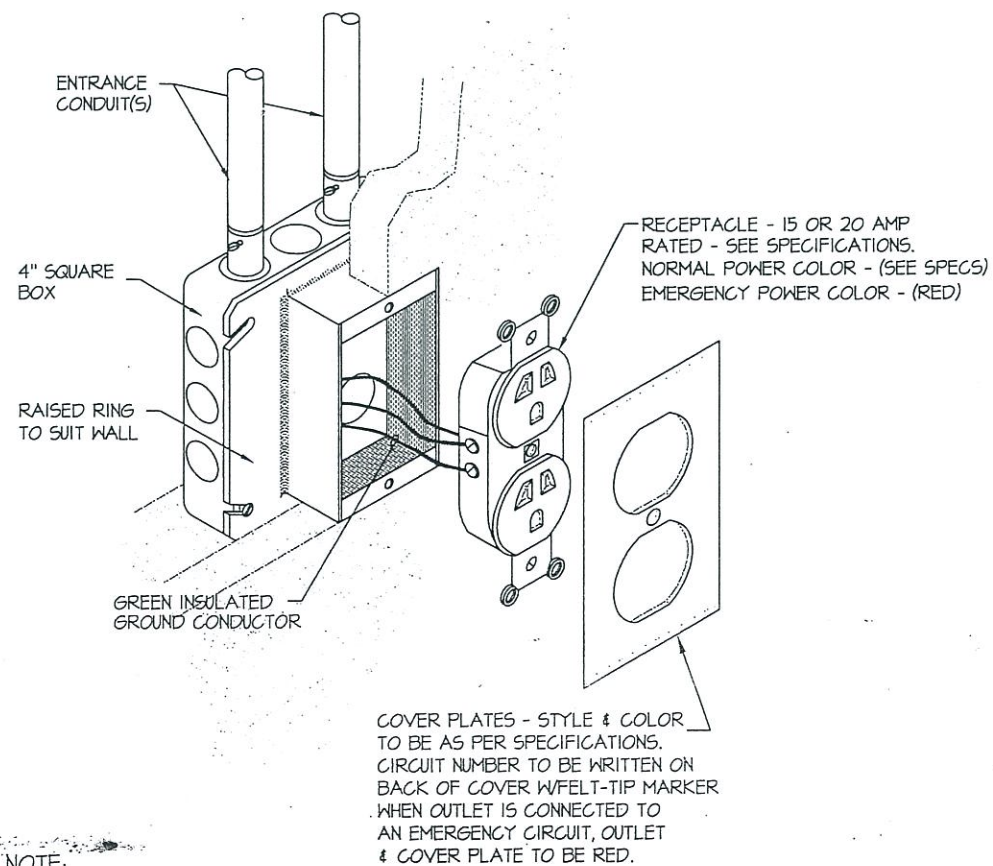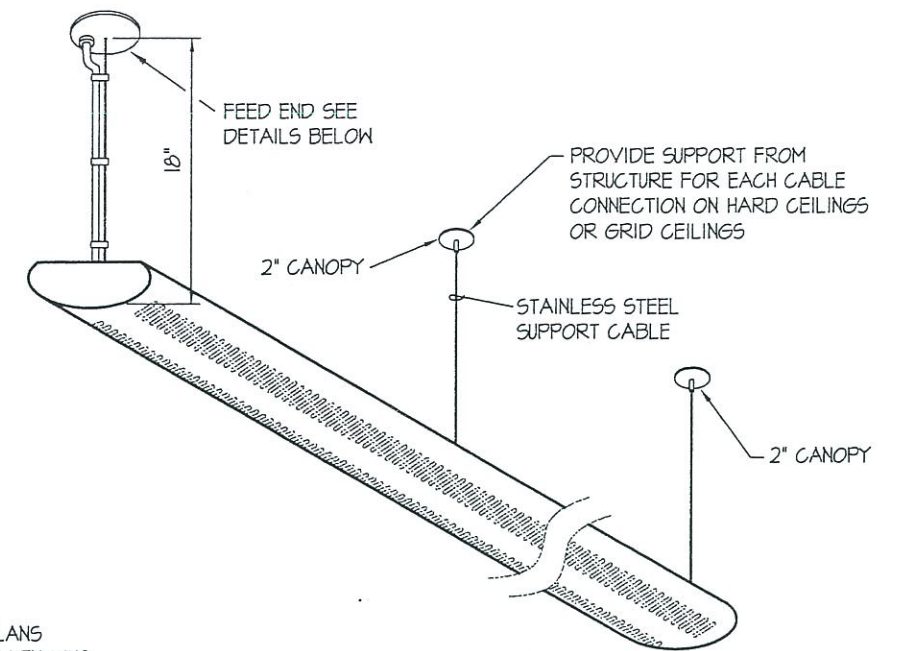


#### NOTE:

IF ELECTRICAL OUTLET COVER PLATES ARE METAL, OUTLETS SHALL BE INSTALLED WITH THE GROUND RECEIVER IN THE UP POSITION, AS PER CODE.

### RECEPTACLE MOUNTING DETAIL

NO SCALE

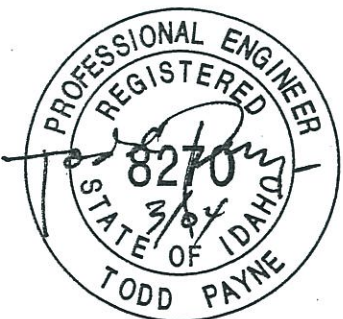


PROJ. NO. 0353

**PAYNE**  
Engineering Inc.

Consulting Engineers

1823 E. Center  
Pocatello, Idaho 83201  
tel (208) 232-4439 fax (208) 232-1435

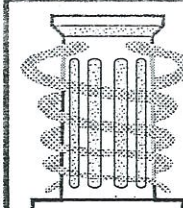

Medical Design Group  
Architecture for Health Care

2716 WESTLAND PLACE  
BOISE, IDAHO 83704-5863  
BOISEARCHITECT@AOL.COM  
Fax (208) 378-1405  
Phone (208) 378-0817

© COPYRIGHT: MEDICAL DESIGN GROUP

ELECTRICAL DETAILS

Desert Sage Health Center  
2200 American Legion Blvd.  
Mountain Home, Idaho

SHEET  
16.30

March 2004

# DIVISION 16 ELECTRICAL SPECIFICATIONS

## 8. EXECUTION

Raceway Installation: Separate underground conduits in a common trench 4" minimum horizontally, 12" minimum from other utility lines. Minimum conduit depth shall be 24". Coordinate conduit installation with pipes, steel and ducts installed by other trades. Install conduit runs exposed to view parallel or at right angles to structural members, walls or building lines. Support conduit with one-hole malleable factory made pipe straps, fastened with stainless steel screws.

## 9. OPERATING AND ADJUSTING

The owner reserves the right to operate any systems of equipment prior to final completion and acceptance of the work. Such preliminary operation shall not be construed as an acceptance of any work.

Each piece of equipment and all of the systems shall be adjusted to insure proper functioning and shall be left in first class operating condition.

## 10. CUTTING AND PATCHING

Do all drilling and cutting as necessary for installation of equipment. Do cutting and drilling of structure only with prior approval of the owner. Where cutting and patching of work is necessary, use same materials workmanship and finish neatly, match all surrounding work.

## 11. CONDUIT

Provide EMT conduit and install in strict accordance with Electrical Code and for all systems in building. In damp or wet locations, use EMT conduit with appropriate fittings. Conduits underground or in slab shall be Sch. 40 PVC; install a galvanized steel elbow where these conduits emerge above grade or slab and wrap to retard deterioration. All conduits without conductors, installed with #12 TW pull wire. Verify sizes of all underground conduits not indicated.

## 12. OUTLET BOXES AND BOX EXTENSION

Provide 4" square steel boxes with mudring as required.

## 13. CONDUCTORS

Type THWN or THHN copper wire insulated for 600V. Smallest wire shall be #12 awg unless noted. Use "Ideal Yellow" pulling compound for all pulls. Use Scotchlock connectors for all splices in #12 wire and taped bolted pressure connectors for larger wire. All wiring shall be copper.

## 14. GROUNDING

Provide and install service grounding per NEC and as detailed on the drawings. Provide and install a green equipment ground conductor in all raceways. Conduit only ground is not acceptable. Grounding shall conform to Article 517 in the NEC, as required.

## 15. DEVICES

Switches: specification grade, quiet type, color to be white, (nylon) 20 amps. (Such as P&S 20AC1 X) provide 3-way, 4-way and pilot light switches as indicated.

Convenience outlets: Specification grade duplex grounding type, 20 amps. at 125 volts, color white (nylon) and GFI in Code required locations. (Such as P&S 5352 X)

Special Outlets: As noted on plans.

Manufactured by P&S, Leviton, Bryant, or Hubbell.

## 16. DEVICE PLATES

Required for all wiring devices, outlets and similar applications. Gang covers for gang boxes. Nylon, color white Sierra "P" line or other as required.

## 17. LIGHTING FIXTURES

Provide all lighting fixtures complete with accessories as required for proper installation, including lamps. See notes and plans on Fixture Schedule. Substitutions shall be accompanied with copies of specified items and substitutions for comparison by engineer. Any relocation shall be approved by architect.

## 18. SERVICE EQUIPMENT

Panelboards: Circuit breakers and equipment shall be 42,000 AIC-minimum. All locks keyed alike and typewritten directories. All panels shall have a minimum of 36" working clearance in front of panel.

## 1. INTENT

The Contractor shall be responsible for the installation of complete and operable systems of electrical lighting, power and receptacles etc, as indicated on the drawings and specifications, this includes furnishing all incidental items not actually shown or specified, but which are required by good practice to provide complete and functional systems.

## 2. SUBMITTALS

Submit material lists, data and product cut sheets for all panels, service equipment and lighting fixtures for approval and "as-built" records for this work in accordance with the supplementary and general conditions of the contract documents. No material shall be installed until final approval is given.

## 3. COMPLIANCE WITH CODES

All work and materials shall comply with all applicable codes, safety orders, laws, ordinances and regulations of governing authorities and other agencies having jurisdiction including regulations of the Local Fire Marshall, unless detailed as specified to a more restrictive standard or higher requirement.

## 4. INTERPRETATION OF DRAWINGS

The electrical drawings are essentially diagrammatic in that all provisions necessary to conform to structural, architectural, mechanical and plumbing systems cannot be shown. All installations shall be adjusted as necessary to conform and to avoid obstructions without additional cost to the owner.

All work, material and equipment called for by notes, schedules or otherwise indicated on the drawings shall be furnished and installed as though fully set forth in these specifications.

## 5. VISITING THE SITE

Visit the site and become acquainted with conditions to be encountered. Extra funds will not be allowed due to failure to examine the site and to include existing conditions in bid price.

## 6. COORDINATION WITH UTILITIES

These plans have been prepared without utility company comments. The contractor shall verify the exact requirements for the electric and telephone services with the utility company representatives and provide all work and pay all costs for complete and operating systems, as directed by the governing utilities. Power, Telephone and Cable Television.

## 7. MATERIALS AND WORKMANSHIP

All workmanship shall be performed by skilled mechanics using the best standard practices of the trade. All materials shall, unless otherwise noted, be new and in perfect condition. All material for similar uses shall be of the same type, material and manufacture for ease of future maintenance.

All equipment shall be readily accessible for maintenance and repairs. Provide ladders or similar facilities necessary to install the work.

All materials, fixtures and equipment shall be covered or sealed upon installation so as to provide for safety and to insure that operation and appearance will be maintained after subsequent construction operations.

## 19. CLEAN-UP


Upon completion of the work, prior to final inspection, thoroughly clean all exposed fixtures, trim and equipment, and leave the entire installation in neat, clean and usable condition. Remove all cement, paint, grease, oil and other foreign substances.

## 20. TEST

Test all wire for shorts, opens, grounds, or other defects. Correct any defective work. Demonstrate continuous satisfactory operation of all electrical equipment.

## 21. GUARANTEE

Prior to final acceptance of the project, deliver to the owner a written one year guarantee on all workmanship, materials and equipment and agree to repair or replace all such defective items promptly that may occur during this period, including repair or replacement of the premises that may be damaged due to faulty work and materials furnished under this section.

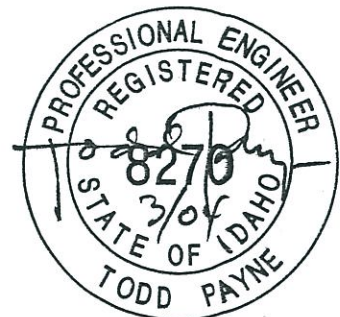


PROJ. NO. 0353

**PAYNE**  
Engineering Inc.

Consulting Engineers

1823 E. Center  
Pocatello, Idaho 83201  
tel (208) 232-4439 fax (208) 232-1435

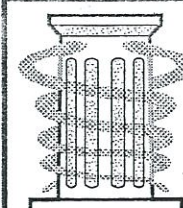

**Medical Design Group**  
Architecture for Health Care

2716 WESTLAND PLACE  
BOISE, IDAHO 83704-5863  
BOISEARCHITECT@AOL.COM  
Fax (208) 378-1405  
Phone (208) 378-0817

© COPYRIGHT: MEDICAL DESIGN GROUP

**ELECTRICAL SPEC.**

Desert Sage Health Center  
2280 American Legion Blvd.  
Mountain Home, Idaho

SHEET

16.40

March 2004

**Lighting Compliance Certificate**  
**2001 IECC**

COMcheck-EZ Software Version 2.4 Release 2b  
 Data filename: C:\Program Files\Check\COMcheck-EZ\desert sage.cck

**Section 1: Project Information**

Project Name: Desert Sage Health Center  
 Designer/Contractor: Payne Engineering Inc.  
 Document Author: Dennis Blanchard  
 Notes: February 10, 2004

**Section 2: General Information**

Building Use Description by: Whole Building Type

Building Type	Floor Area
Medical and Clinical Care	8557

Project Description (check one):  
 New Construction  Addition  Alteration  Unconditioned Shell (File Affidavit)

**Section 3: Requirements Checklist**

- Bldg. |  
 Dept. |  
 Use |
- [ ] Interior Lighting
1. Total actual watts must be less than or equal to total allowed watts
- | Allowed Watts | Actual Watts | Complies(Y/N) |
|---------------|--------------|---------------|
| 13691         | 10211        | YES           |
- [ ] Exterior Lighting
2. Efficacy greater than 45 lumens/W
- Exceptions:  
 Specialized lighting highlighting features of historic buildings; signage; safety or security lighting;  
 low-voltage landscape lighting.
- [ ] Controls, Switching, and Wiring
3. Independent controls for each space (switch/occupancy sensor).  
 Exception: Areas that must be continuously lighted.
- [ ] 4. Master switch at entry to hotel/motel guest room.
- [ ] 5. Two switches or dimmer in each space to provide uniform light reduction capability.  
 Exceptions:  
 Only one luminaire in space; An occupant-sensing device controls the area;  
 The area is a corridor, storage, restroom, or lobby; Areas that must be continuously lighted;  
 Areas greater than 250 sq.ft.
- [ ] 6. Photocell/astronomical time switch on exterior lights.  
 Exceptions: Areas requiring lighting during daylight hours


- [ ] 7. Tandem wired one-lamp and three-lamp ballasted luminaires.  
 Exceptions:  
 Electronic high-frequency ballasts; Luminaires not on same switch

Permit Number

Checked By/Date

**Section 4: Compliance Statement**

The proposed lighting design represented in this document is consistent with the building plans, specifications and other calculations submitted with this permit application. The proposed lighting system has been designed to meet the 2001 IECC requirements in COMcheck-EZ Version 2.4 Release 2b and to comply with the mandatory requirements in the Requirements Checklist.

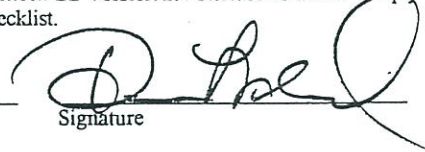Dennis Blanchard  3-11-04  
 Principal Lighting Designer-Name Signature Date

**Lighting Application Worksheet**  
**2001 IECC**

COMcheck-EZ Software Version 2.4 Release 2b

**Section 1: Allowed Lighting Power Calculation**

A	B	C	D
Building Type	Floor Area (ft <sup>2</sup> )	Total Allowed Watts (watts/ft <sup>2</sup> )	Allowed Watts (B x C)
Medical and Clinical Care	8557	1.6	13691
Total Allowed Watts =			13691

**Section 2: Actual Lighting Power Calculation**


A	B	C	D	E	F
Fixture ID	Fixture Description / Lamp Description / Wattage Per Lamp / Ballast	Lamps/ Fixture	# of Fixtures	Fixture Watt.	(D x E)
F1	2 lamp lay-in fluor. / 48" T8 32W / Electronic	2.	4	61	244
F2/F2A	3 lamp lay-in fluor. / 48" T8 32W / Electronic	3	36	95	3420
F3	4 lamp fluor. wrap / 48" T8 32W / Electronic	4	4	112	448
F4	2 lamp fluor. wrap / 48" T8 32W / Electronic	2	4	61	244
F5	2 lamp strip light / 48" T8 32W / Electronic	2	10	61	610
F6	interior wall sconce / Triple 4-pin 26W / Electronic	1	13	26	338
F10	under counter light / 48" T8 32W / Electronic	1	19	37	703
F11	interior recessed can / Triple 4-pin 26W / Electronic	1	1	26	26
F12	interior recessed can / Incandescent 75W	1	10	75	750
F13	2 lamp linear fluor. / 48" T8 32W / Electronic	2	8	61	488
F14	low voltage trac light / Incandescent 50W	1	10	50	500
F15	2 lamp recessed fluor. / 48" T8 32W / Electronic	2	40	61	2440
Total Actual Watts =					10211

**Section 3: Compliance Calculation**

If the Total Allowed Watts minus the Total Actual Watts is greater than or equal to zero, the building complies.

Total Allowed Watts = 13691  
 Total Actual Watts = 10211  
 Project Compliance = 3480


Lighting PASSES: Design 25% better than code

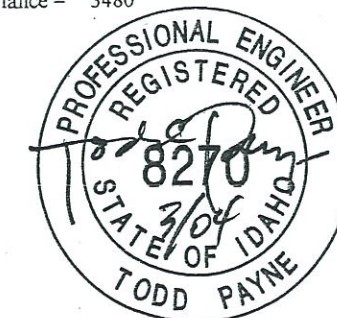

PROJ. NO. 0353

**PAYNE**  
 Engineering Inc. Consulting Engineers

1823 E. Center.  
 Pocatello, Idaho 83201  
 tel (208) 232-4439 fax (208) 232-1435

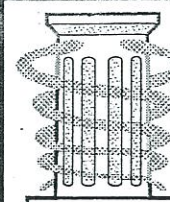

**Medical Design Group**  
 Architecture for Health Care

2716 WESTLAND PLACE  
 BOISE, IDAHO 83704-5863  
 BOISEARCHITECT@AOL.COM  
 Fax (208) 378-1405  
 Phone (208) 378-0817

© COPYRIGHT: MEDICAL DESIGN GROUP

**ELECT. COM-CHECK REPORT**

Desert Sage Health Center  
 2280 American Legion Blvd.  
 Mountain Home, Idaho

SHEET

16.41

March 2004